

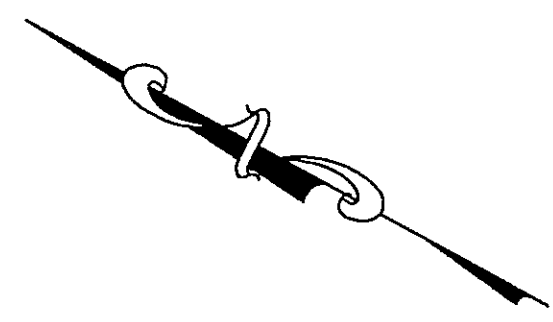


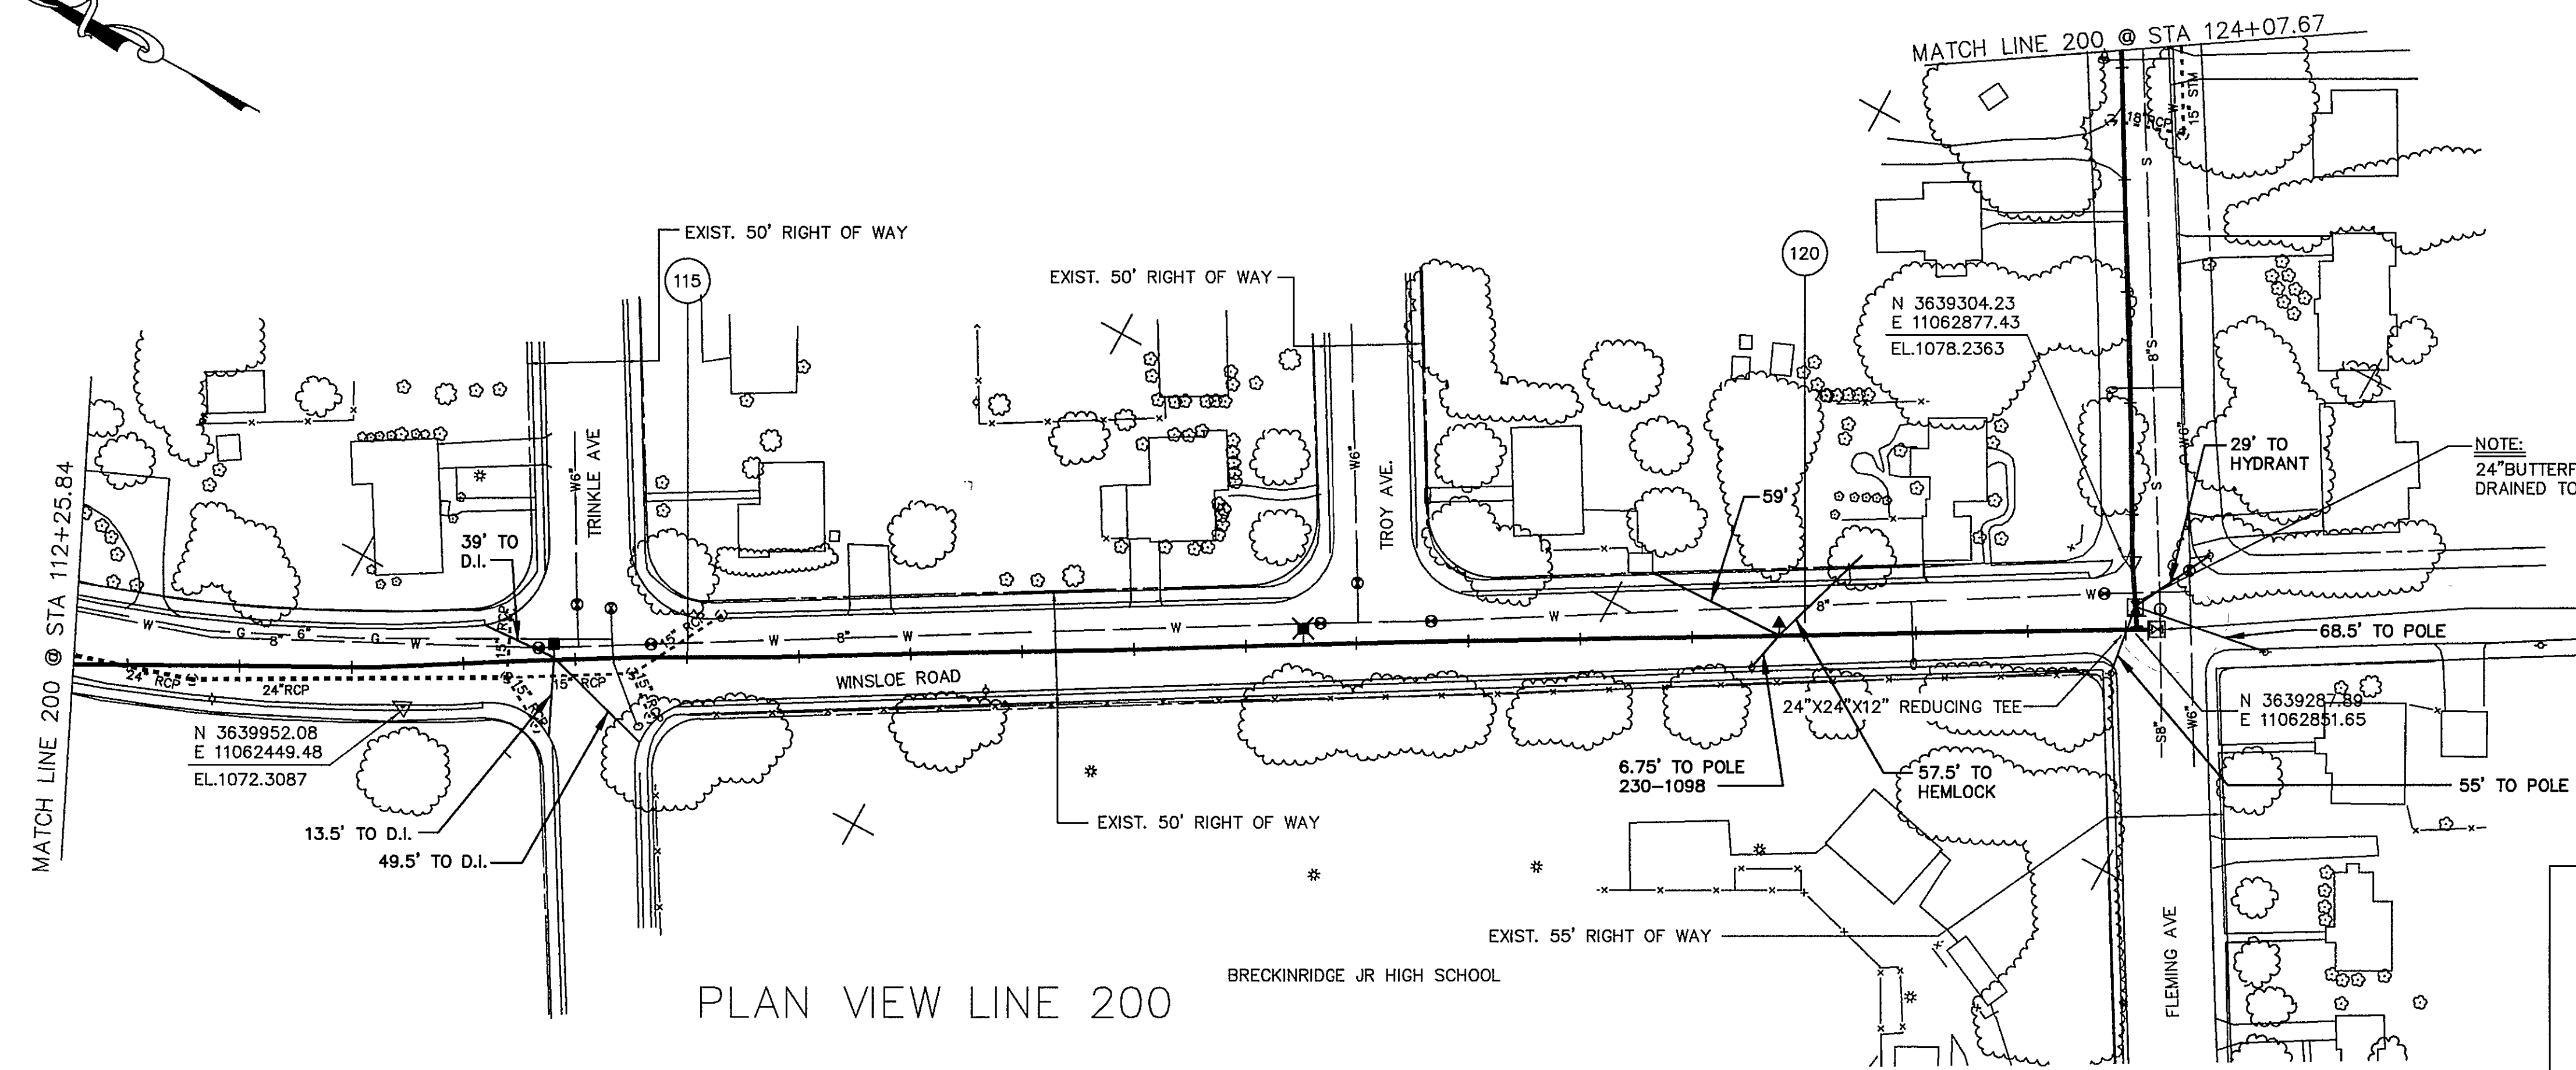


THIS SHEET  
1182 LF 24" WATERMAIN  
1 EA. 6" BLOWOFF  
1 EA. 4" A.R.V.  
2 EA. 24" BUTTERFLY VALVE

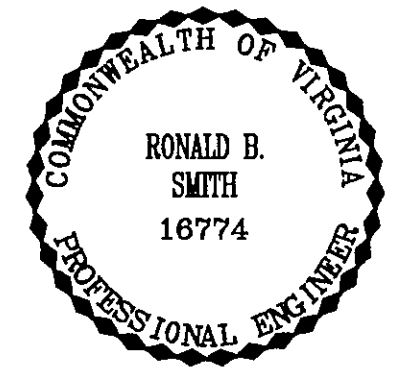


PLAN VIEW LINE 200

|                                                                                                         |                                                                                                         |
|---------------------------------------------------------------------------------------------------------|---------------------------------------------------------------------------------------------------------|
| <br>ENGINEER'S SEAL | <br>ENGINEER'S SEAL |
|---------------------------------------------------------------------------------------------------------|---------------------------------------------------------------------------------------------------------|

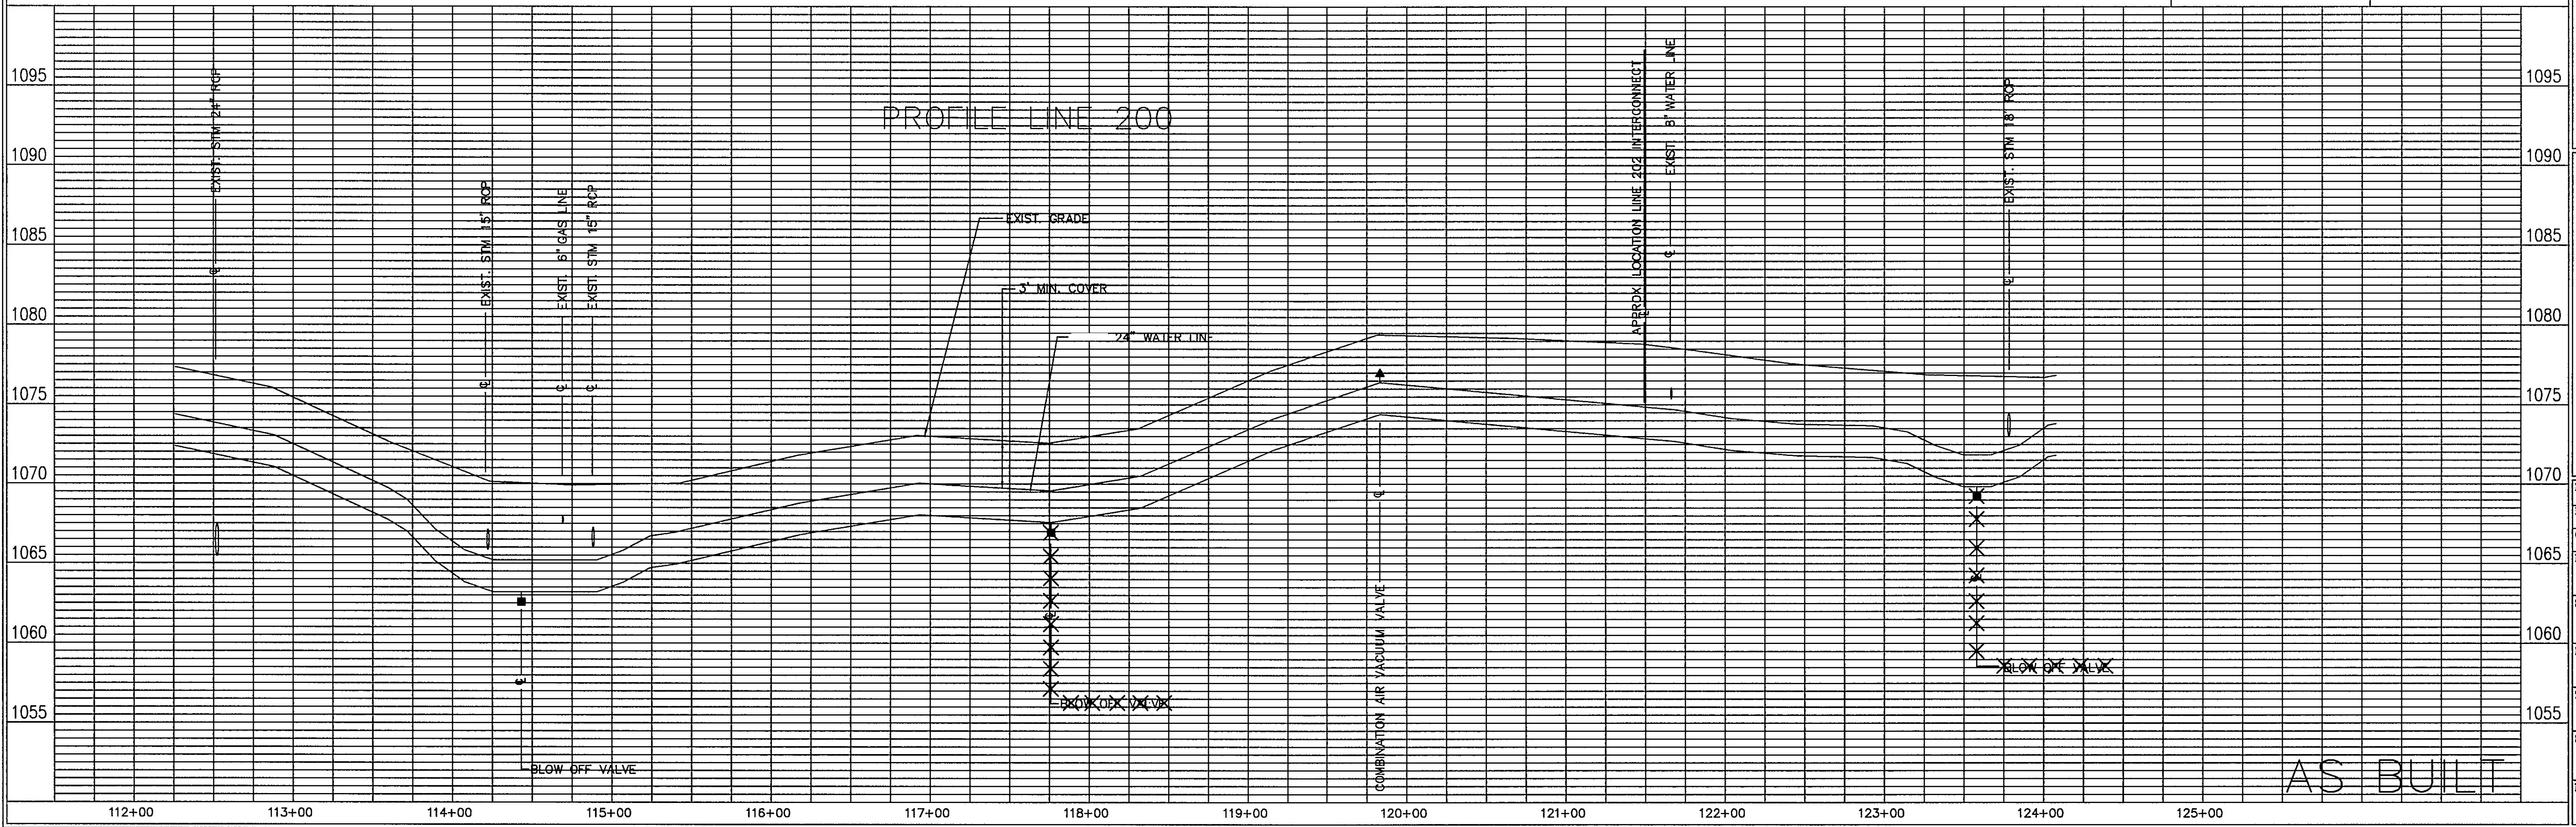

AS BUILT
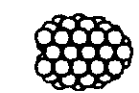
|                                                                                                                                                                                                                              |                                                                                                                                                                                   |                                                        |
|------------------------------------------------------------------------------------------------------------------------------------------------------------------------------------------------------------------------------|-----------------------------------------------------------------------------------------------------------------------------------------------------------------------------------|--------------------------------------------------------|
| <br>Architects<br>Engineers<br>Planners<br>Surveyors<br>5838 Valleypointe Parkway, Suite One-B<br>Roanoke, Virginia 24019<br>703 362-7725 | Carvins Cove, Phase II<br>City of Roanoke<br>Roanoke, Virginia                                                                                                                    | CONTRACT "B1"<br>LINE 200<br>STA 112+25.84 - 124+07.67 |
|                                                                                                                                                                                                                              | Drawn By REH/ACF<br>Designed By RBS<br>Checked By SEH<br>Date MAY 93<br>Scale<br>V: 1" = 5'<br>H: 1" = 50'<br>Plan Number A2<br>Zoned NONE<br>Sheet 11 of 25<br>File Number C1160 |                                                        |
|                                                                                                                                                                                                                              |                                                                                                                                                                                   |                                                        |