

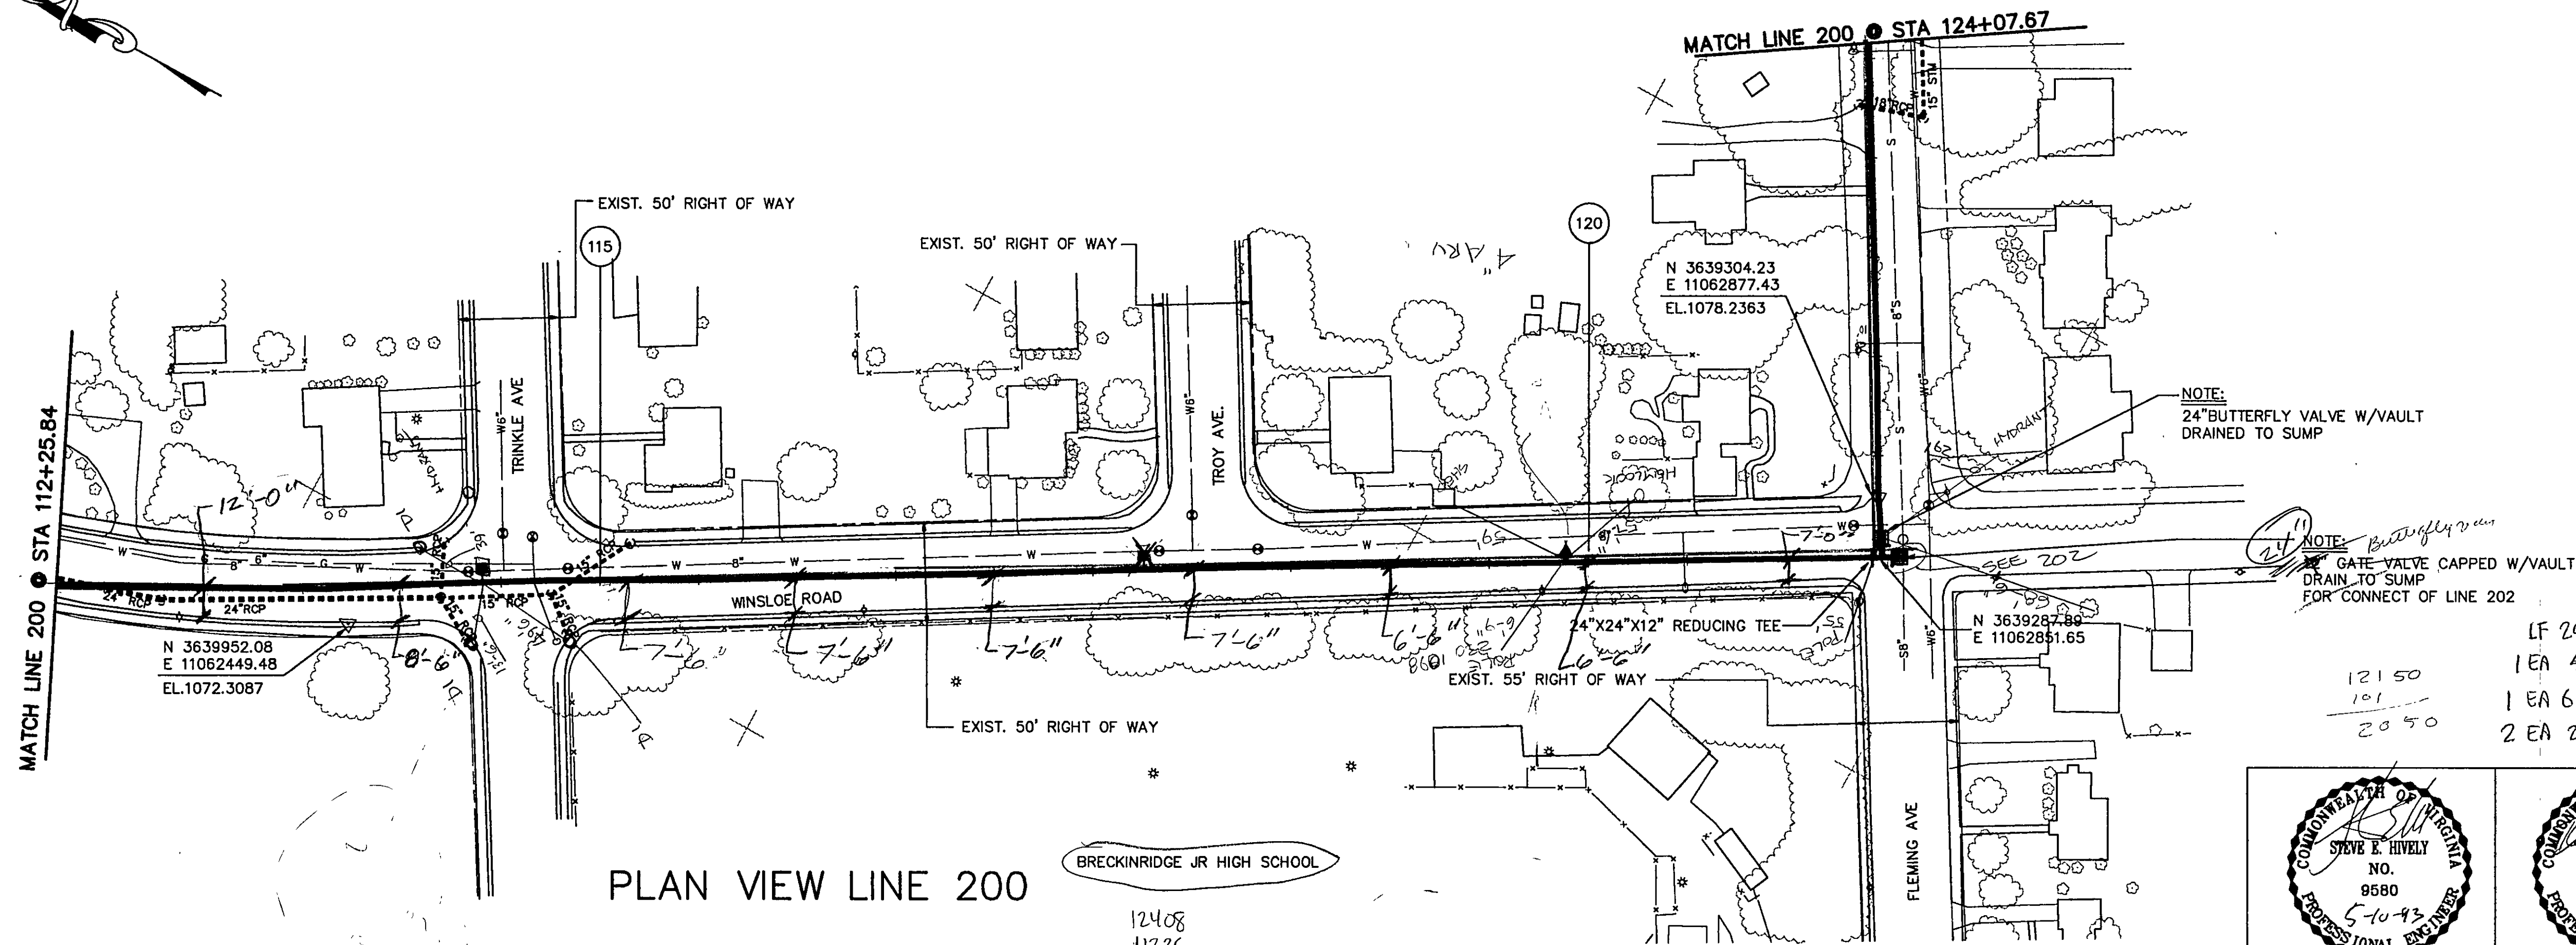


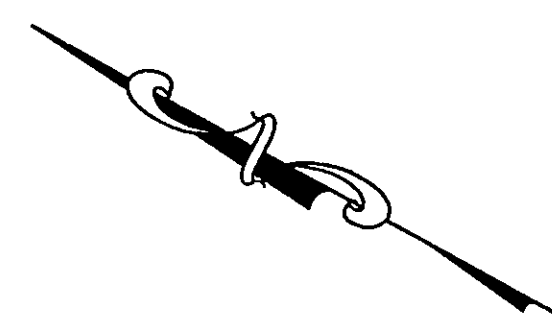


PLAN VIEW LINE 200

BRECKINRIDGE JR HIGH SCHOOL

12408
11226
1182

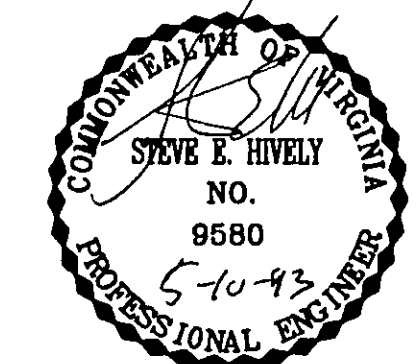


ENGINEER'S SEAL

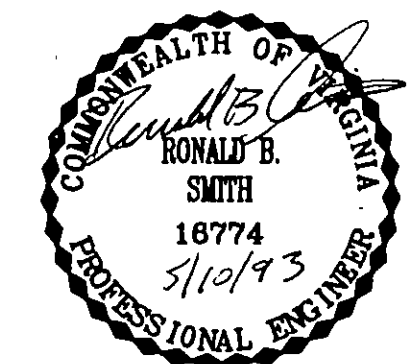

ENGINEER'S SEAL

PROFILE LINE 200

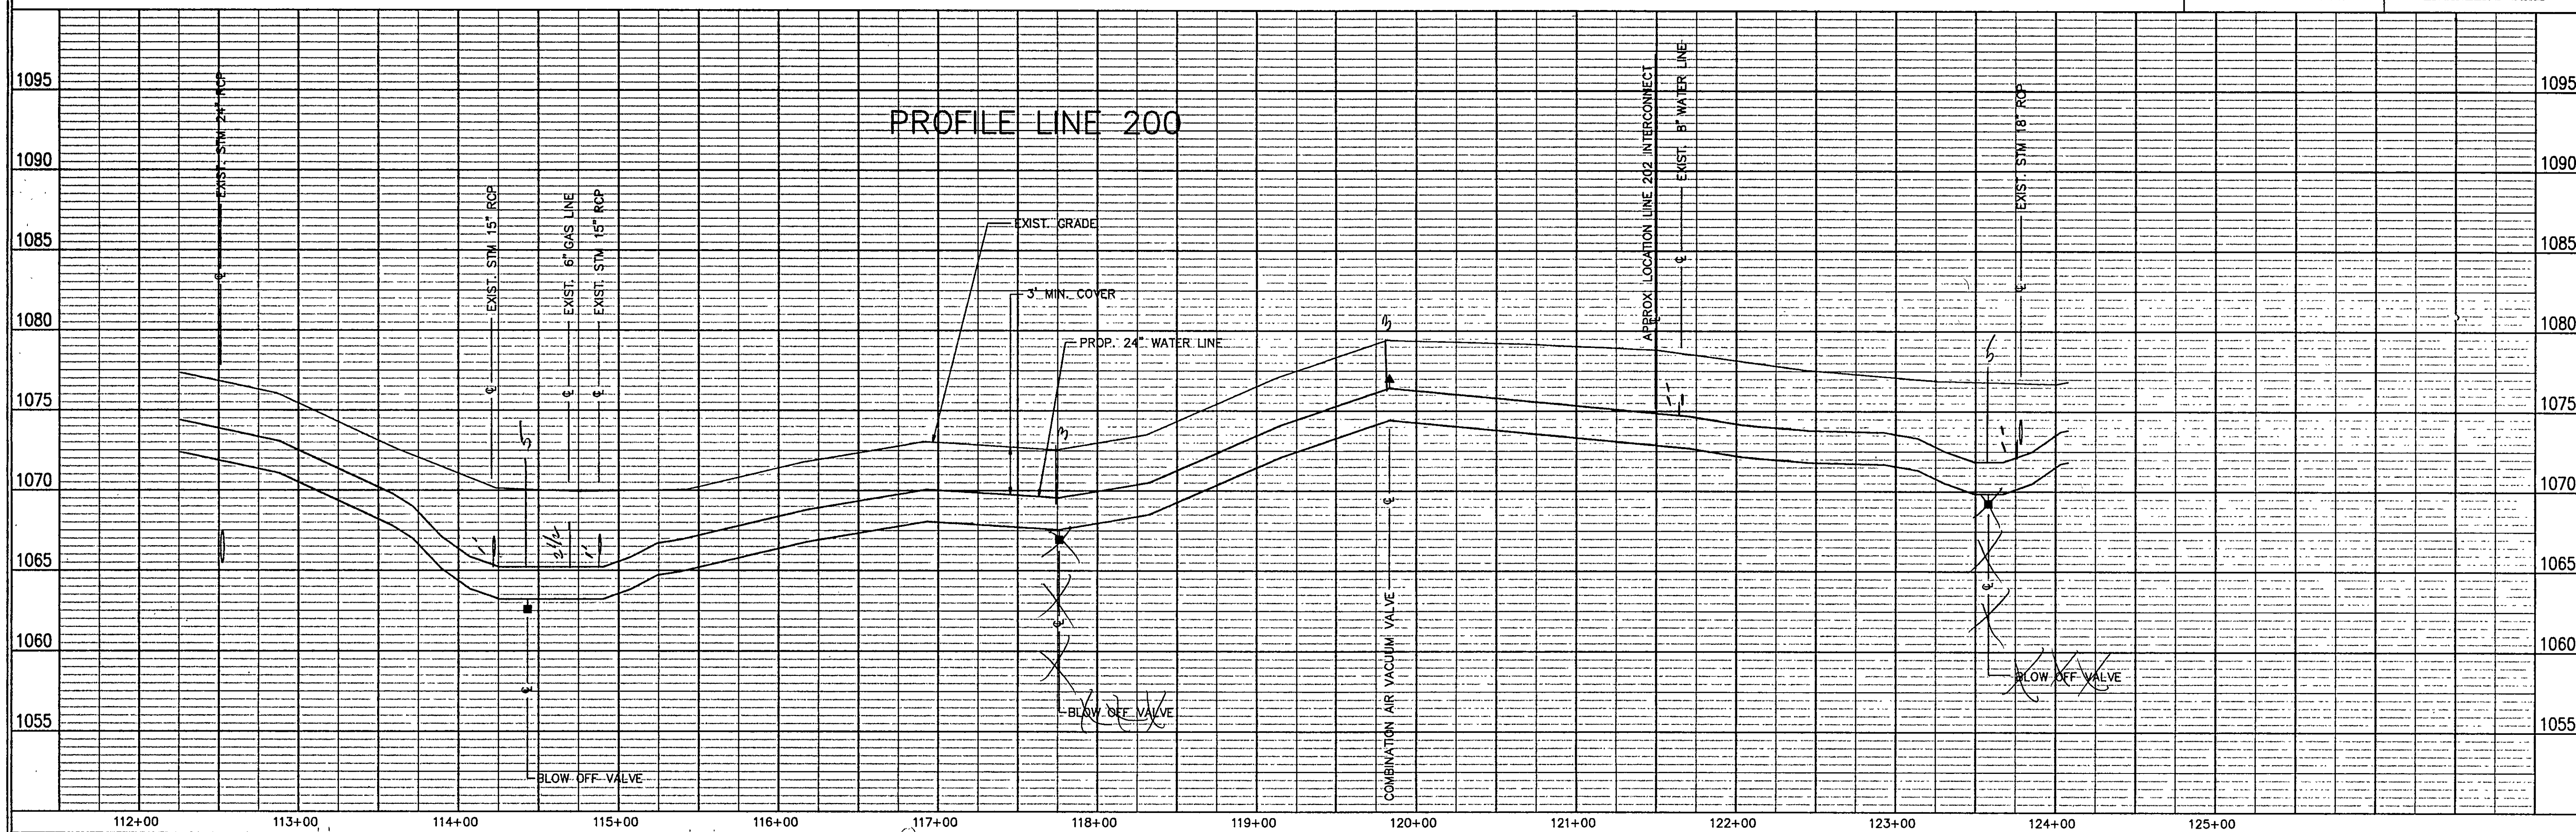

Architects
Engineers
Planners
Surveyors

Dewberry & Davis

5238 Valleypointe Parkway, Suite One-B
Roanoke, Virginia 24019
703 362-7725

Carvins Cove, Phase II
City of Roanoke
Roanoke, Virginia

CONTRACT "B1"
LINE 200
STA 112+25.84 - 124+07.67

Drawn By REH/ACF

Designed By RBS

Checked By SEH

Date

MAY 93

Scale

V: 1" = 5'

H: 1" = 50'

Plan Number

A2

Zoned

NONE

Sheet

11 of 25

File Number

C1160