



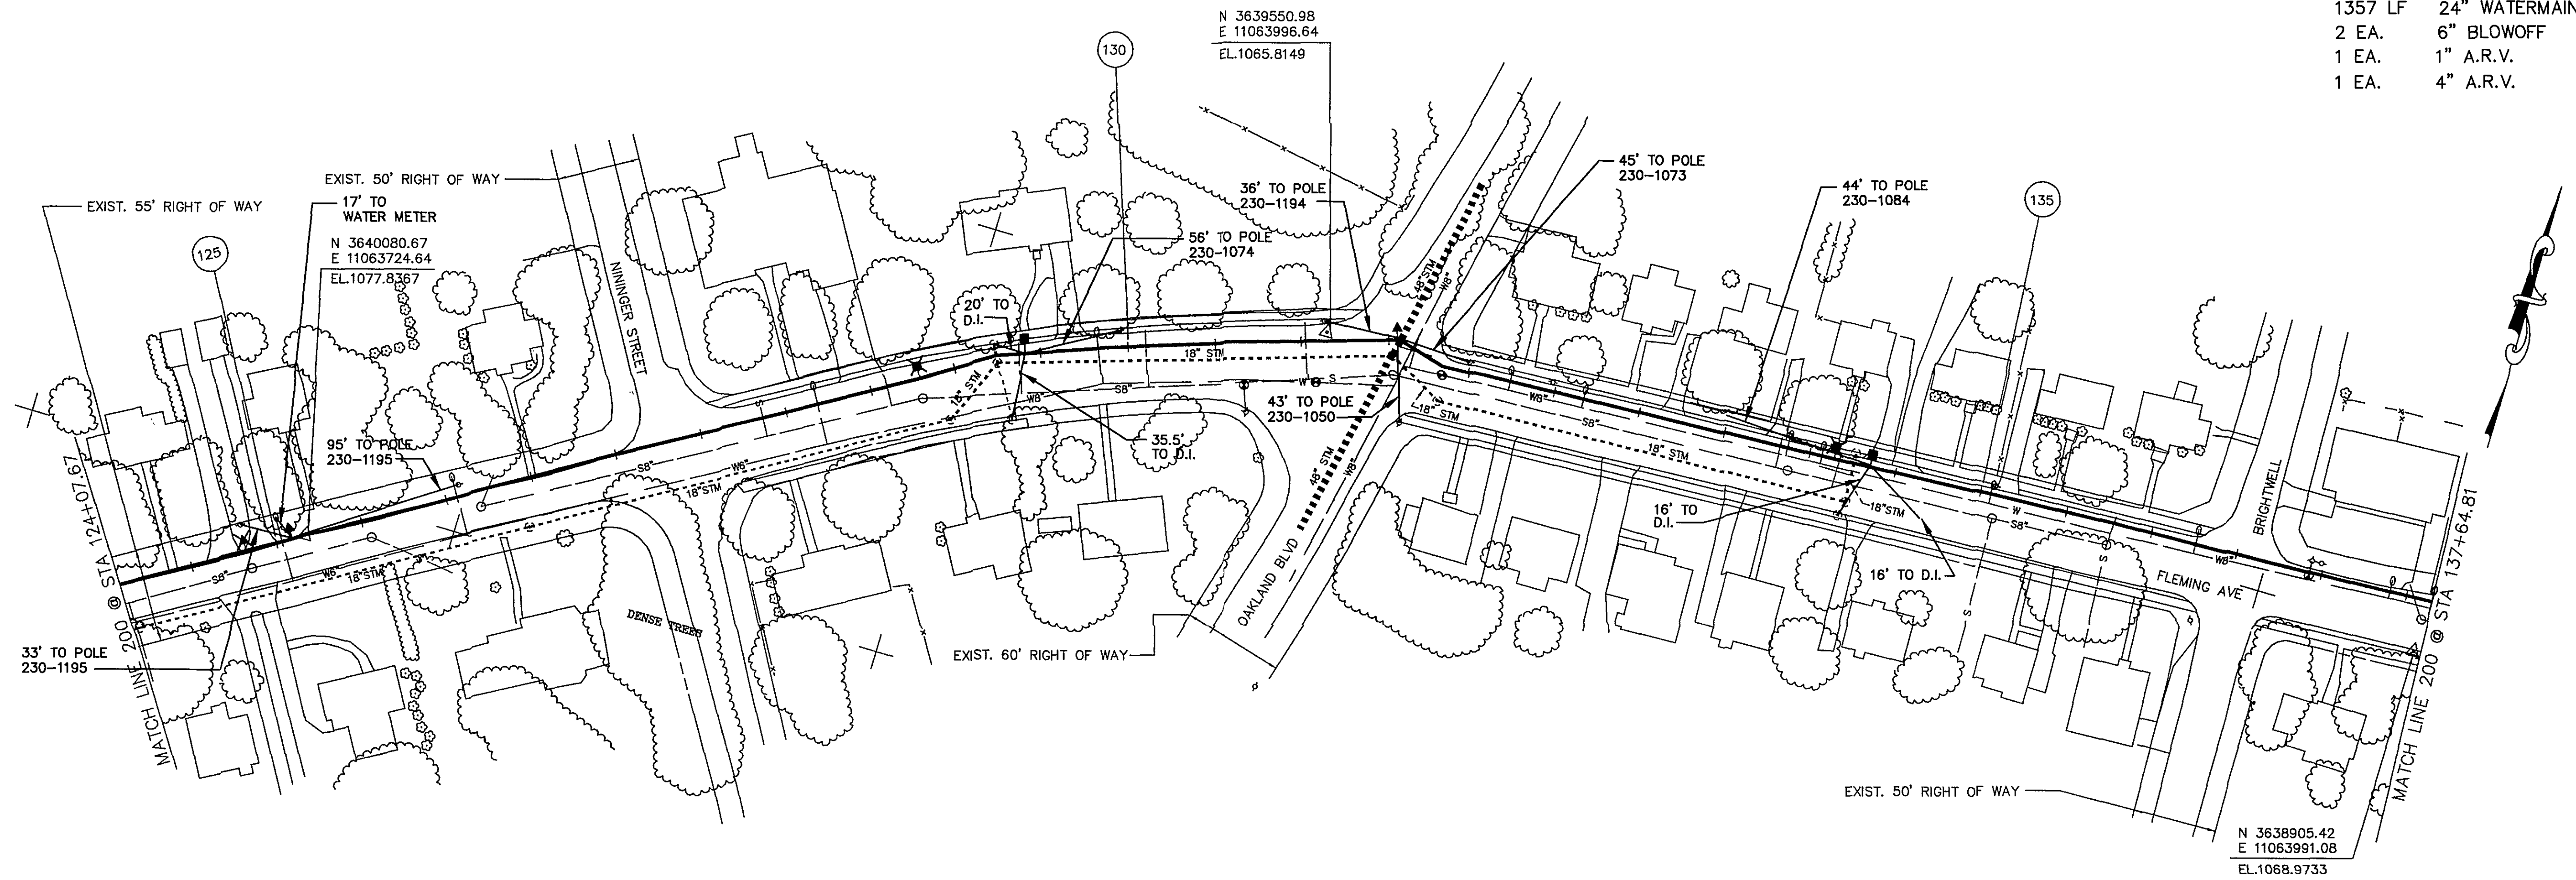


PLAN VIEW LINE 200

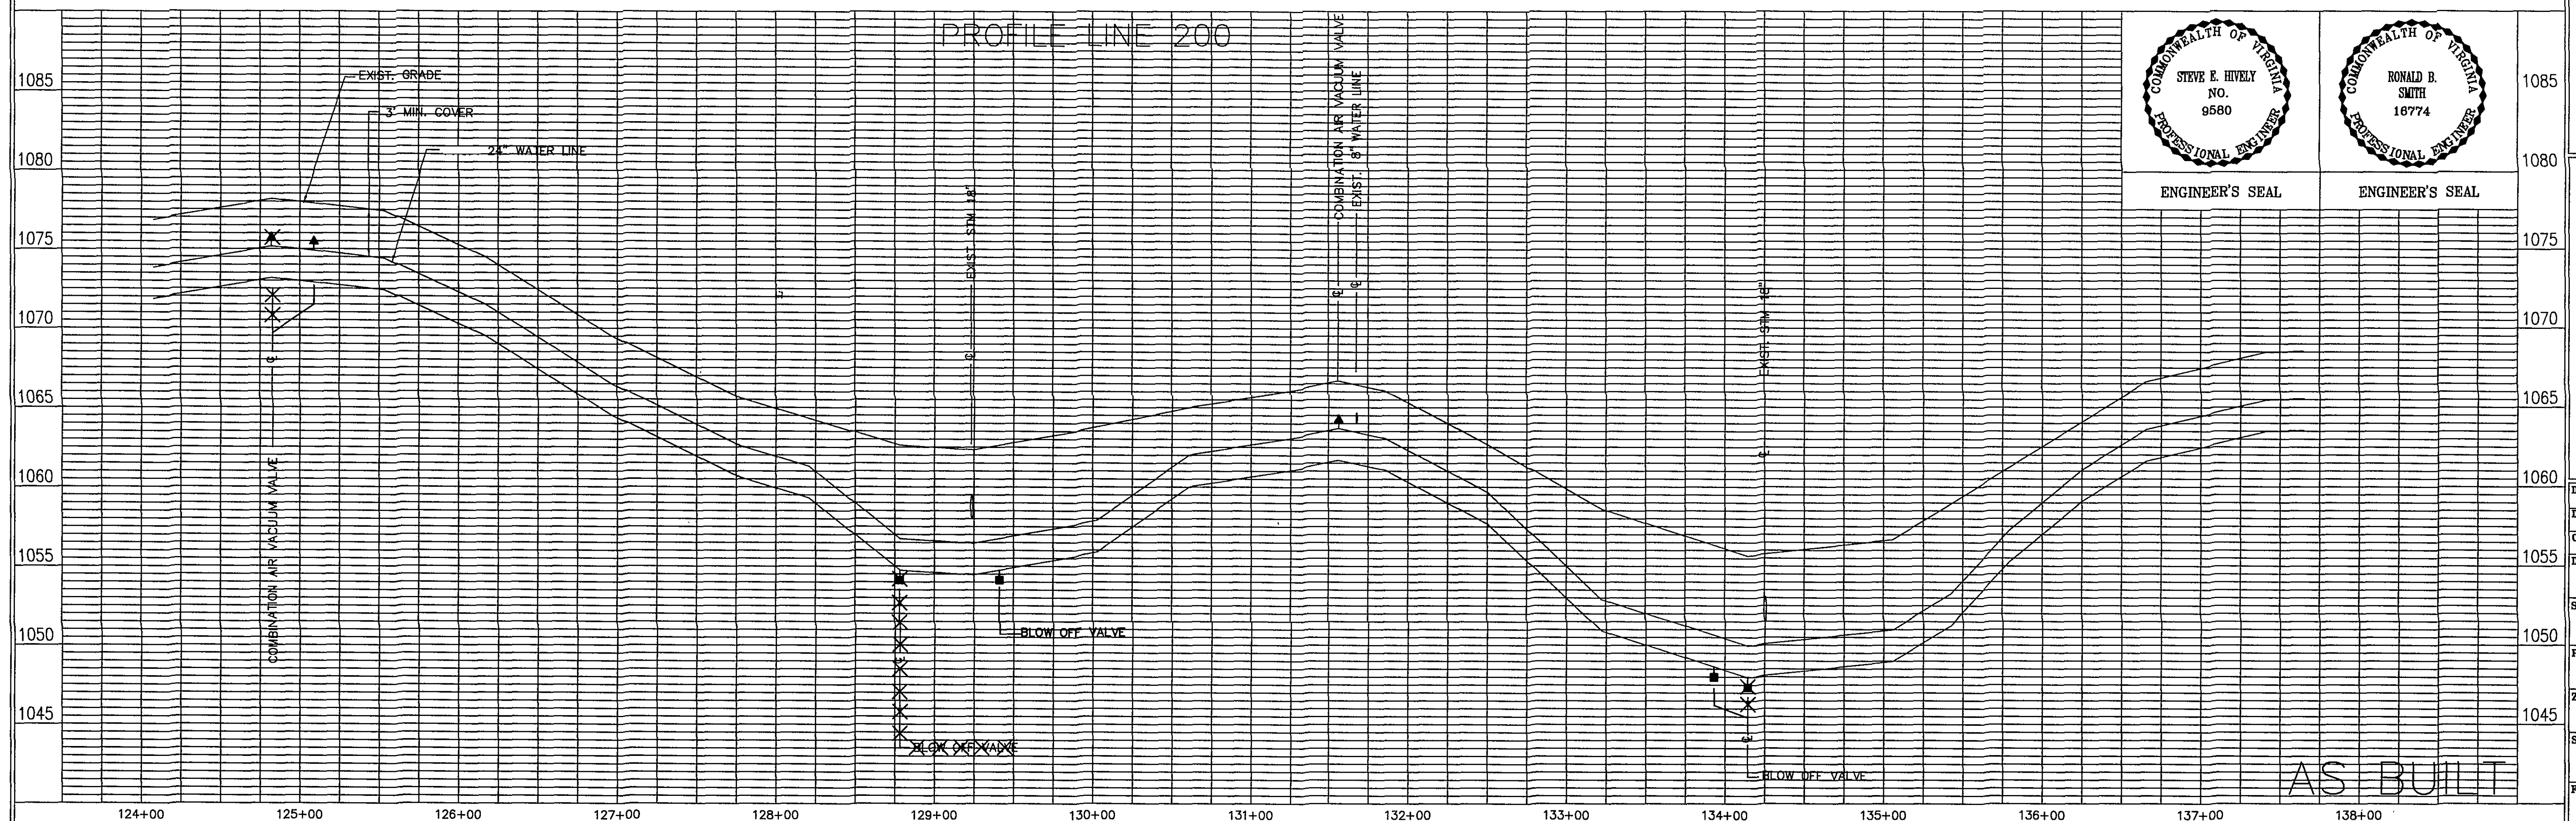


AS BUILT

THIS SHEET
1357 LF 24" WATERMAIN
2 EA. 6" BLOWOFF
1 EA. 1" A.R.V.
1 EA. 4" A.R.V.

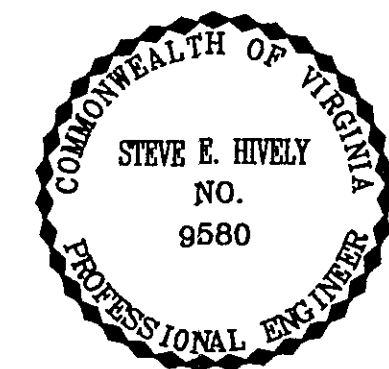

ENGINEER'S SEAL

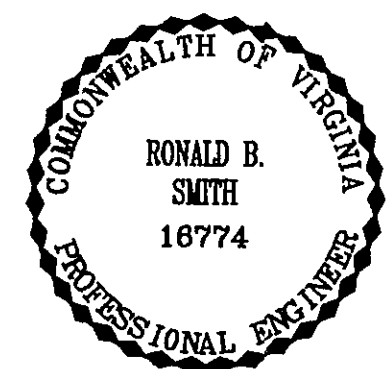

ENGINEER'S SEAL

Architects
Engineers
Planners
Surveyors

Dewberry & Davis

5238 Valleypointe Parkway, Suite One-B
Roanoke, Virginia 24019
703 982-7725

Carvins Cove, Phase II
City of Roanoke
Roanoke, Virginia

CONTRACT "B1"
LINE 200
STA 124+07.67 - 137+64.81

Drawn By ACF/REH
Designed By RBS
Checked By SEH

Date MAY 93

Scale
V: 1" = 5'
H: 1" = 50'

Plan Number
A3

Zoned
NONE

Sheet
12 of 25

File Number
C1160