




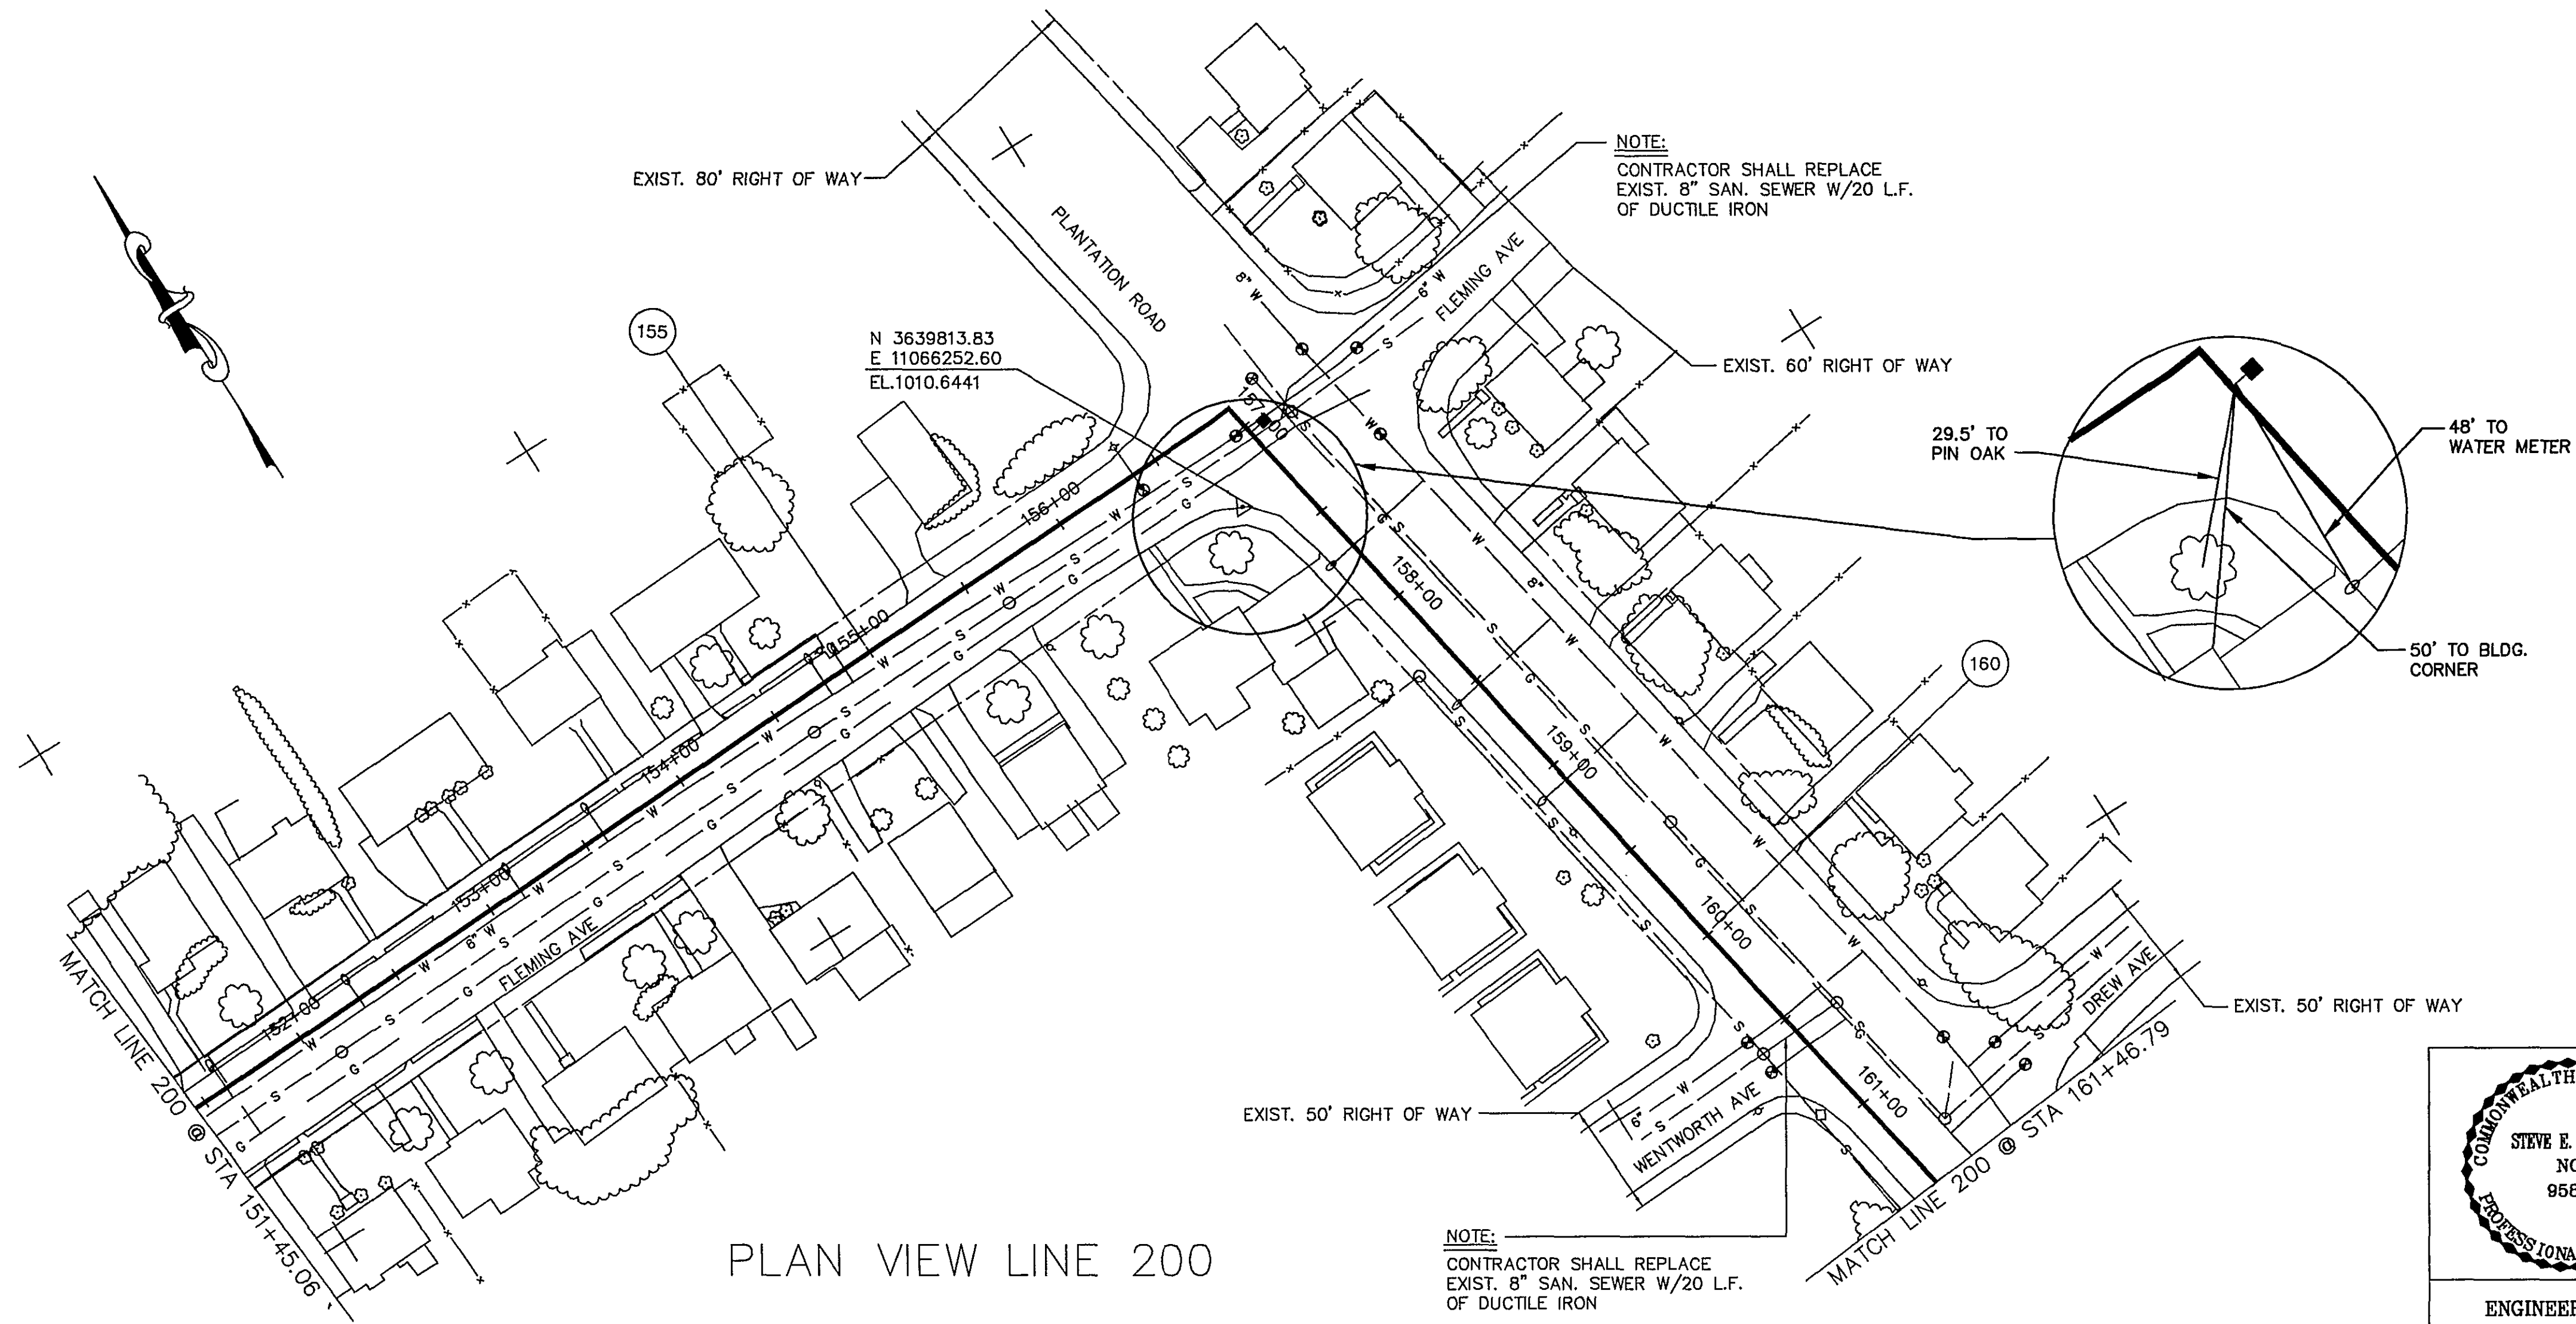


THIS SHEET
1002 LF 24" WATERMAIN
1 EA. 6" BLOWOFF

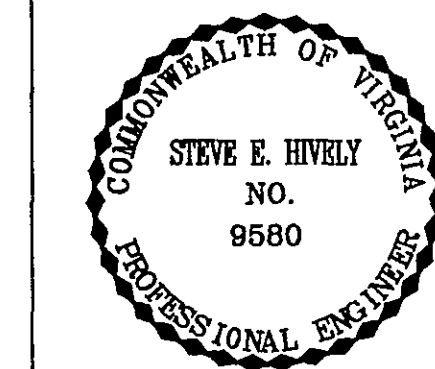

ENGINEER'S SEAL

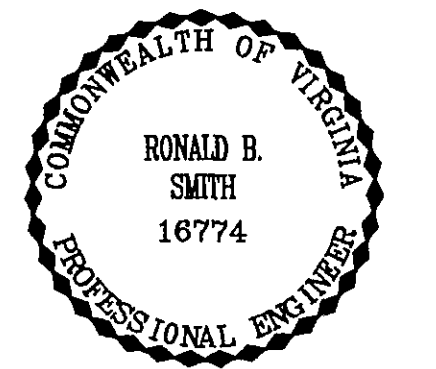

ENGINEER'S SEAL

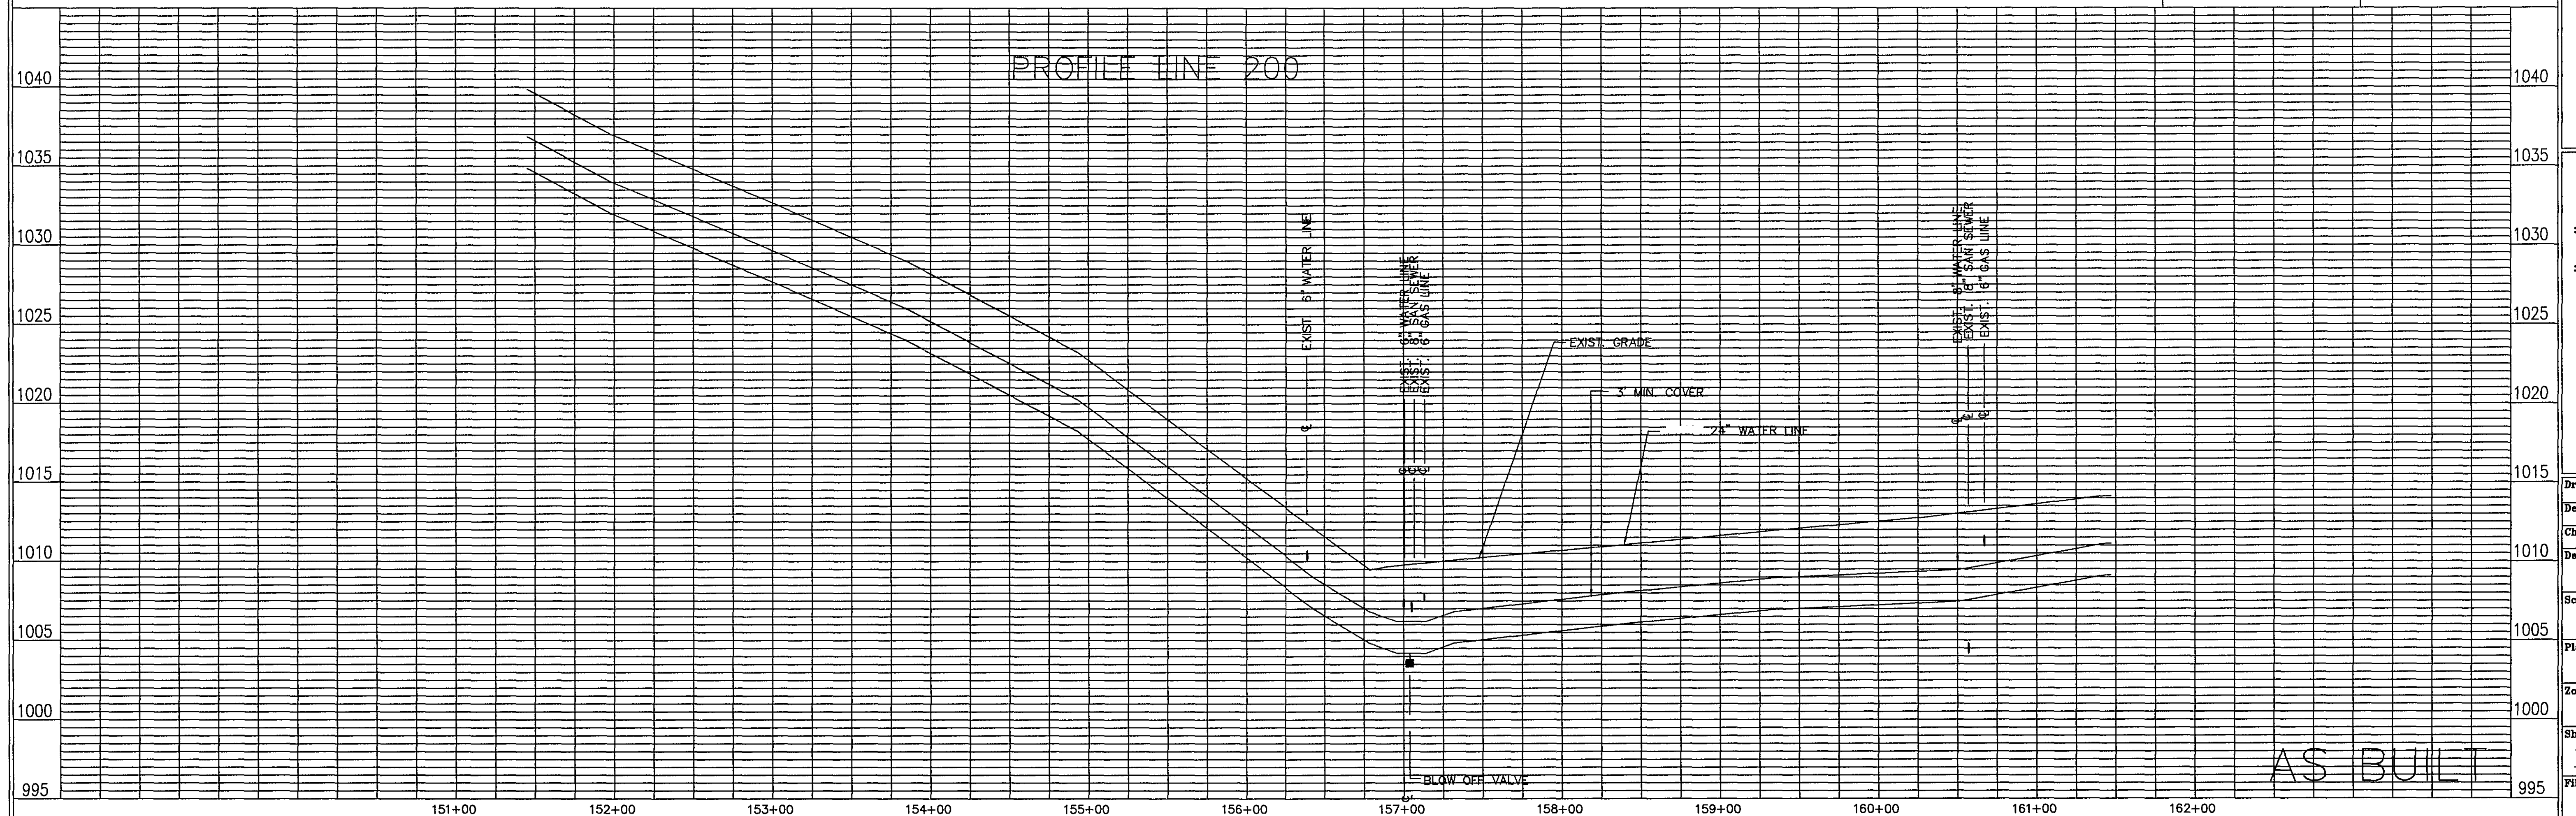

Architects
Engineers
Planners
Surveyors

Dewberry & Davis

5238 Valleypointe Parkway, Suite One-B
Roanoke, Virginia 24019
703 362-7725

Carvins Cove, Phase II

City of Roanoke
Roanoke, Virginia

CONTRACT "B1"
LINE 200
STA 151+45.06 - 161+46.79

Drawn By REH/ACF
Designed By RBS
Checked By SEH

Date MAY 93

Scale
V: 1" = 5'
H: 1" = 50'

Plan Number
A5

Zoned
NONE

Sheet
14 of 25

File Number
C1160