





THIS SHEET
888 LF 24" WATERMAIN
1 EA. 1" A.R.V.
1 EA. 24" BUTTERFLY VALVE

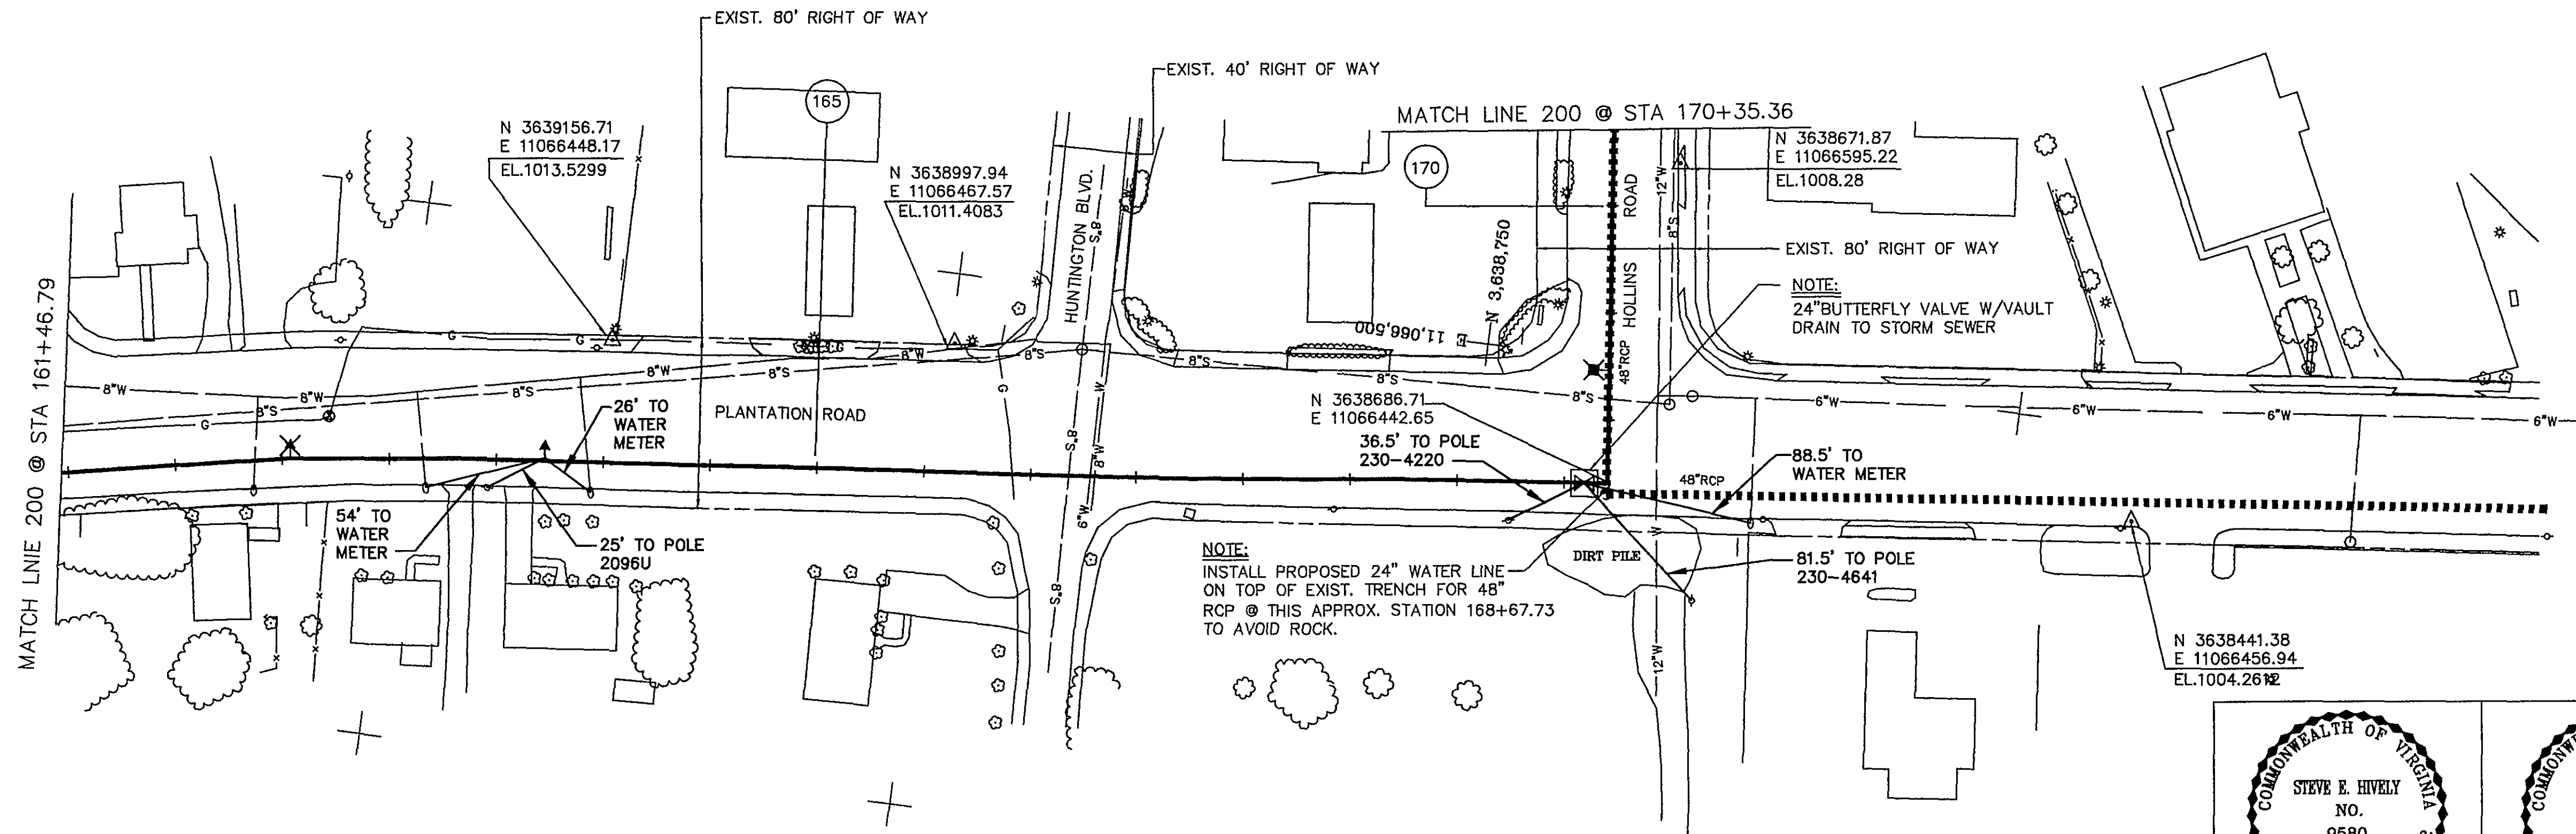


PLAN VIEW LINE 200



ENGINEER'S SEAL

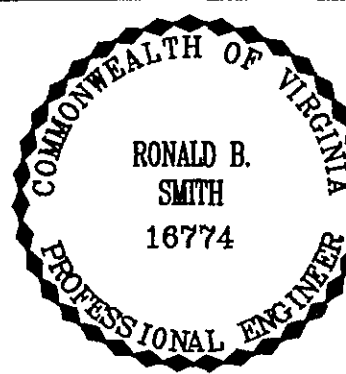

ENGINEER'S SEAL

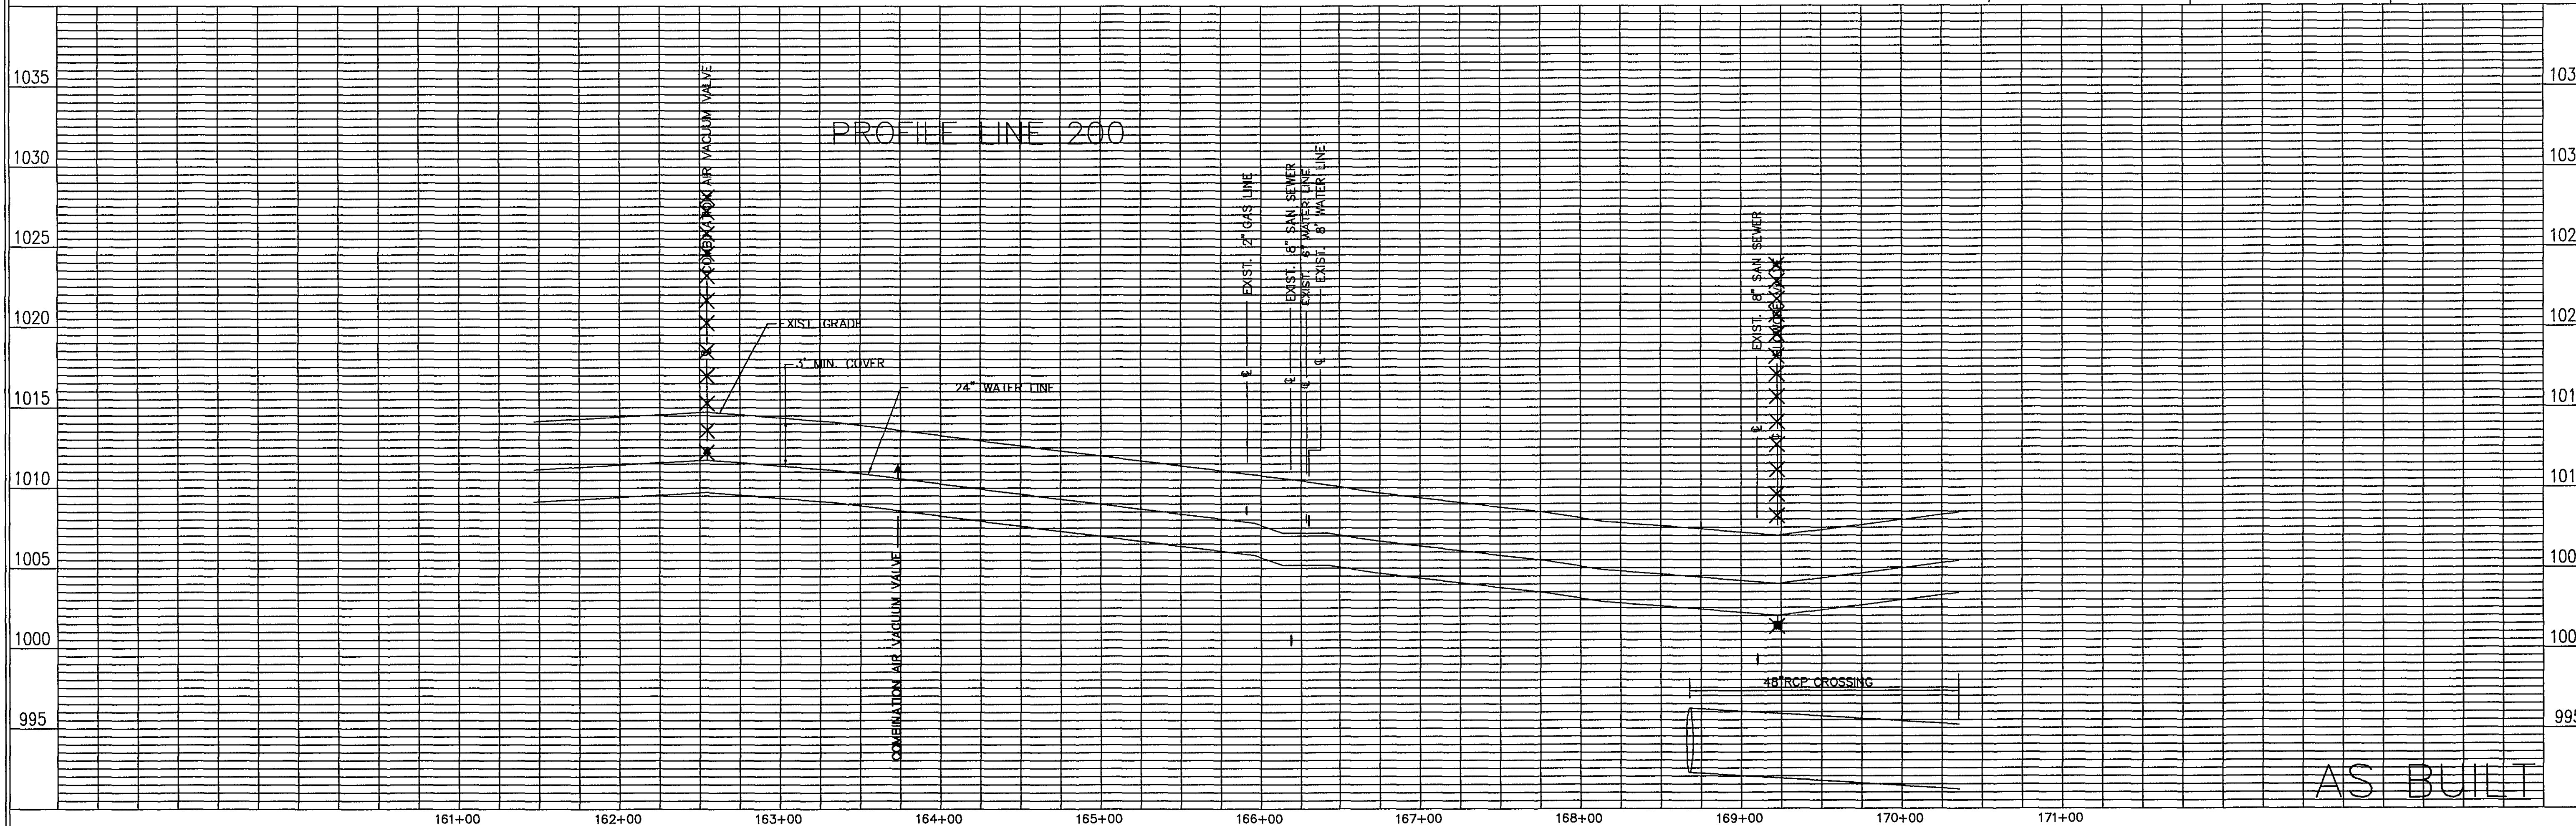

AS BUILT

Architects
Engineers
Planners
Surveyors

Dewberry & Davis

5238 Valleypointe Parkway, Suite One-B
Roanoke, Virginia 24019
703 362-7725

Carvins Cove, Phase II
City of Roanoke
Roanoke, Virginia

CONTRACT "B1"
LINE 200
STA 161+46.79 - 170+35.36

Drawn By REH/ACF
Designed By RBS
Checked By SEH

Date MAY 93

Scale
V: 1" = 5'
H: 1" = 50'

Plan Number A6

Zoned NONE

Sheet 15 of 25

File Number C1160