




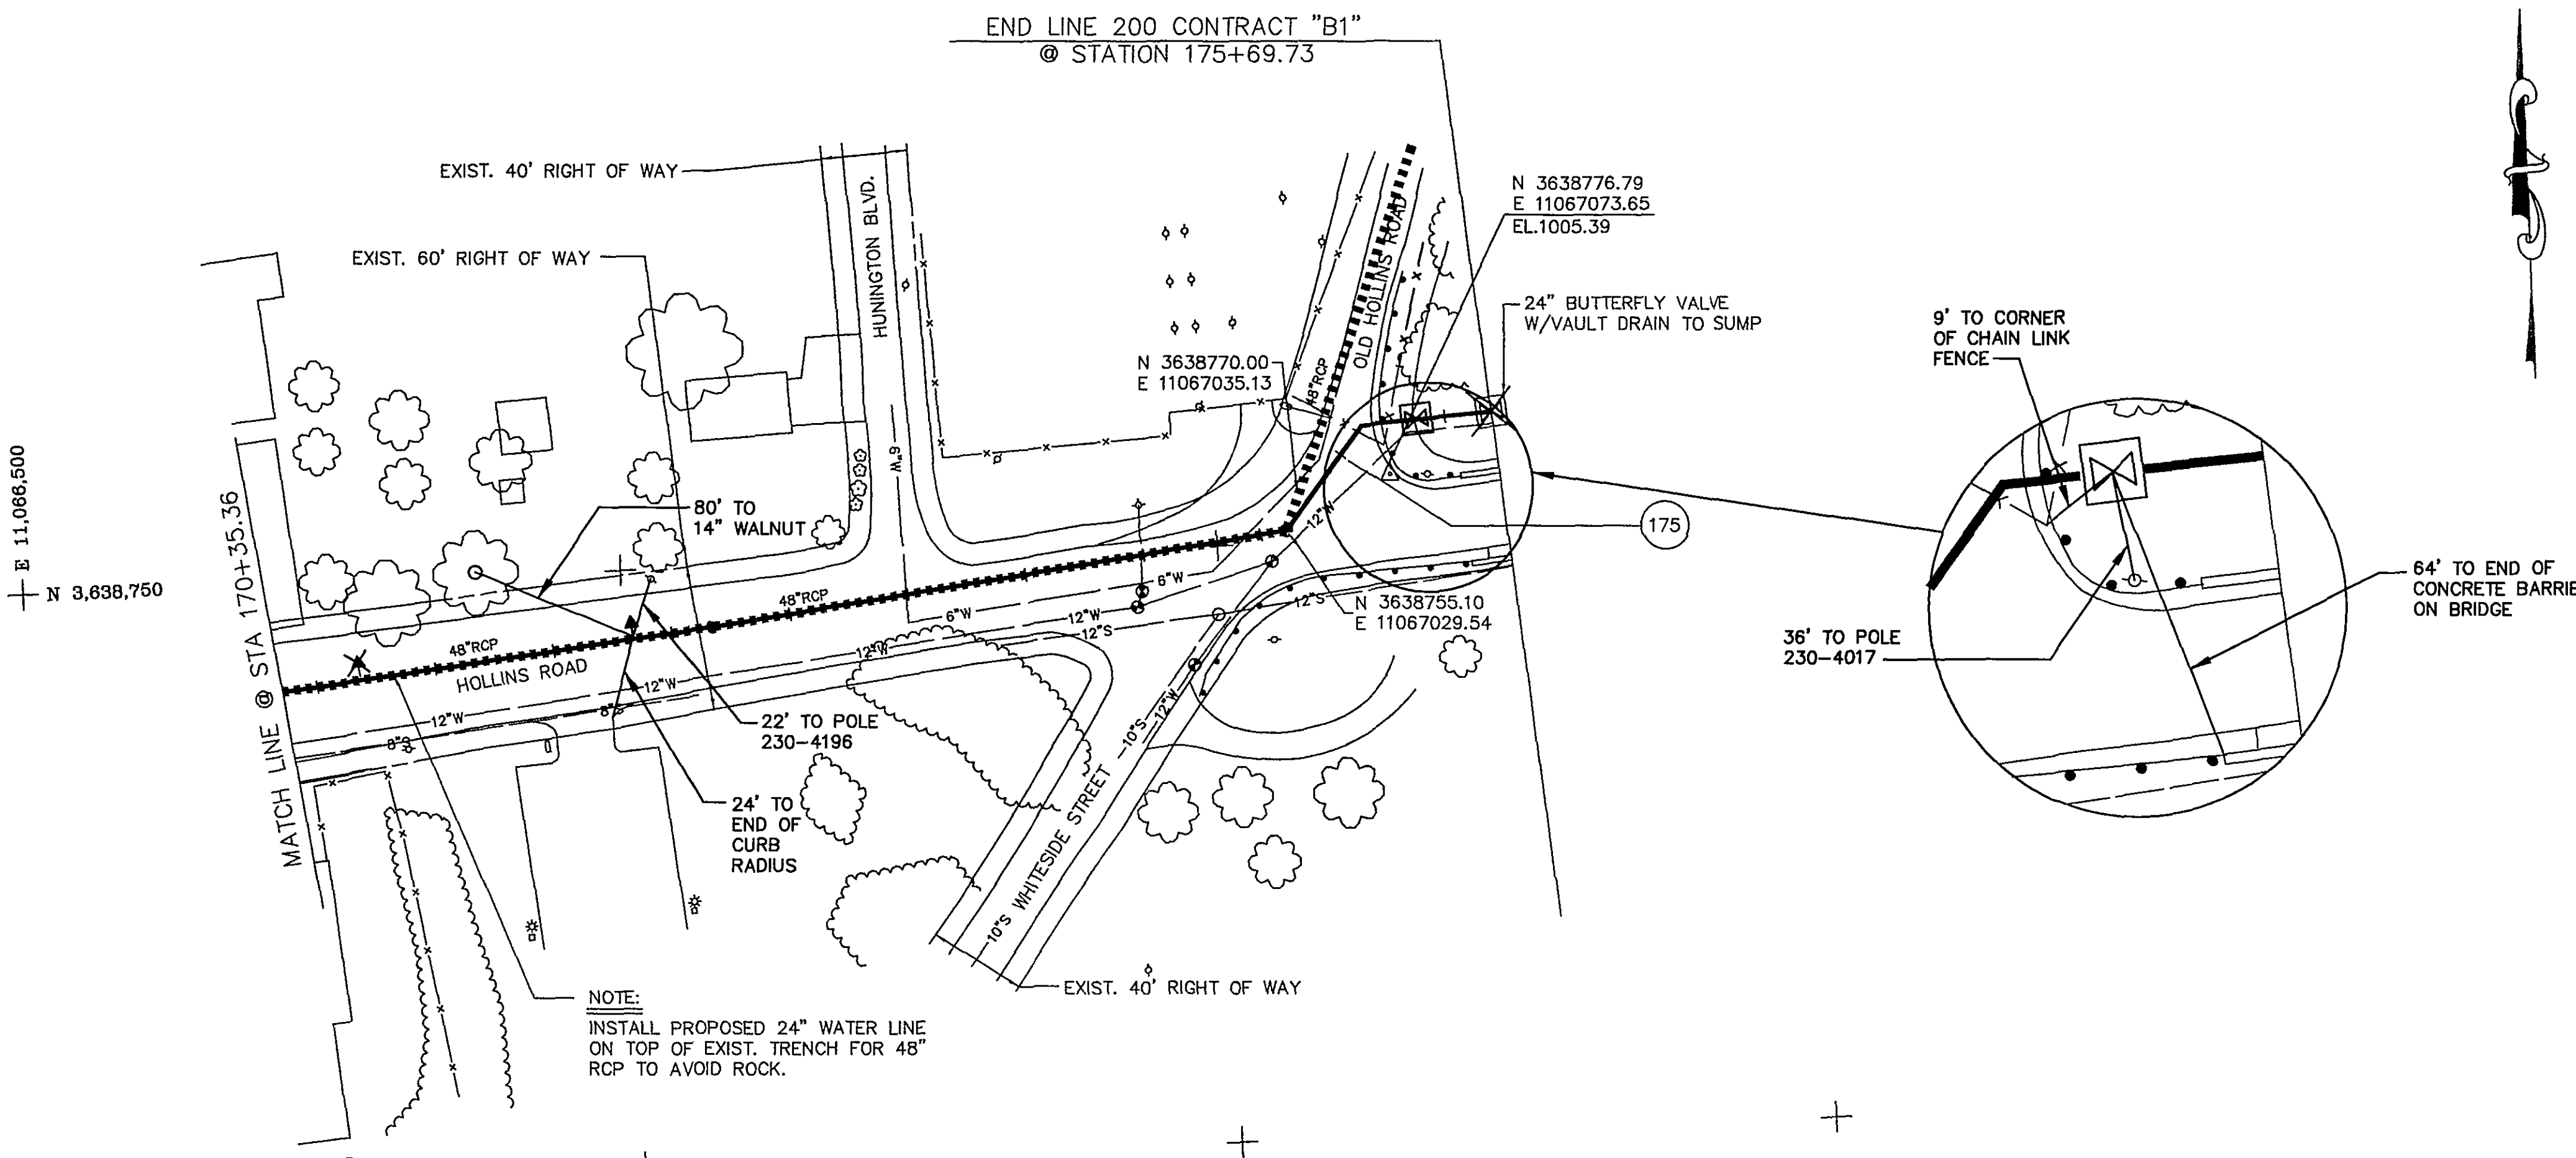


PLAN VIEW LINE 200

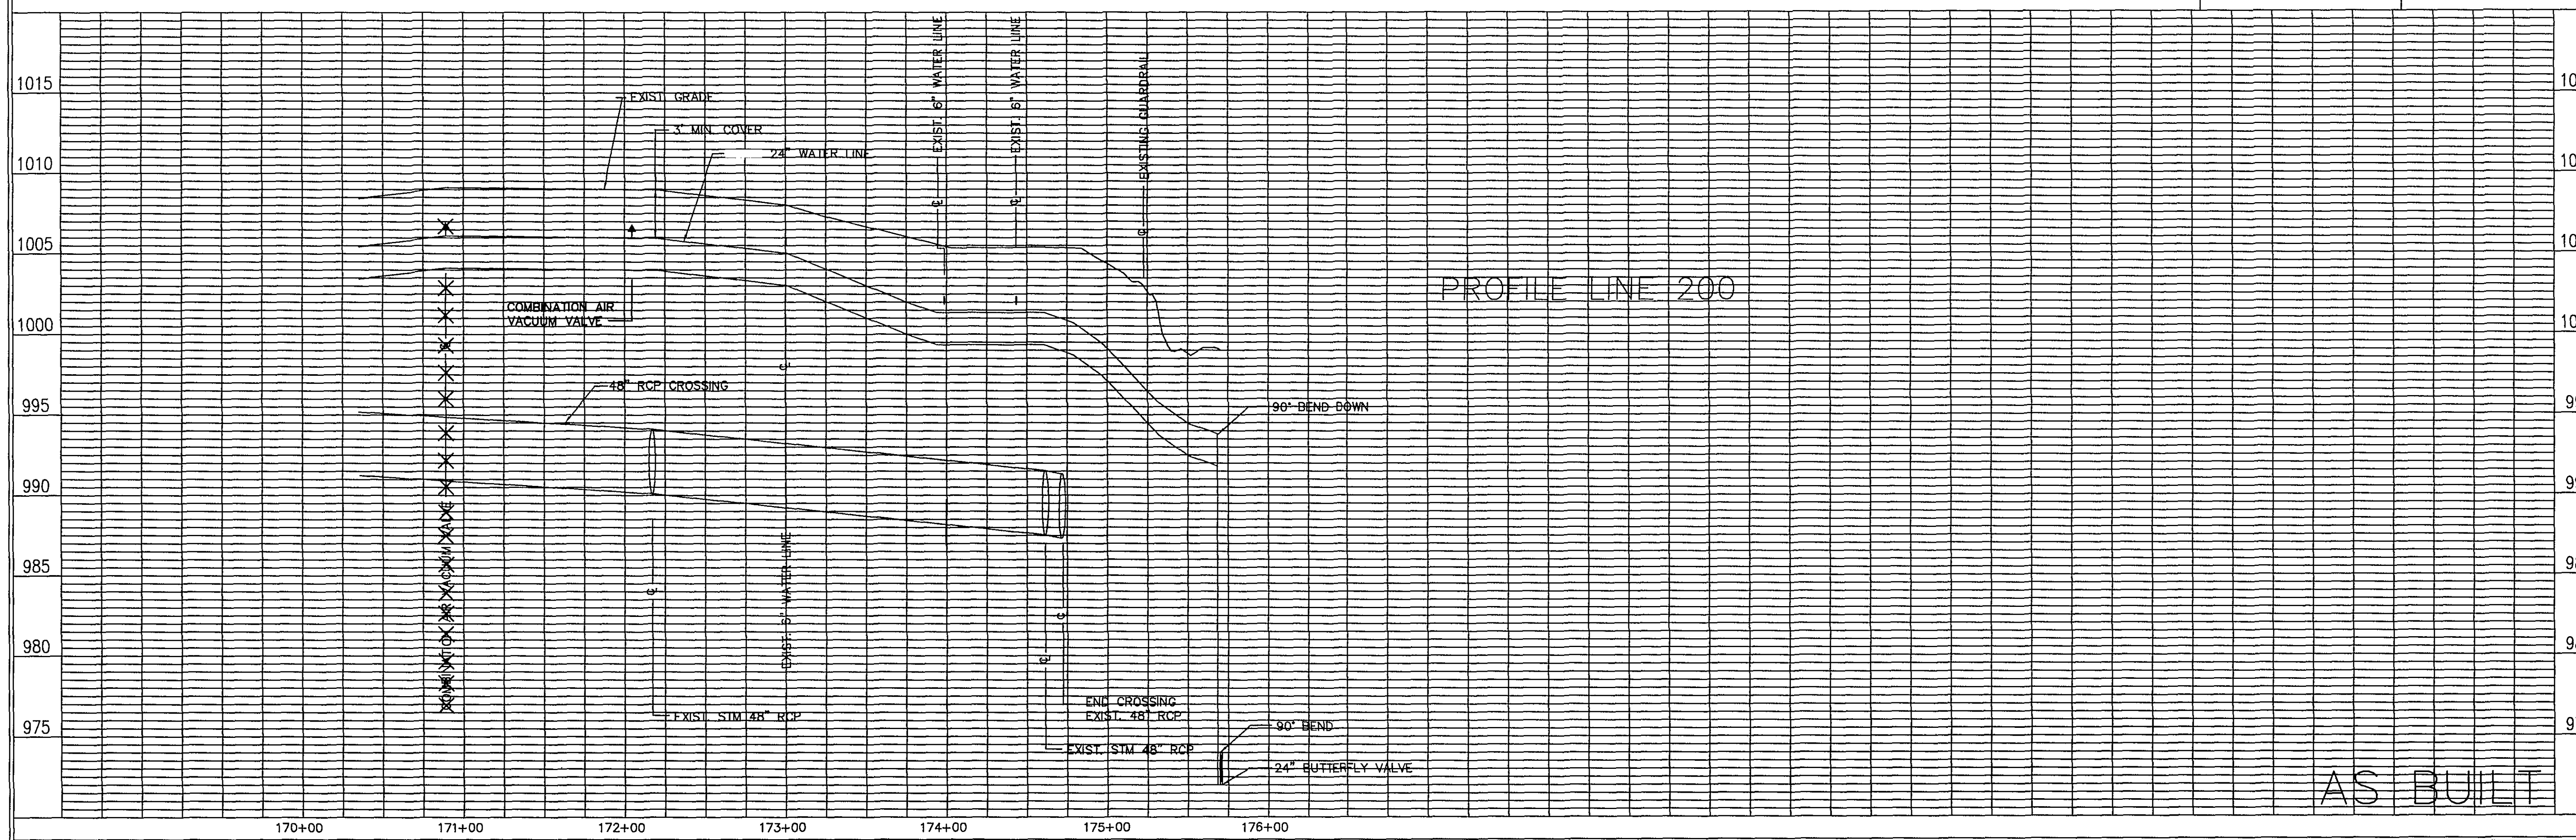

PROFILE LINE 200

THIS SHEET
535 LF 24" WATERMAIN
1 EA. 1" A.R.V.
1 EA. 24" BUTTERFLY VALVE

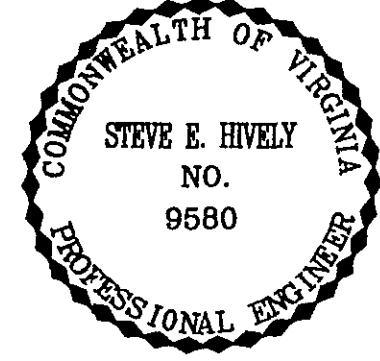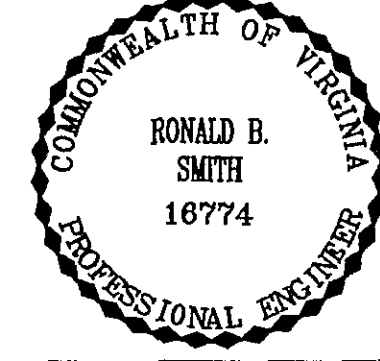 ENGINEER'S SEAL	 ENGINEER'S SEAL
---	---

AS BUILT

 Dewberry & Davis Architects Engineers Planners Surveyors 5238 Valleypointe Parkway, Suite One-B Roanoke, Virginia 24019 703 362-7725	Carvins Cove, Phase II City of Roanoke Roanoke, Virginia
	CONTRACT "B1" END LINE 200 STA 170+35.36 - 175+69.73
Drawn By REH/ACF Designed By RBS Checked By SEH Date MAY 93 Scale V: 1" = 5' H: 1" = 50' Plan Number A7A Zoned NONE Sheet 16 of 25 File Number C1160	