
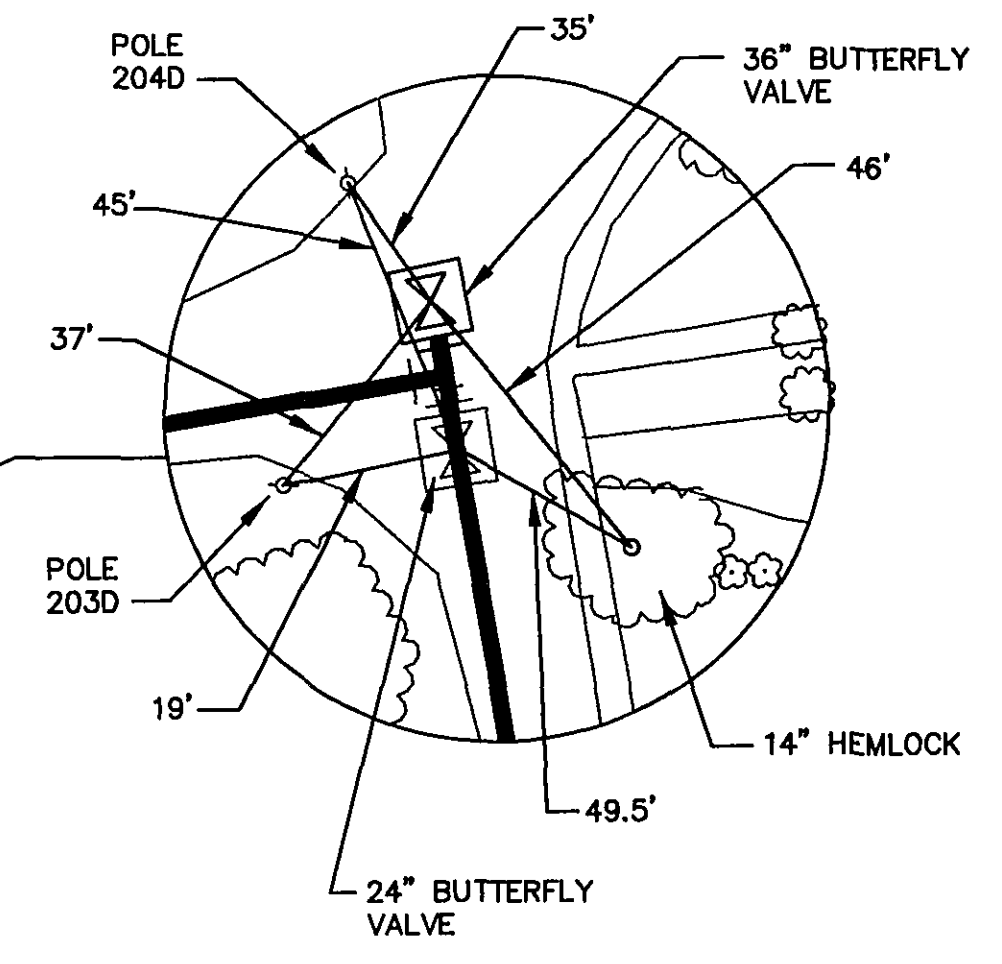
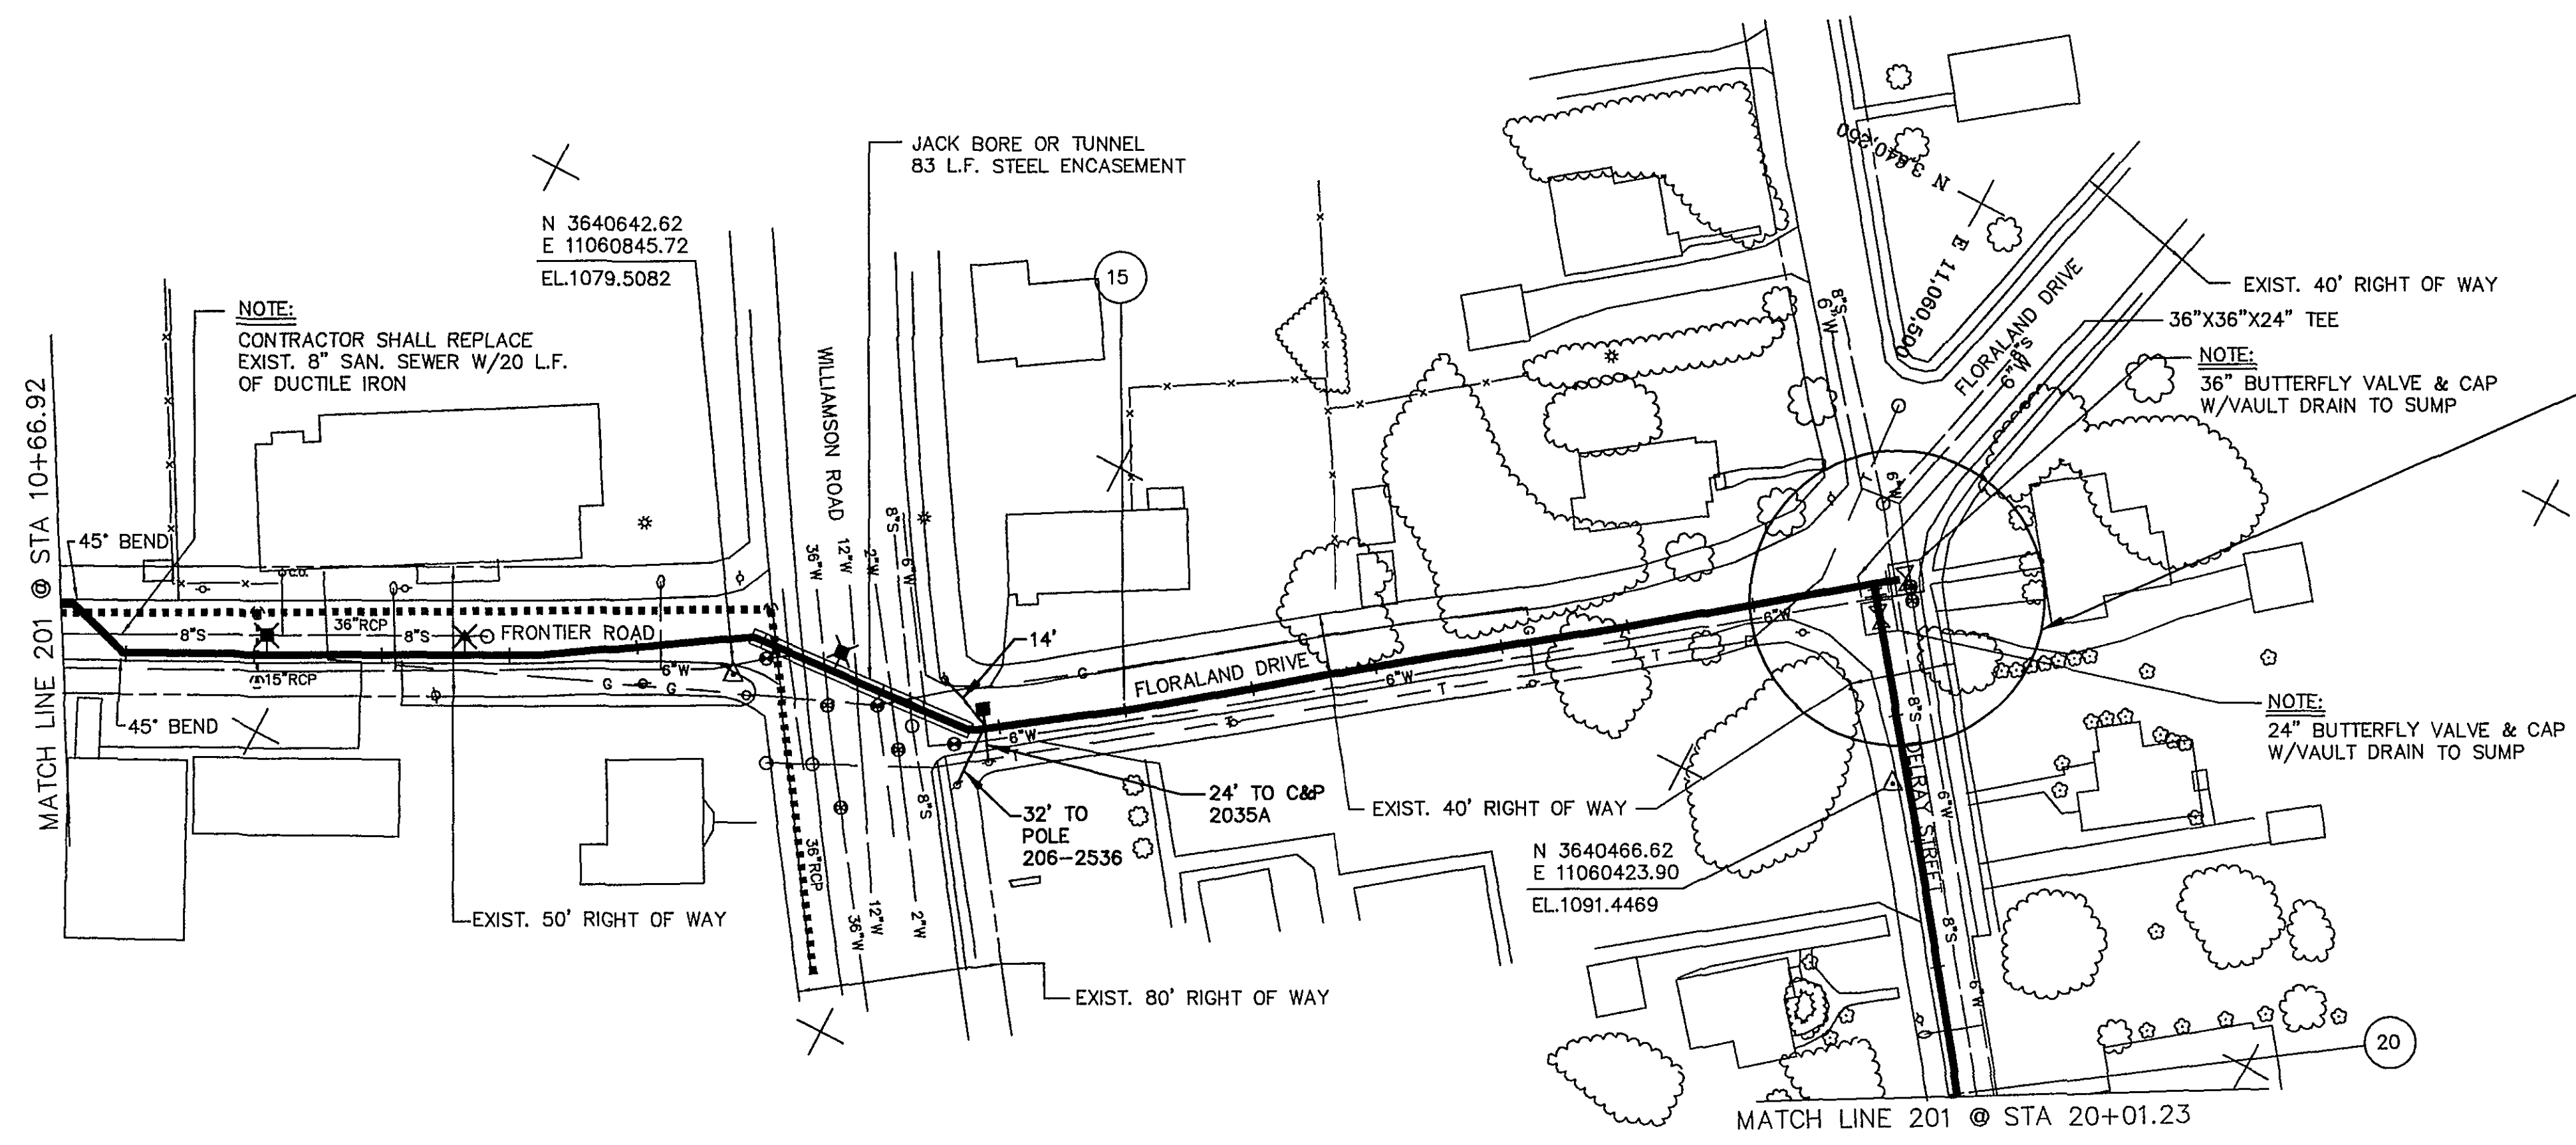


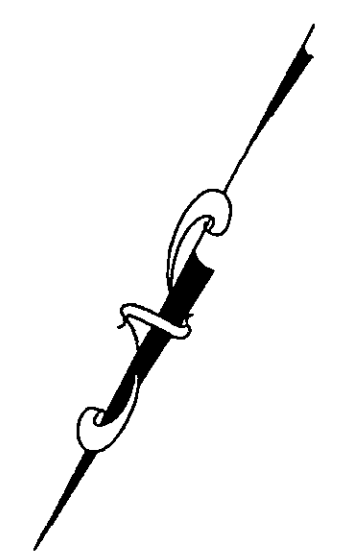

THIS SHEET


733 LF	36" WATERMAIN
201 LF	24" WATERMAIN
1 EA.	8" BLOWOFF
1 EA.	36" BUTTERFLY VALVE
1 EA.	24" BUTTERFLY VALVE

 ENGINEER'S SEAL	 ENGINEER'S SEAL
---------------------	---------------------

N 3,641,000
E 11,061,000

PLAN VIEW LINE 201

PROFILE LINE 201

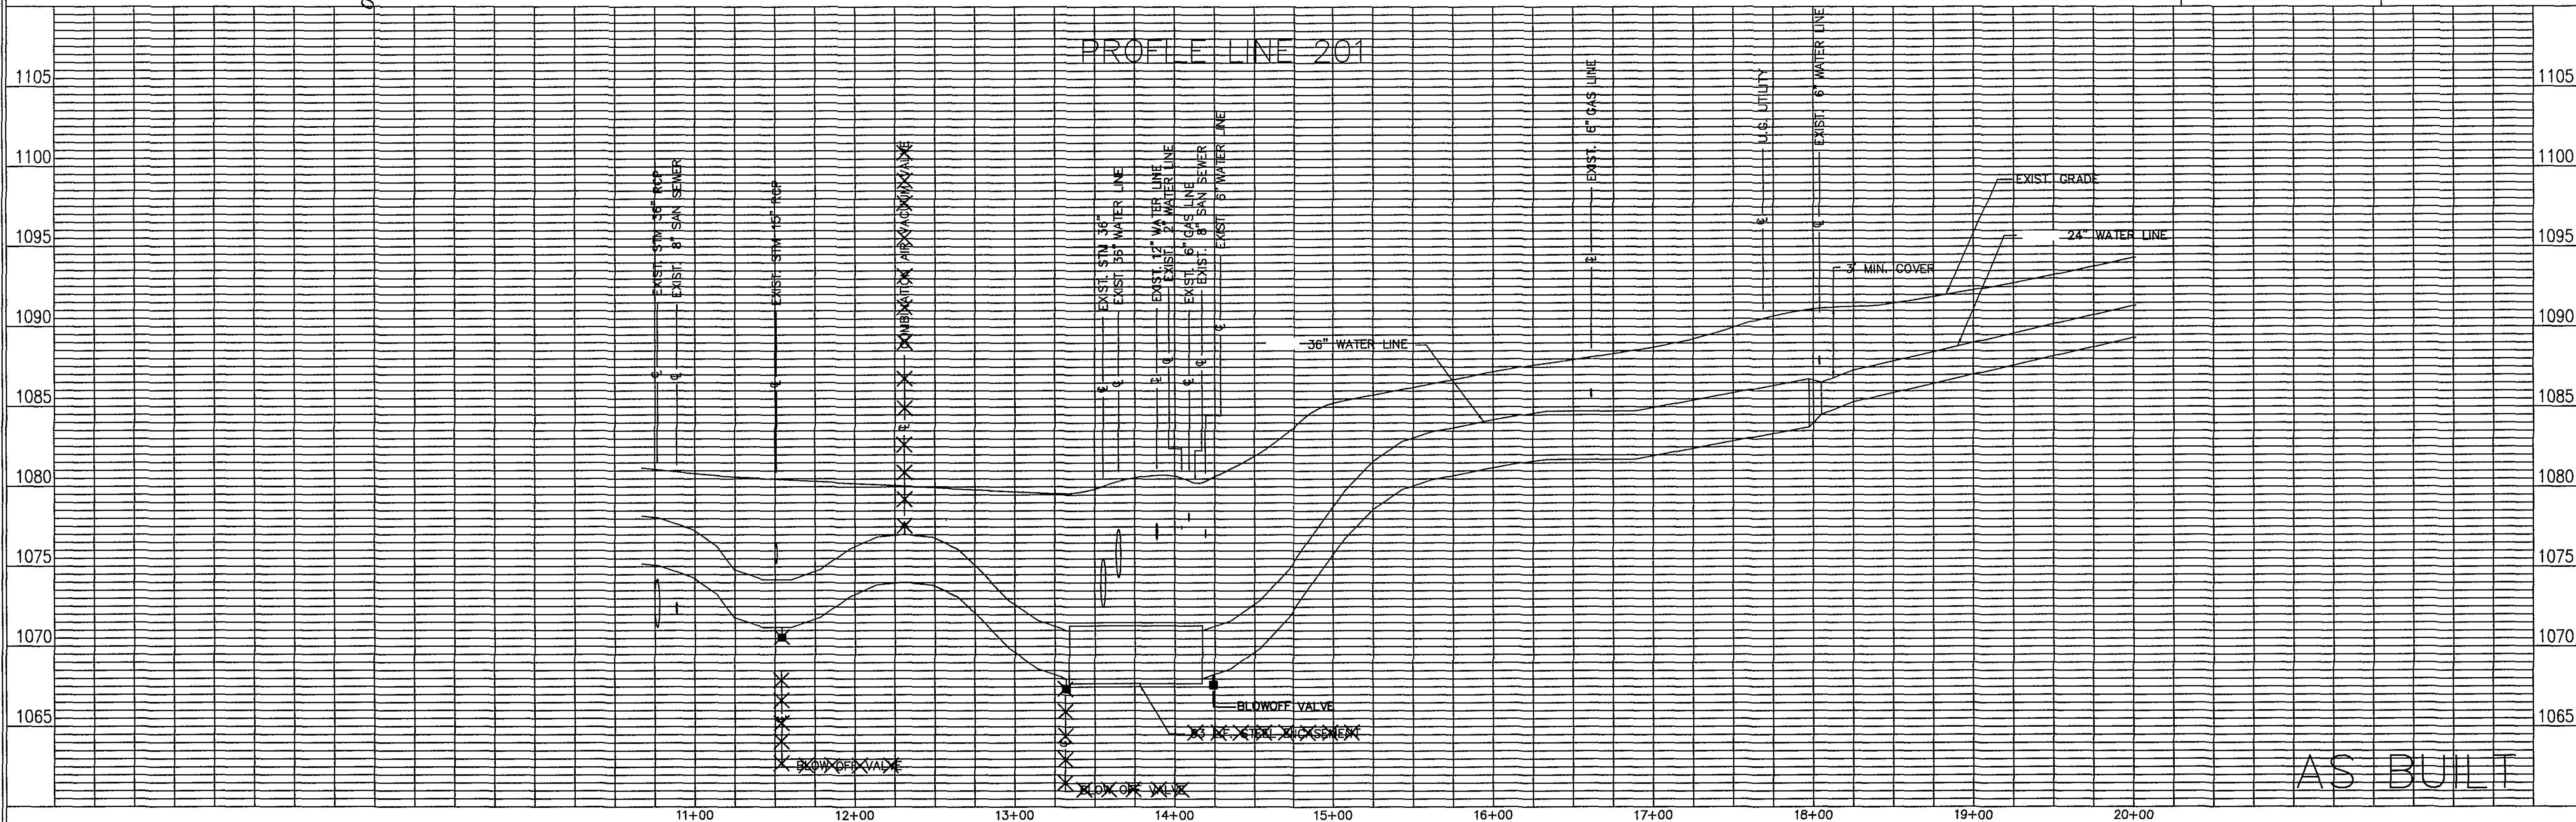

 Architects Engineers Planners Surveyors 5238 Valleypointe Parkway, Suite One-B Roanoke, Virginia 24019 703 362-7725	Carvins Cove, Phase II City of Roanoke Roanoke, Virginia	CONTRACT "B1" LINE 201 STA 10+66.92 - 20+01.23	Drawn By REH/ACF Designed By RBS Checked By SEH Date MAY 93 Scale V: 1" = 5' H: 1" = 50' Plan Number A11 Zoned NONE Sheet 18 of 25 File Number C1160
---	--	--	--