



THIS SHEET
1097 LF 24" WATERMAIN
1 EA. 1" A.R.V.

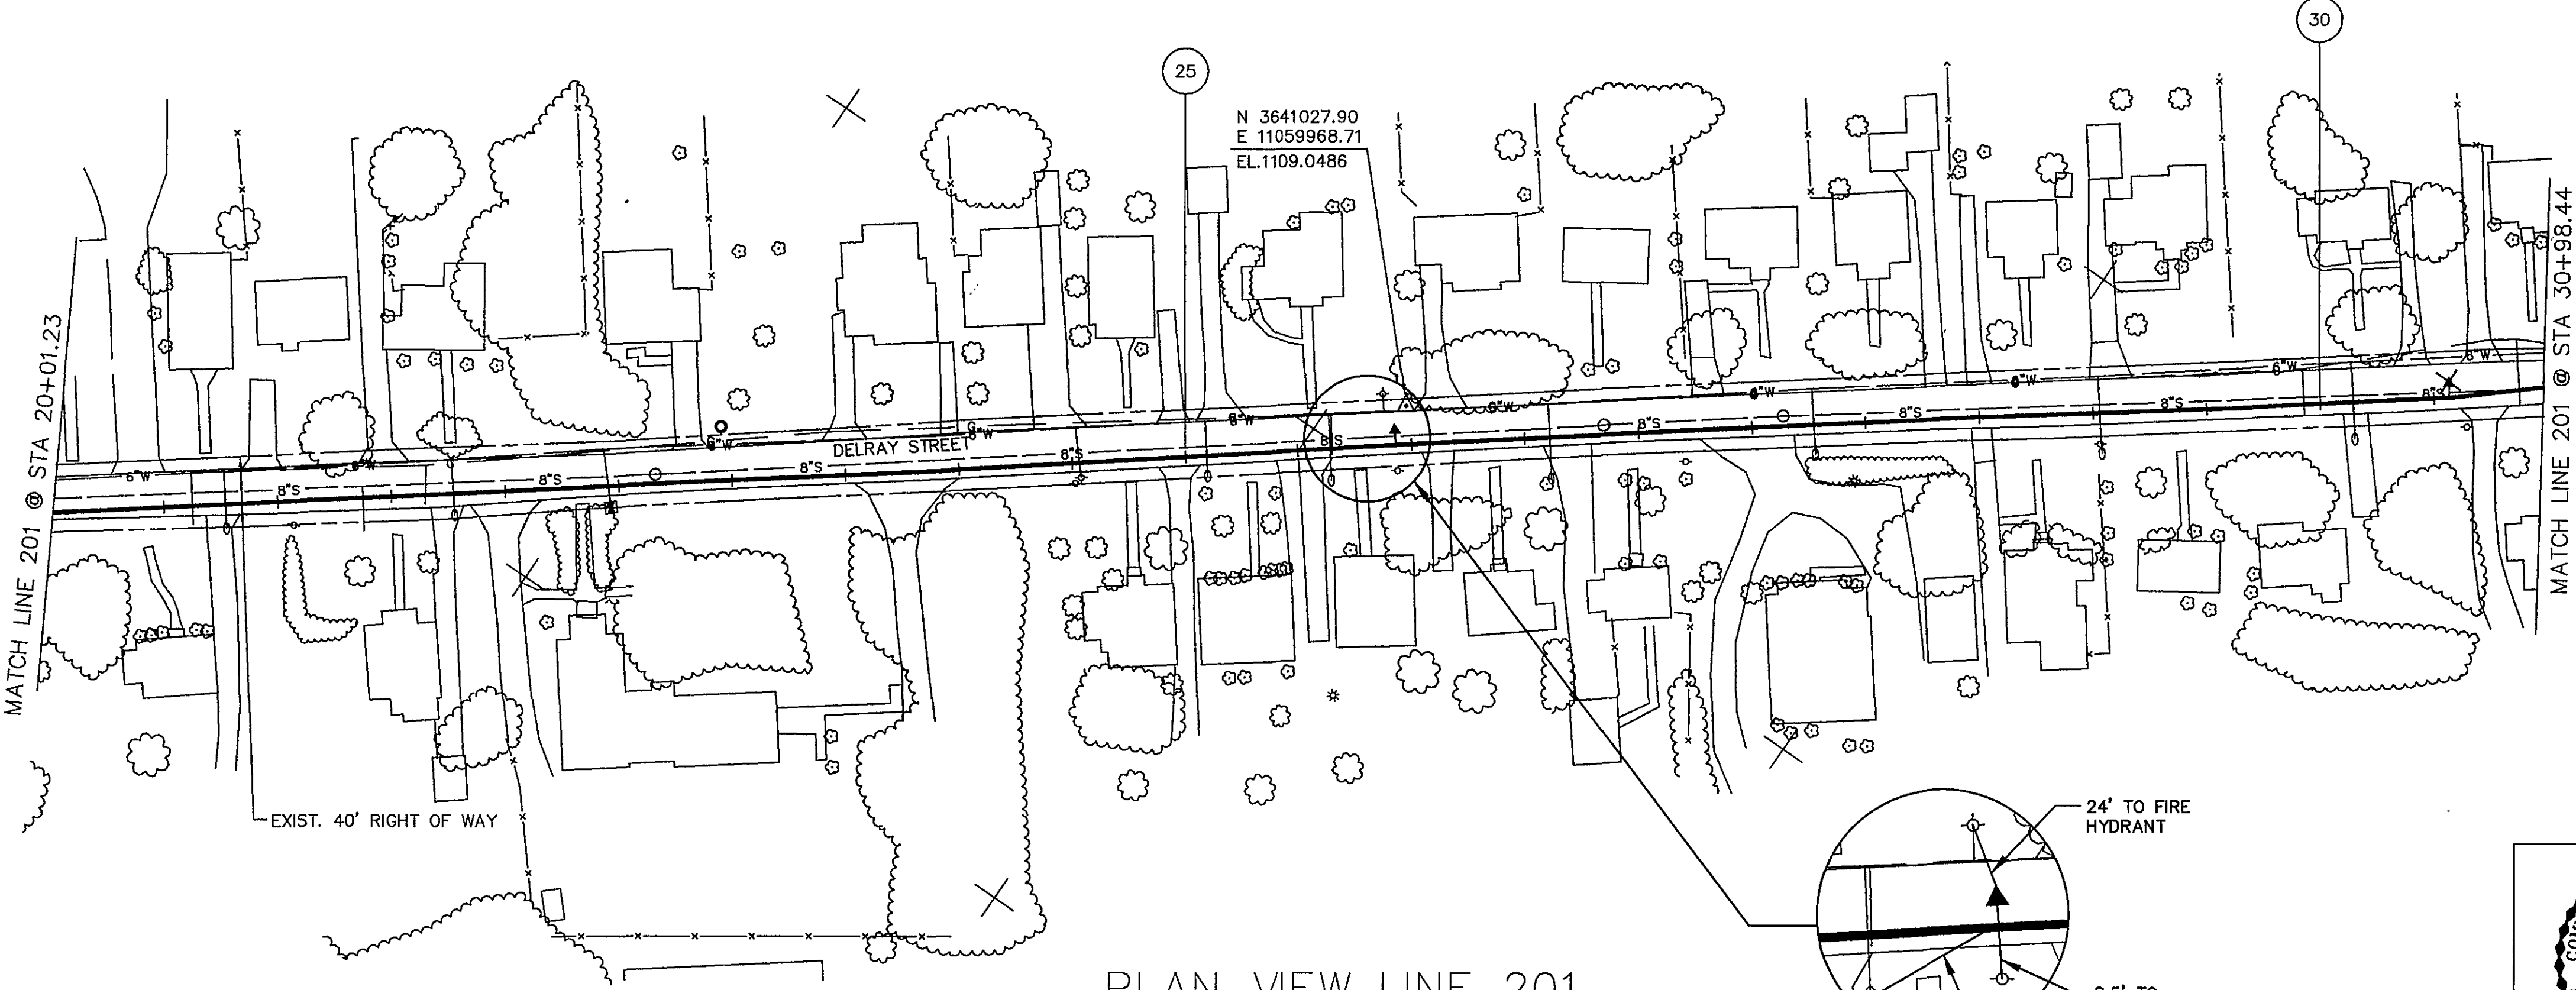

PLAN VIEW LINE 201

ENGINEER'S SEAL	ENGINEER'S SEAL

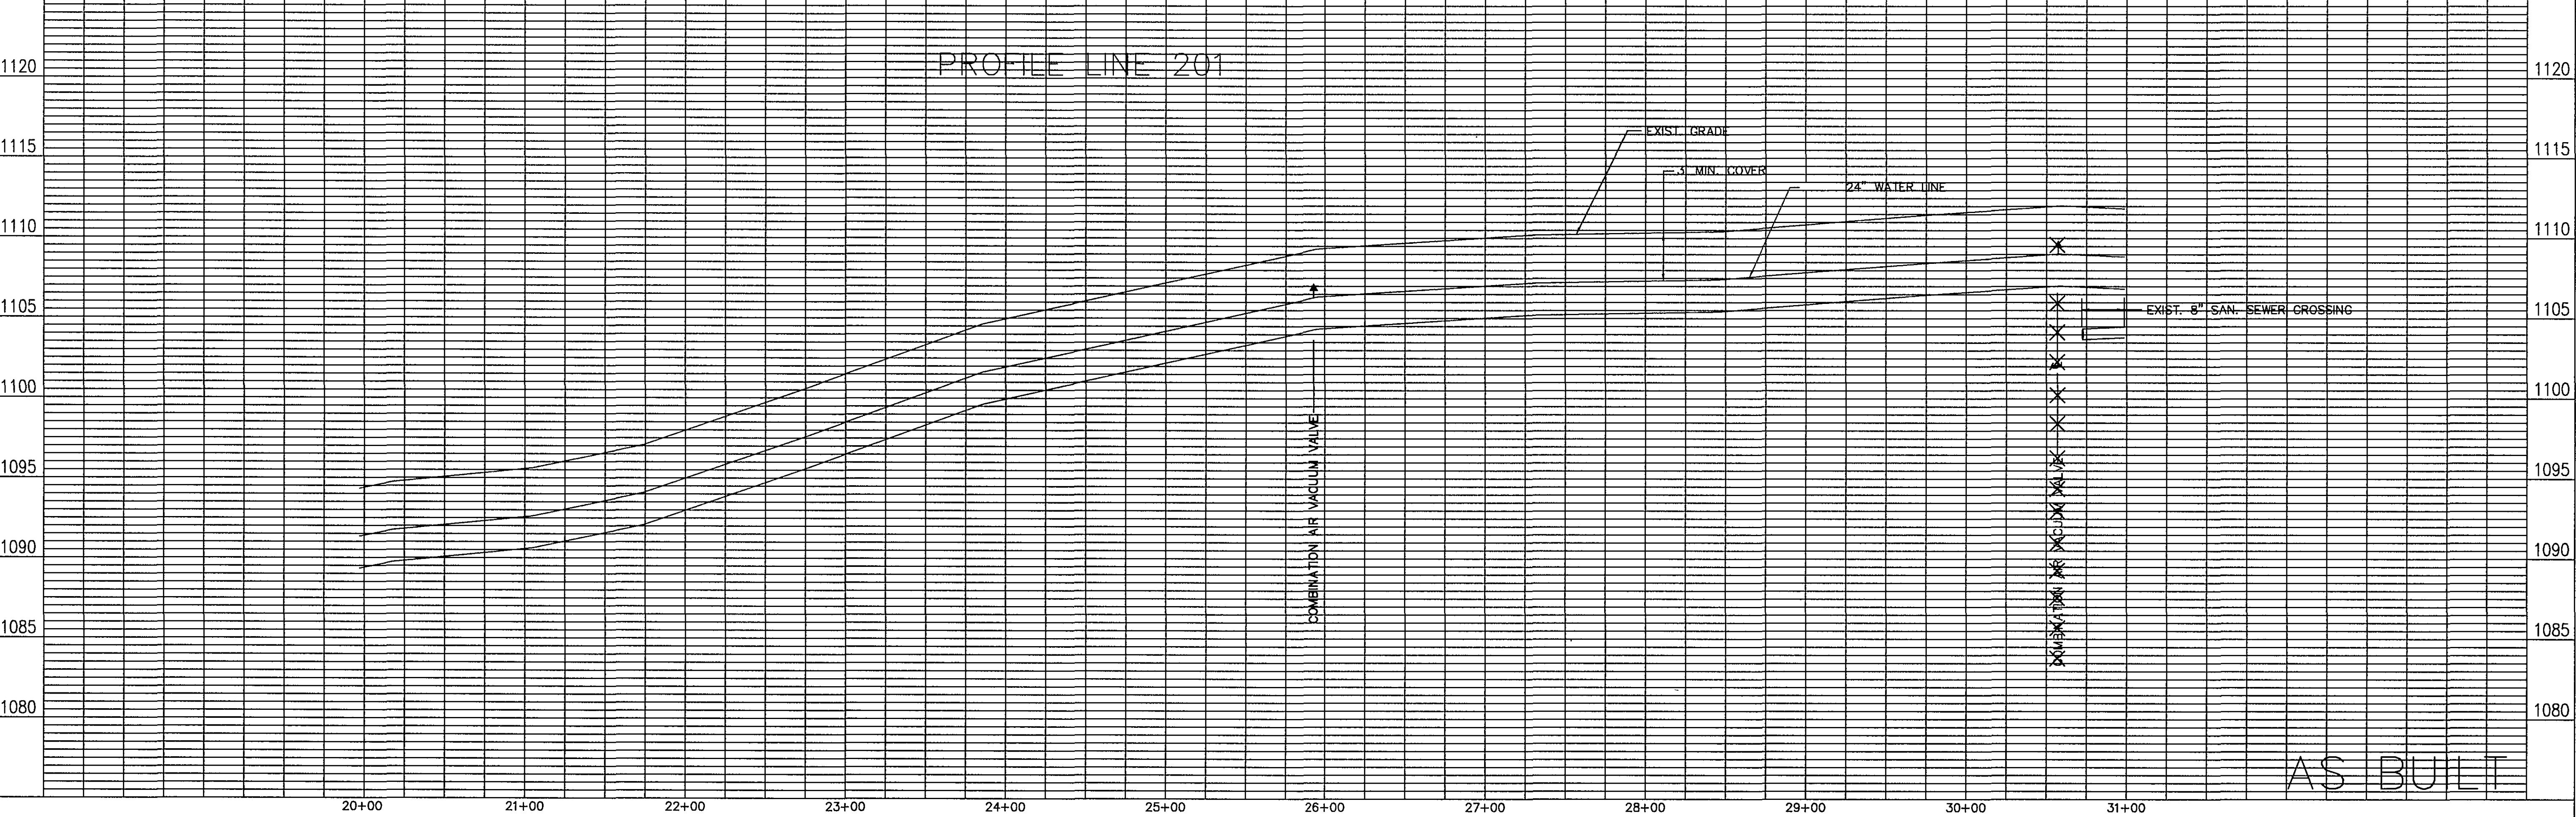

PROFILE LINE 201

Dewberry & Davis
Architects
Engineers
Planners
Surveyors
5238 Valleypointe Parkway, Suite One-B
Roanoke, Virginia 24019
703 562-7725

Carvins Cove, Phase II
City of Roanoke
Roanoke, Virginia

CONTRACT "B1"
LINE 201
STA 20+01.23 - 30+98.44

Drawn By REH/ACF
Designed By RBS
Checked By SEH
Date MAY 93
Scale V: 1" = 5'
H: 1" = 50'
Plan Number A12
Zoned NONE
Sheet 19 of 25
File Number C1160