

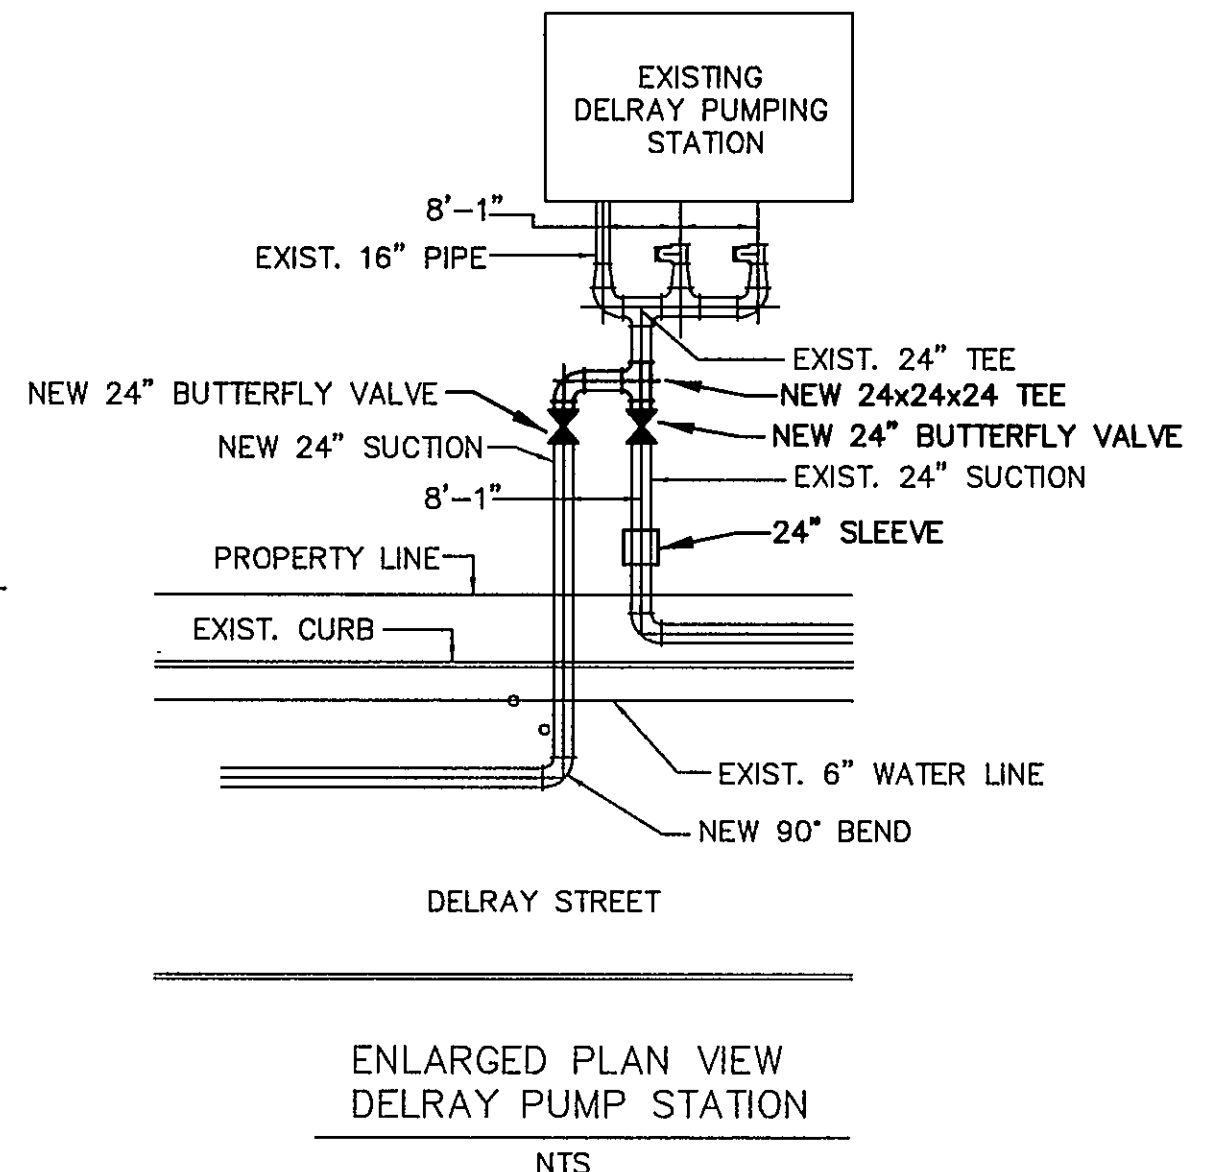
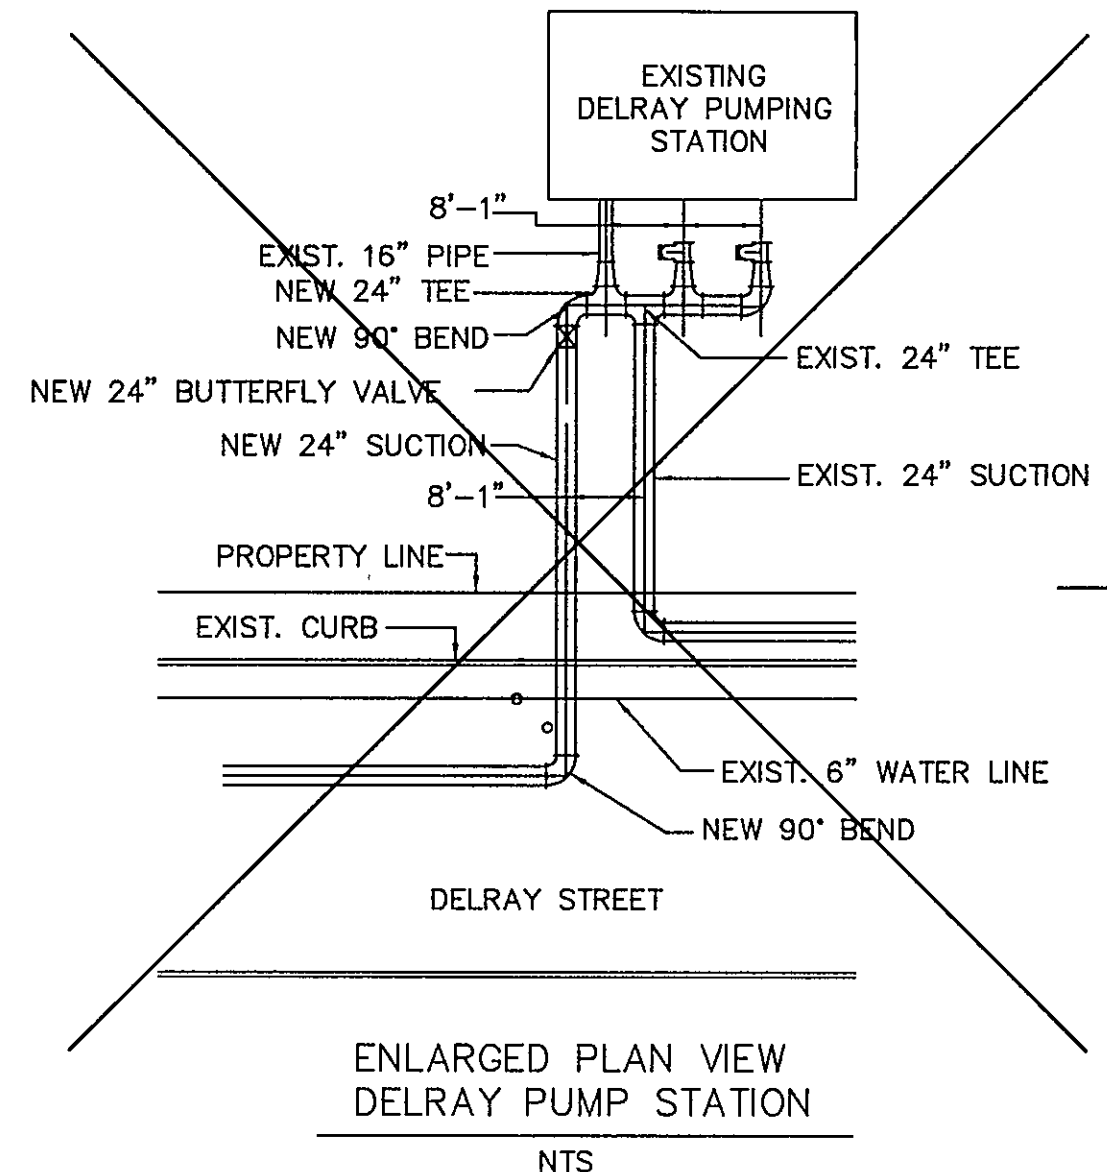


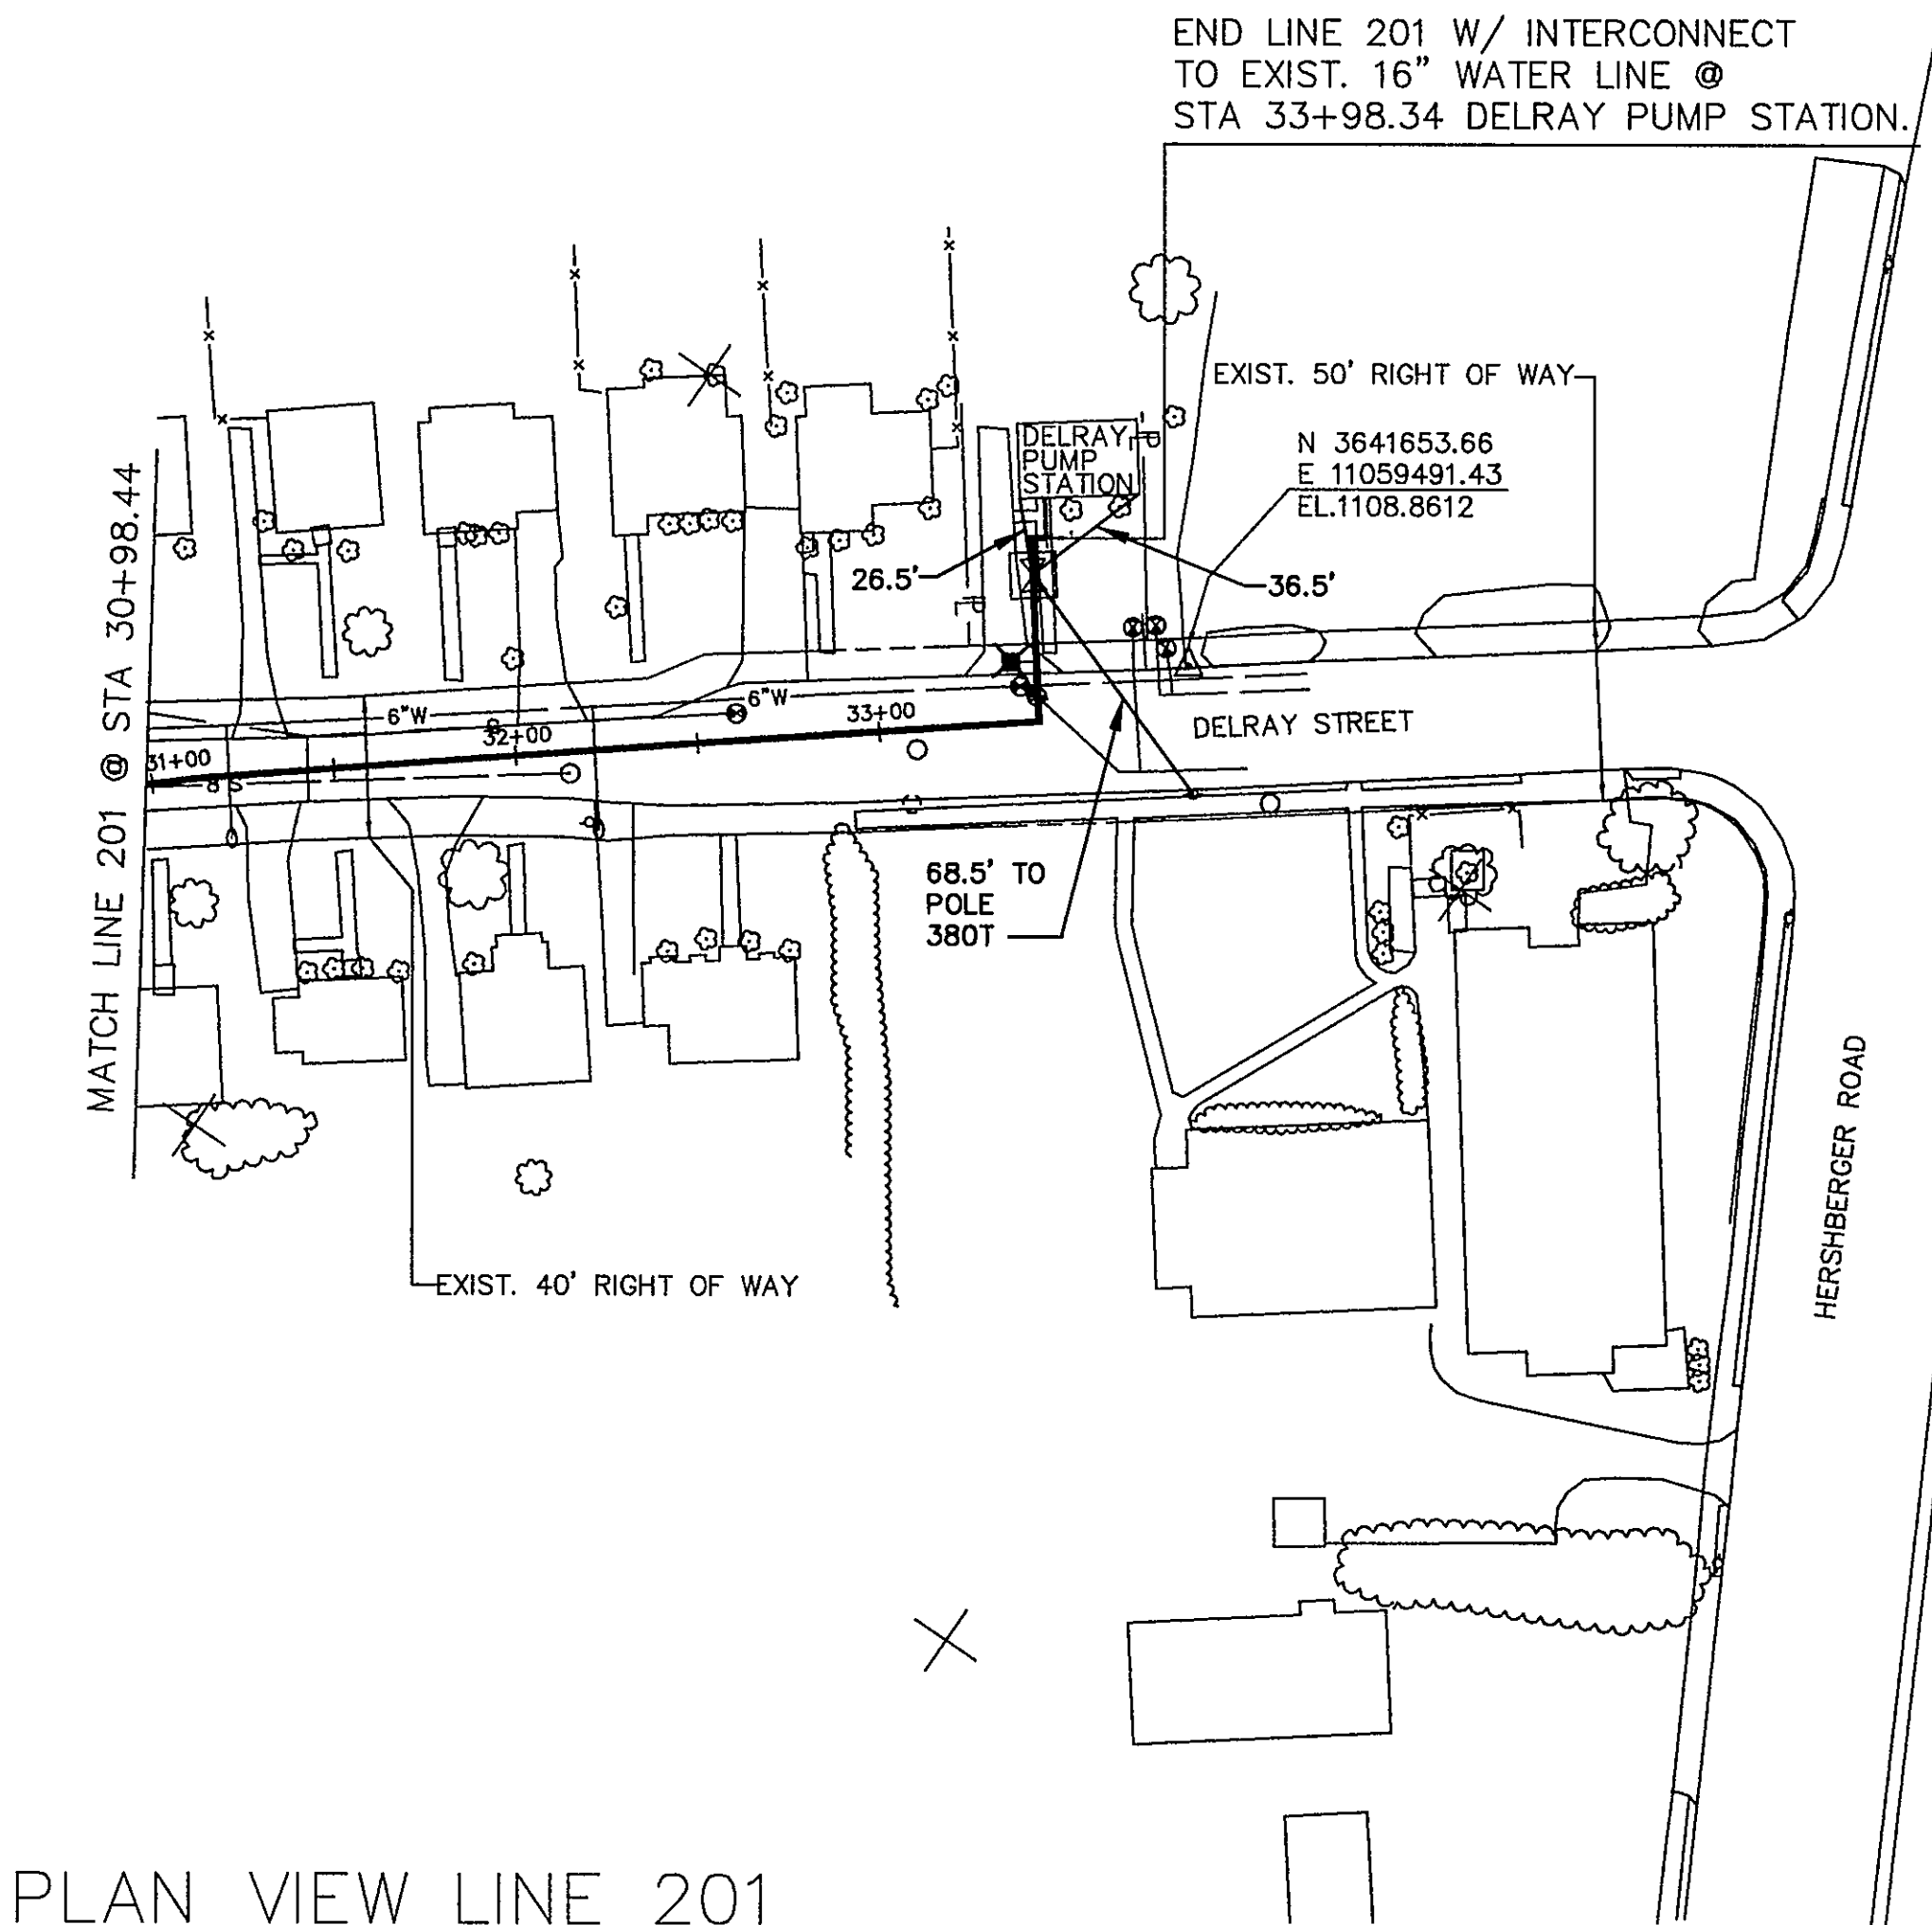

 ENGINEER'S SEAL	 ENGINEER'S SEAL
---------------------	---------------------

PROFILE LINE 201

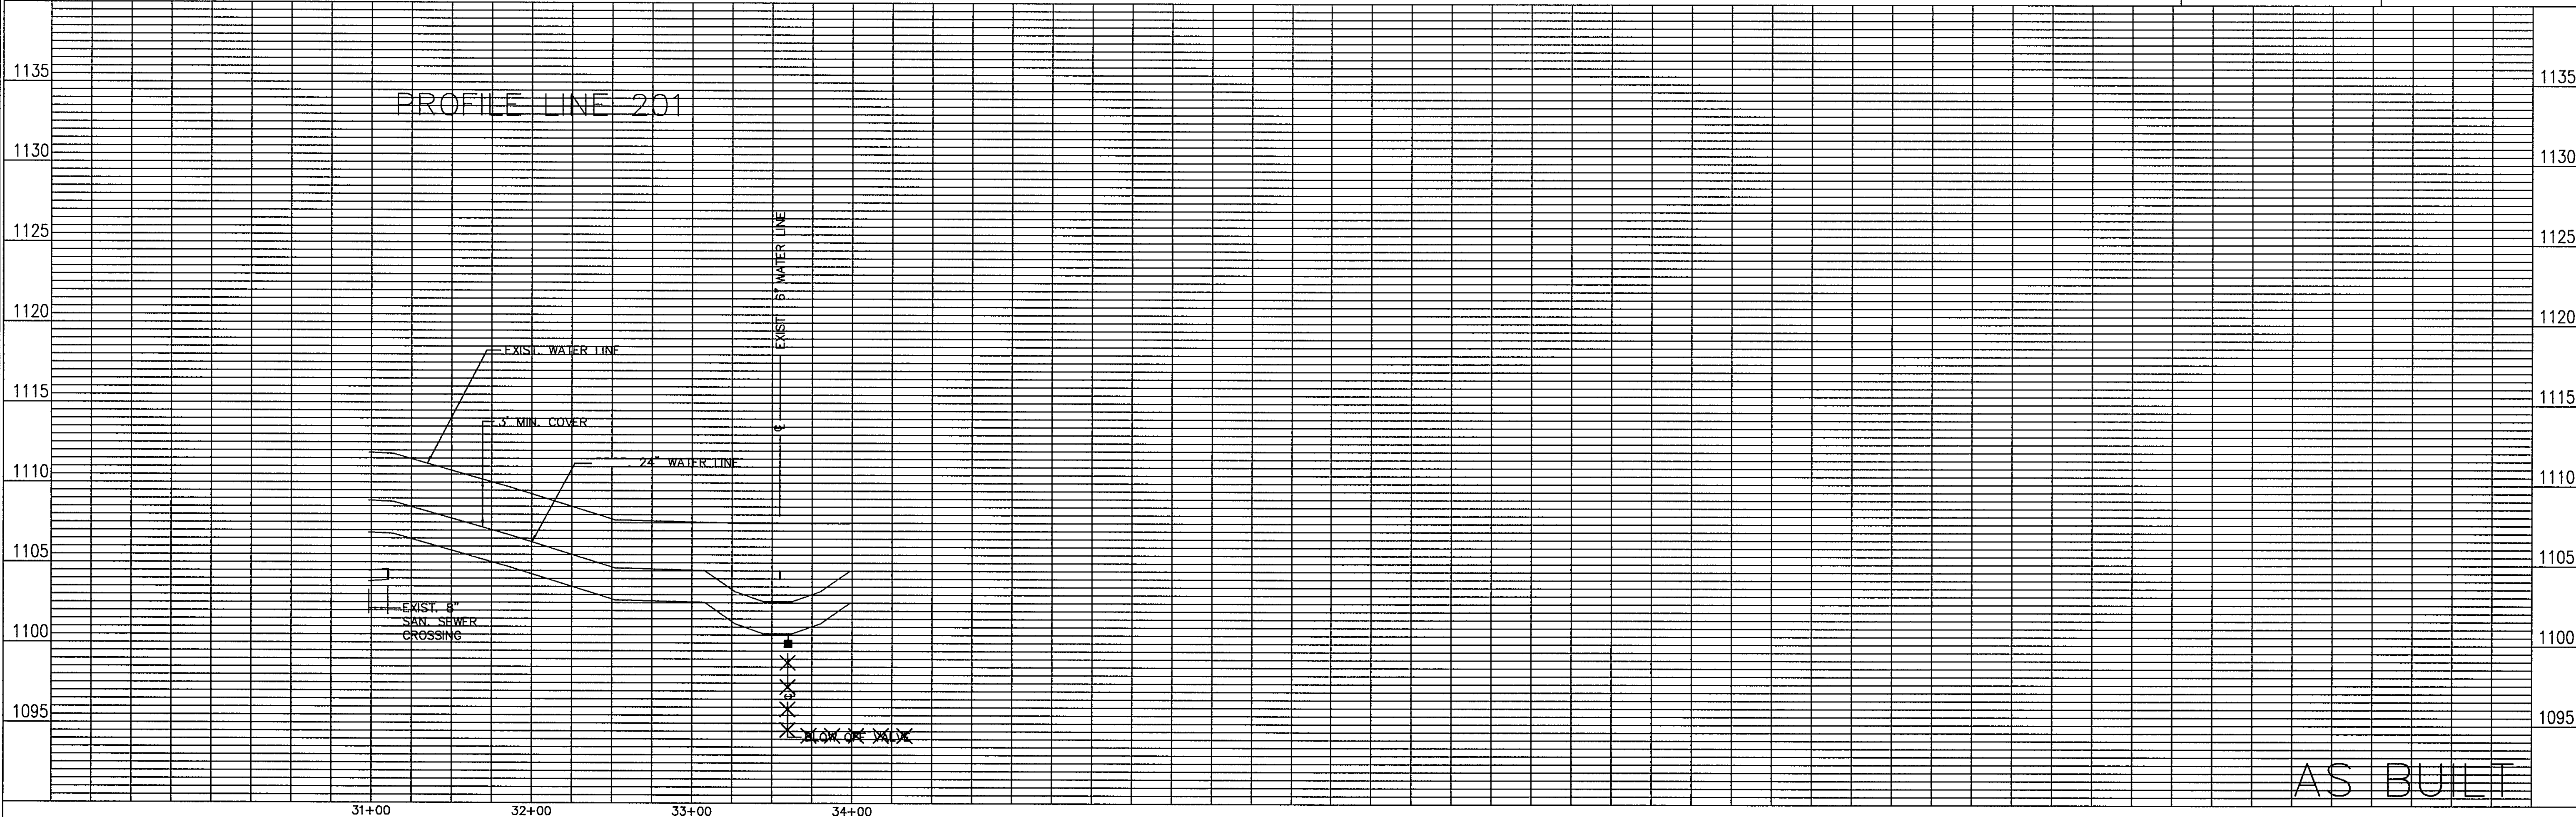

AS BUILT

Dewberry & Davis Architects Engineers Planners Surveyors 5238 Valleypointe Parkway, Suite One-B Roanoke, Virginia 24019 ☎ 703 362-7726	Carvins Cove, Phase II City of Roanoke Roanoke, Virginia	CONTRACT "B1" END LINE 201 DELRAY PUMP STATION STA 30+98.44 - 33+98.34	Drawn By REH/ACF
			Designed By RBS
			Checked By SEH
			Date MAY 93
Scale V: 1" = 5' H: 1" = 50'	Plan Number A13	Zoned NONE	Sheet 20 of 25
File Number C1160			