

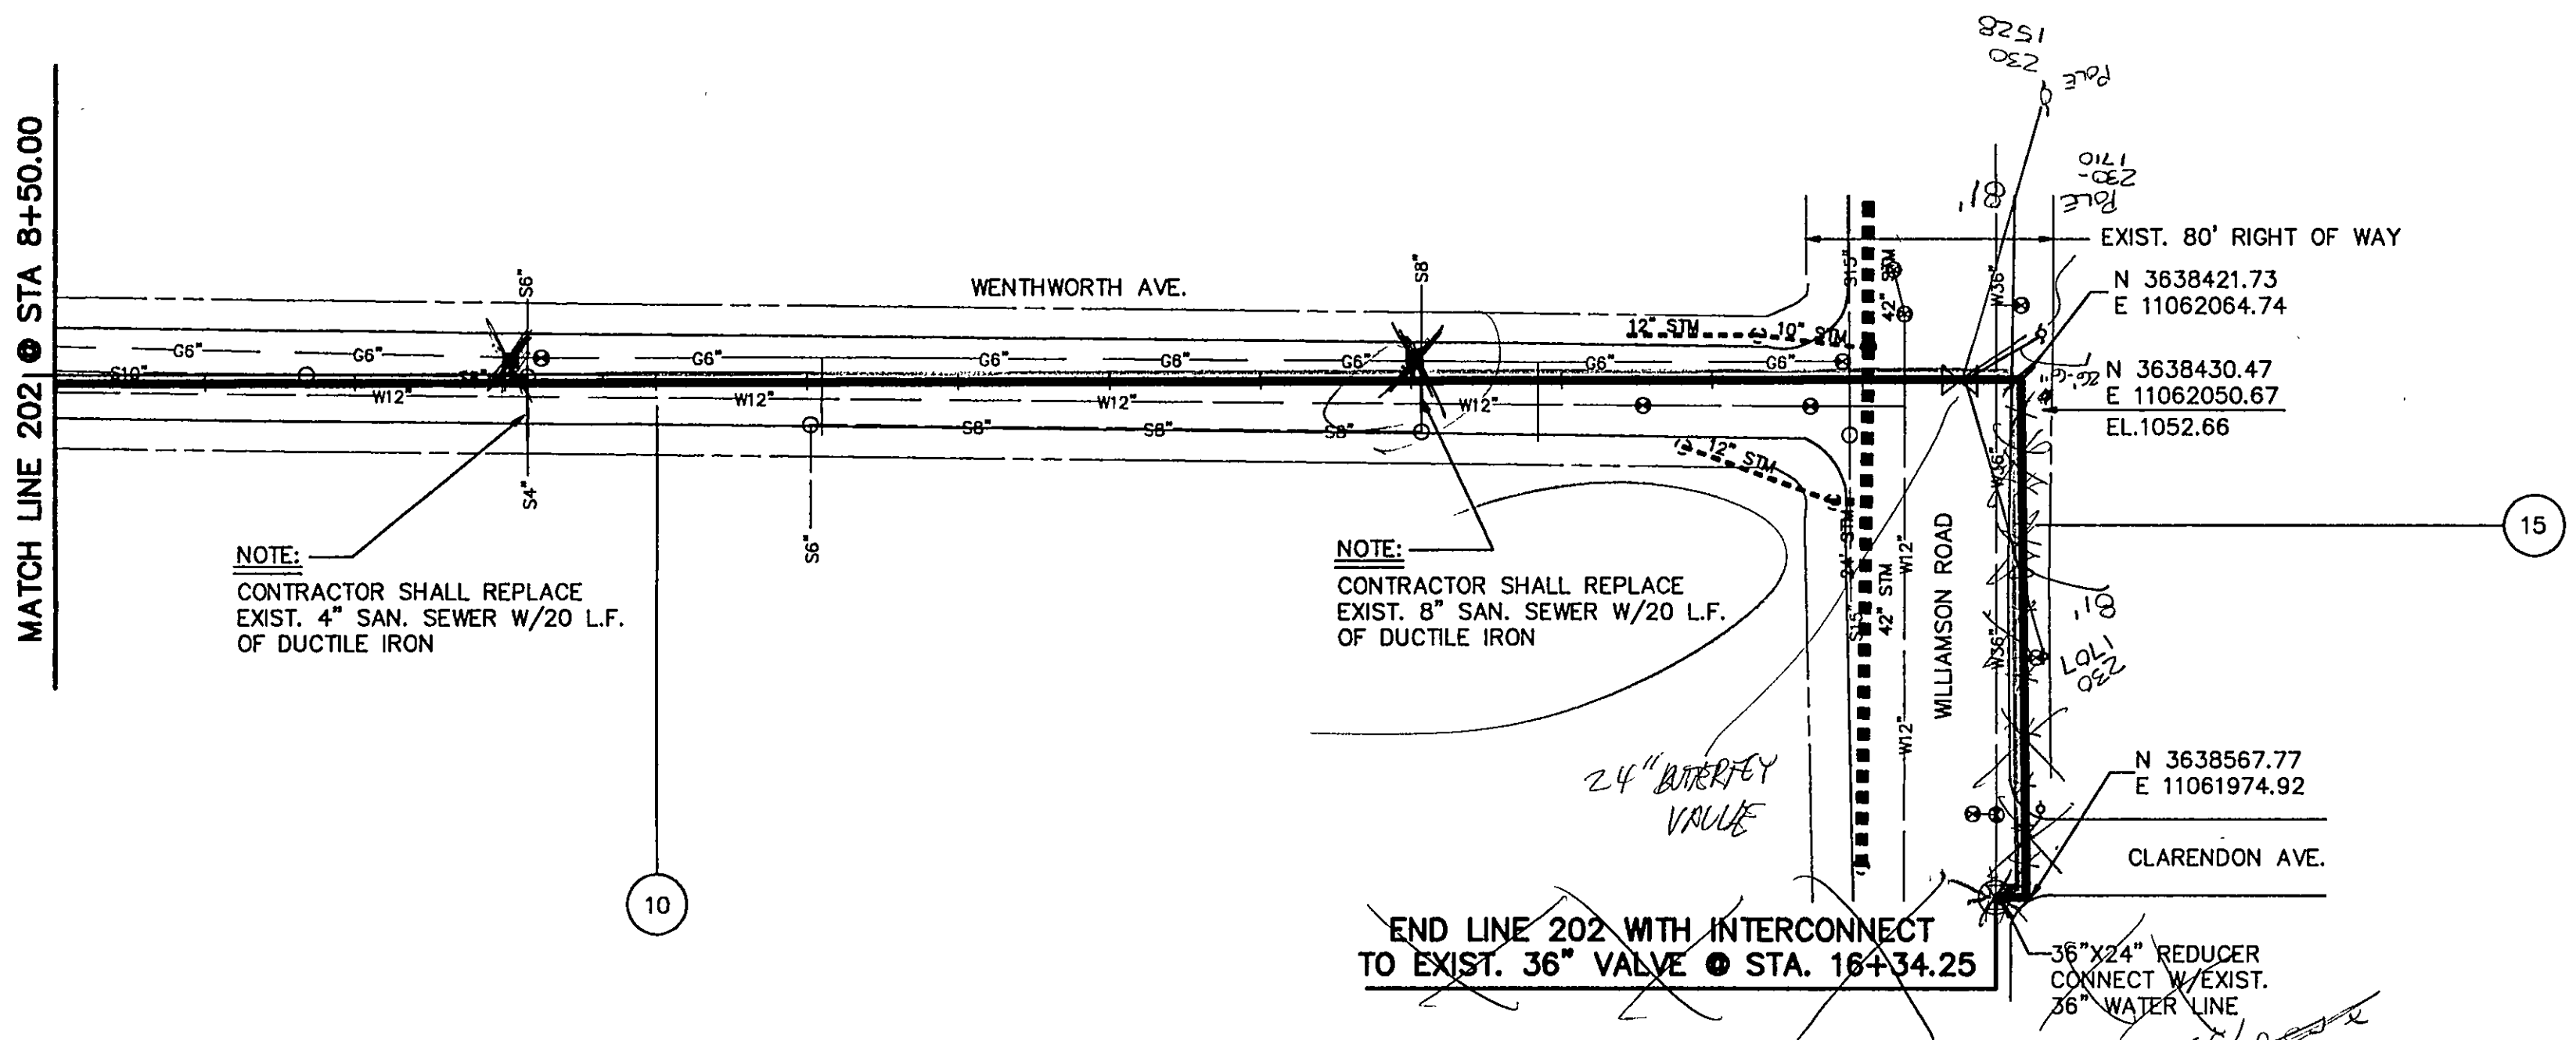
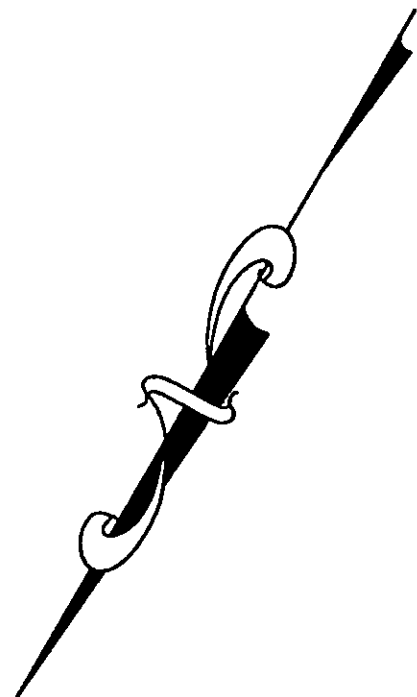
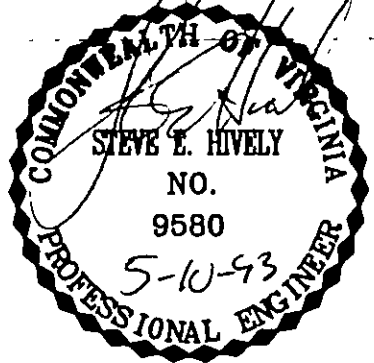


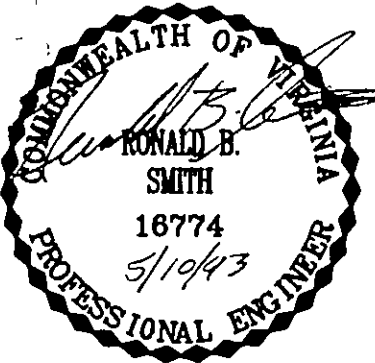

PLAN VIEW LINE 202

600 LF 24" WATERMAIN
1 EA 24" ~~SEWER~~
TRAPPING VALVE

 ENGINEER'S SEAL	 ENGINEER'S SEAL
---	---

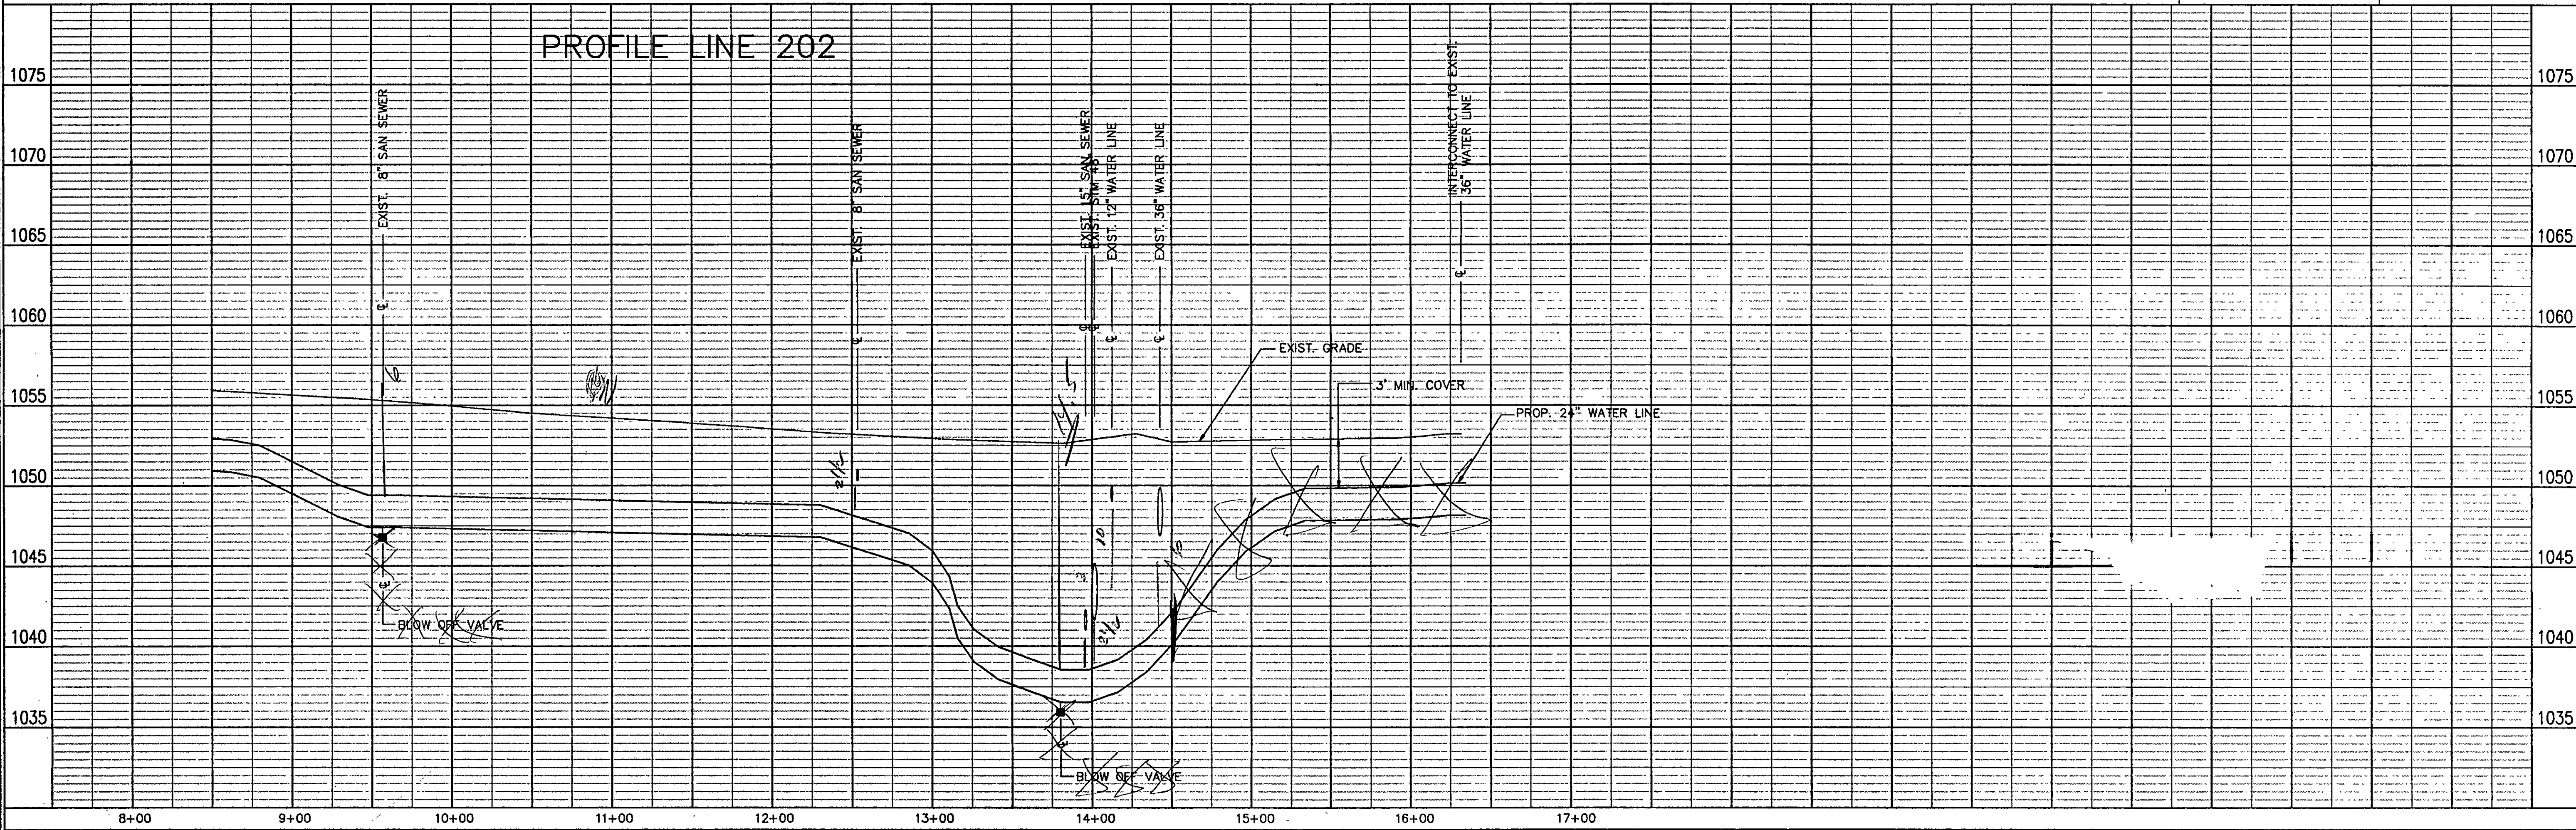

 Architects Engineers Planners Surveyors 5238 Valleypointe Parkway, Suite One-B Roanoke, Virginia 24019 ☎ 703 362-7725	Carvins Cove, Phase II City of Roanoke Roanoke, Virginia	CONTRACT "B1" END LINE 202 STA 8+50.00 - 16+34.25
	Drawn By REH/ACF Designed By RBS Checked By SEH Date MAY 93 Scale V: 1" = 5' H: 1" = 50' Plan Number A2B Zoned NONE Sheet 22 of 25 File Number C1160	