

CARVINS COVE PHASE II

WATER IMPROVEMENTS PROJECT



CONTRACT B2

ROANOKE, VIRGINIA

AS BUILT


VICINITY MAP

NOT TO SCALE

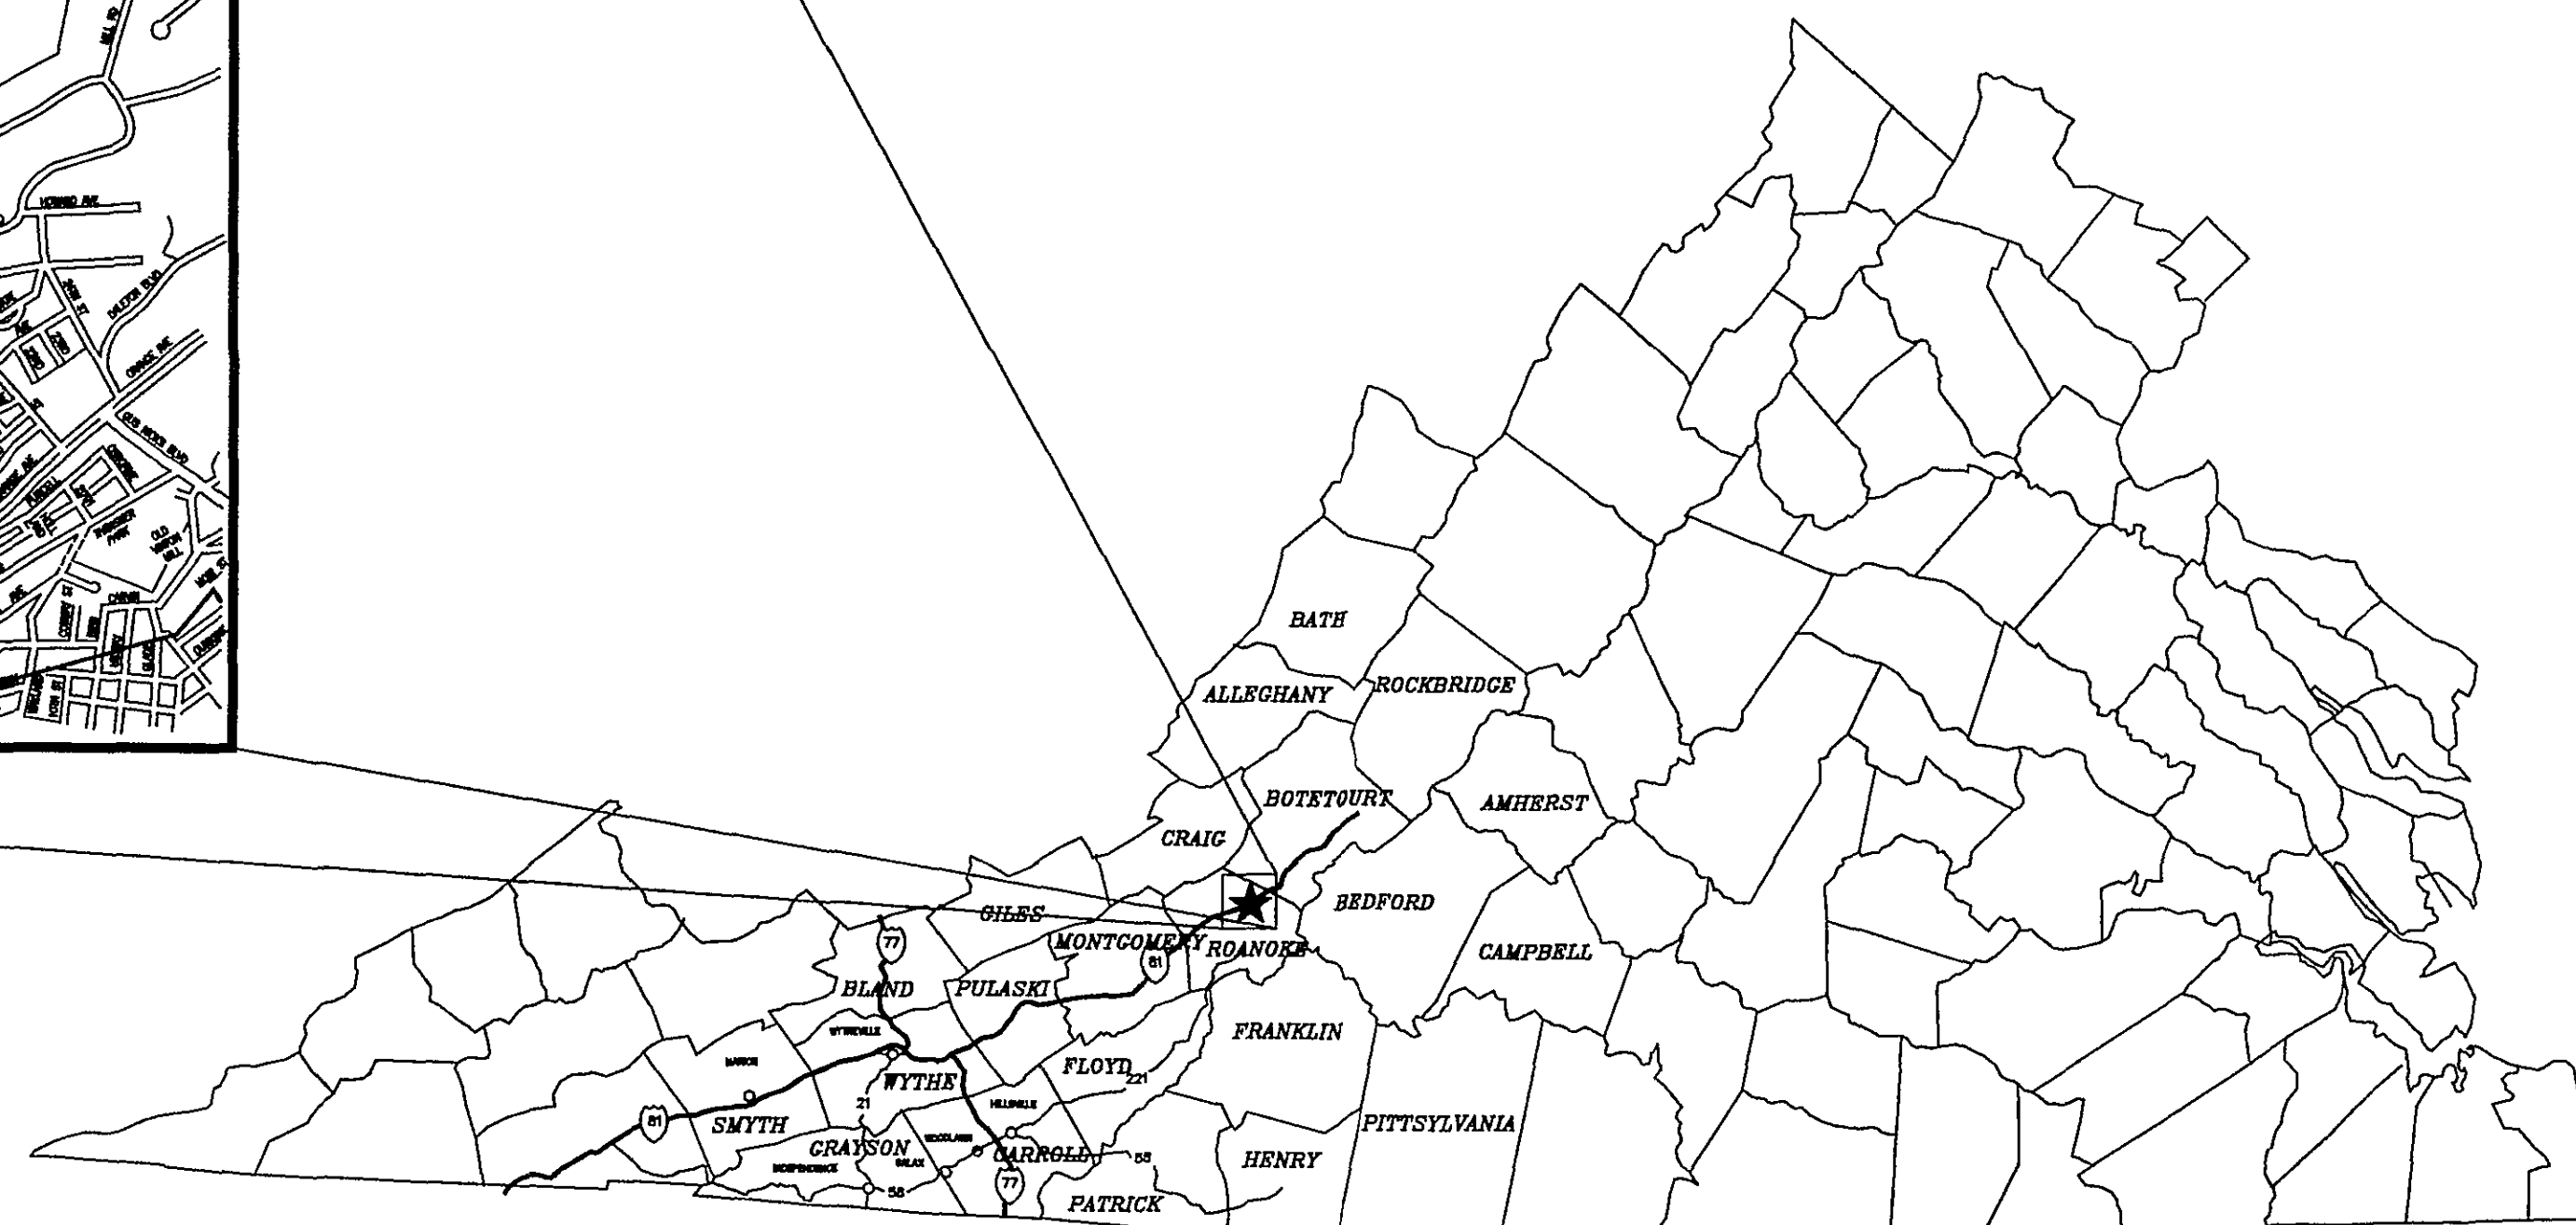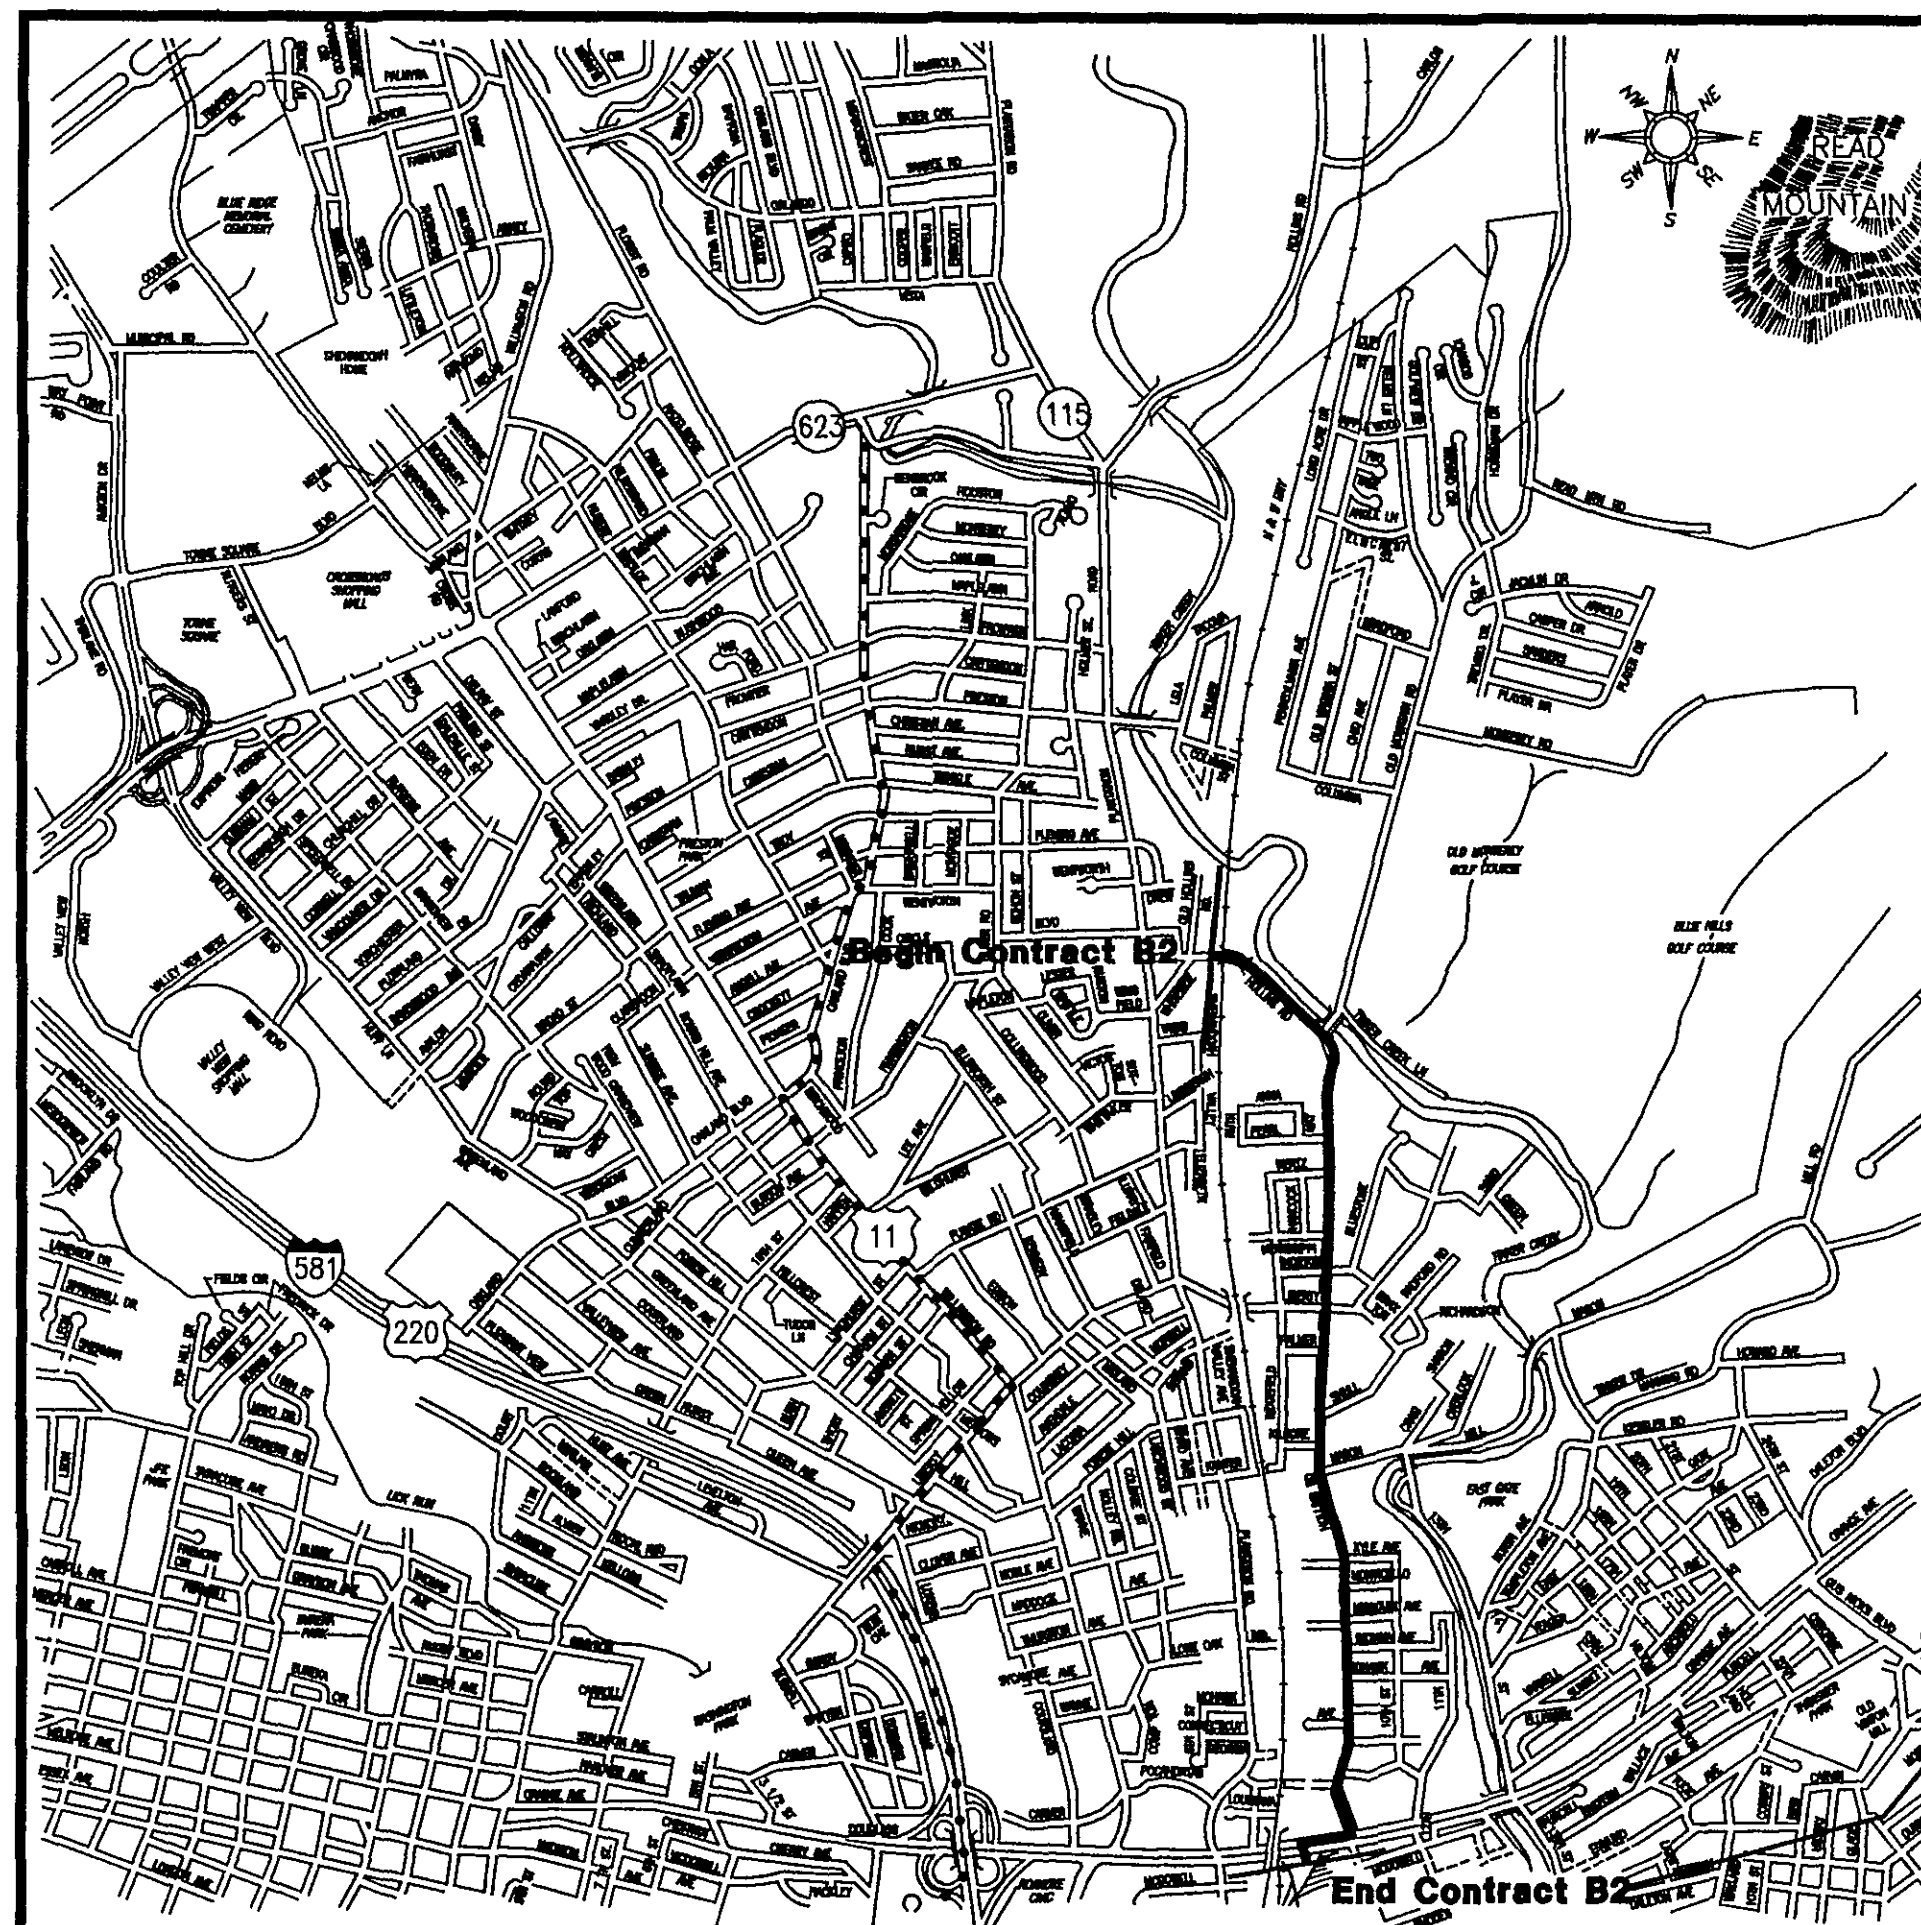

INDEX OF SHEETS

SHEET	TITLE		
1	LINE 250	0+00.00	5+93.92
2	LINE 250	5+93.92	17+87.11
3	LINE 250	17+87.11	29+89.44
4	LINE 250	29+89.44	42+26.04
5	LINE 250	42+26.04	54+68.01
6	LINE 250	54+68.01	68+24.64
7	LINE 250	68+24.64	83+27.56
8	LINE 250	83+27.56	95+60.59
9	LINE 250	95+60.59	103+19.39
10	LINE 202	0+00.00	6+53.22
11	LINE 202	6+53.22	17+76.00
12	LINE 202	17+76.00	30+99.66
13	LINE 202	30+99.66	44+16.79
14	LINE 300	0+00.00	10+88.10
15	LINE 300	10+88.10	23+01.50
16	LINE 300	23+01.50	29+00.00
17	LINE 300	29+00.00	37+70.77
18	LINE 400	0+00.00	11+64.03
19	LINE 400	11+64.03	18+22.33
20	DETAILS		
21	DETAILS		
22	DETAILS/SOIL EROSION/LEGEND		

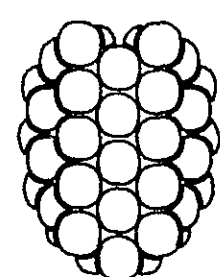


Dewberry & Davis

5238 VALLEYPONTE PARKWAY
SUITE ONE-B
ROANOKE, VIRGINIA 24019
(703) 362-7725


CONTRACT B-2 WATER PLAN #93-23

COMPLETED: 5/10/1995

CONTRACTOR: AARON J. CONNER

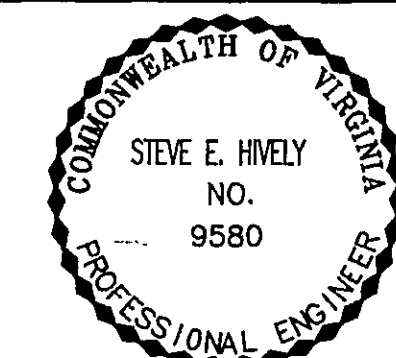

ENGINEER'S SEAL

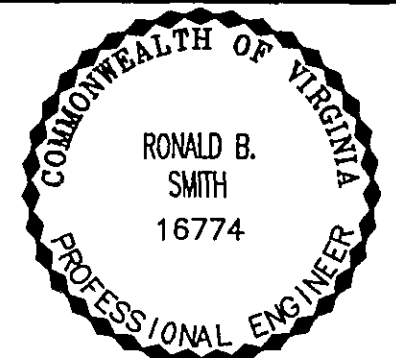

ENGINEER'S SEAL