



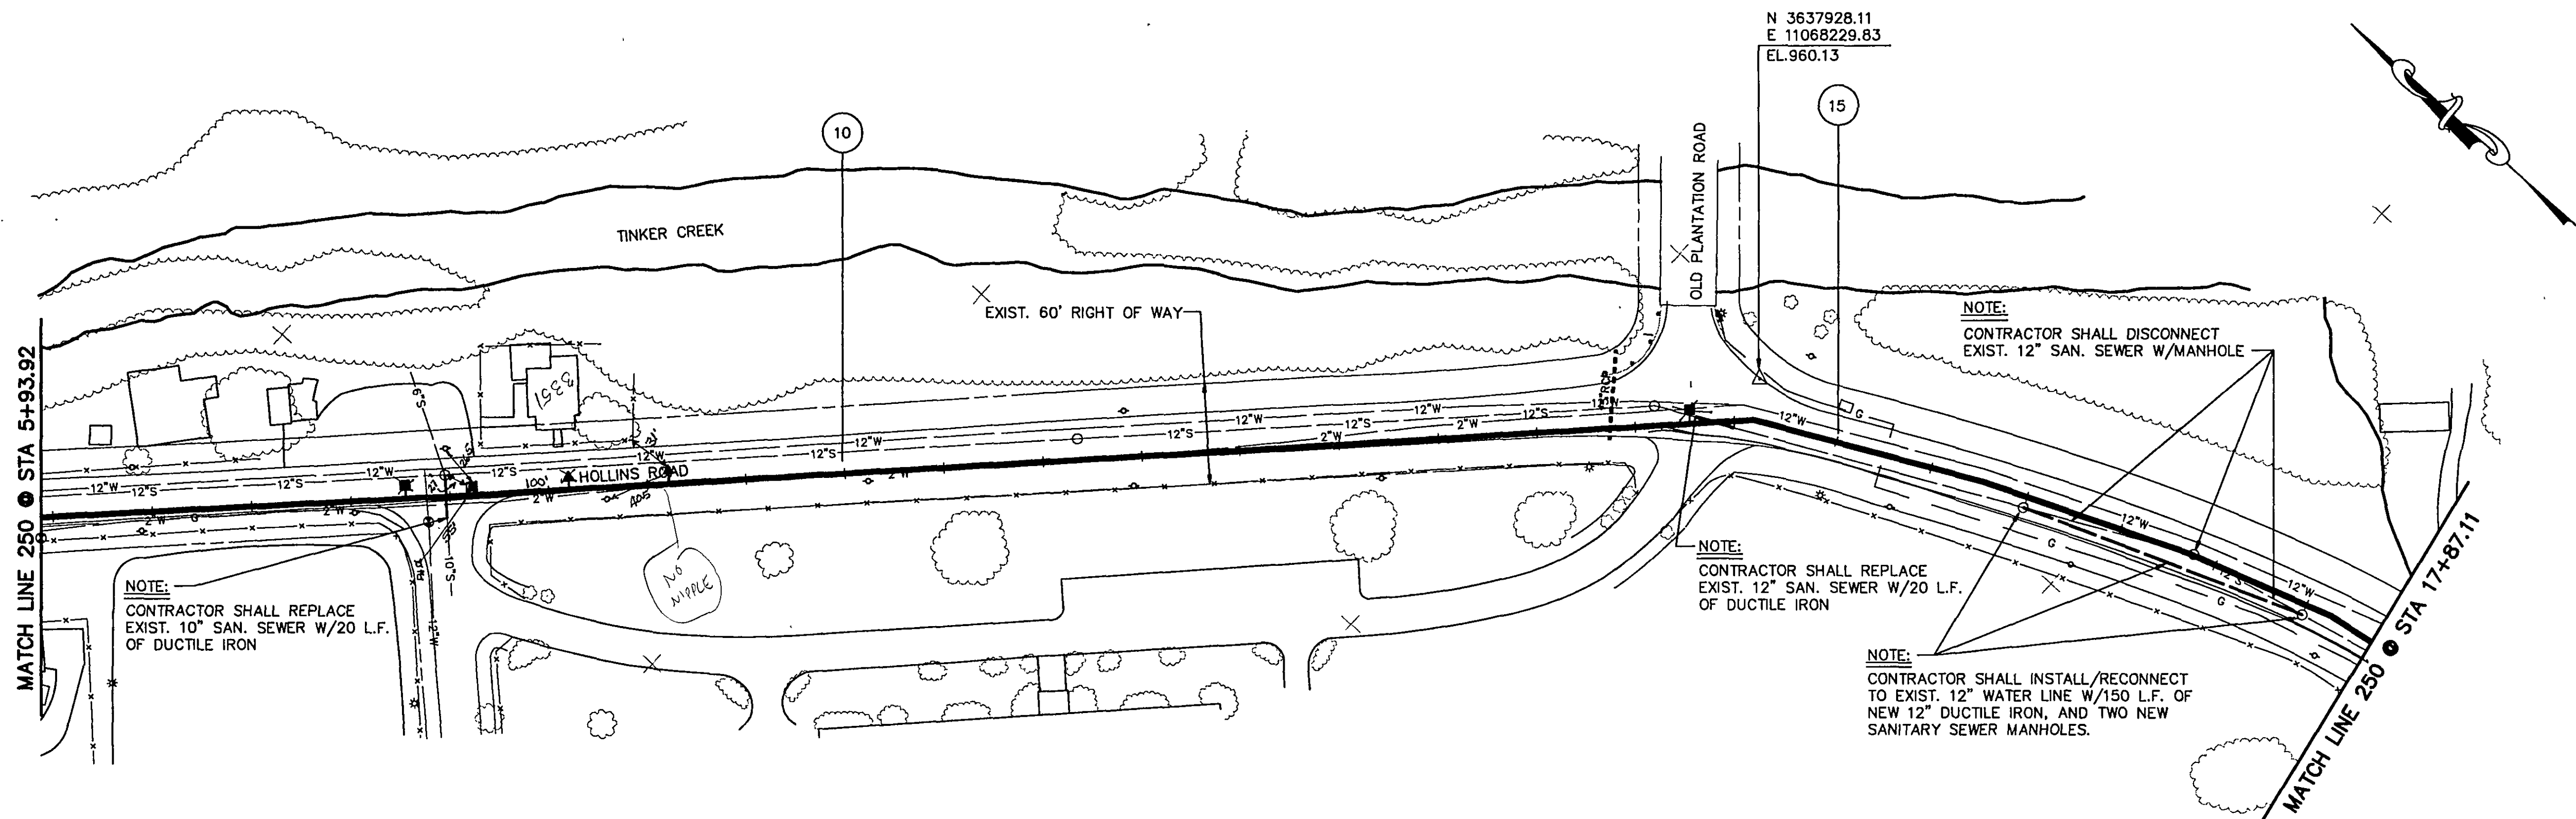

PLAN VIEW LINE 250

ENGINEER'S SEAL	ENGINEER'S SEAL

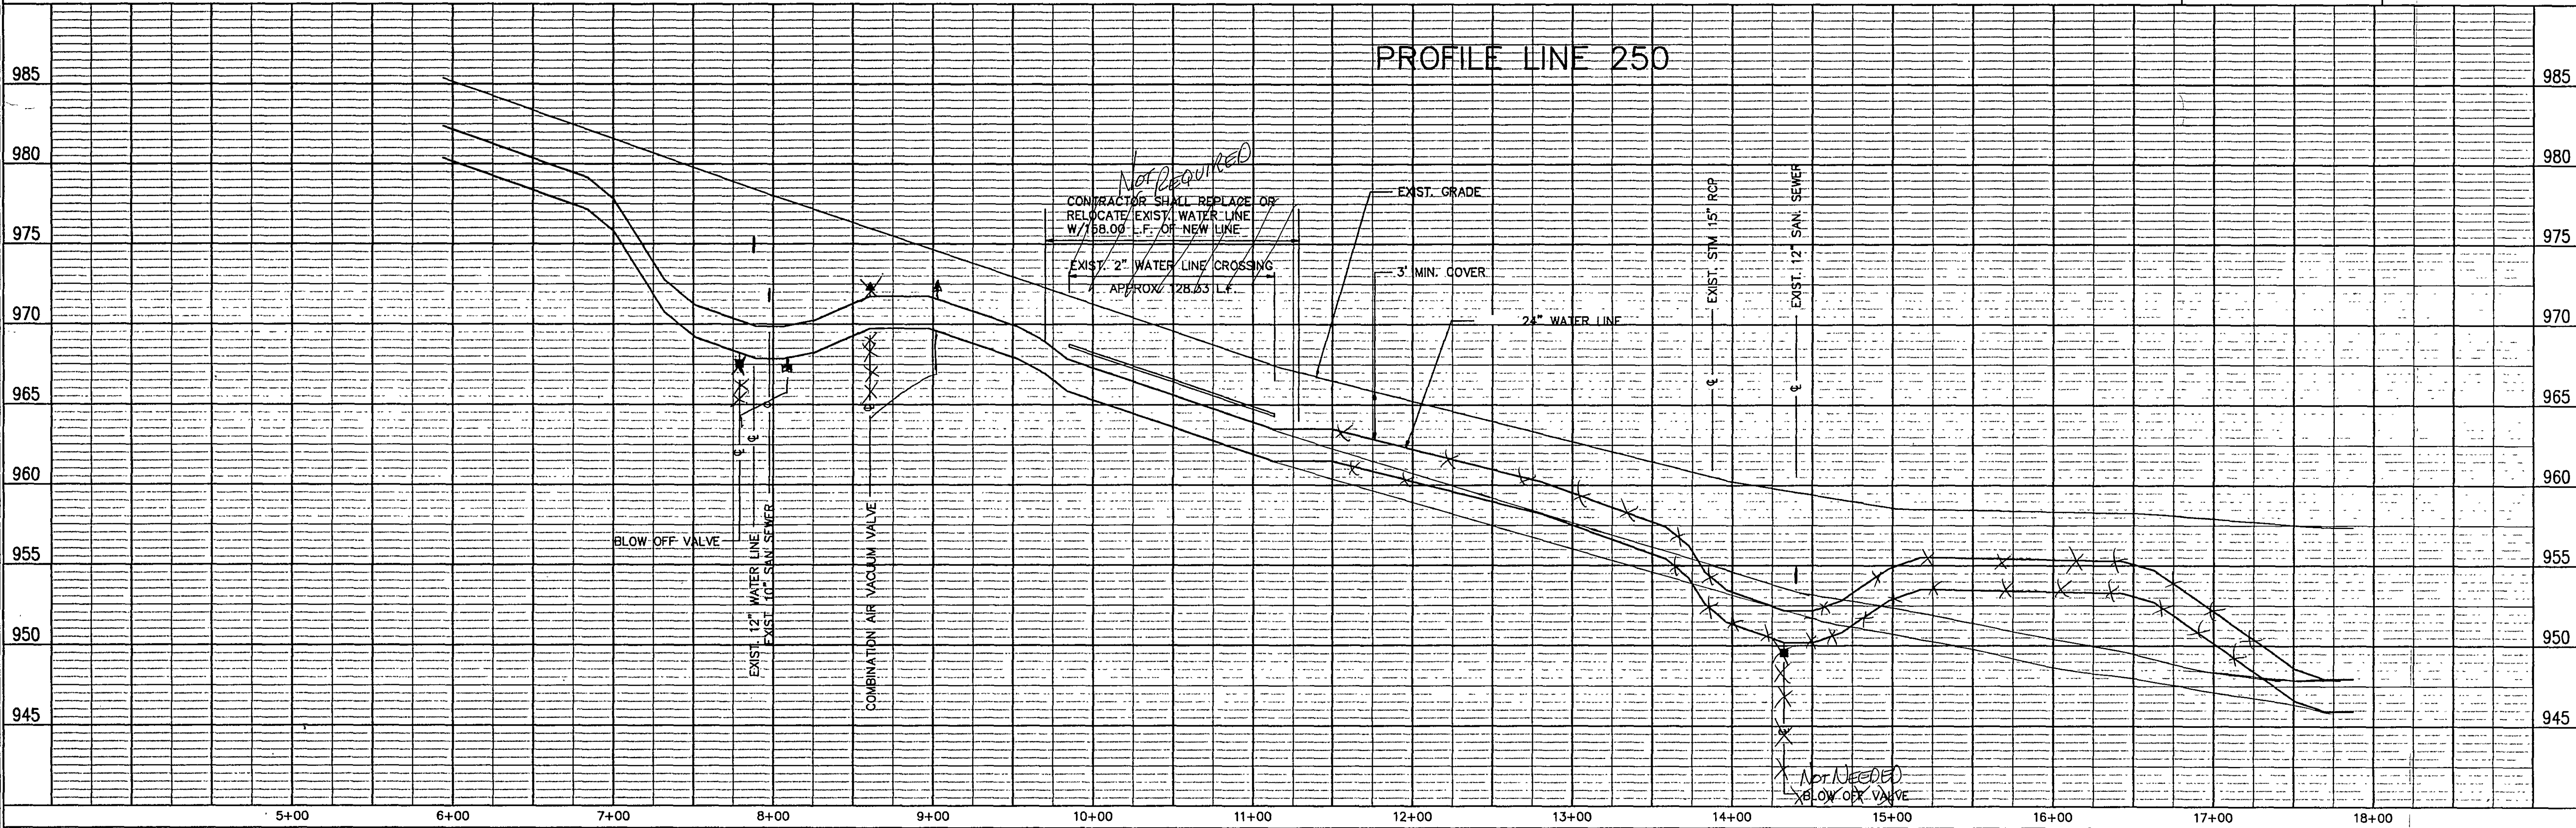

PROFILE LINE 250

Dewberry & Davis Architects Engineers Planners Surveyors 5233 Valleypointe Parkway, Suite One-B Roanoke, Virginia 24019 703 362-7725	Carvins Cove, Phase II City of Roanoke Roanoke, Virginia CONTRACT "B2" LINE 250 STA 5+93.92 - 17+87.11 Drawn By REH/ACF Designed By RBS Checked By SEH Date APRIL 93 Scale V: 1" = 5' H: 1" = 50' Plan Number AB Zoned NONE Sheet 2 of 22 File Number C1160
--	---