



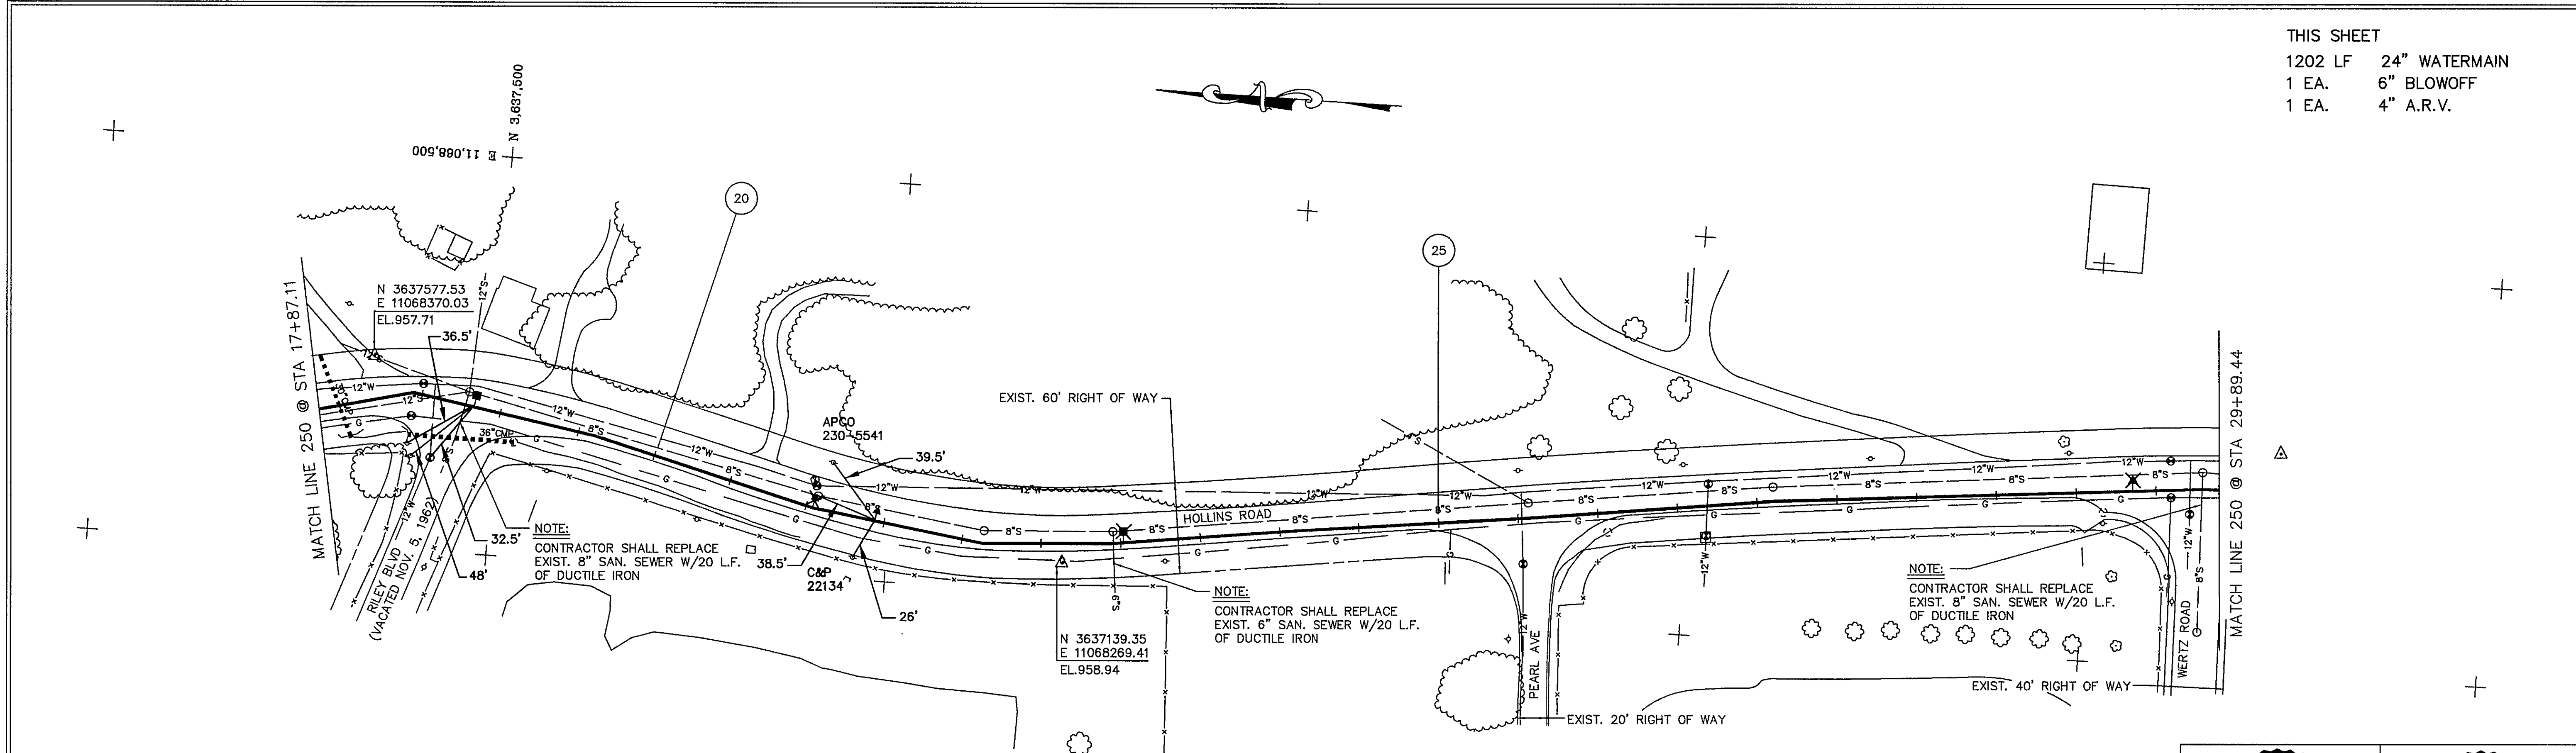


PLAN VIEW LINE 250

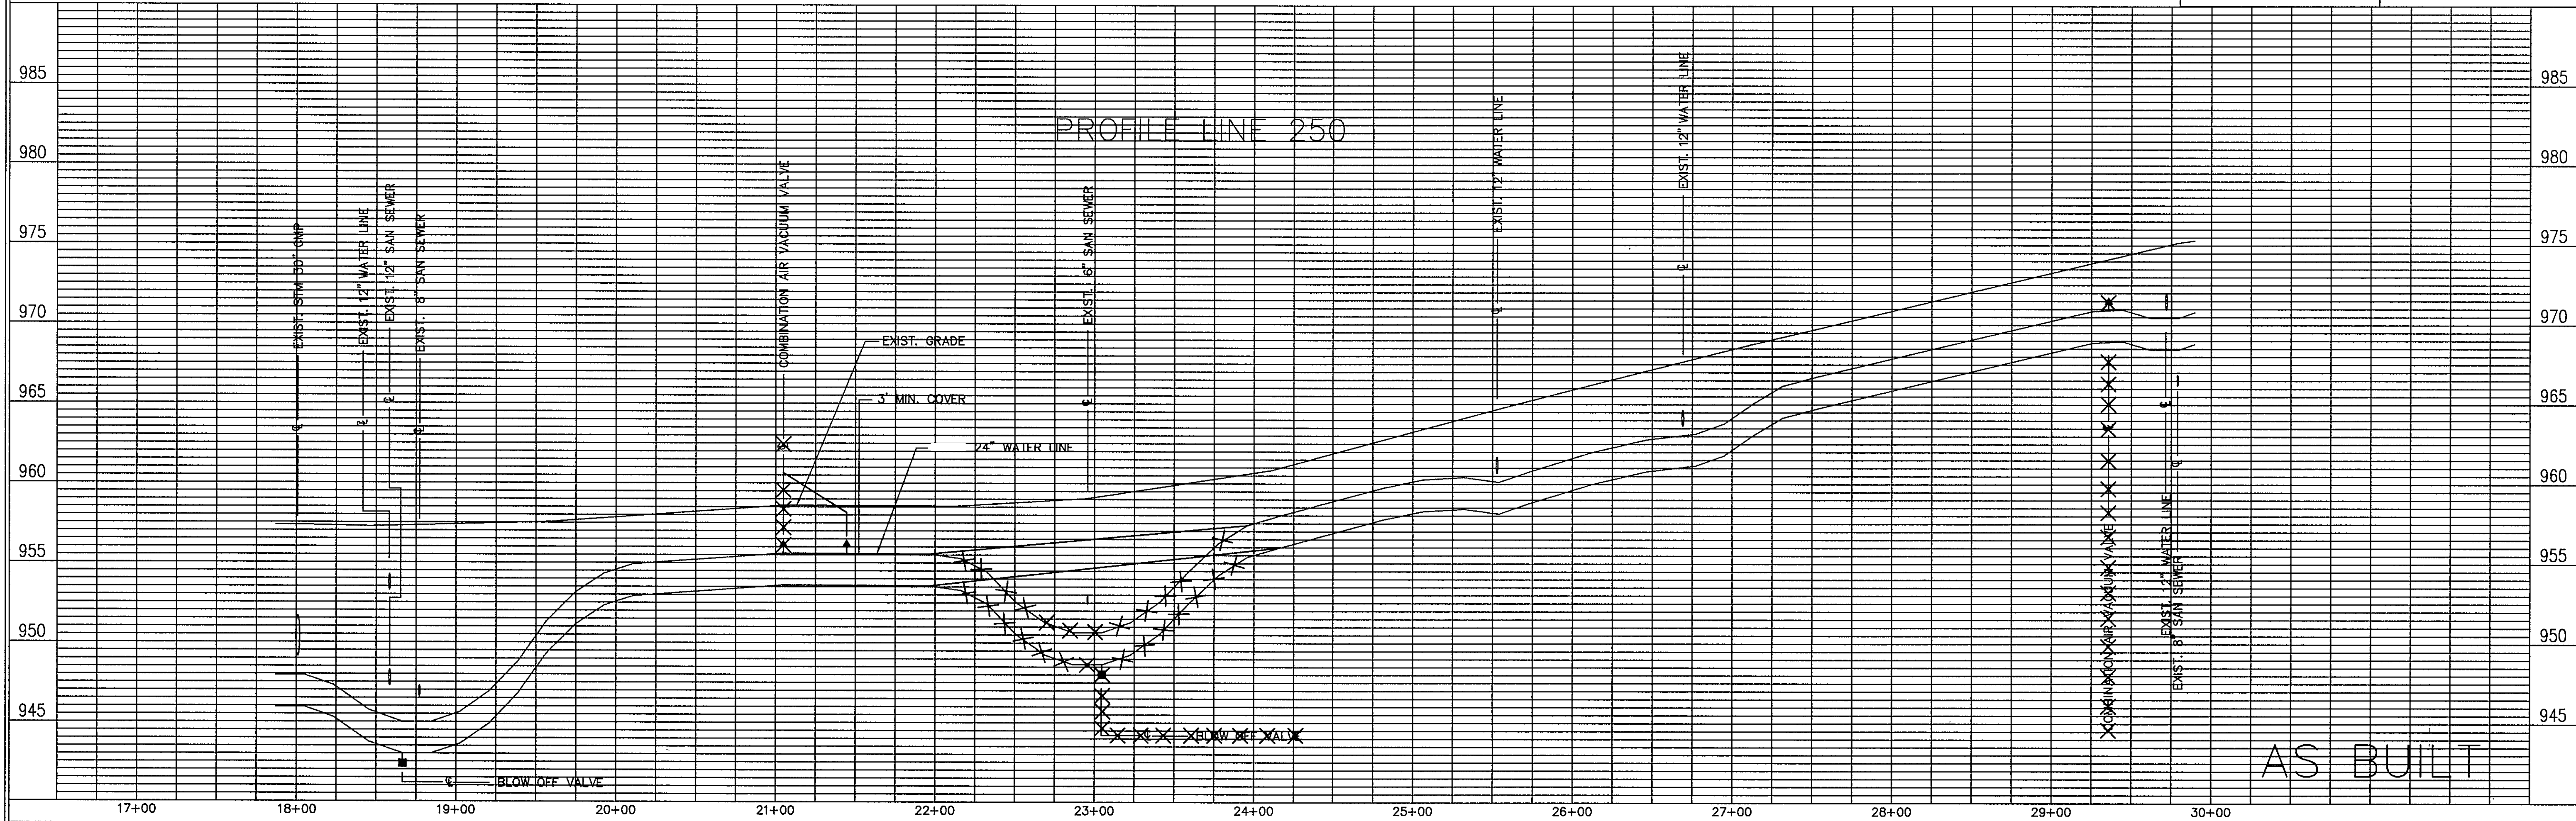


AS BUILT

THIS SHEET
1202 LF 24" WATERMAIN
1 EA. 6" BLOWOFF
1 EA. 4" A.R.V.

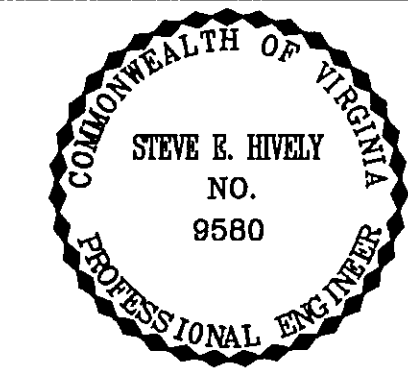

ENGINEER'S SEAL

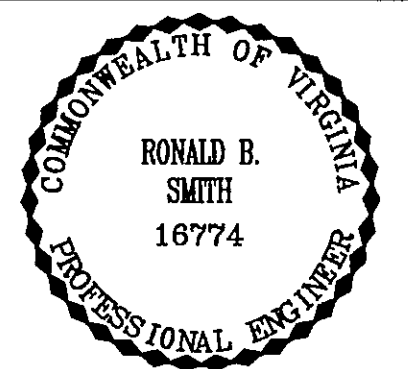

ENGINEER'S SEAL

Architects
Engineers
Planners
Surveyors

Dewberry & Davis

5238 Valleypointe Parkway, Suite One-B
Roanoke, Virginia 24019
703 362-7726

Carvins Cove, Phase II

City of Roanoke
Roanoke, Virginia

CONTRACT "B2"

LINE 250

STA 17+87.11 - 29+89.44

Drawn By REH/ACF
Designed By RBS
Checked By SEH
Date APRIL 93
Scale V: 1" = 5'
H: 1" = 50'
Plan Number A9
Zoned NONE
Sheet **3** of 22
File Number C1160