

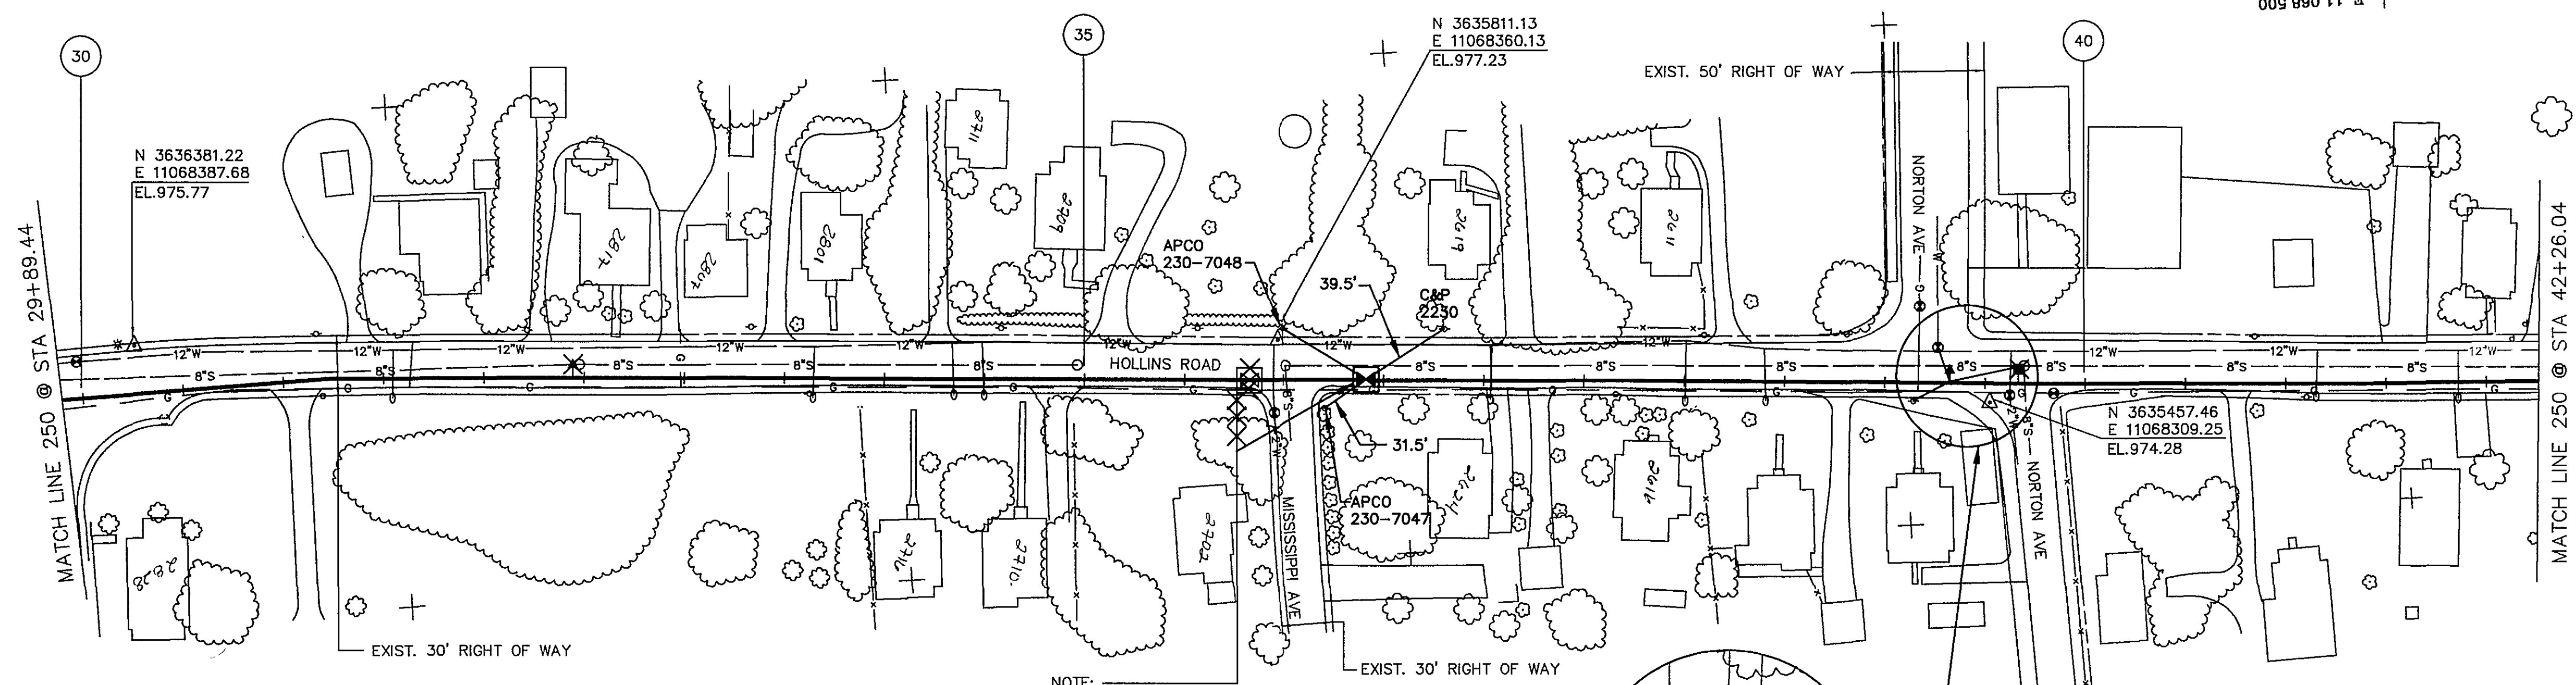
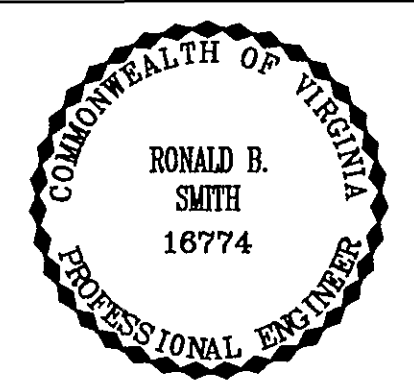


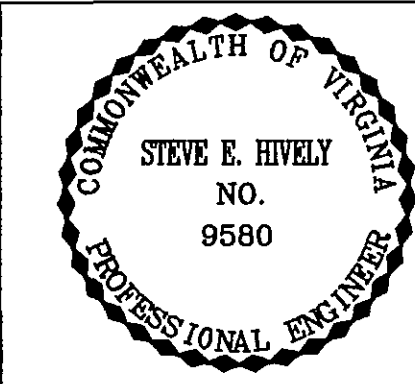


NOTE:
24" BUTTERFLY VALVE W/VAULT
DRAIN TO SUMP

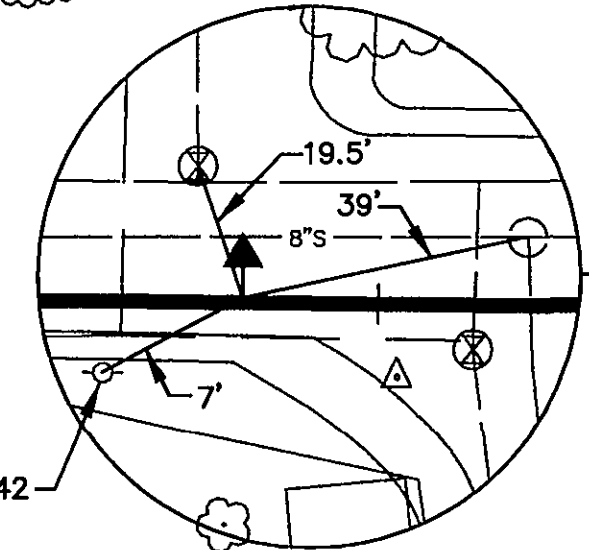

ENGINEER'S SEAL

ENGINEER'S SEAL

PLAN VIEW LINE 250

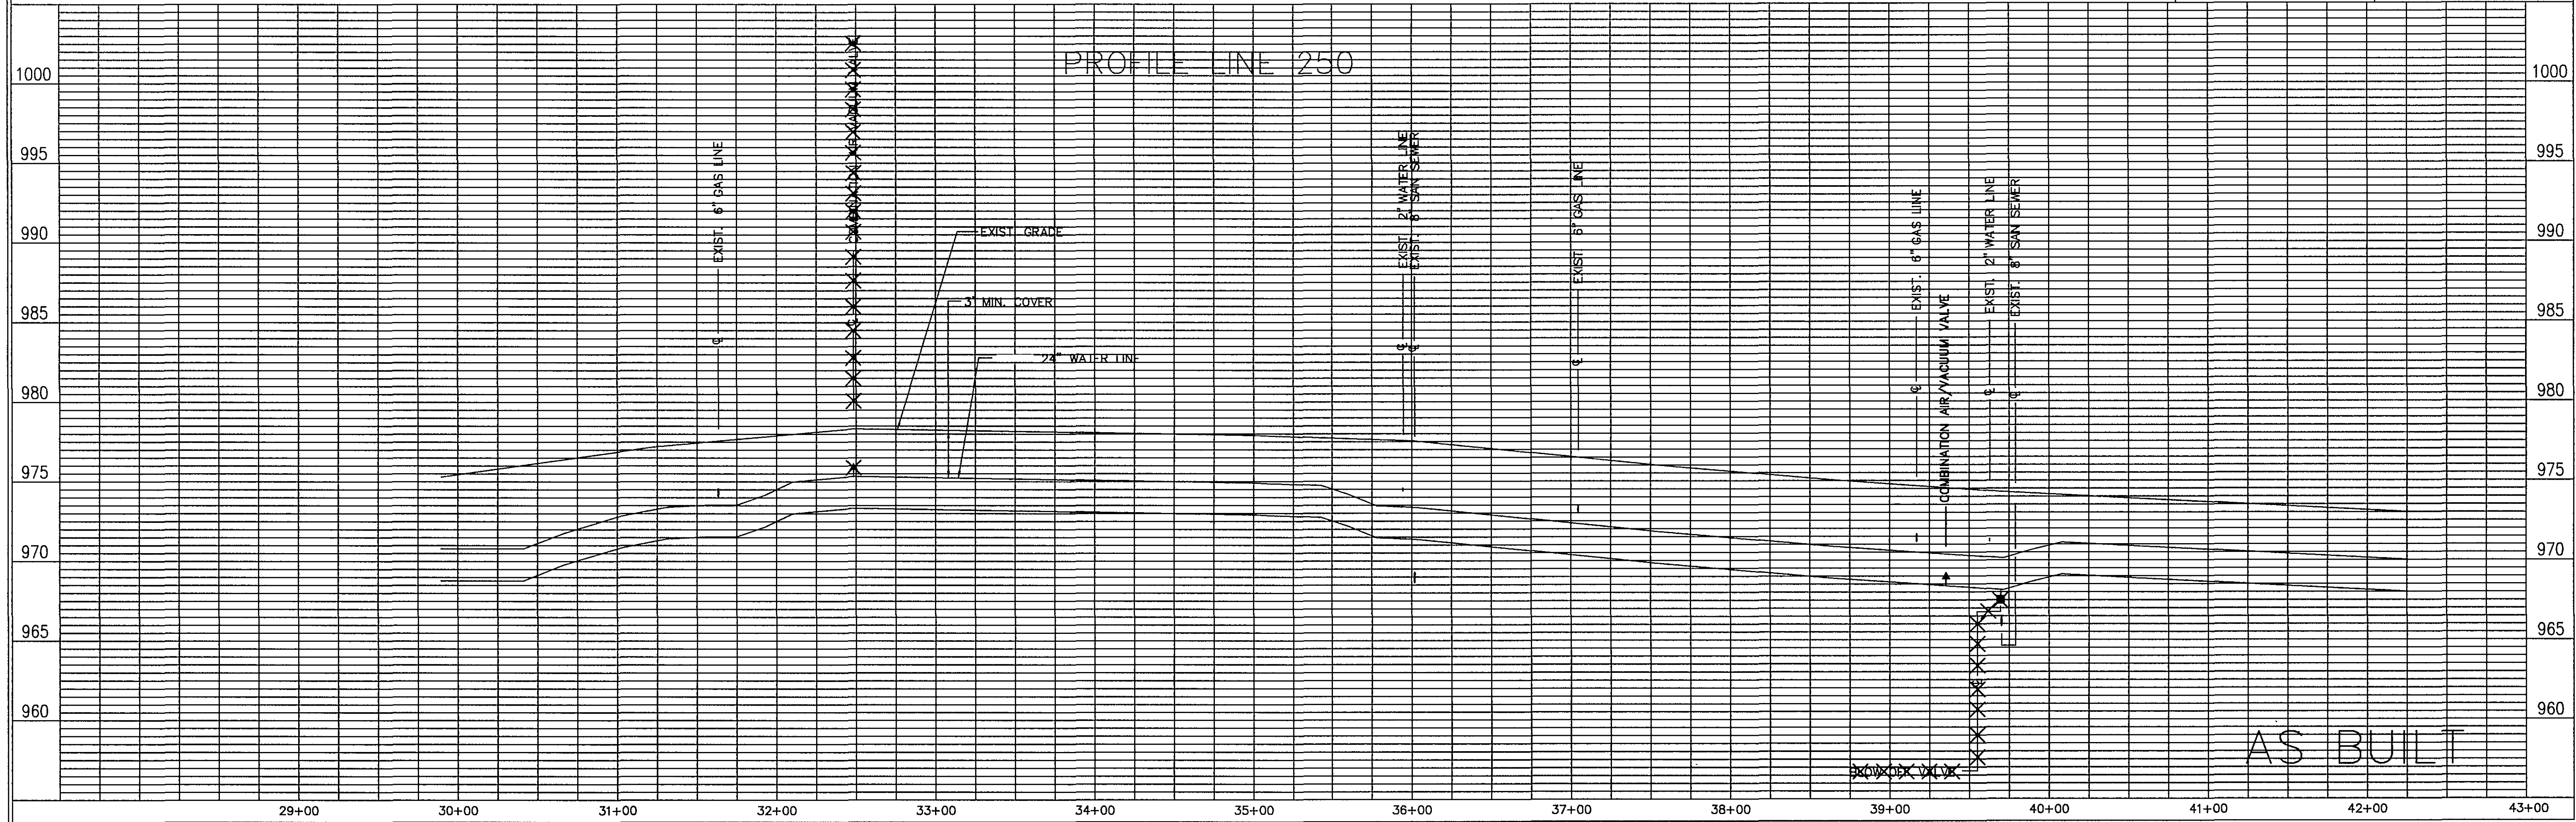

AS BUILT

Dewberry & Davis
Architects
Engineers
Planners
Surveyors
5238 Valleypointe Parkway, Suite One-B
Roanoke, Virginia 24019
703 362-7725

Carvins Cove, Phase II
City of Roanoke
Roanoke, Virginia

CONTRACT "B2"
LINE 250
STA 29+89.44 - 42+26.04

Drawn By REH/ACF
Designed By RBS
Checked By SEH
Date APRIL 93
Scale
V: 1" = 5'
H: 1" = 50'
Plan Number A9A
Zoned NONE
Sheet 4 of 22
File Number C1160