



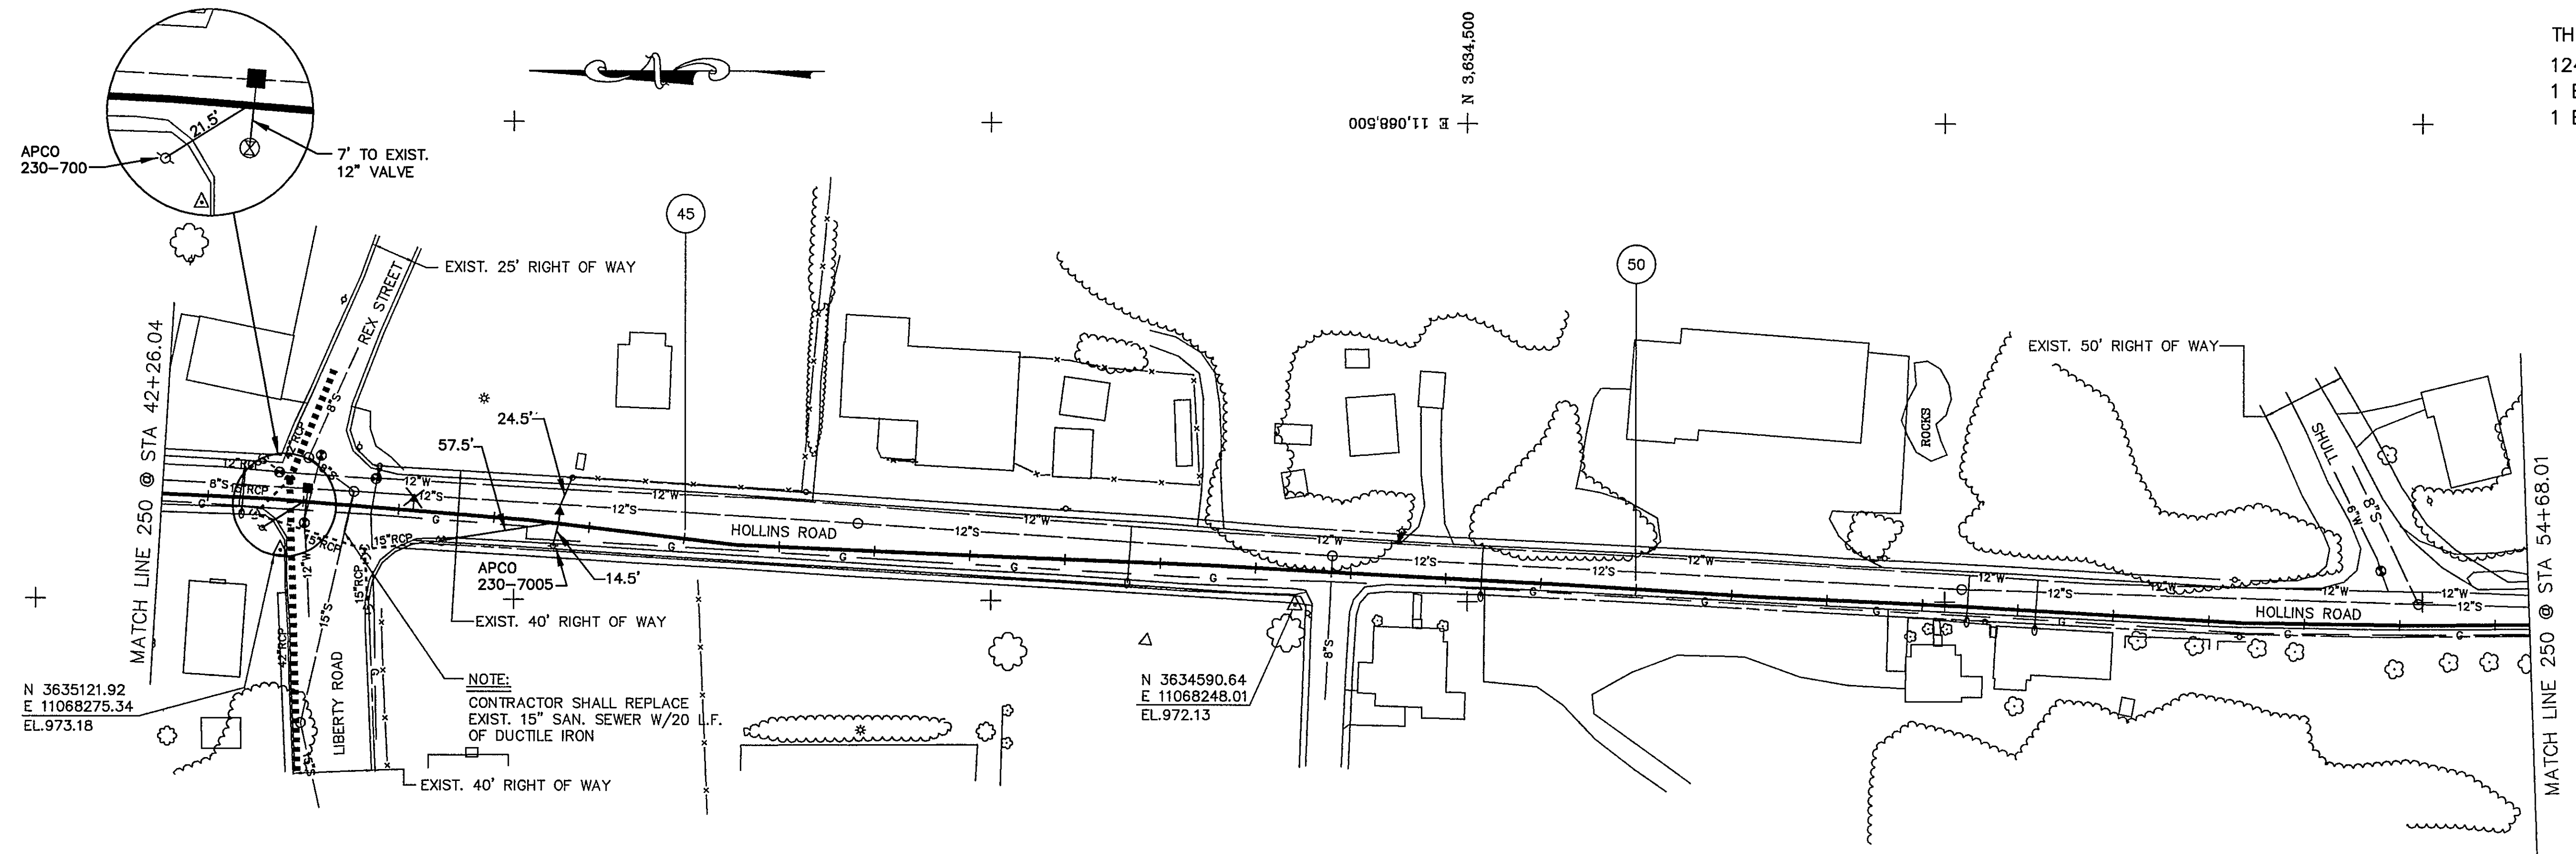

PLAN VIEW LINE 250

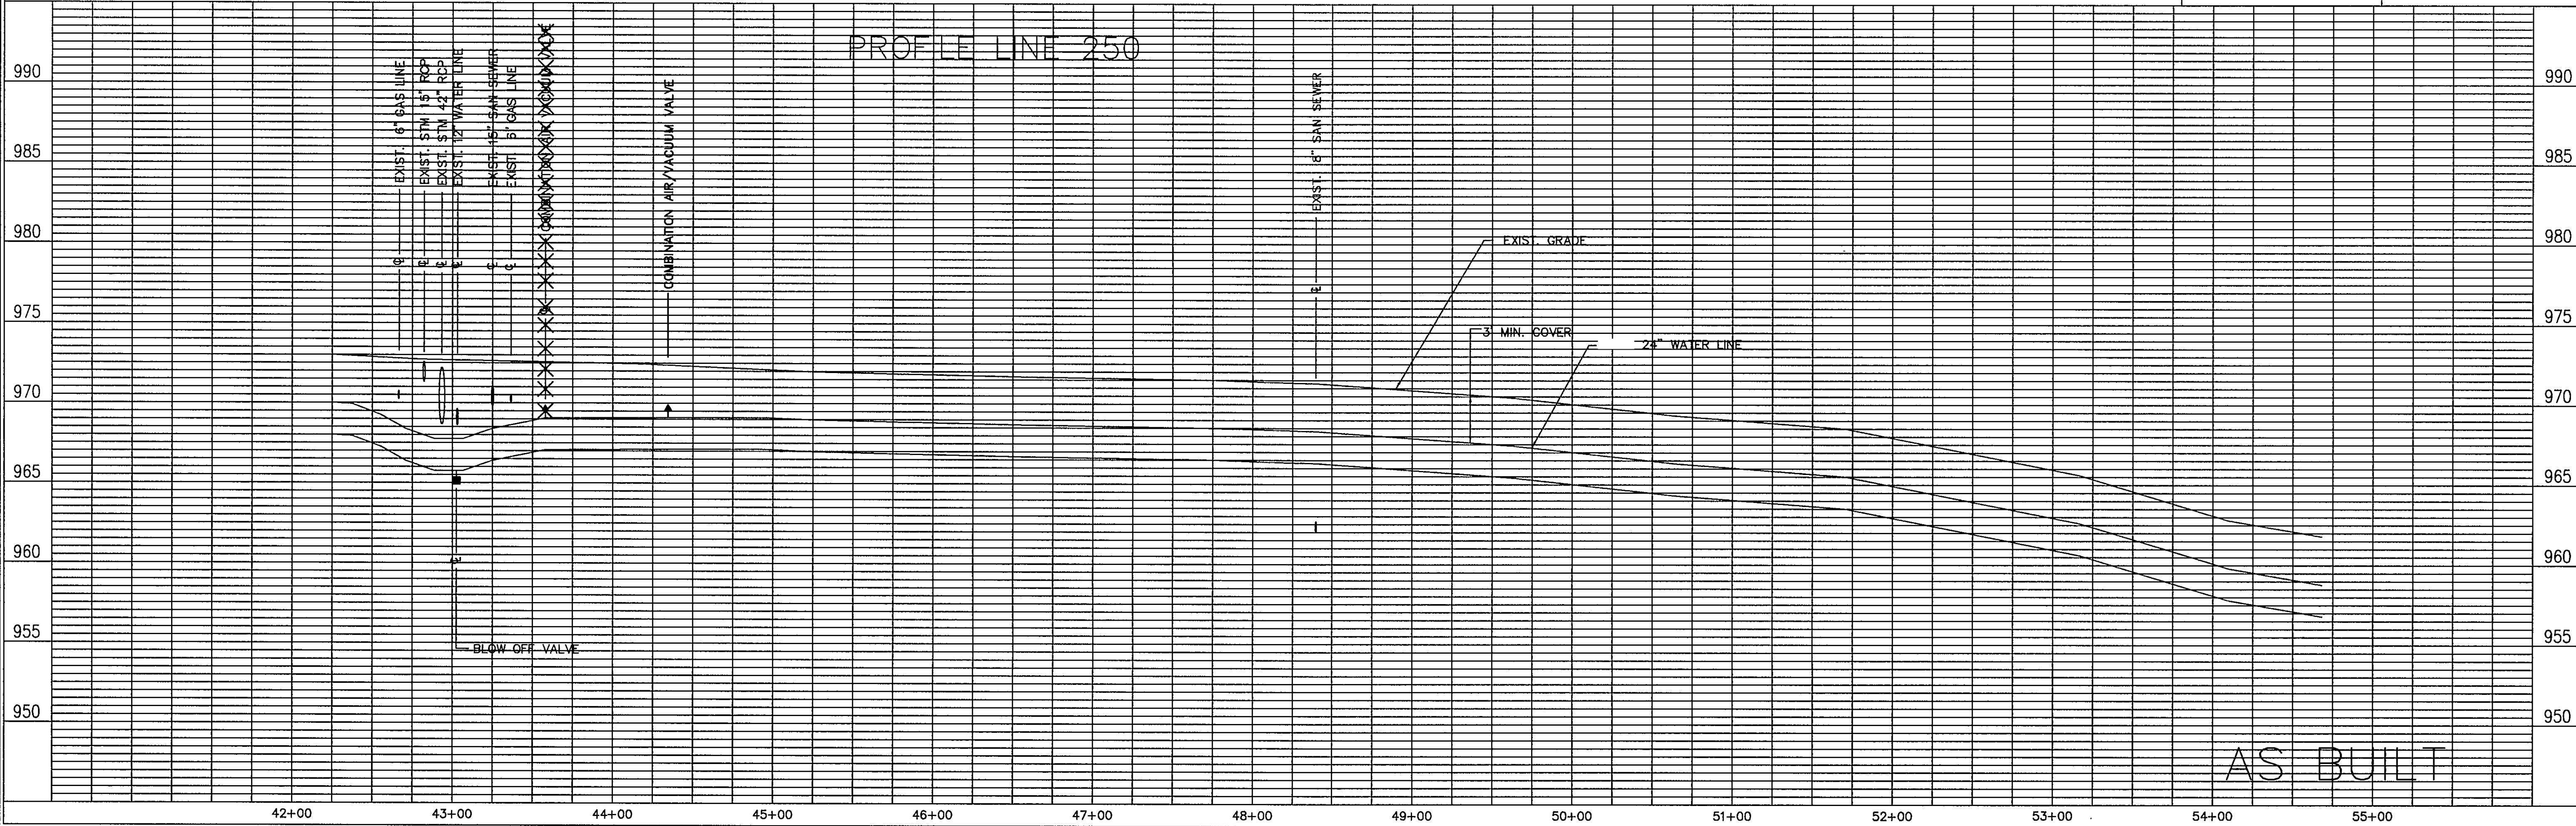

THIS SHEET
1242 LF 24" WATERMAIN
1 EA. 6" BLOWOFF
1 EA. 4" A.R.V.

ENGINEER'S SEAL	ENGINEER'S SEAL

 Architects Engineers Planners Surveyors 5238 Valleypointe Parkway, Suite One-B Roanoke, Virginia 24019 ☎ 703 362-7725	Carvins Cove, Phase II City of Roanoke Roanoke, Virginia	CONTRACT "B2" LINE 250 STA 42+26.04 - 54+68.01	Drawn By REH/ACF Designed By RBS Checked By SEH Date APRIL 93 Scale V: 1" = 5' H: 1" = 50' Plan Number B1 Zoned NONE Sheet 5 of 22 File Number C1160
---	--	--	---