



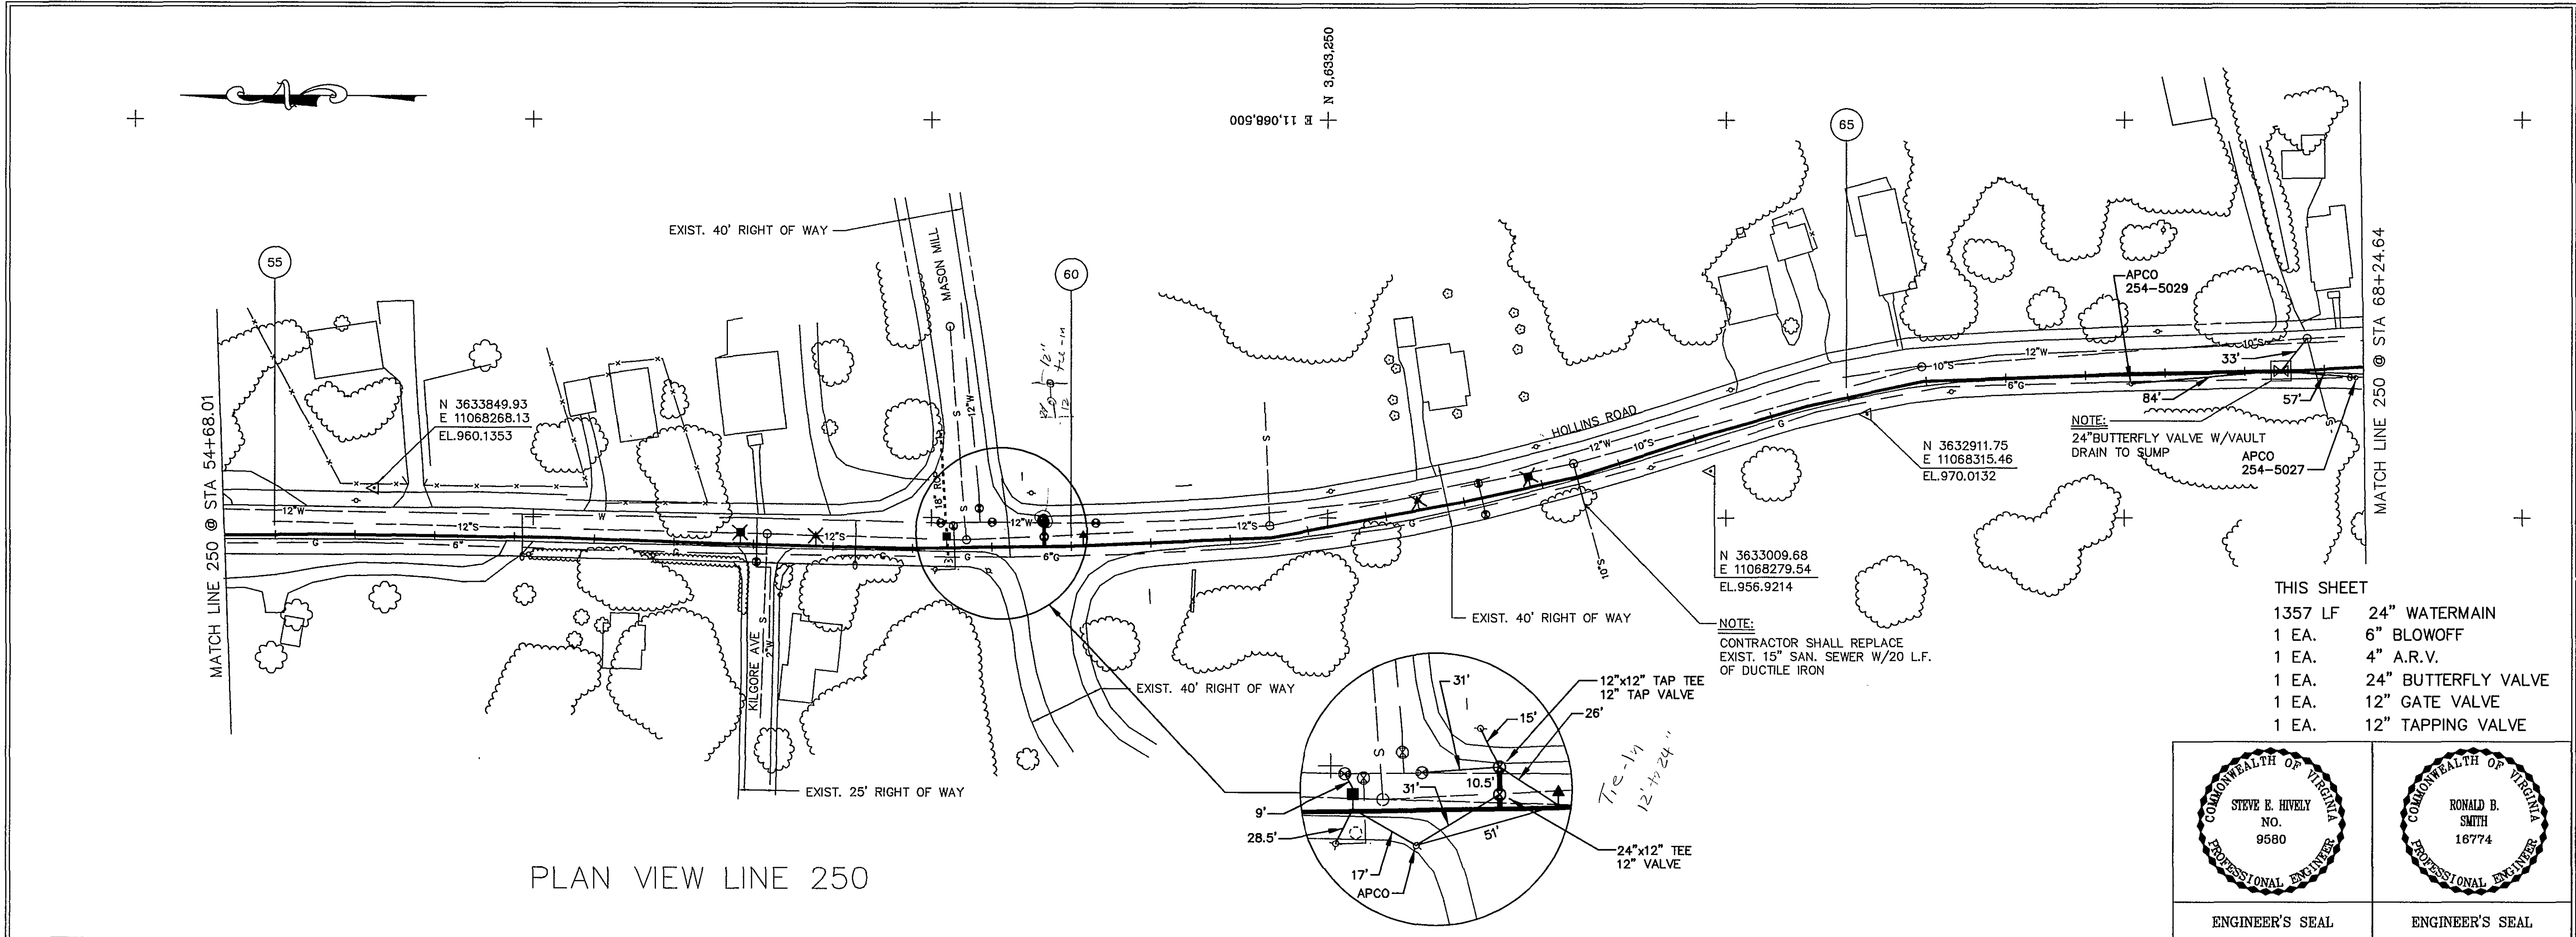

PLAN VIEW LINE 250

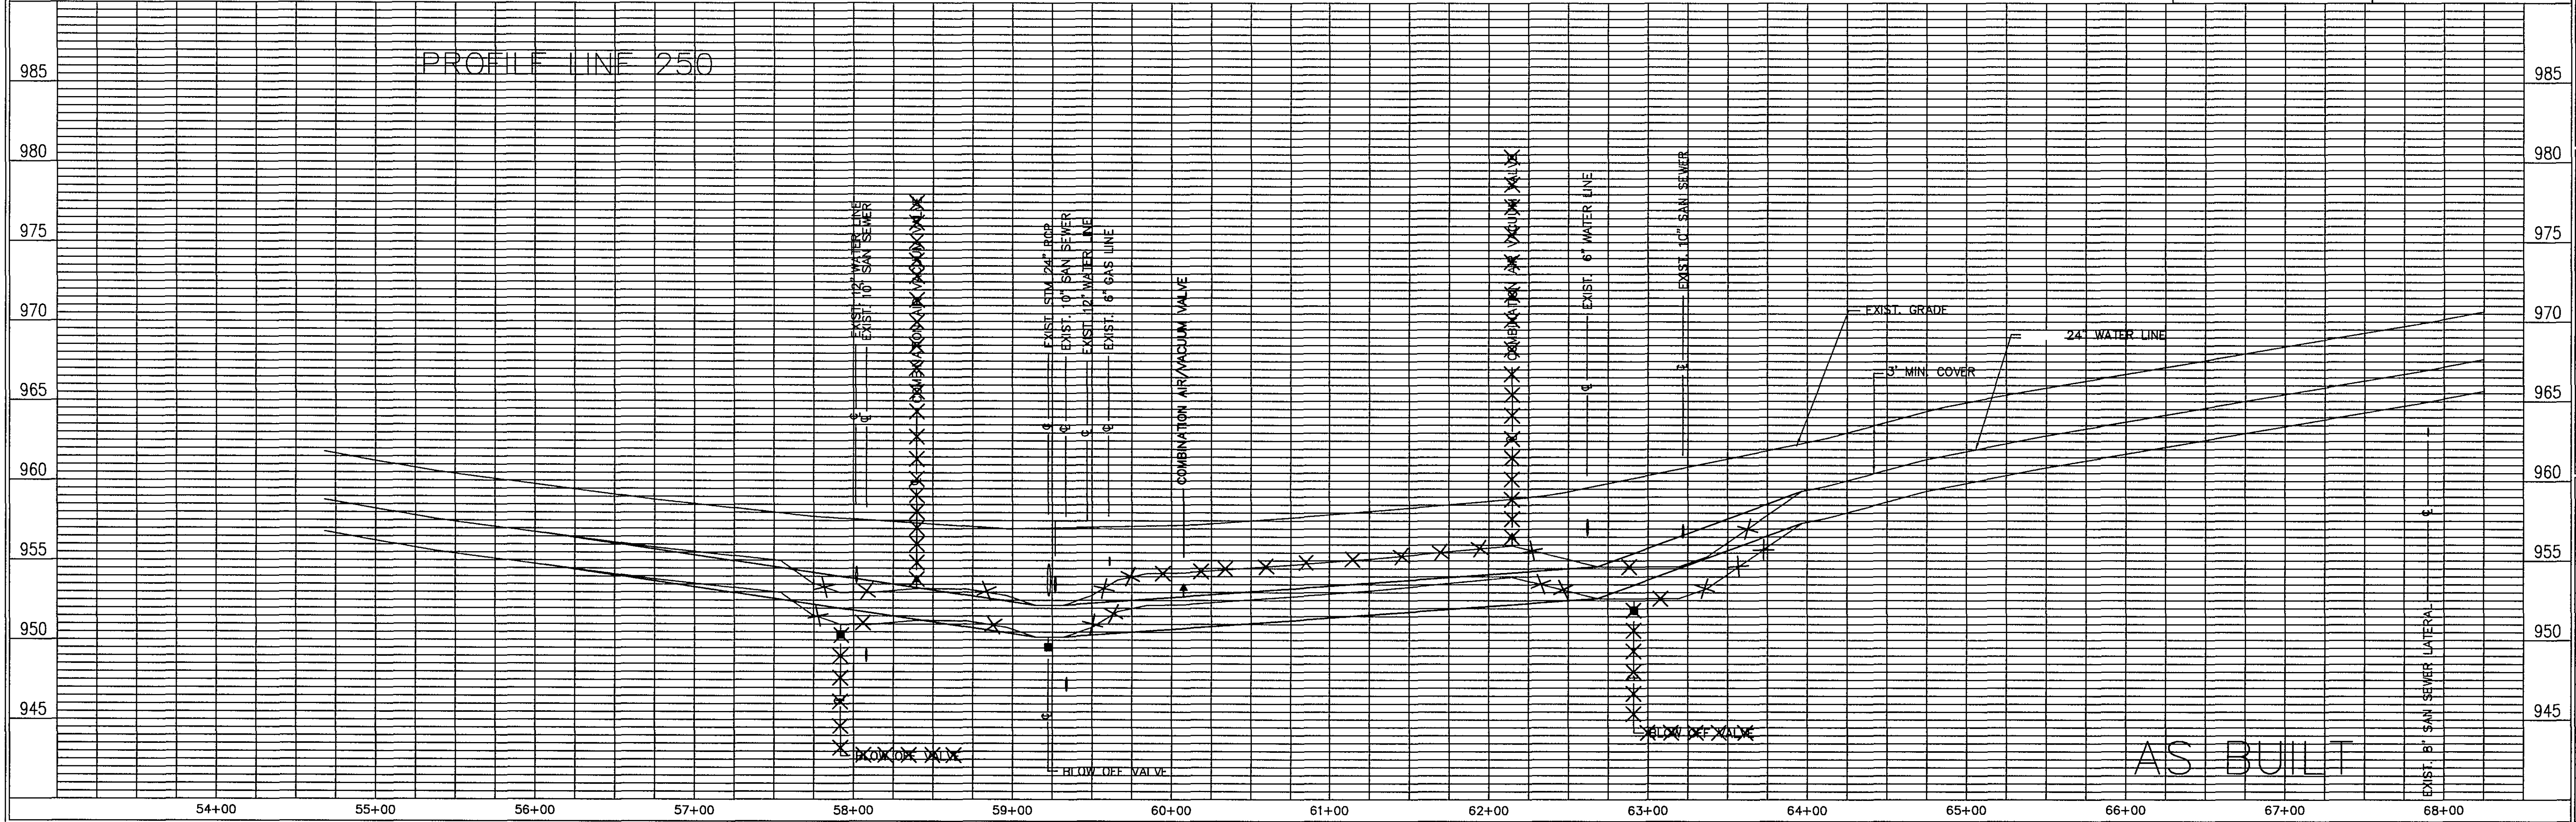

AS BUILT

THIS SHEET

1357 LF	24" WATERMAIN
1 EA.	6" BLOWOFF
1 EA.	4" A.R.V.
1 EA.	24" BUTTERFLY VALVE
1 EA.	12" GATE VALVE
1 EA.	12" TAPPING VALVE

COMMONWEALTH OF VIRGINIA
STEVE E. HIVELEY
NO. 9560
PROFESSIONAL ENGINEER

ENGINEER'S SEAL

COMMONWEALTH OF VIRGINIA
RONALD B. SMITH
16774
PROFESSIONAL ENGINEER

ENGINEER'S SEAL

Dewberry & Davis
Architects
Engineers
Planners
Surveyors
5238 Valleypointe Parkway, Suite One-B
Roanoke, Virginia 24019
703 362-7725

Carvins Cove, Phase II
City of Roanoke
Roanoke, Virginia

CONTRACT "B2"
LINE 250
STA 54+68.01 - 68+24.64

Drawn By REH/ACF
Designed By RBS
Checked By SEH
Date APRIL 93
Scale V: 1" = 5'
H: 1" = 50'
Plan Number B2
Zoned NONE
Sheet 6 of 22
File Number C1160