

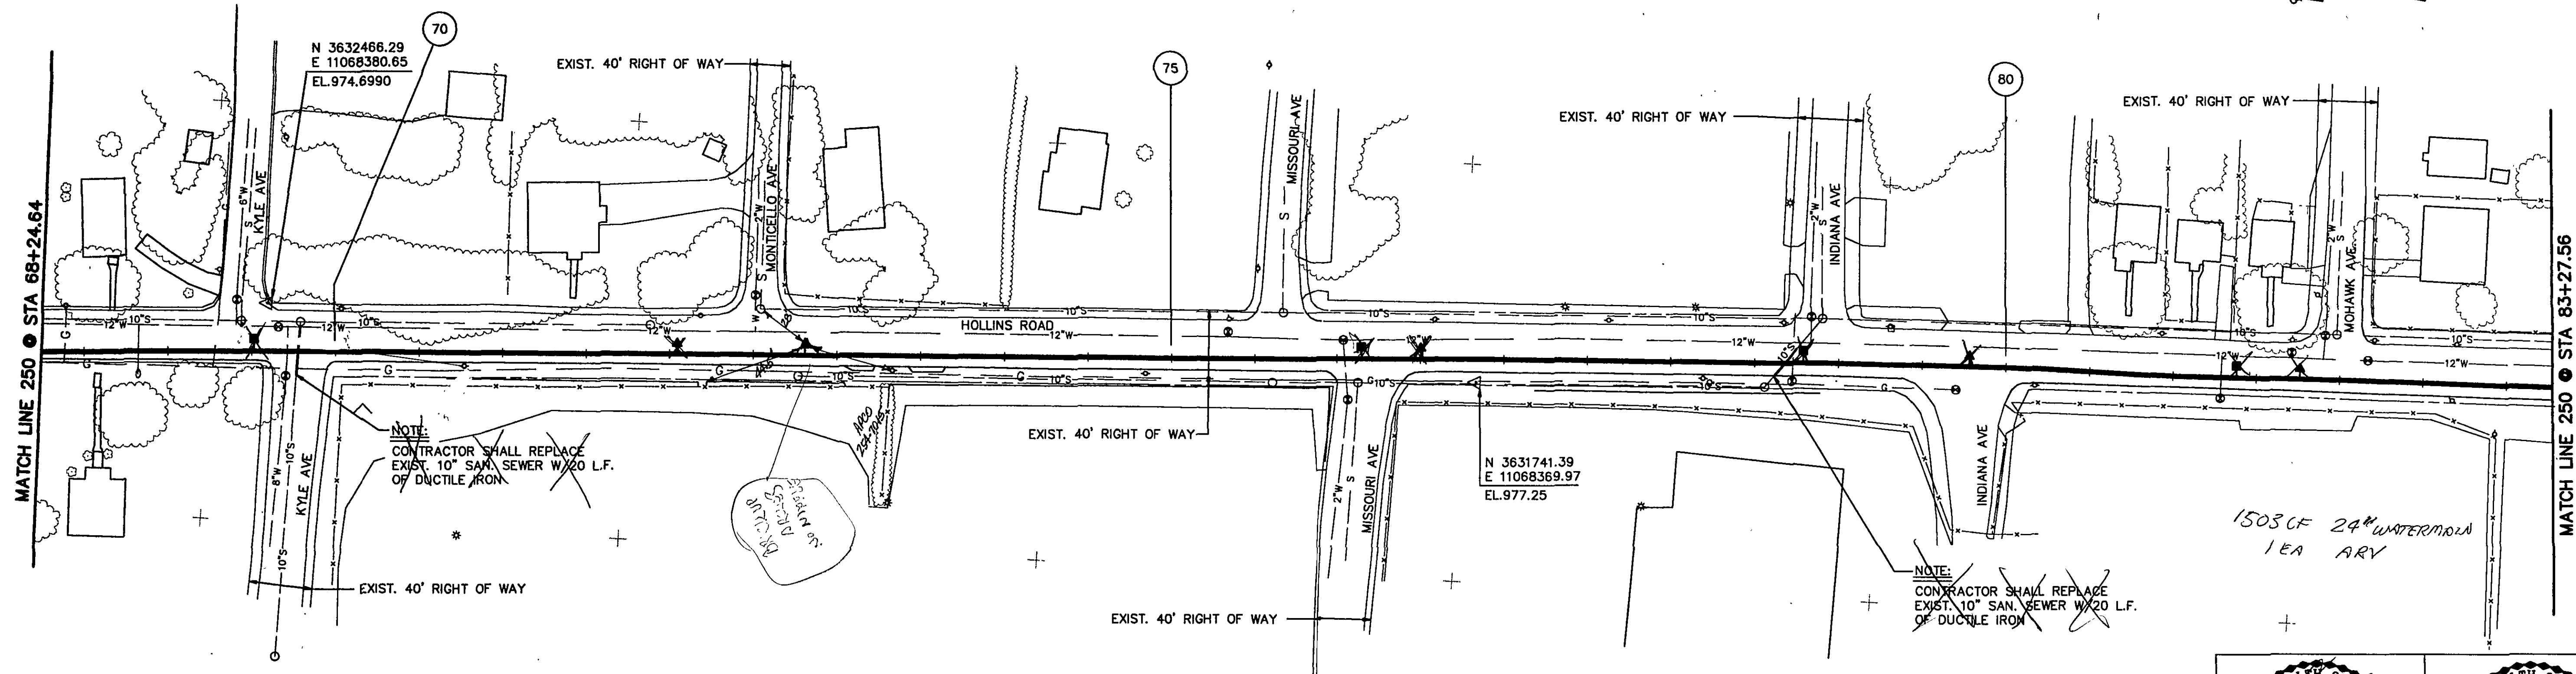


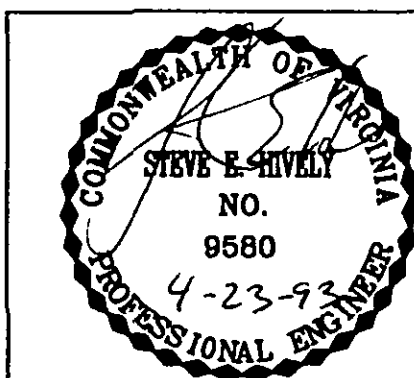


PLAN VIEW LINE 250

PROFILE LINE 250

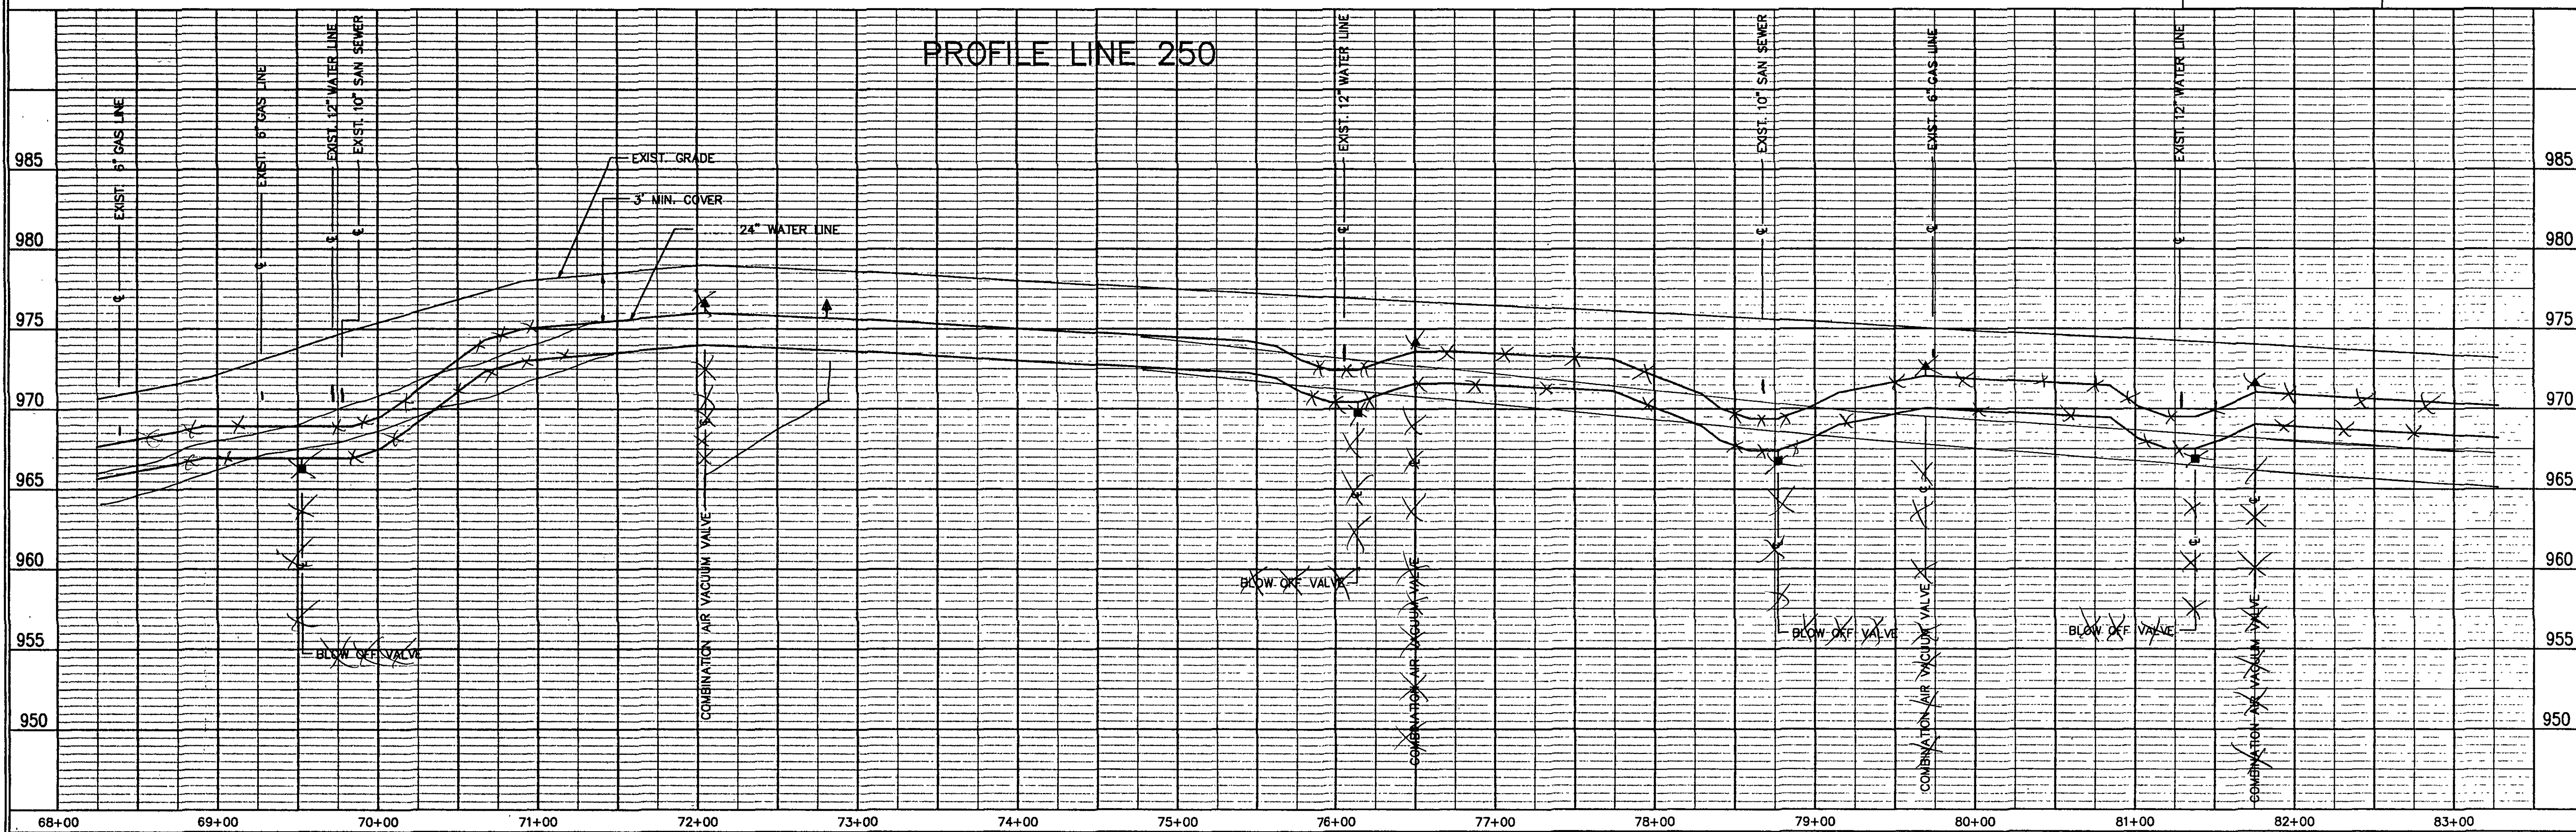

ENGINEER'S SEAL

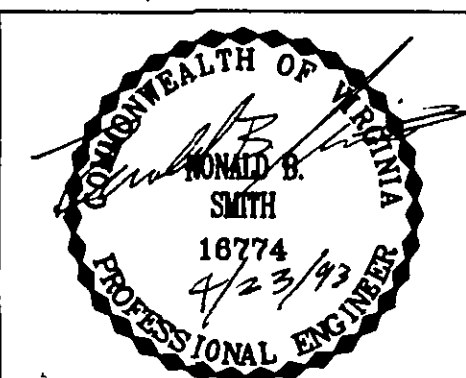

ENGINEER'S SEAL

Carvins Cove, Phase II
City of Roanoke
Roanoke, Virginia

CONTRACT "B2"
LINE 250
STA 68+24.64 - 83+27.56

Drawn By REH/ACF
Designed By RBS
Checked By SEH
Date APRIL 93
Scale V: 1" = 5'
H: 1" = 50'
Plan Number B3
Zoned NONE
Sheet 7 of 22
File Number C1160

Dewberry & Davis
Architects
Engineers
Planners
Surveyors
5236 Valleypointe Parkway, Suite One-B
Roanoke, Virginia 24019
703 362-7725