


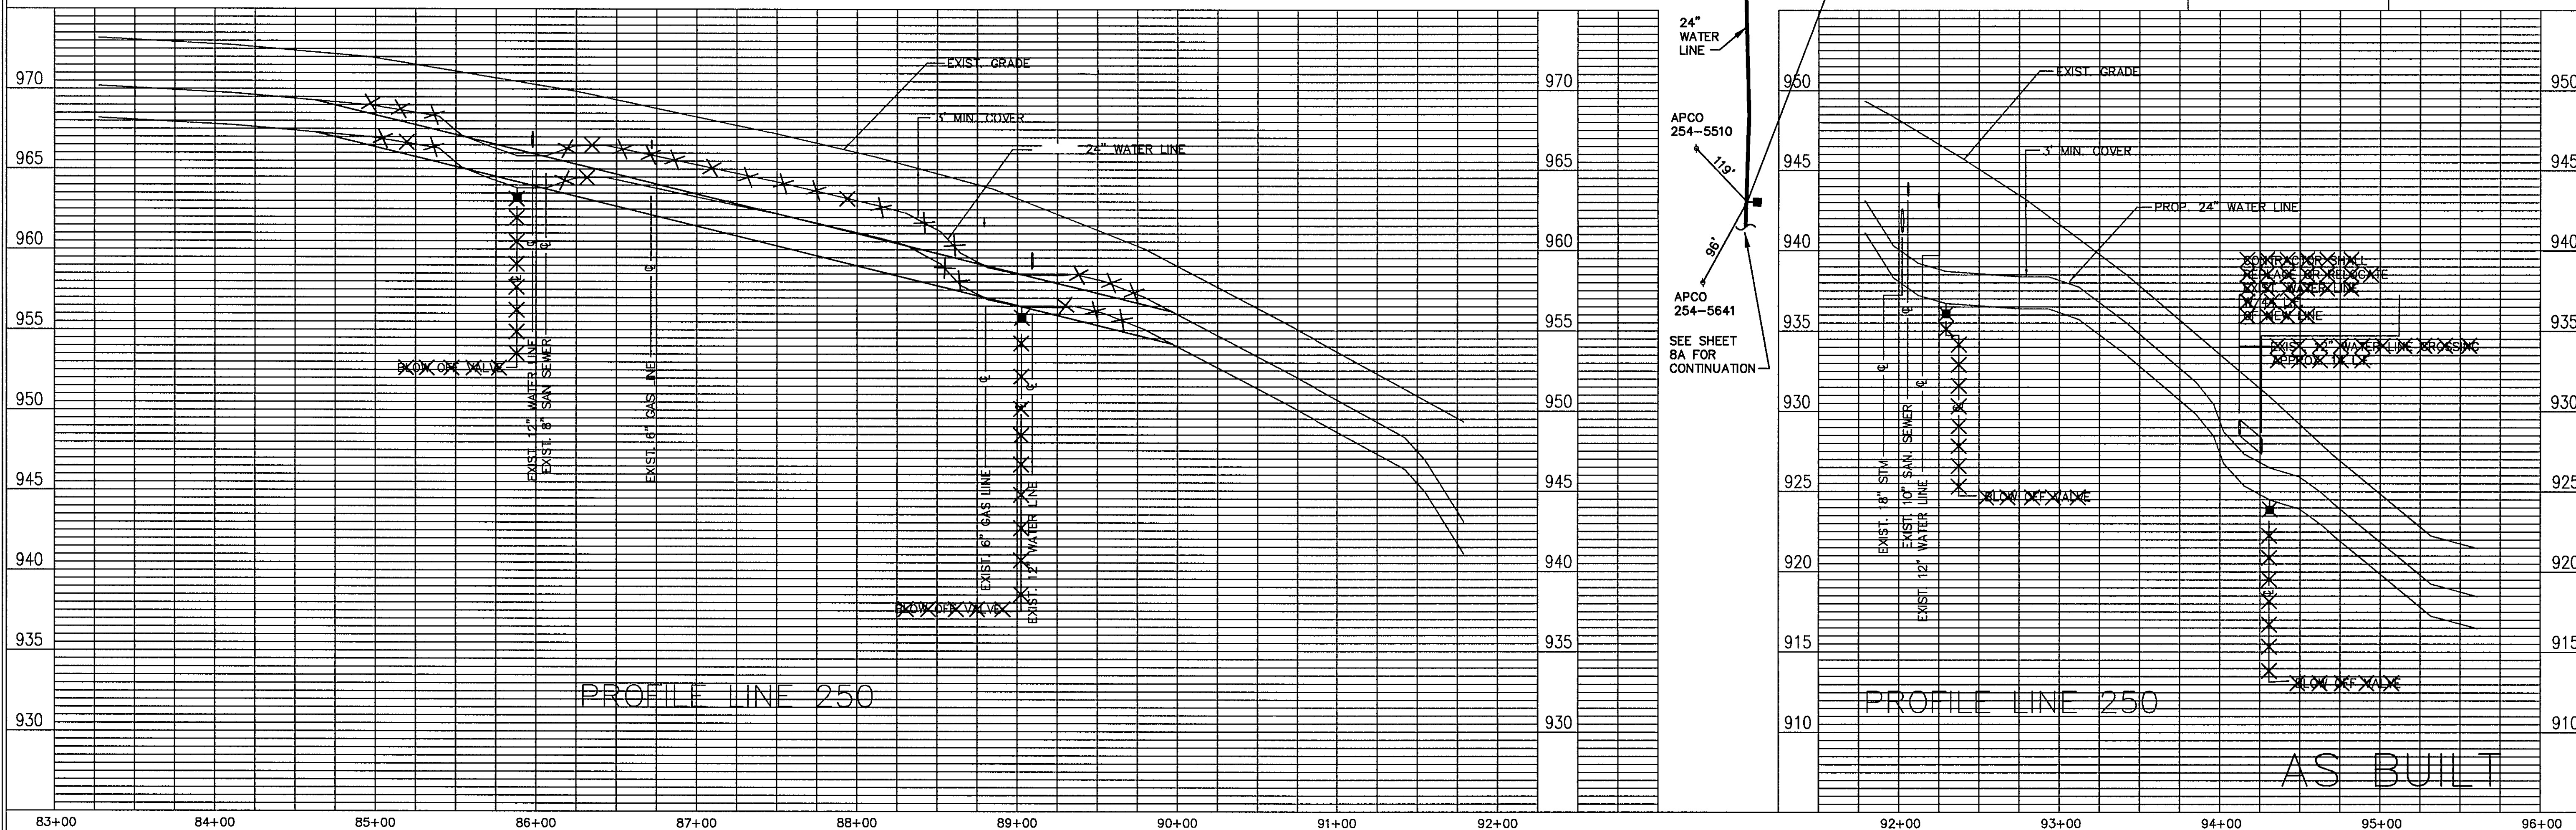


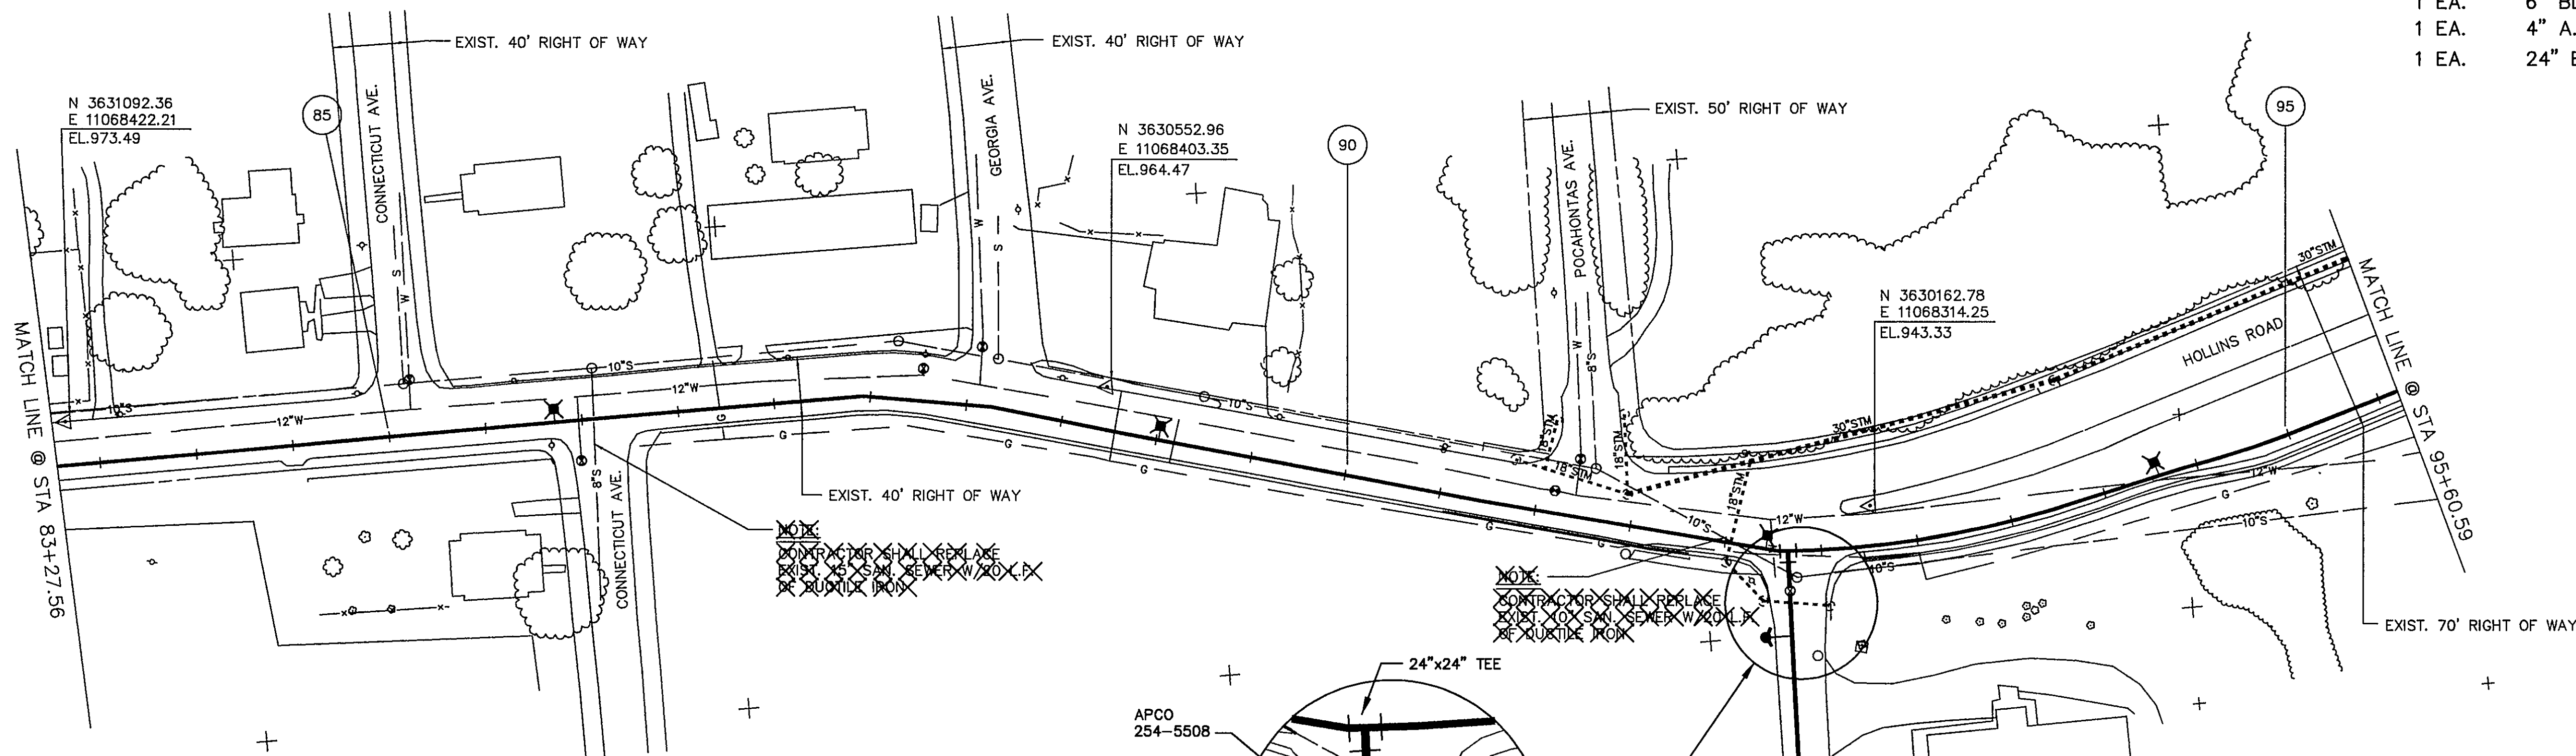

THIS SHEET
 1553 LF 24" WATERMAIN
 1 EA. 6" BLOWOFF
 1 EA. 4" A.R.V.
 1 EA. 24" BUTTERFLY VALVE

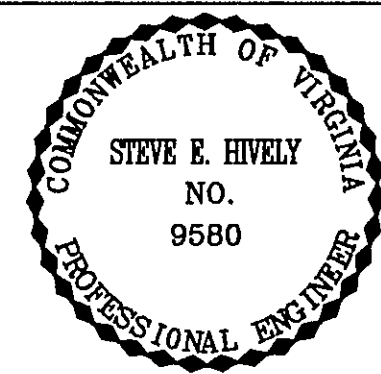

ENGINEER'S SEAL

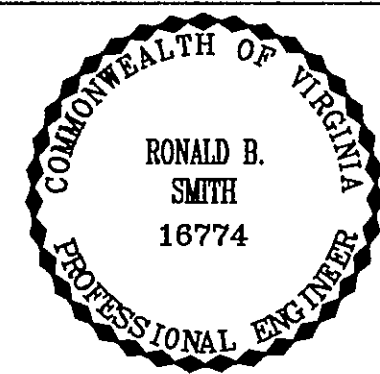

ENGINEER'S SEAL

Architects
 Engineers
 Planners
 Surveyors

Dewberry & Davis
 5238 Valleypointe Parkway, Suite One-B
 Roanoke, Virginia 24019
 ☎ 703 362-7725

Carvins Cove, Phase II
 City of Roanoke
 Roanoke, Virginia

CONTRACT "B2"
 LINE 250

STA 83+27.56 - 95+60.59

Drawn By REH/ACF
 Designed By RBS
 Checked By SEH
 Date APRIL 93
 Scale V: 1" = 5'
 H: 1" = 50'
 Plan Number B4
 Zoned NONE
 Sheet 8 of 22
 File Number C1160

AS BUILT