


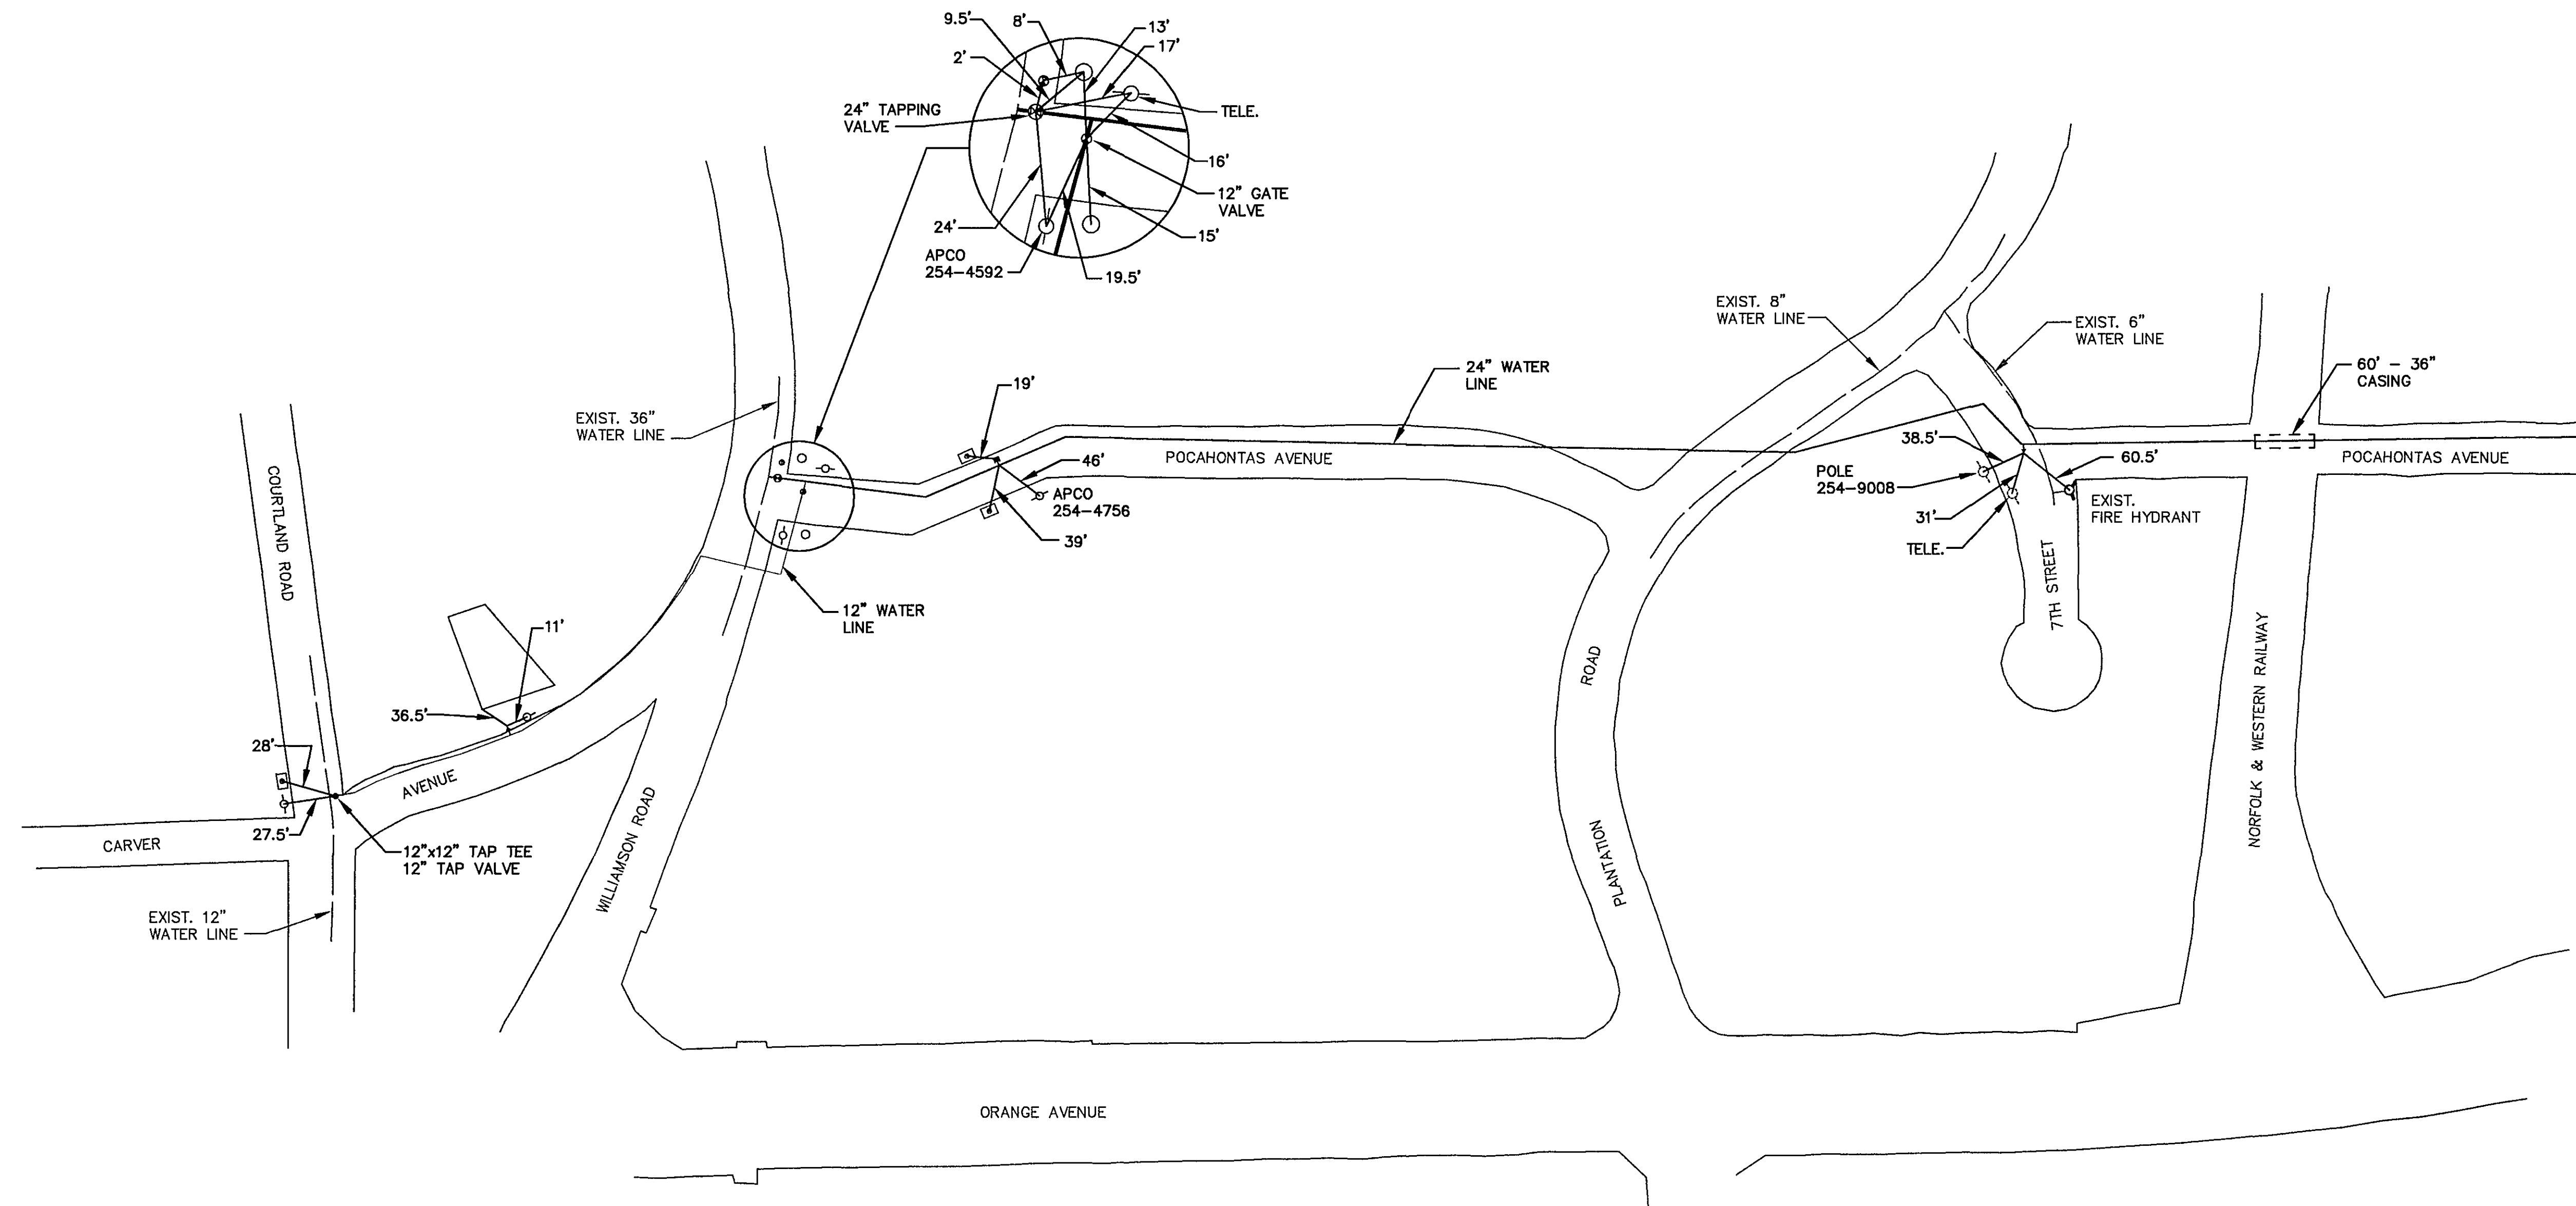

THIS SHEET

1890 LF	24" WATERMAIN
585 LF	12" WATERMAIN
1 EA.	6" BLOWOFF
1 EA.	4" A.R.V.
1 EA.	2" BLOWOFF
1 EA.	24" TAPPING VALVE
1 EA.	12" TAPPING VALVE
1 EA.	12" GATE VALVE

FOR CONTINUATION
SEE SHEET 8

AS BUILT

Architects
Engineers
Planners
Surveyors

Dewberry & Davis
5238 Valleypointe Parkway, Suite One-B
Roanoke, Virginia 24019
703 362-7725

Carvins Cove, Phase II
City of Roanoke
Roanoke, Virginia

CONTRACT "B2"

Drawn By	REH/ACF
Designed By	RBS
Checked By	SEH
Date	APRIL 93
Scale	V: 1" = 100' H: 1" = 100'
Plan Number	B4-1
Zoned	NONE
Sheet	8A of 22
File Number	C1160