

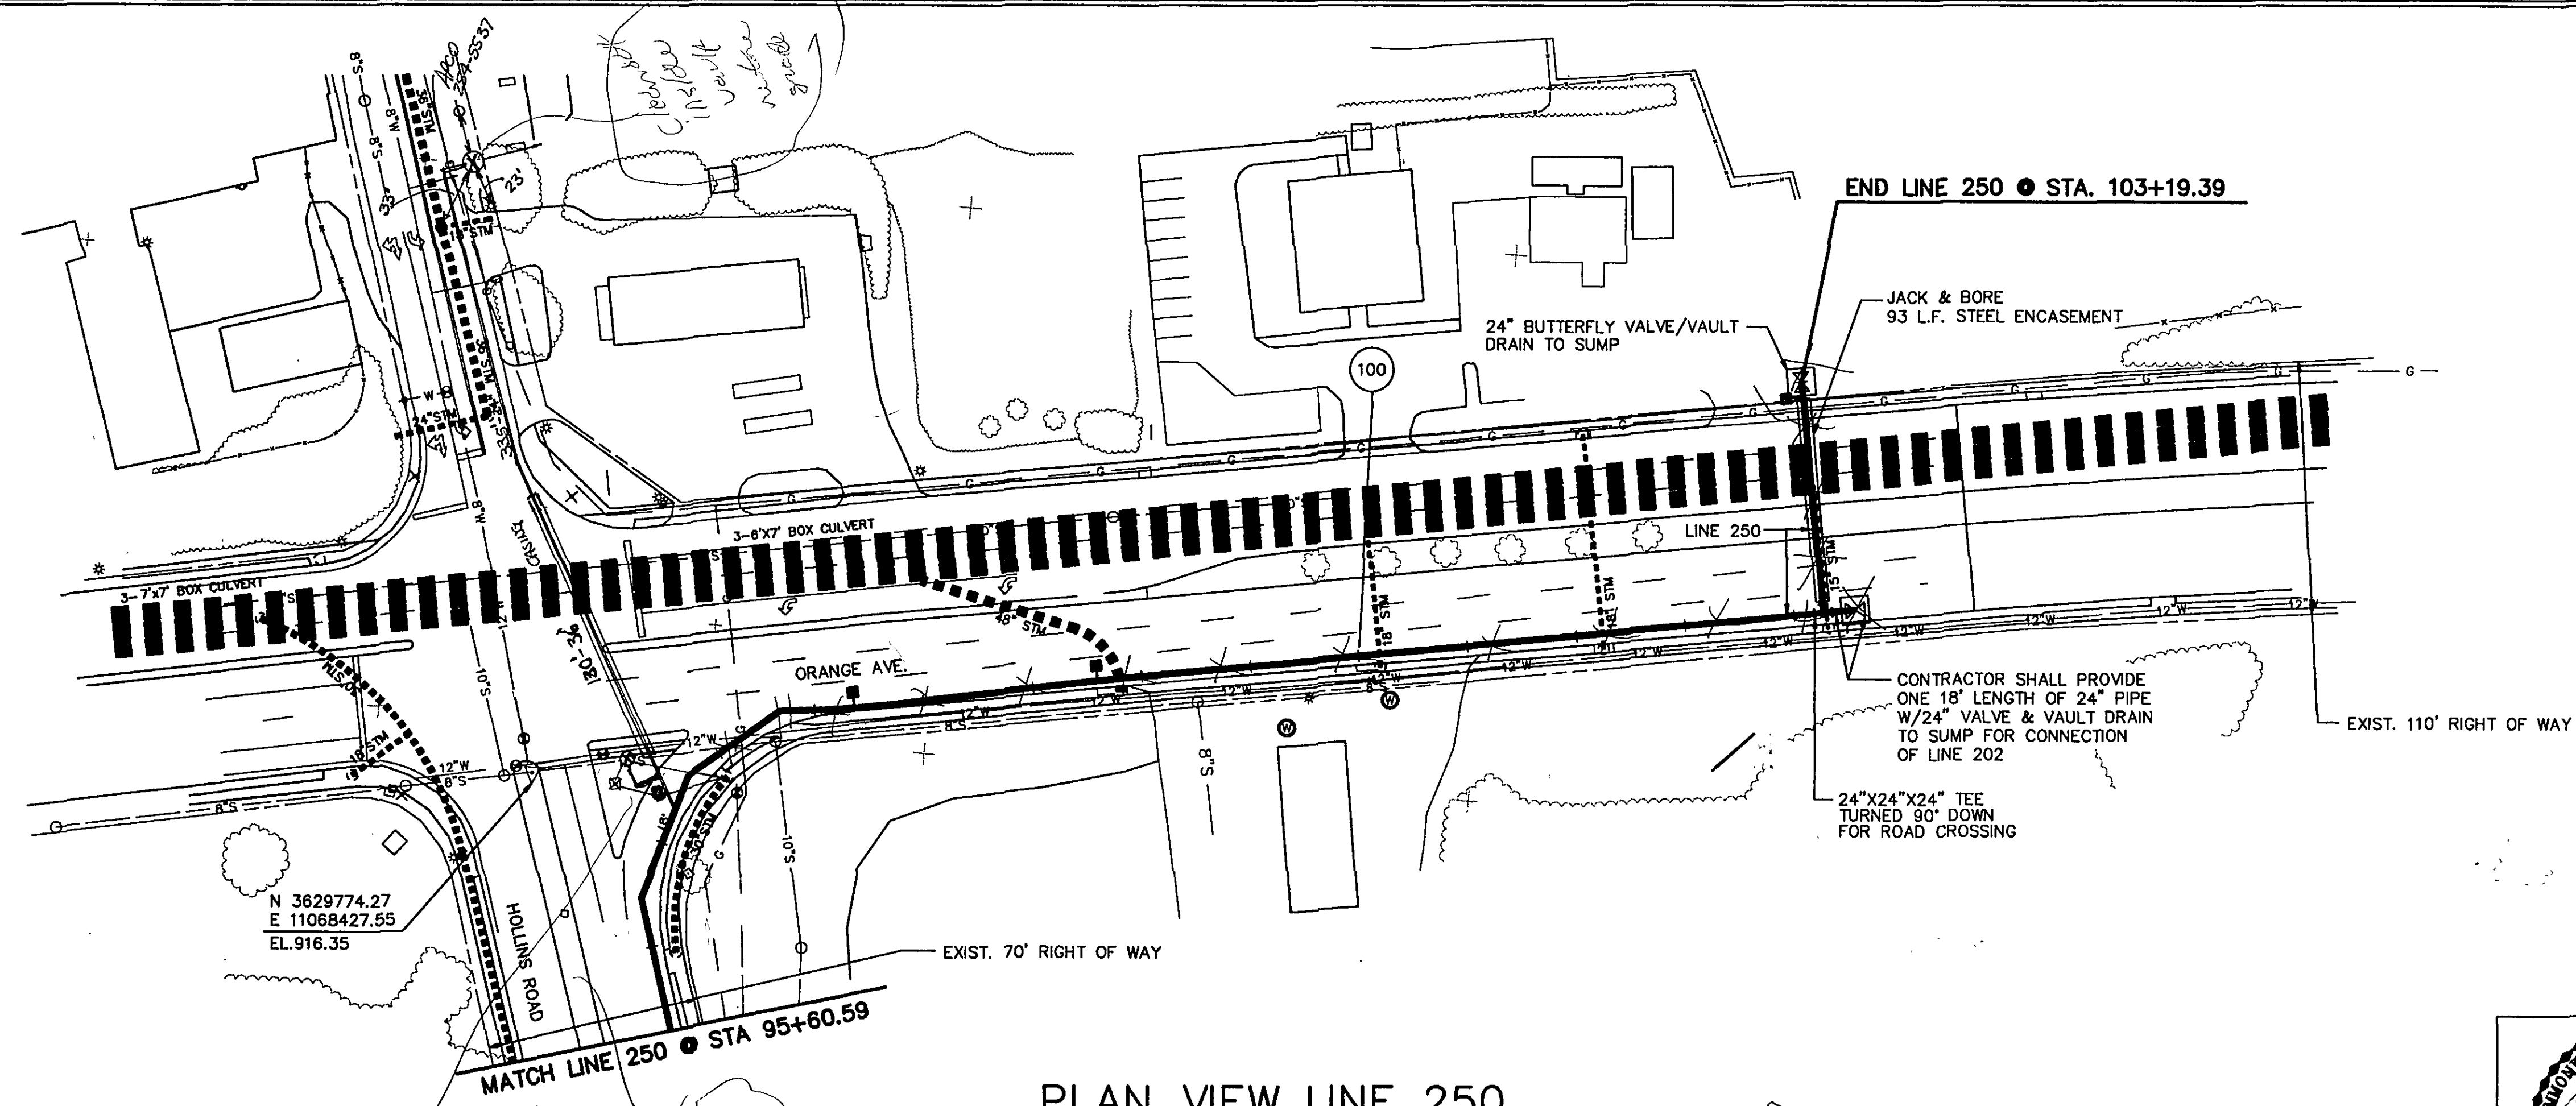
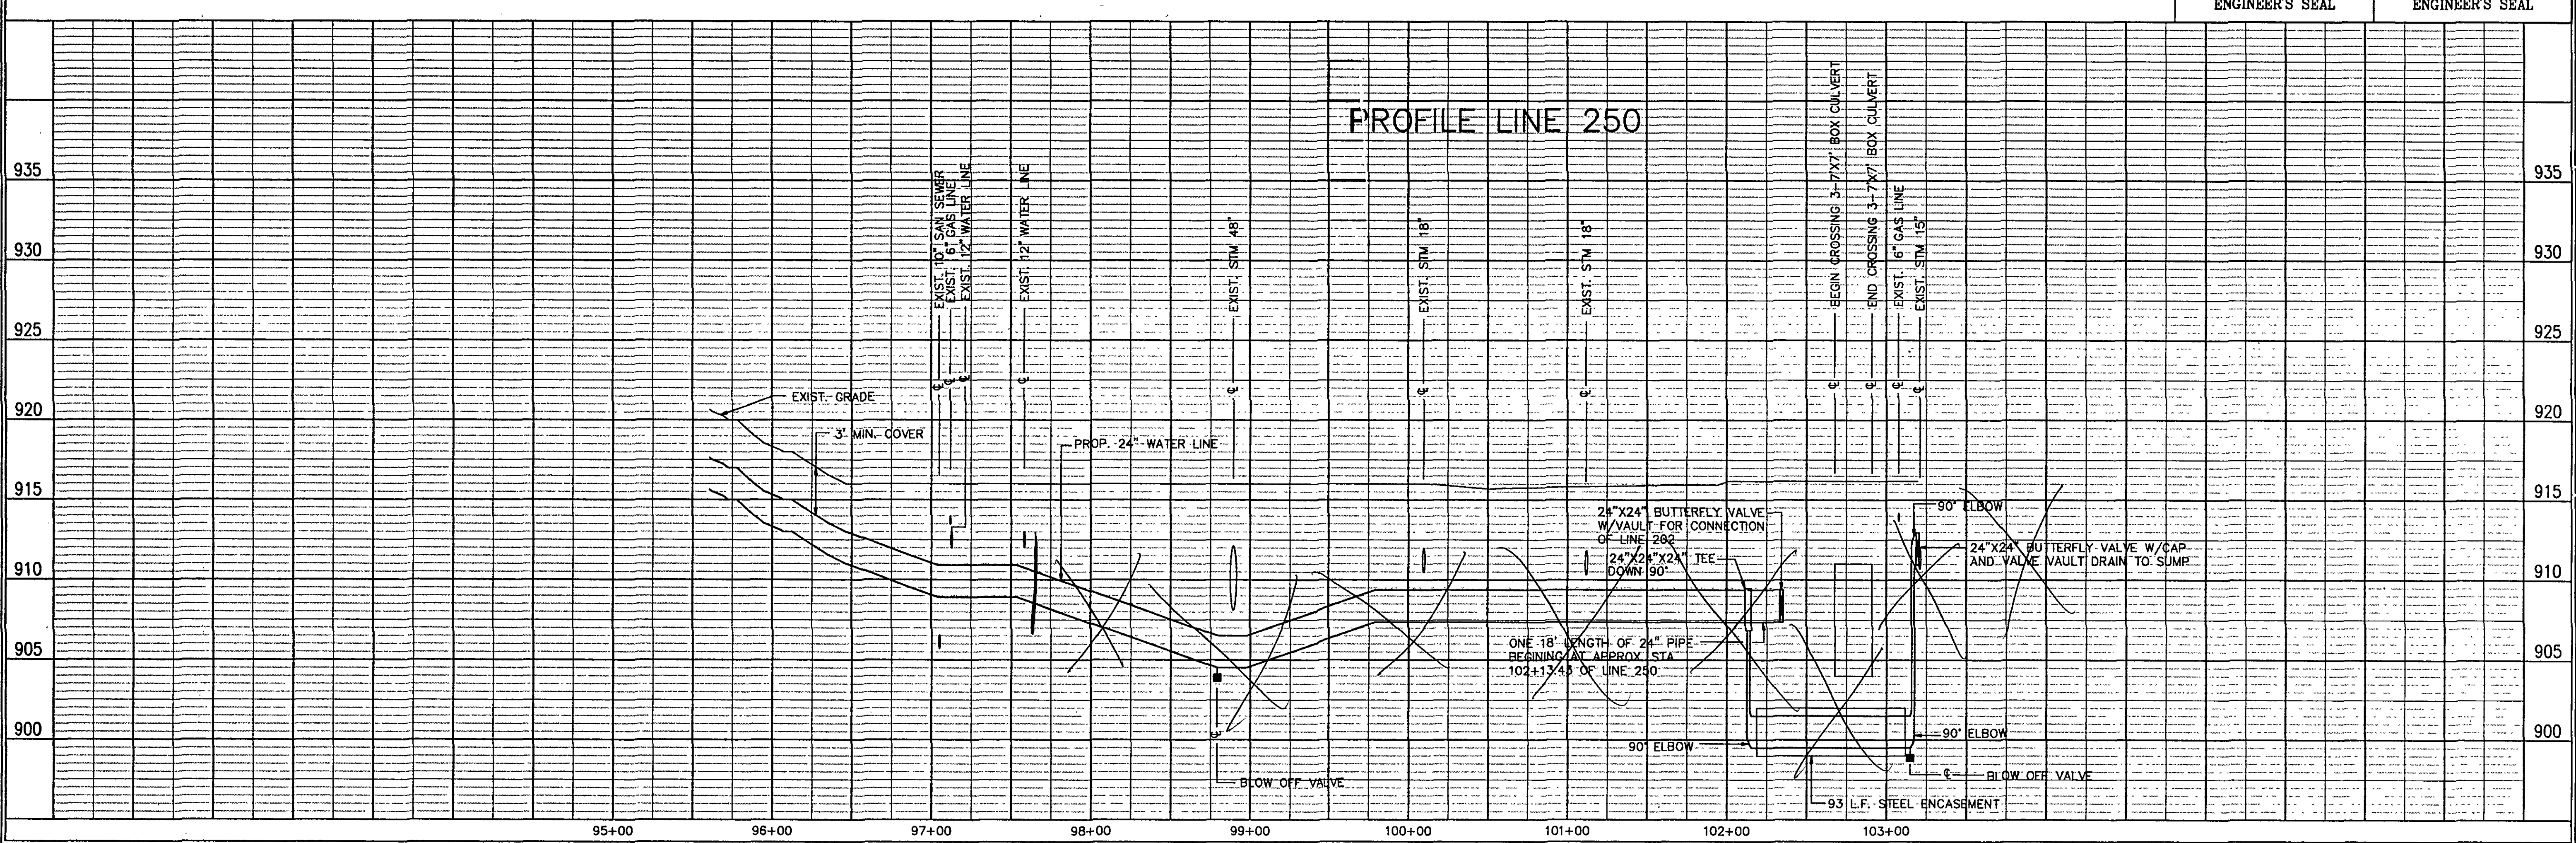


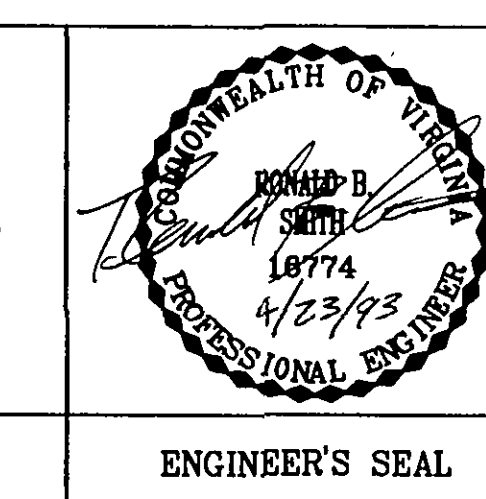

- 420 LF 24" WATERMAIN
1 EA 6" BLOWOFF
1 EA 24" BUTTERFLY VALVE
1 EA 12" TAPPING VALVE

PLAN VIEW LINE 250

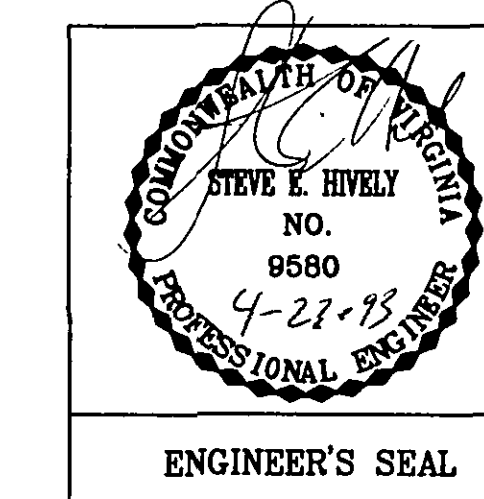

PROFILE LINE 250