

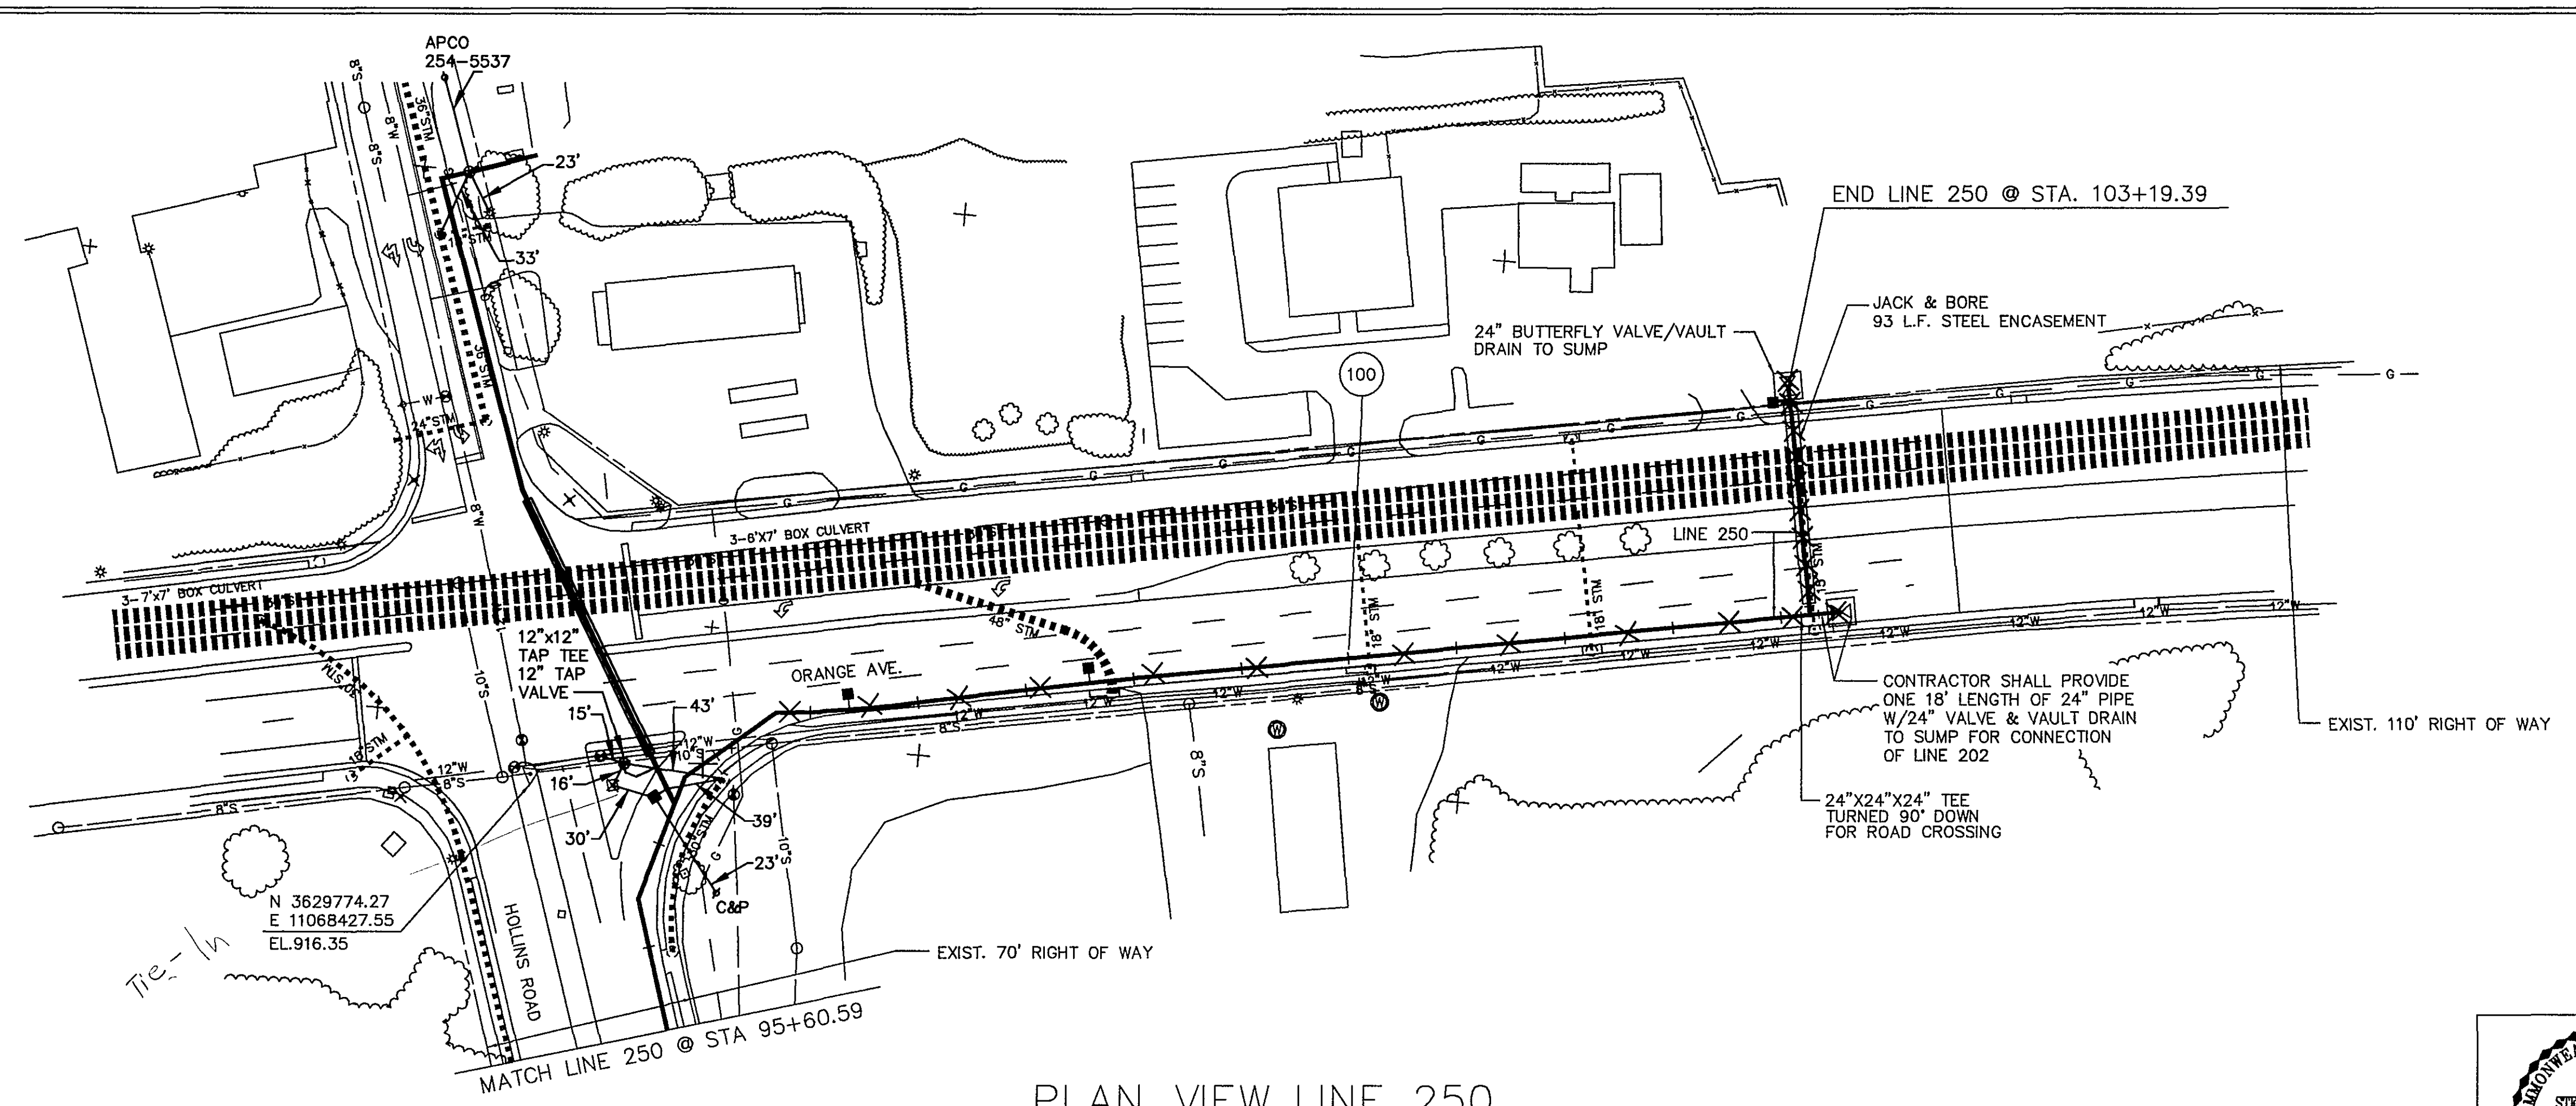


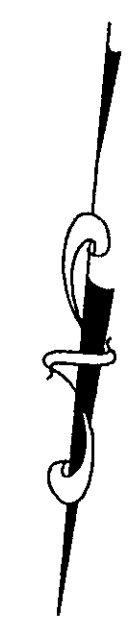


PLAN VIEW LINE 250


- THIS SHEET
- 420 LF 24" WATERMAIN
 - 1 EA. 6" BLOWOFF
 - 1 EA. 24" BUTTERFLY VALVE
 - 1 EA. 12" TAPPING VALVE

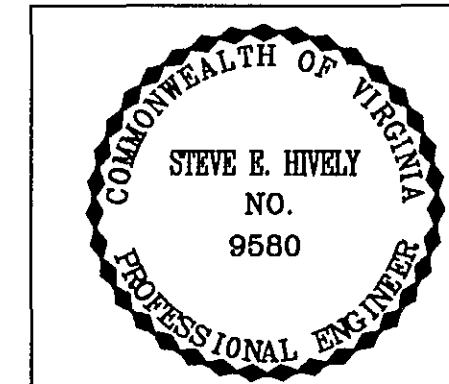

ENGINEER'S SEAL

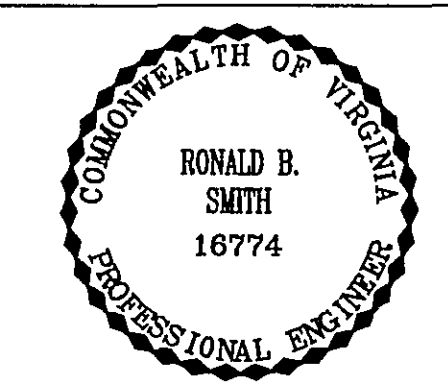

ENGINEER'S SEAL

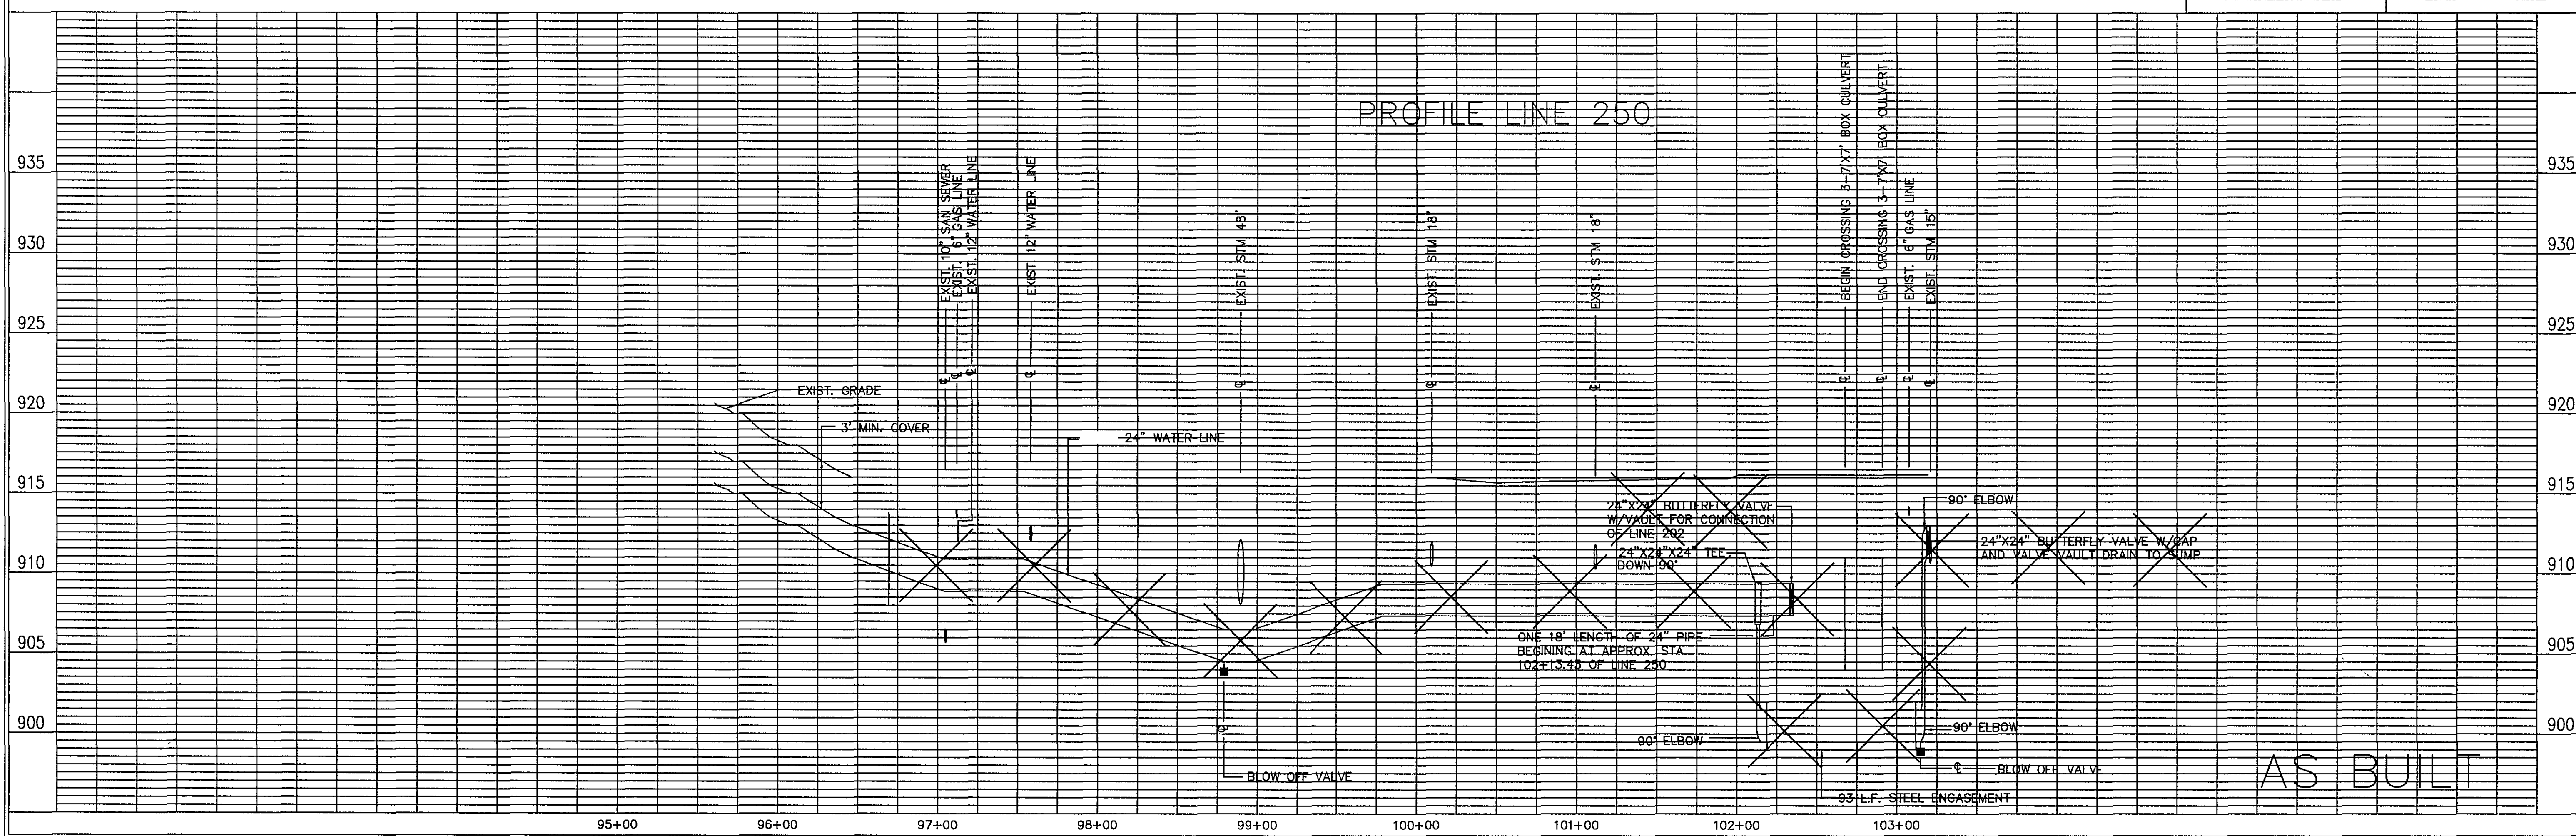

AS BUILT

Dewberry & Davis
Architects
Engineers
Planners
Surveyors
5238 Valleypointe Parkway, Suite One-B
Roanoke, Virginia 24019
703 362-7725

Carvins Cove, Phase II
City of Roanoke
Roanoke, Virginia

CONTRACT "B2"
END LINE 250
STA 95+60.59 - 103+19.39

Drawn By REH/ACF
Designed By RBS
Checked By SEH
Date APRIL 93
Scale V: 1" = 5'
H: 1" = 50'
Plan Number B4A
Zoned NONE
Sheet **9** of 22
File Number C1160