
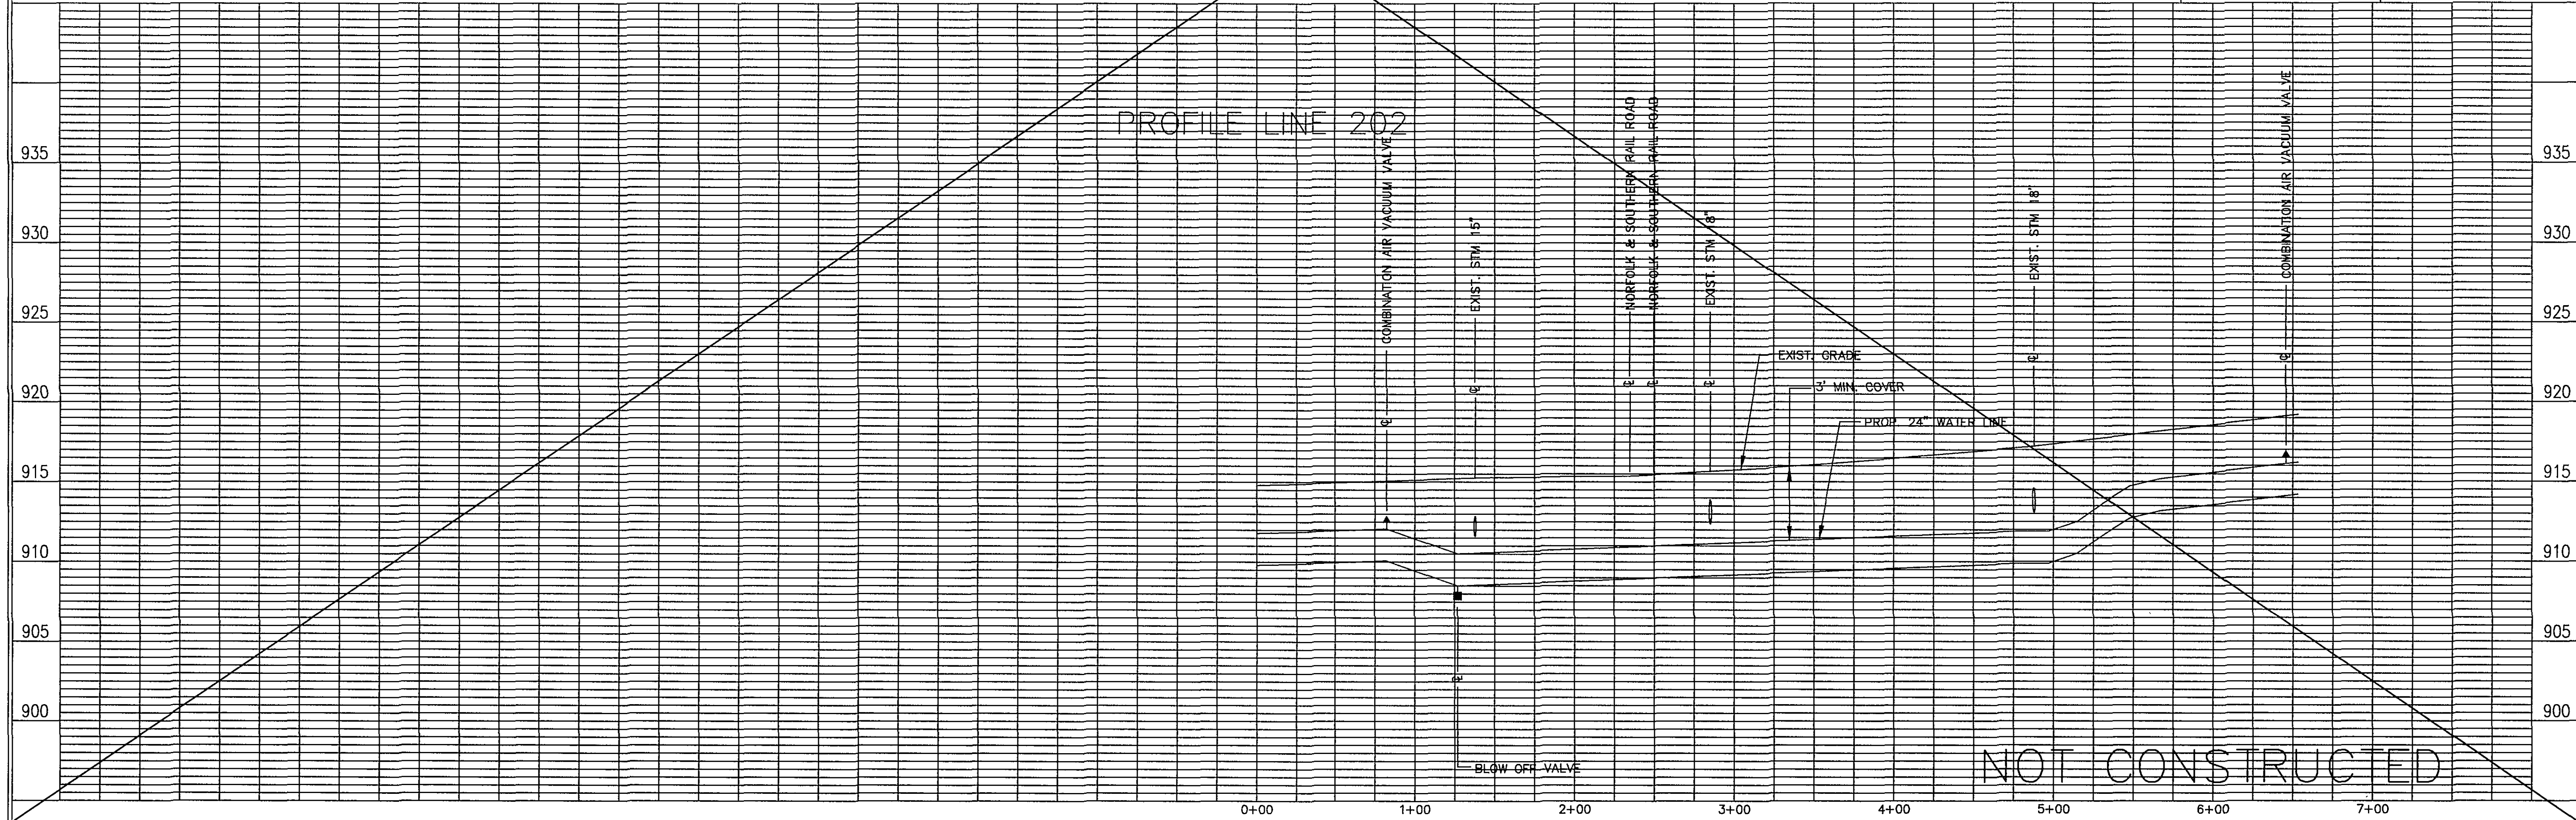


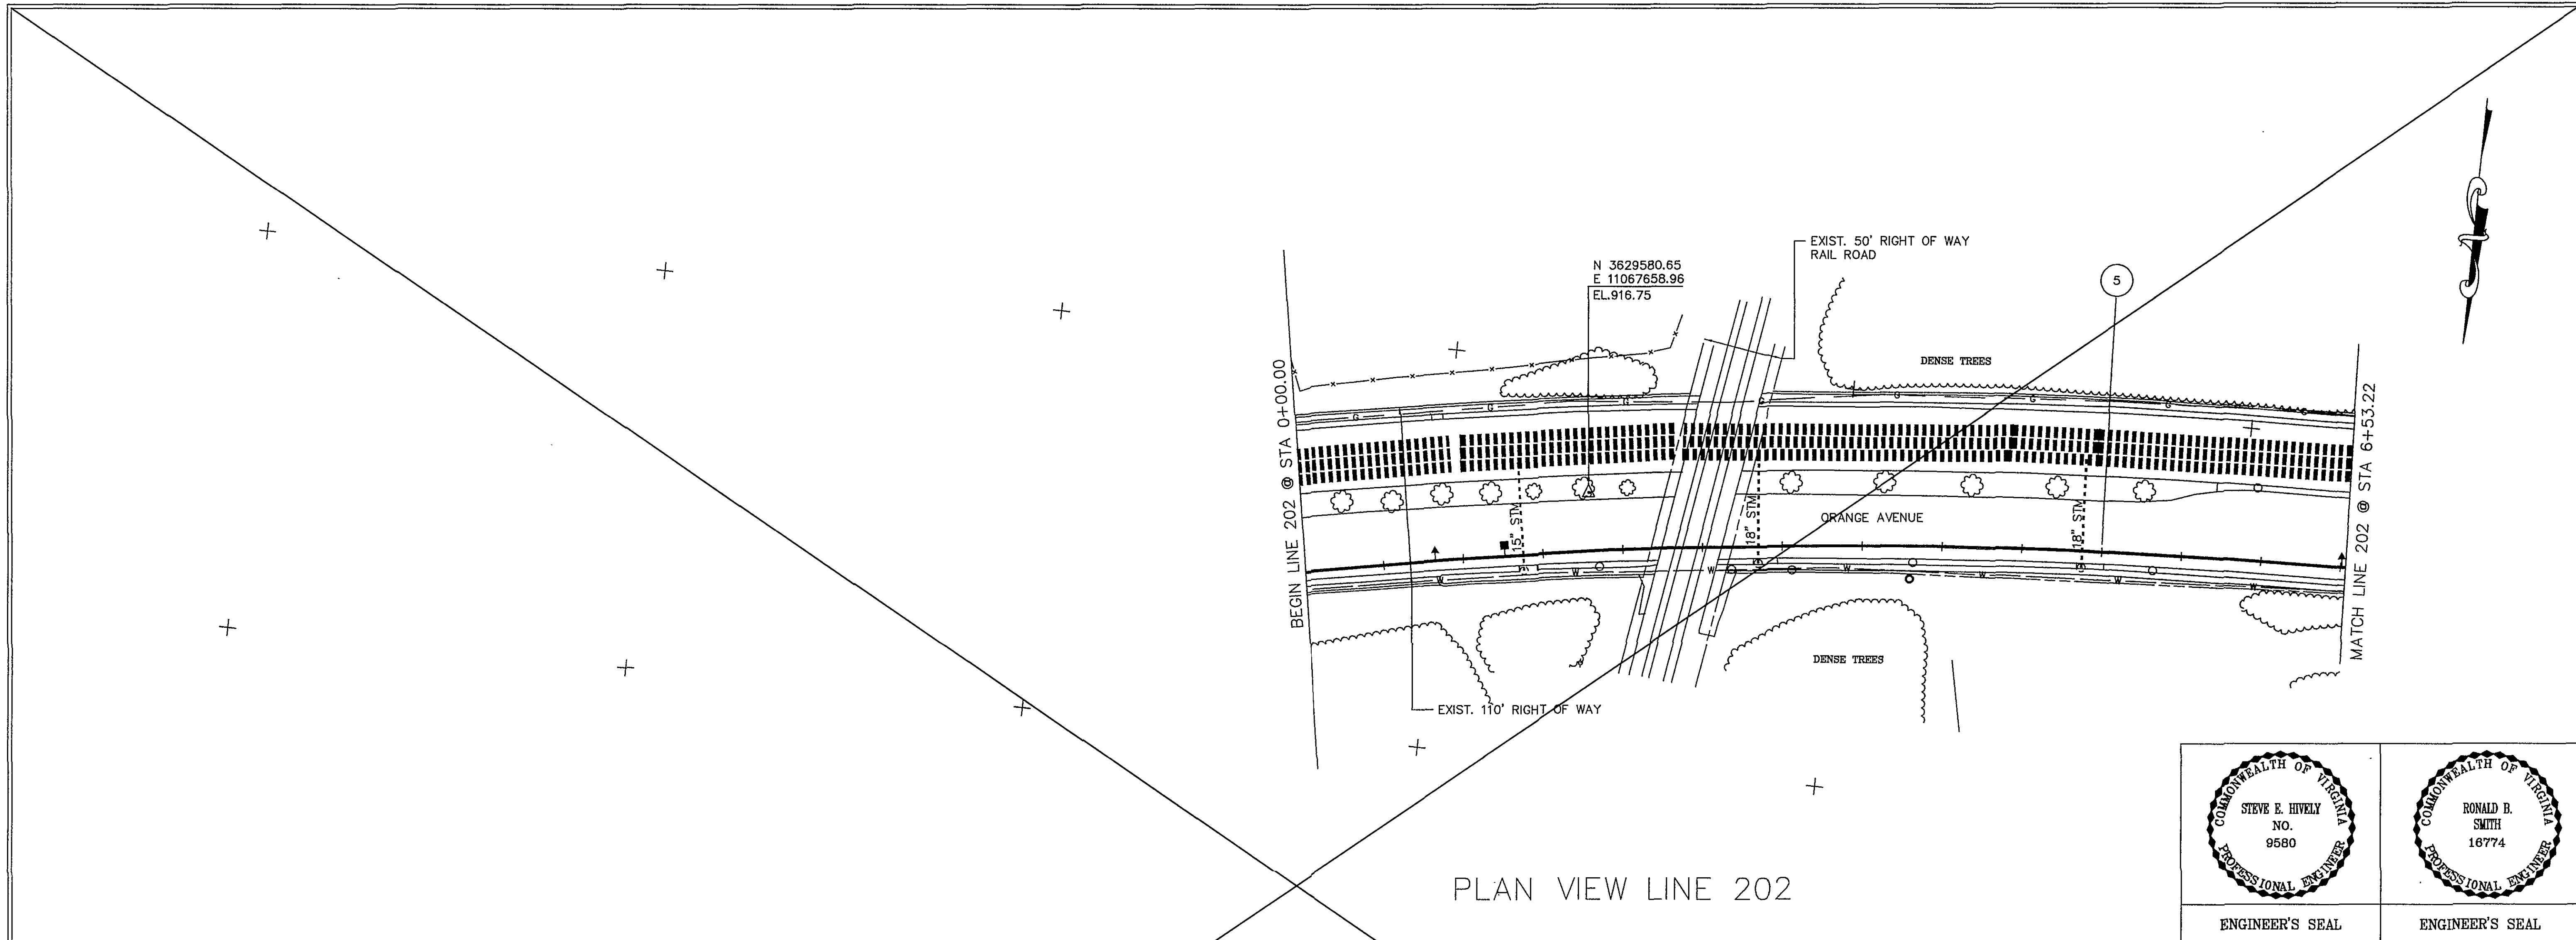

COMMONWEALTH OF VIRGINIA
STEVE E. HIVELY
NO. 9580
PROFESSIONAL ENGINEER
ENGINEER'S SEAL

COMMONWEALTH OF VIRGINIA
RONALD B. SMITH
16774
PROFESSIONAL ENGINEER
ENGINEER'S SEAL

Dewberry & Davis Architects Engineers Planners Surveyors 5238 Valleypointe Parkway, Suite One-B Roanoke, Virginia 24019 ☎ 703 362-7725	Carvins Cove, Phase II City of Roanoke Roanoke, Virginia	CONTRACT "B2" BEGIN LINE 202 STA 0+00.00 - 6+53.22
	Drawn By REH/ACF Designed By RBS Checked By SEH Date APRIL 93 Scale V: 1" = 5' H: 1" = 50' Plan Number B9 Zoned NONE Sheet 10 of 22 File Number C1160	