
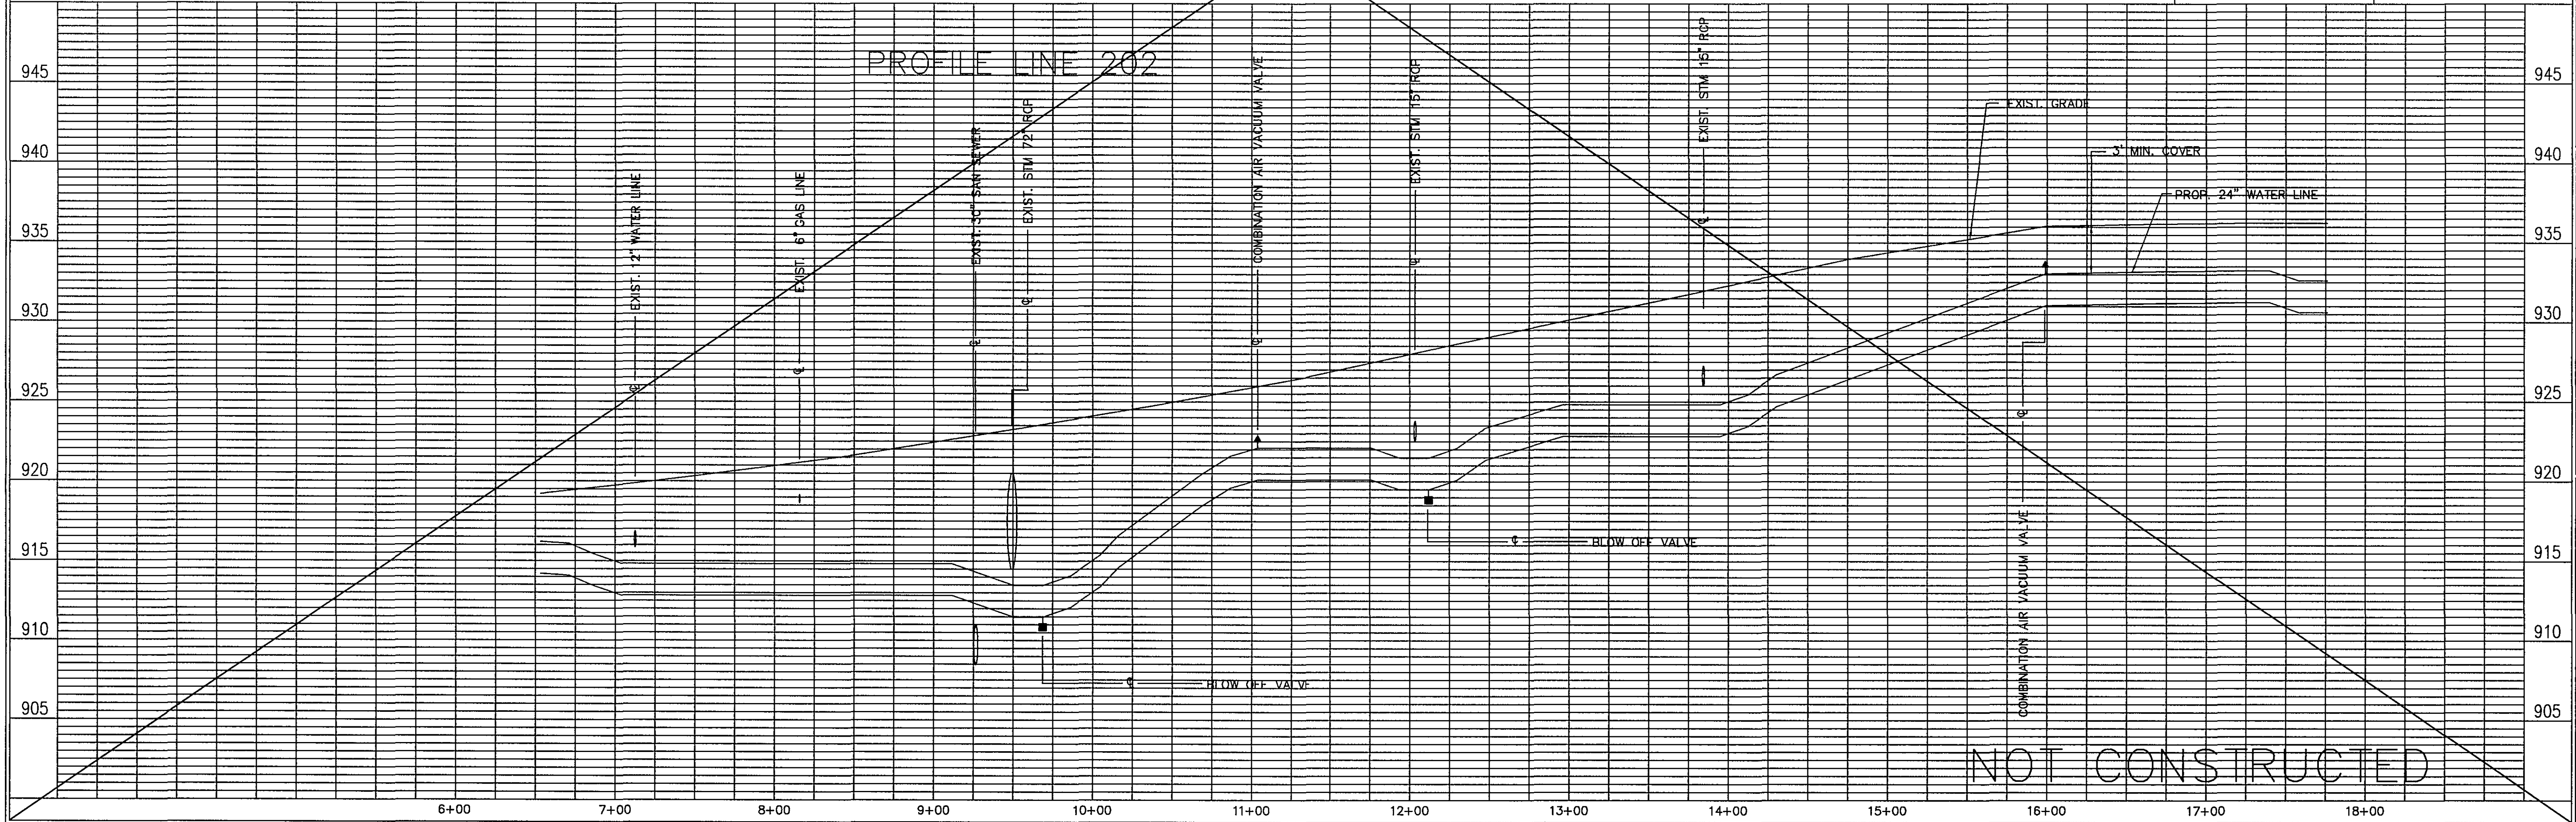


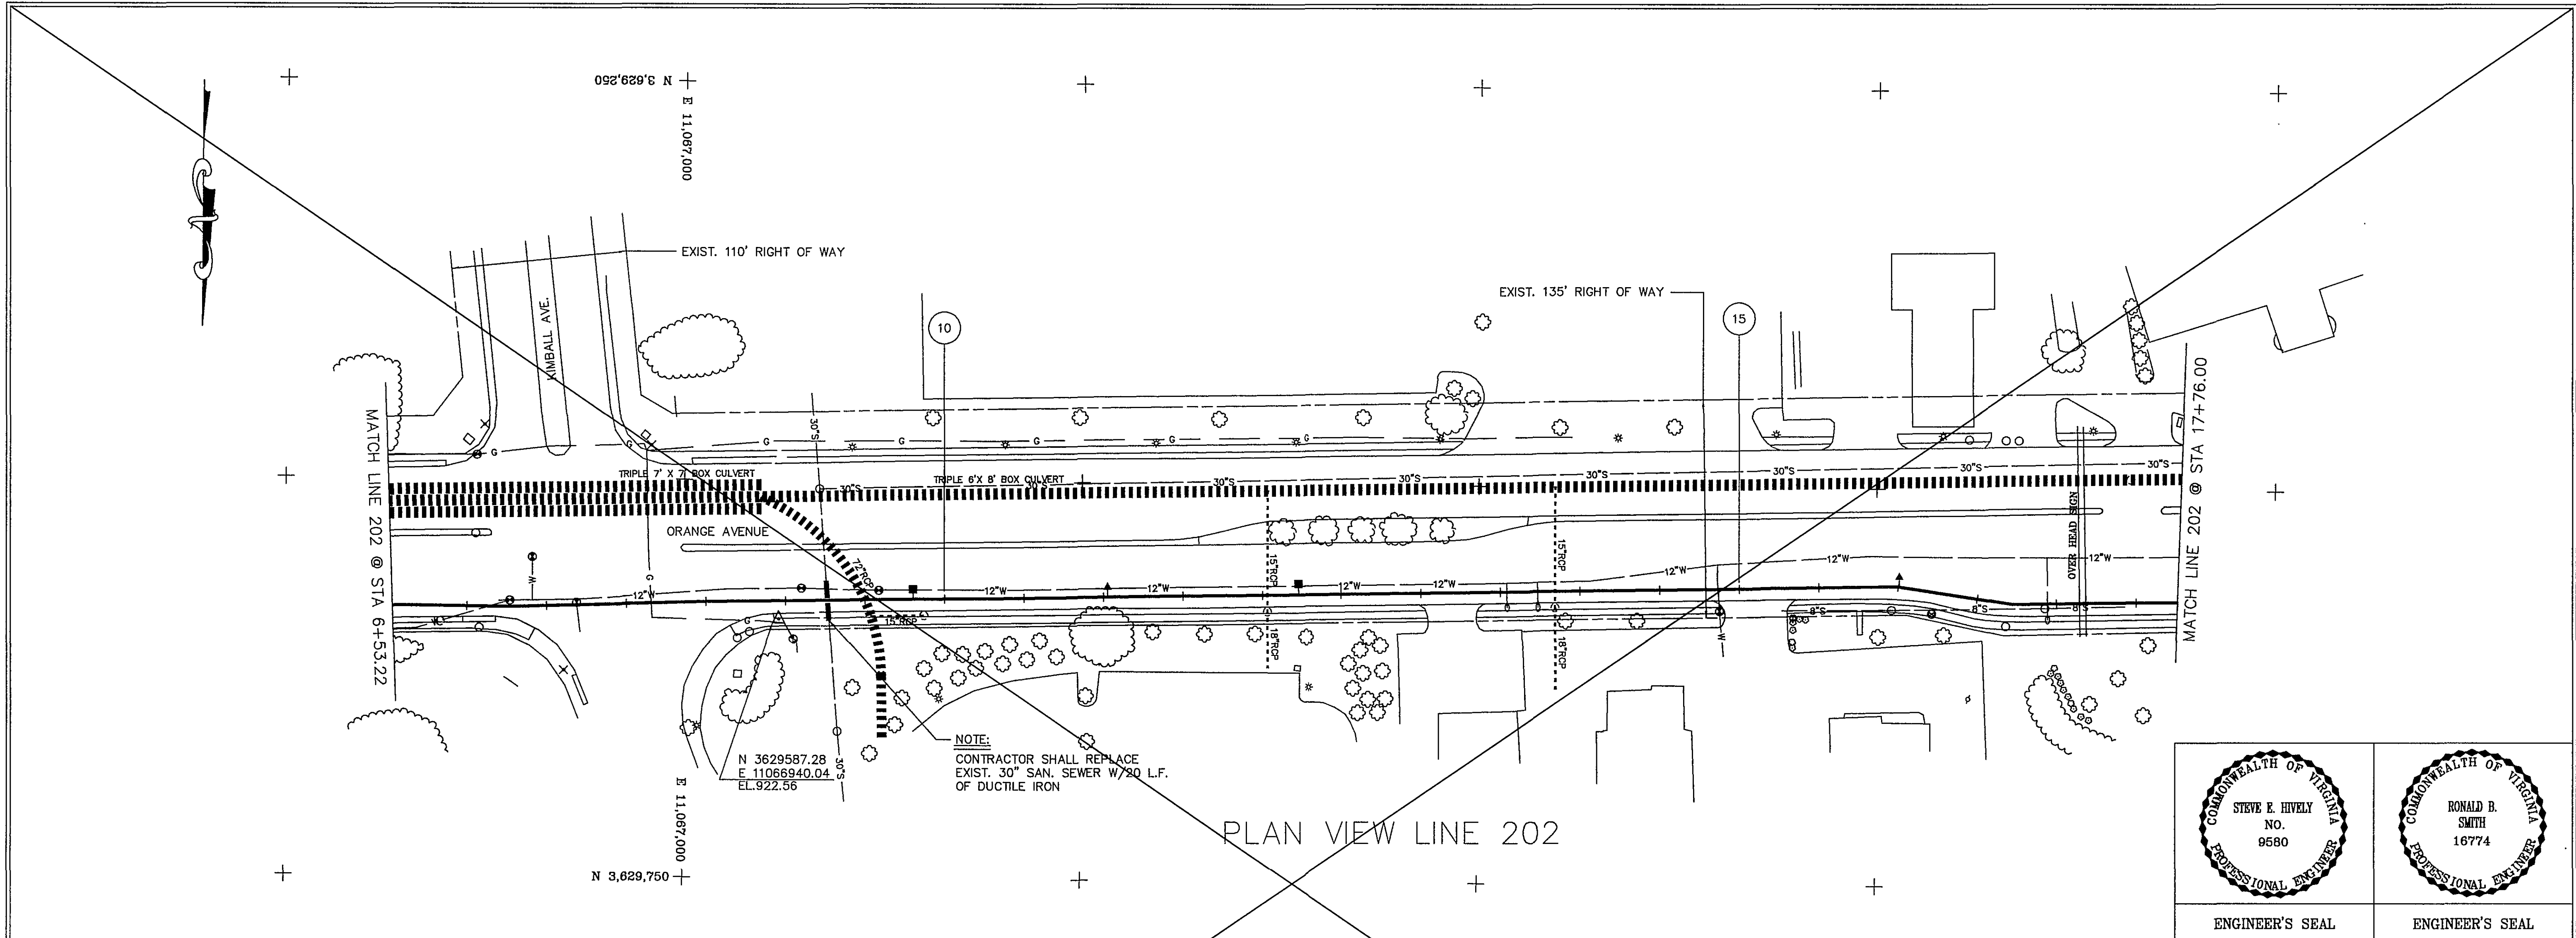

ENGINEER'S SEAL	ENGINEER'S SEAL

 Dewberry & Davis Architects Engineers Planners Surveyors 5238 Valleypointe Parkway, Suite One-B Roanoke, Virginia 24019 703 362-7726	Carvins Cove, Phase II City of Roanoke Roanoke, Virginia
	CONTRACT "B2" LINE 202 STA 6+53.22 - 17+76.00
Drawn By REH/ACF Designed By RBS Checked By SEH Date APRIL 93 Scale V: 1" = 5' H: 1" = 50' Plan Number B10 Zoned NONE Sheet 11 of 22 File Number C1160	