

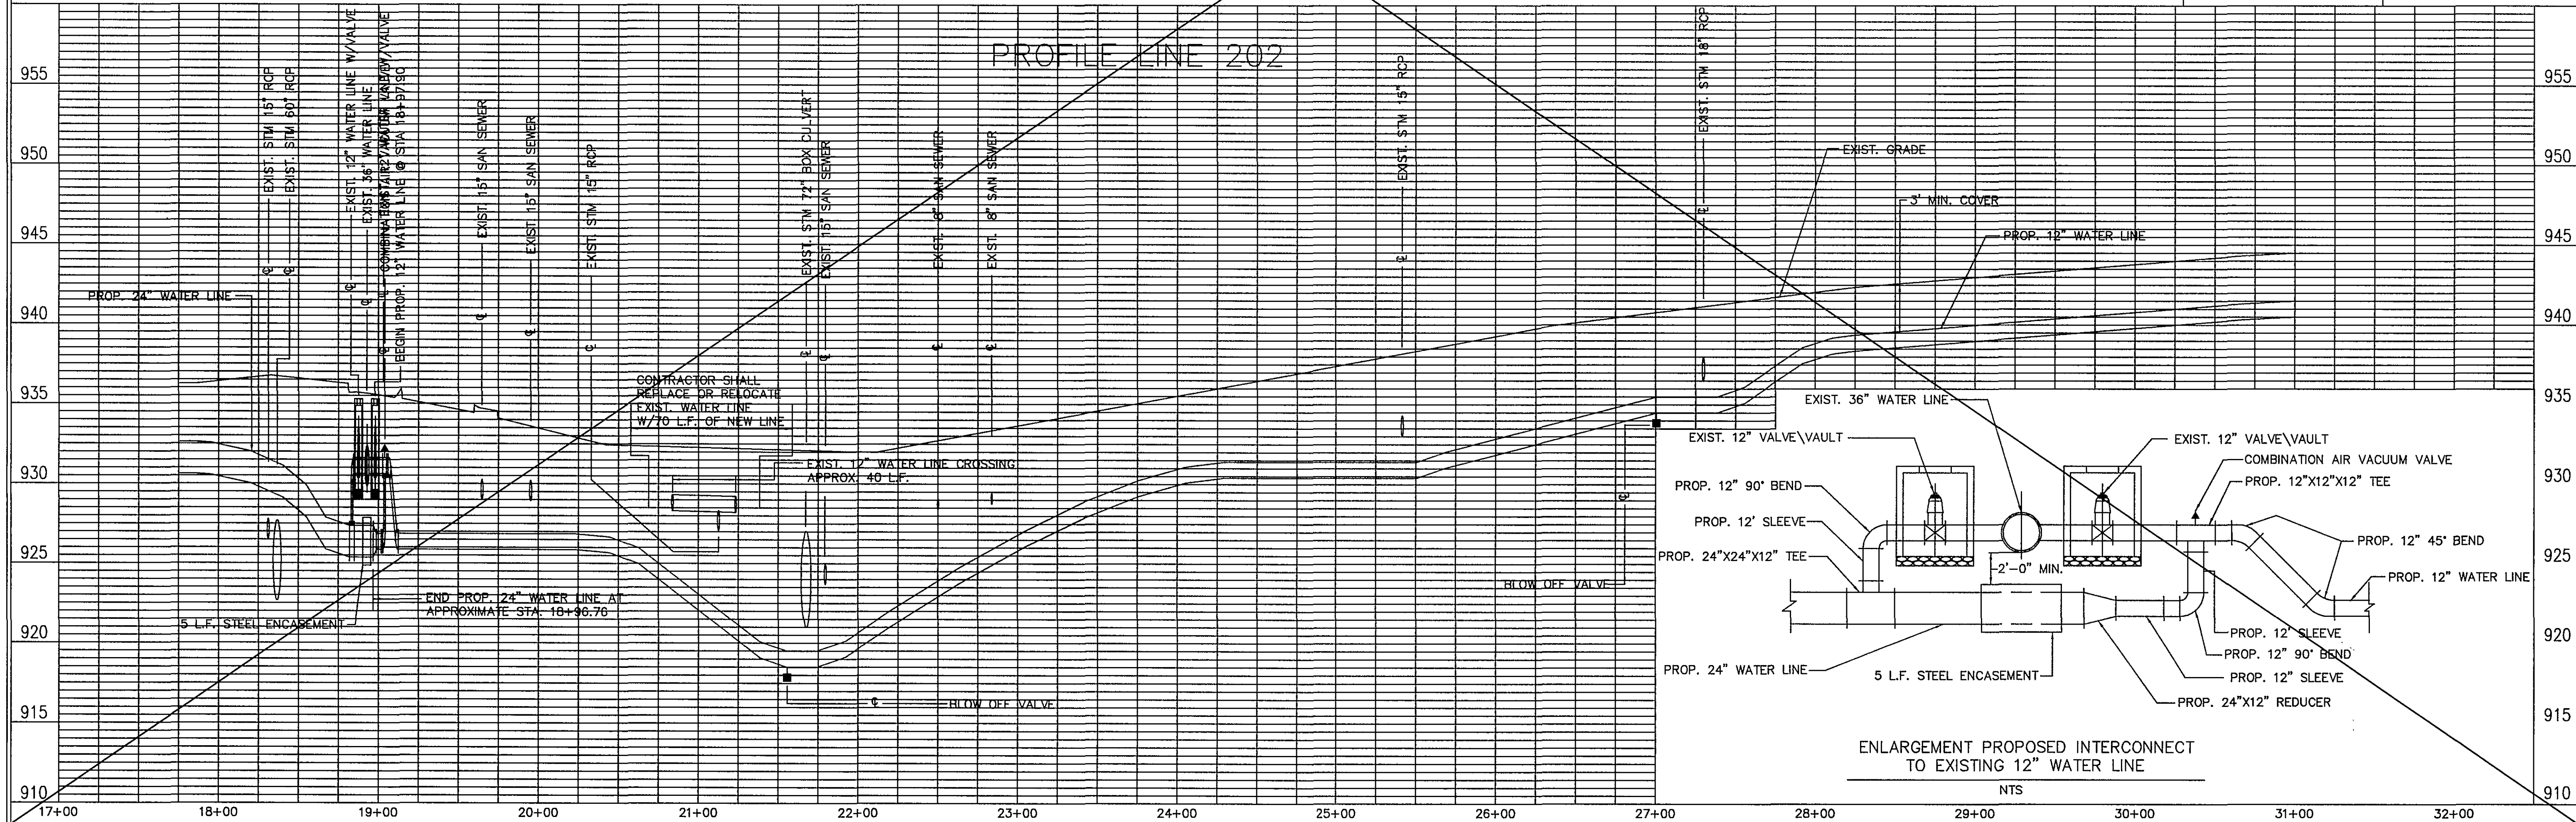
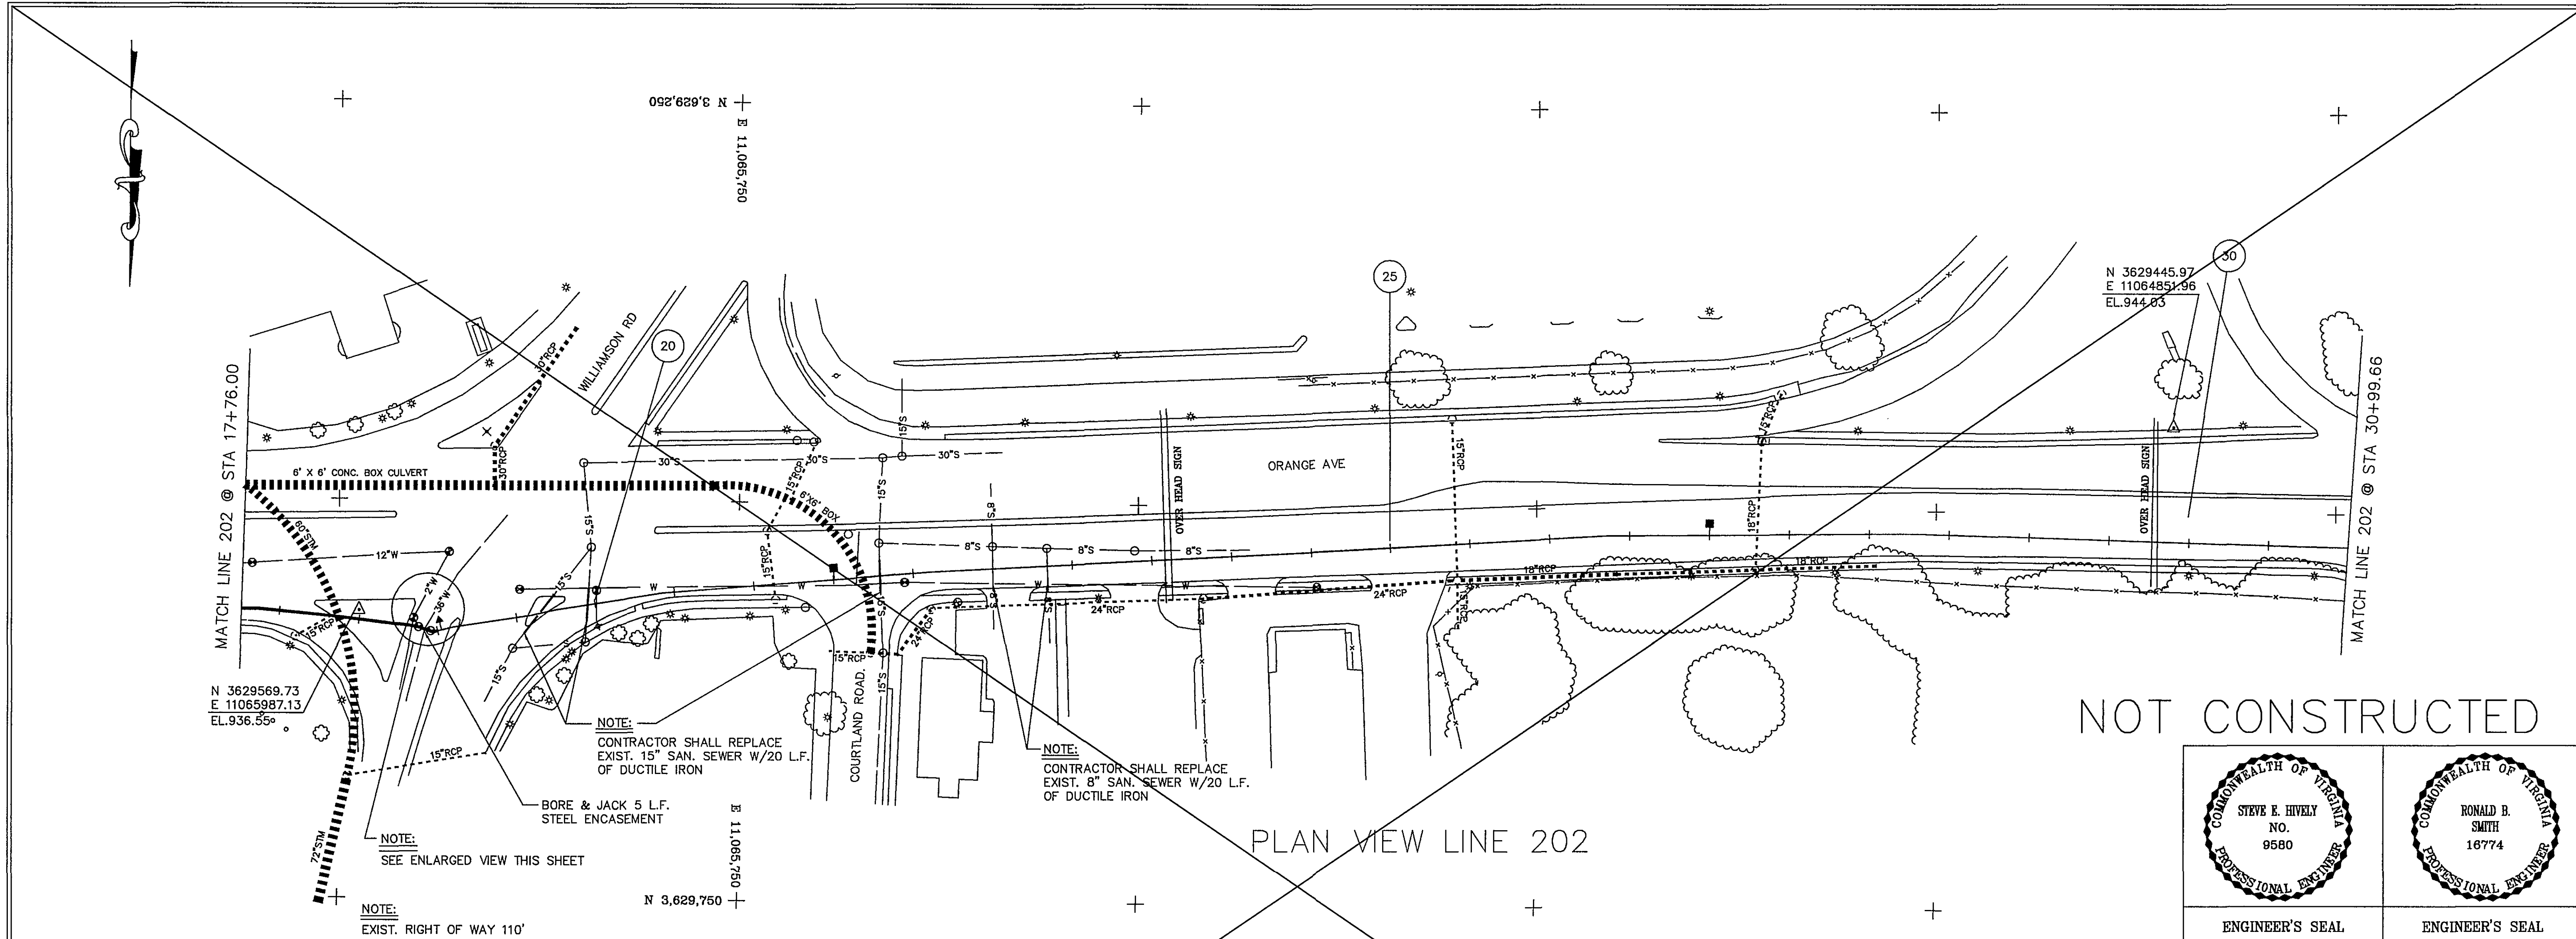


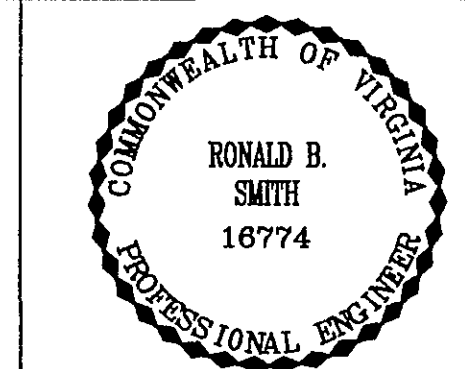

NOT CONSTRUCTED

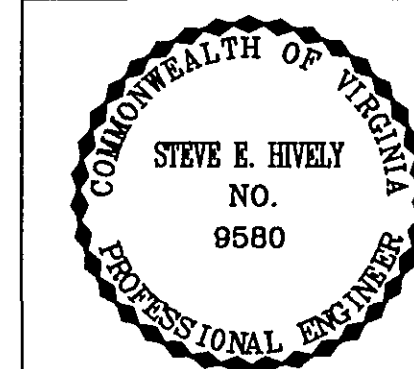

ENGINEER'S SEAL

ENGINEER'S SEAL

Dewberry & Davis
Architects
Engineers
Planners
Surveyors
5238 Valleypointe Parkway, Suite One-B
Roanoke, Virginia 24019
☎ 703 352-7725

Carvins Cove, Phase II
City of Roanoke
Roanoke, Virginia

CONTRACT "B2"
LINE 202
STA 17+76.00 - 30+99.66

Drawn By ACF/REH
Designed By RBS
Checked By SEH
Date APRIL 93
Scale V: 1" = 5'
H: 1" = 50'
Plan Number B11
Zoned NONE
Sheet **12** of 22
File Number C1160