


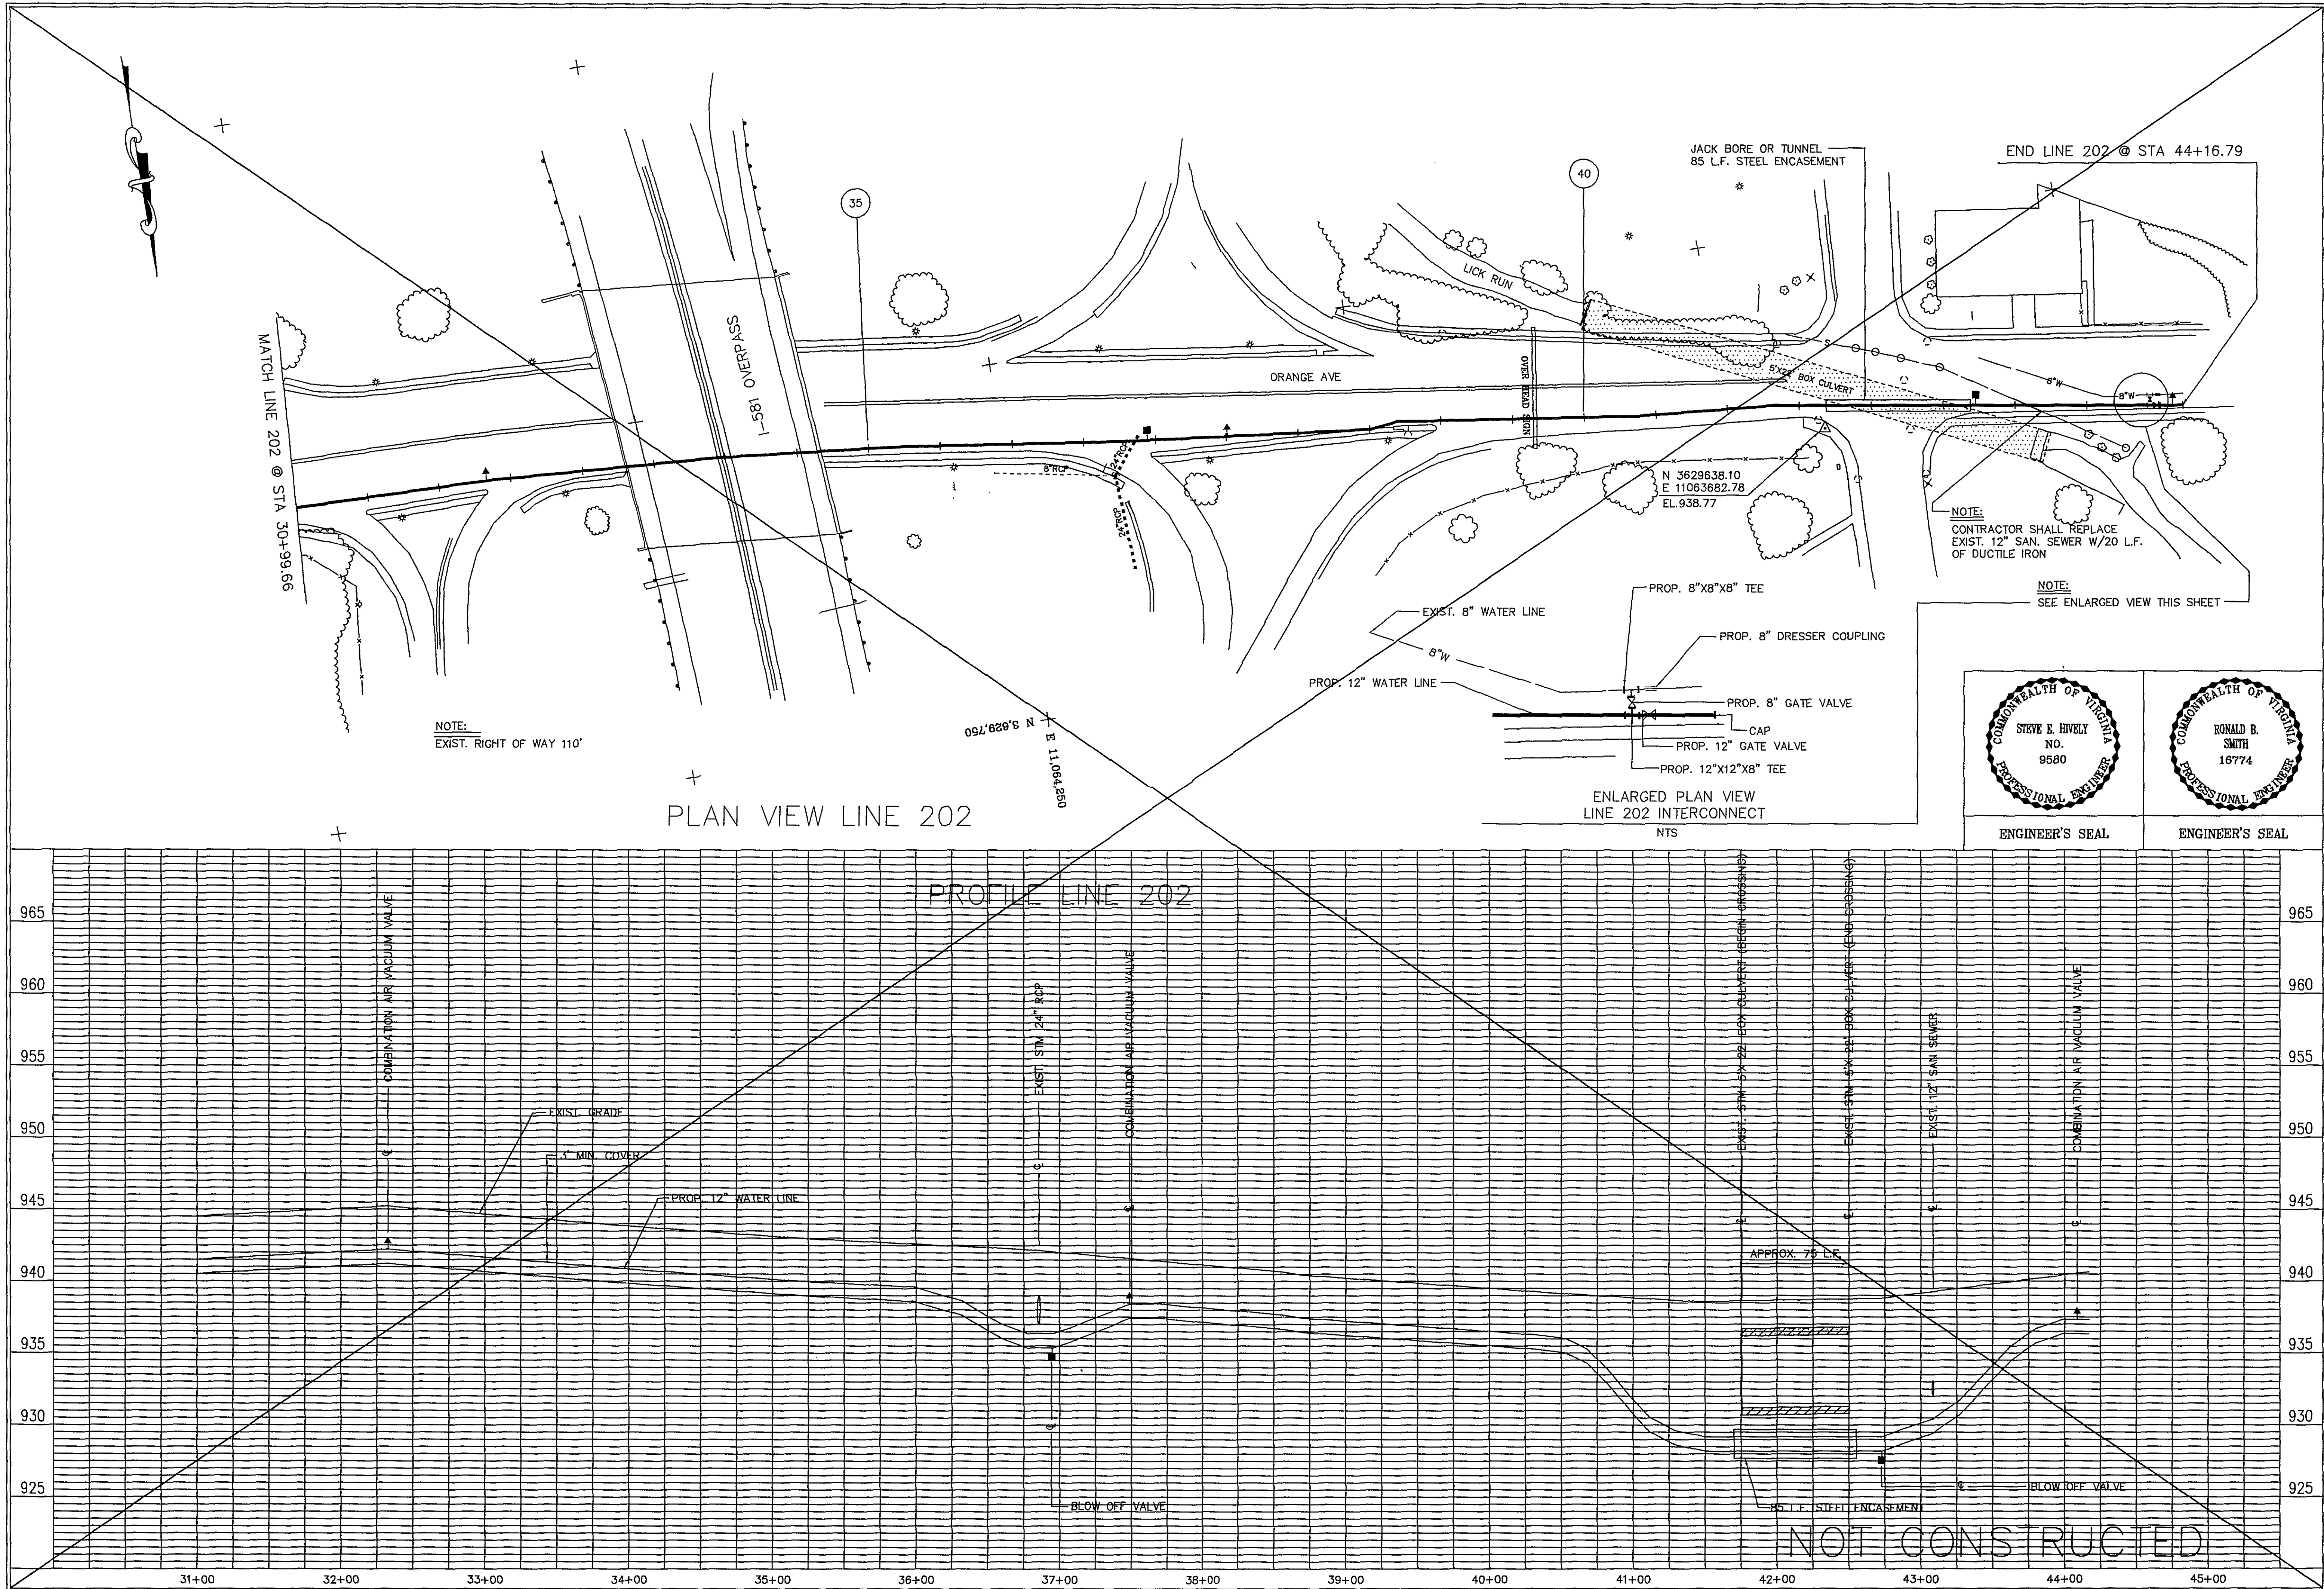

Architects
Engineers
Planners
Surveyors

Dewberry & Davis

5238 Valleypointe Parkway, Suite One-B
Roanoke, Virginia 24019
☎ 703 962-7725

Carvins Cove, Phase II

City of Roanoke

Roanoke, Virginia

CONTRACT "B2"

END LINE 202

STA 30+99.66 - 44+16.79

Drawn By ACF/REH

Designed By RBS

Checked By SEH

Date MAY 93

Scale
V: 1" = 5'
H: 1" = 50'

Plan Number B12

Zoned NONE

Sheet 13 of 22

File Number C1160