




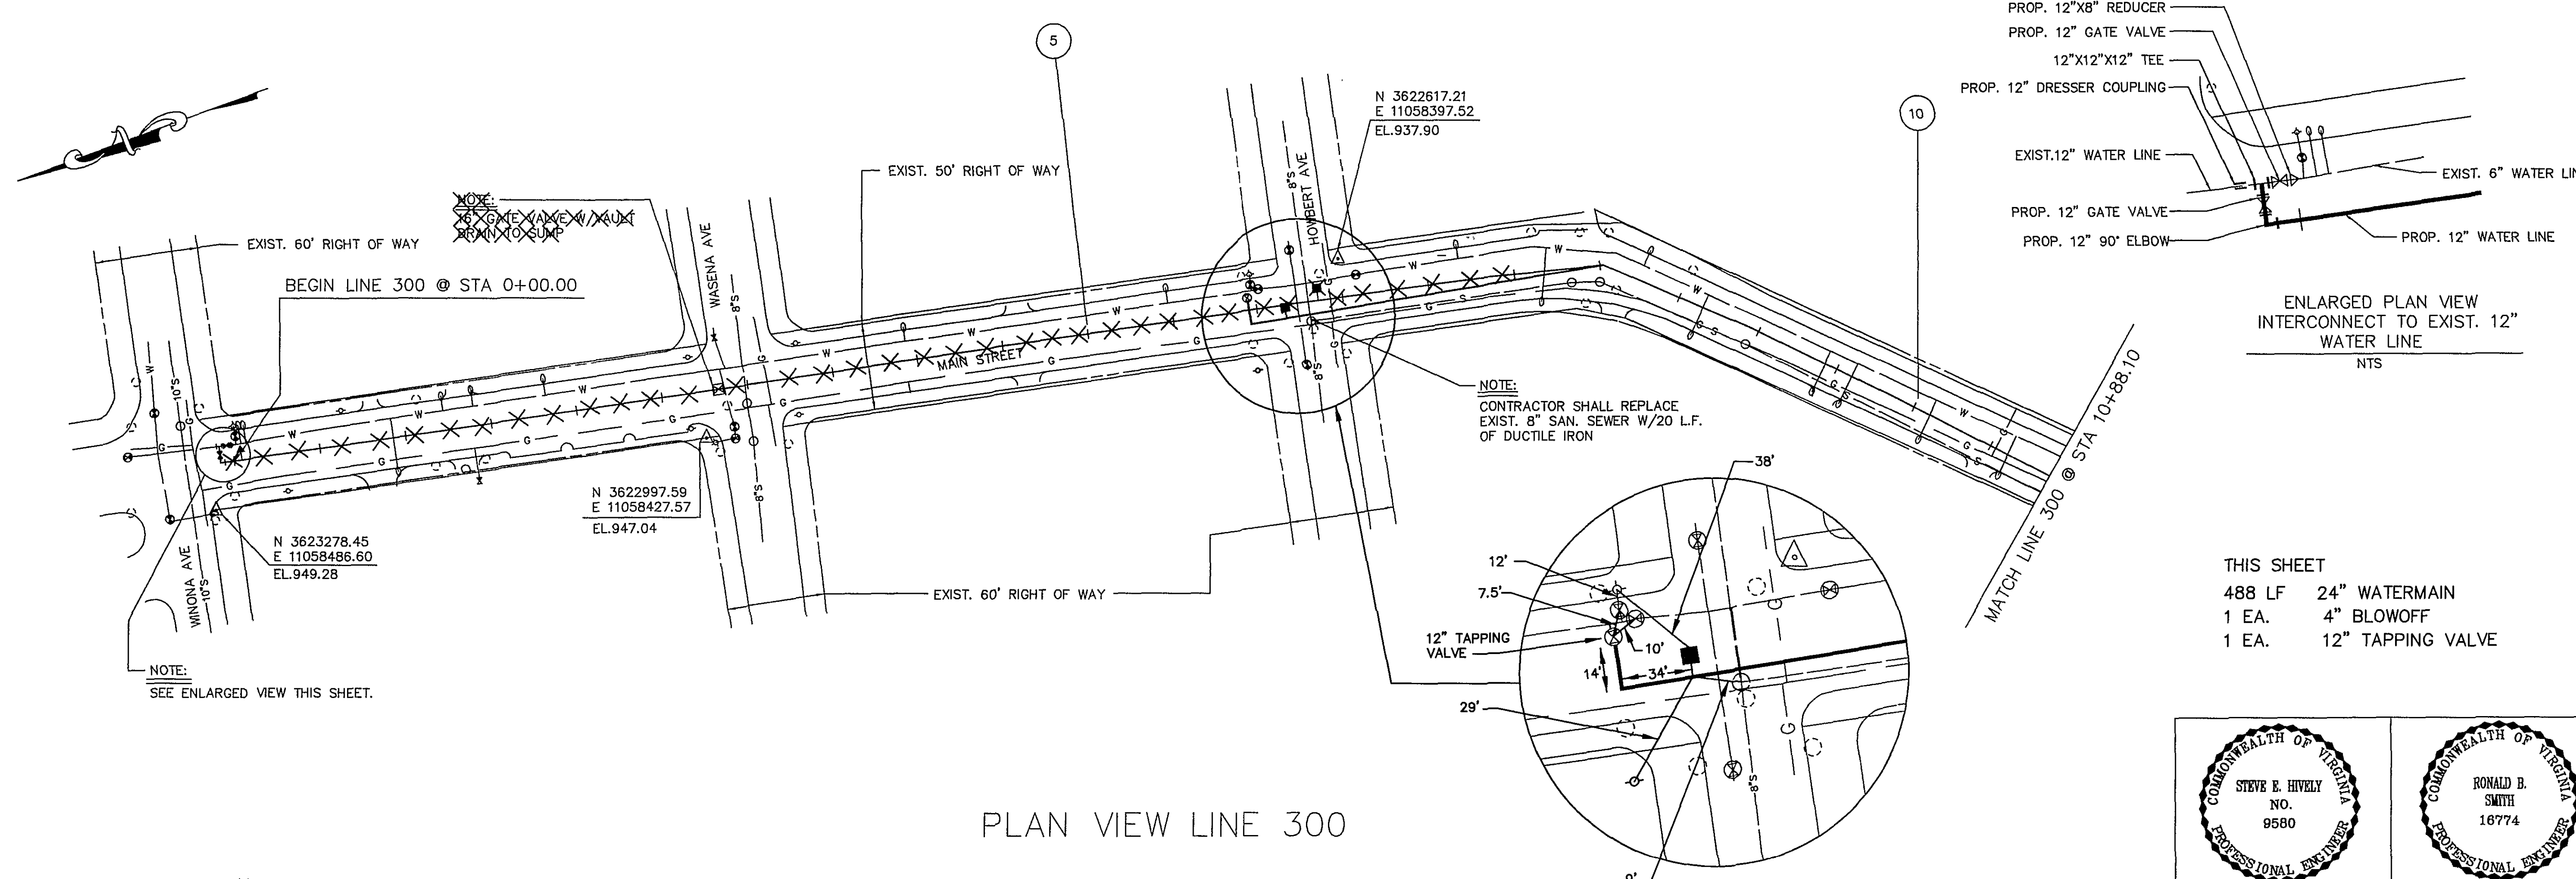

PLAN VIEW LINE 300

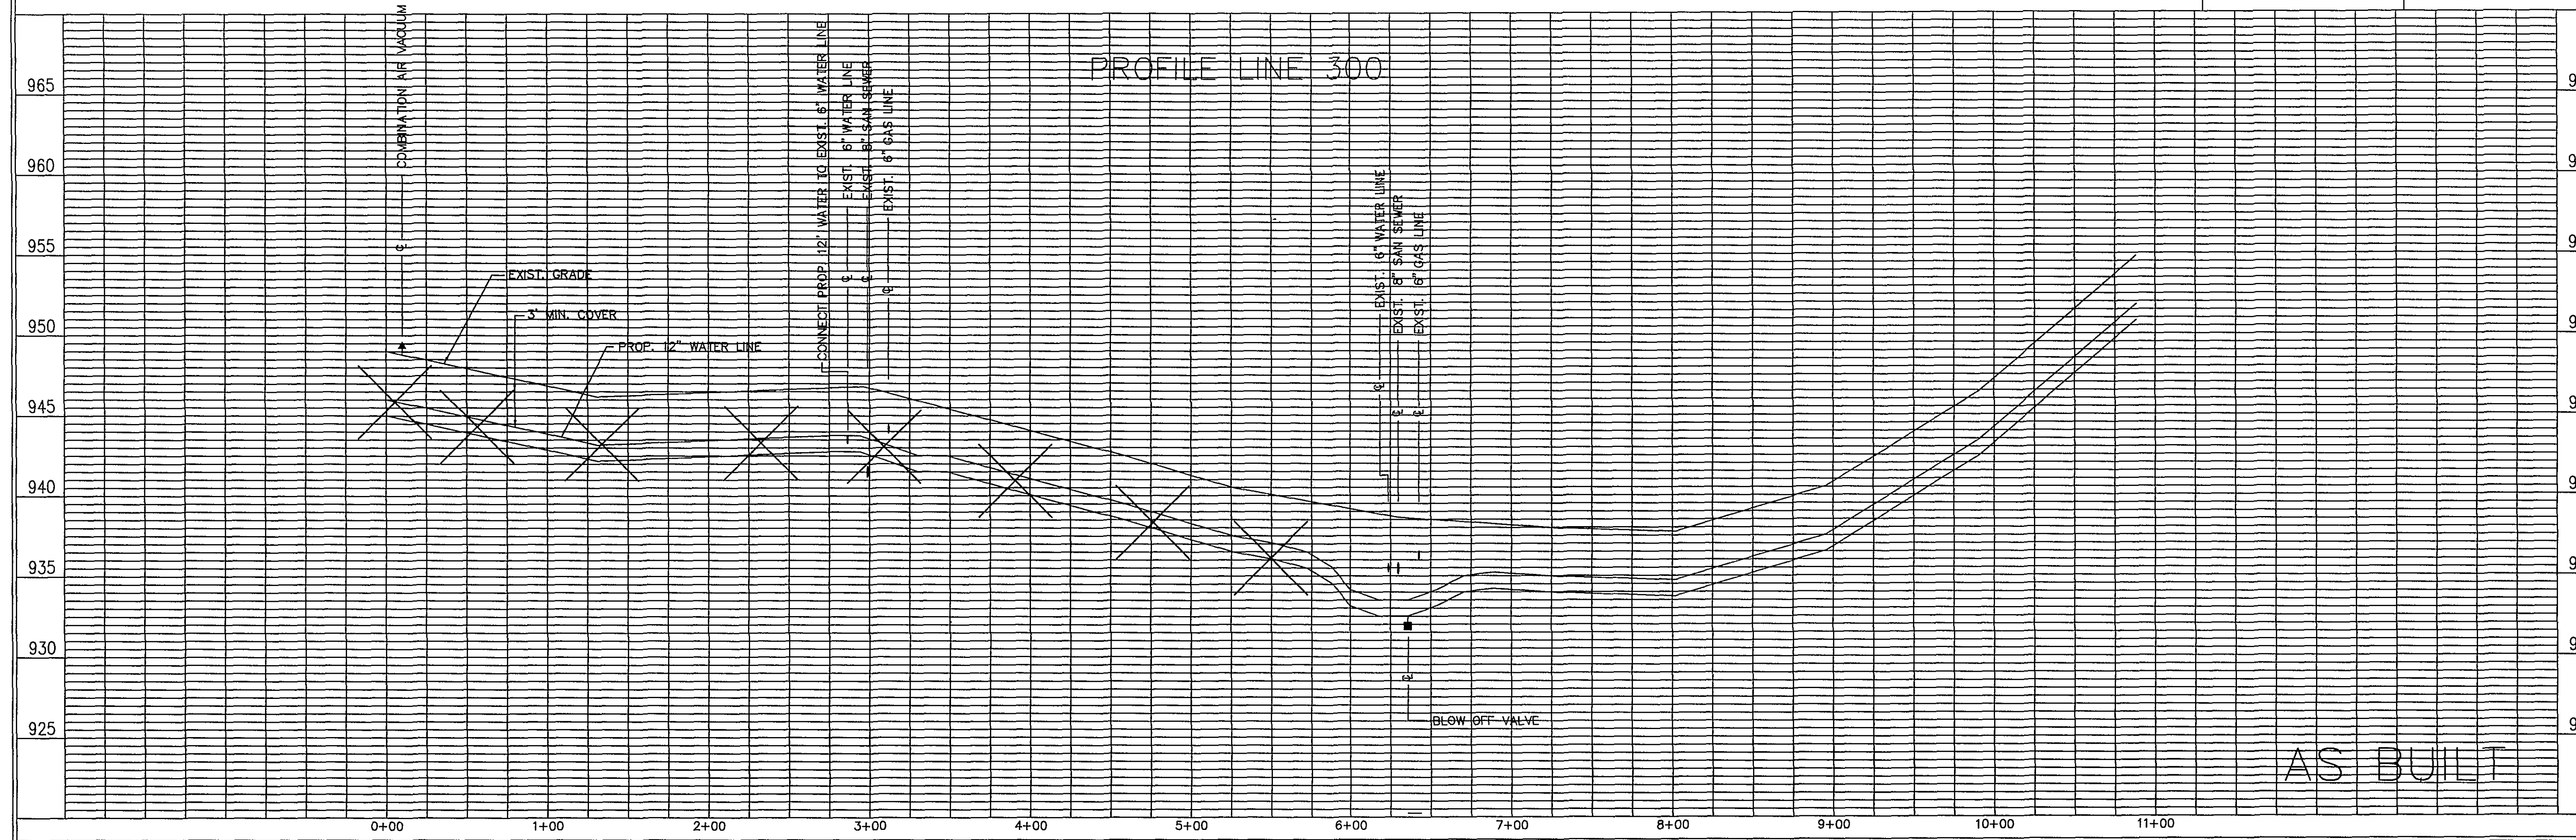


AS BUILT

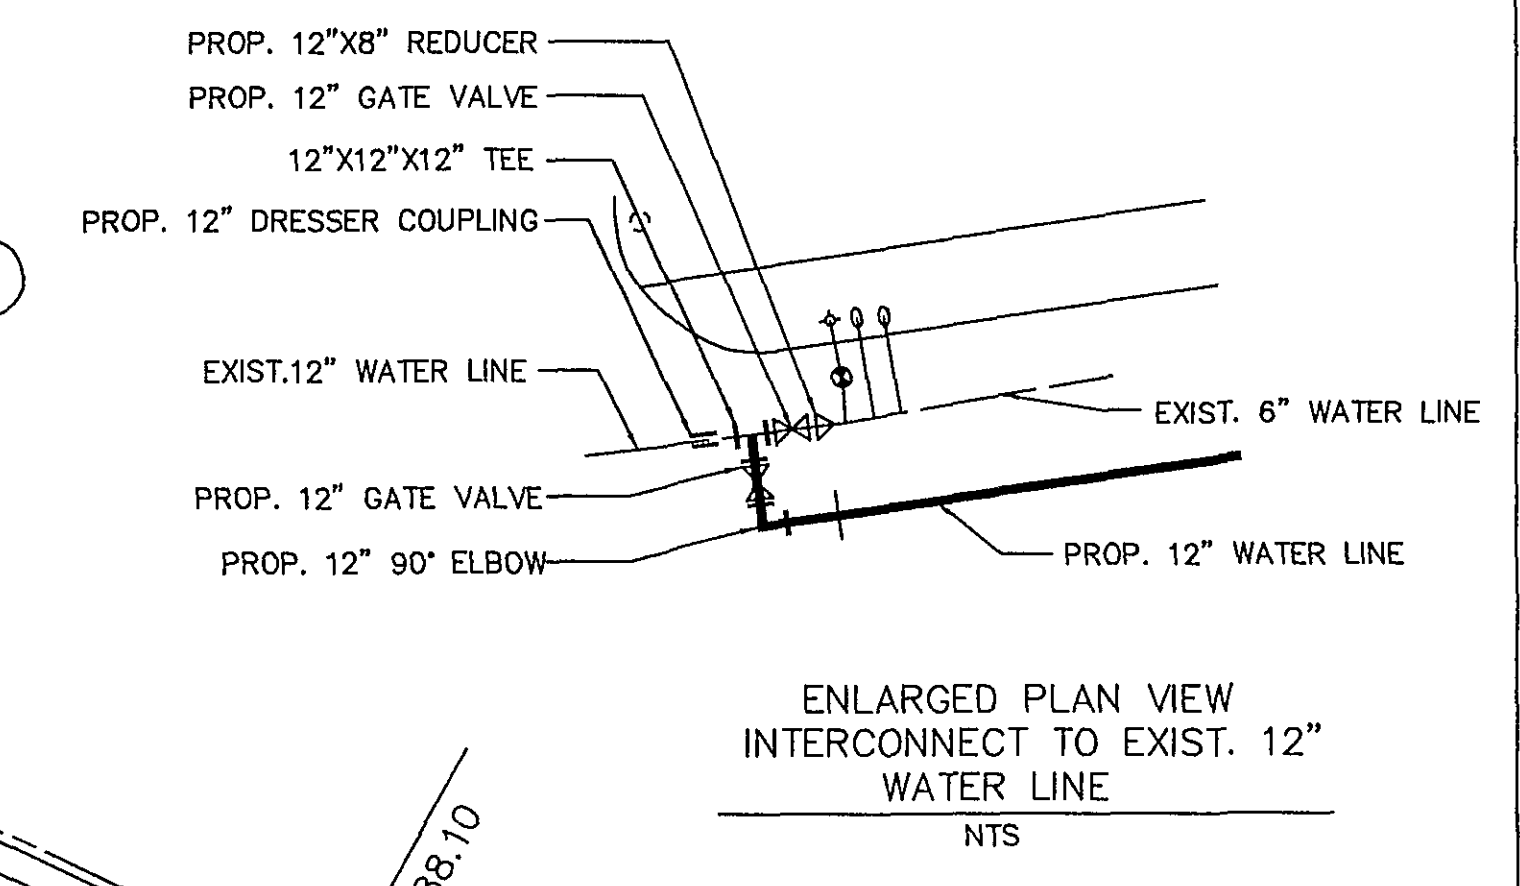


ENLARGED PLAN VIEW
INTERCONNECT TO EXIST. 12"
WATER LINE
NTS

THIS SHEET
488 LF 24" WATERMAIN
1 EA. 4" BLOWOFF
1 EA. 12" TAPPING VALVE

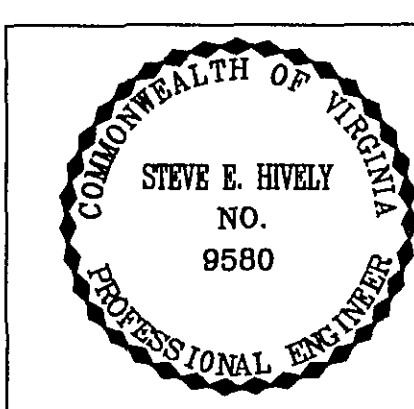

ENGINEER'S SEAL

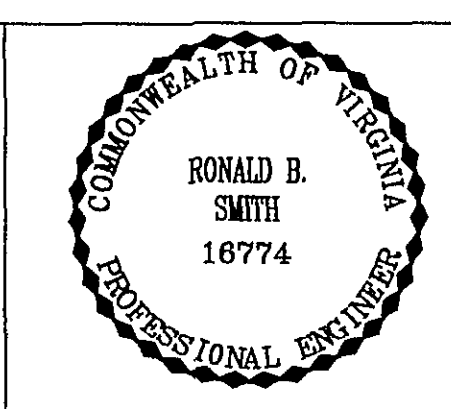

ENGINEER'S SEAL

Dewberry & Davis
Architects
Engineers
Planners
Surveyors
5238 Valleypointe Parkway, Suite One-B
Roanoke, Virginia 24019
703 962-7725

Carvins Cove, Phase II
City of Roanoke
Roanoke, Virginia

CONTRACT "B2"
BEGIN LINE 300
STA 0+00.00 - 10+88.10

Drawn By REH/ACF
Designed By RBS
Checked By SEH
Date APRIL 93
Scale V: 1" = 5'
H: 1" = 50'
Plan Number MS1
Zoned NONE
Sheet 14 of 22
File Number C1160