


1213 LF	24" WATERMAIN
2 EA.	4" BLOWOFF
1 EA.	1" A.R.V.
2 EA.	6" GATE VALVE
1 EA.	12" GATE VALVE

NOTE: _____
CONTRACTOR SHALL REPLACE
EXIST. 10" SAN. SEWER W/20 L.F.
OF DUCTILE IRON

MATCH LINE 300 @ STA 23+01.50

ENLARGED PLAN VIEW
CONNECT/ABANDONMENT
DETAIL
NTS

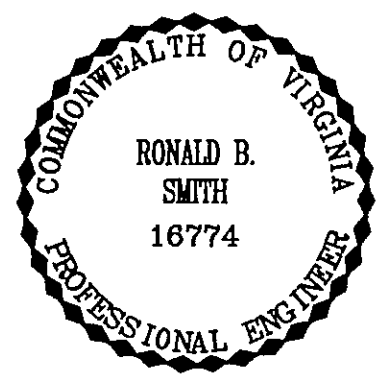

ENGINEER'S SEAL

AS BUILT

 **Dewberry & Davis**
5238 Vallemonte Parkway Suite One-B

CONTRACT "B2"
LINE 300
STA 10+88.10 - 23+01.50

Drawn By	REH/ACF
Designed By	RBS
Checked By	SEH
Date	APRIL 93
Scale	V: 1" = 5' H: 1" = 50'
Man Number	MS2
Notes	NONE
Sheet	15 of 22
File Number	C1160