



THIS SHEET
600 LF 12" WATERMAIN

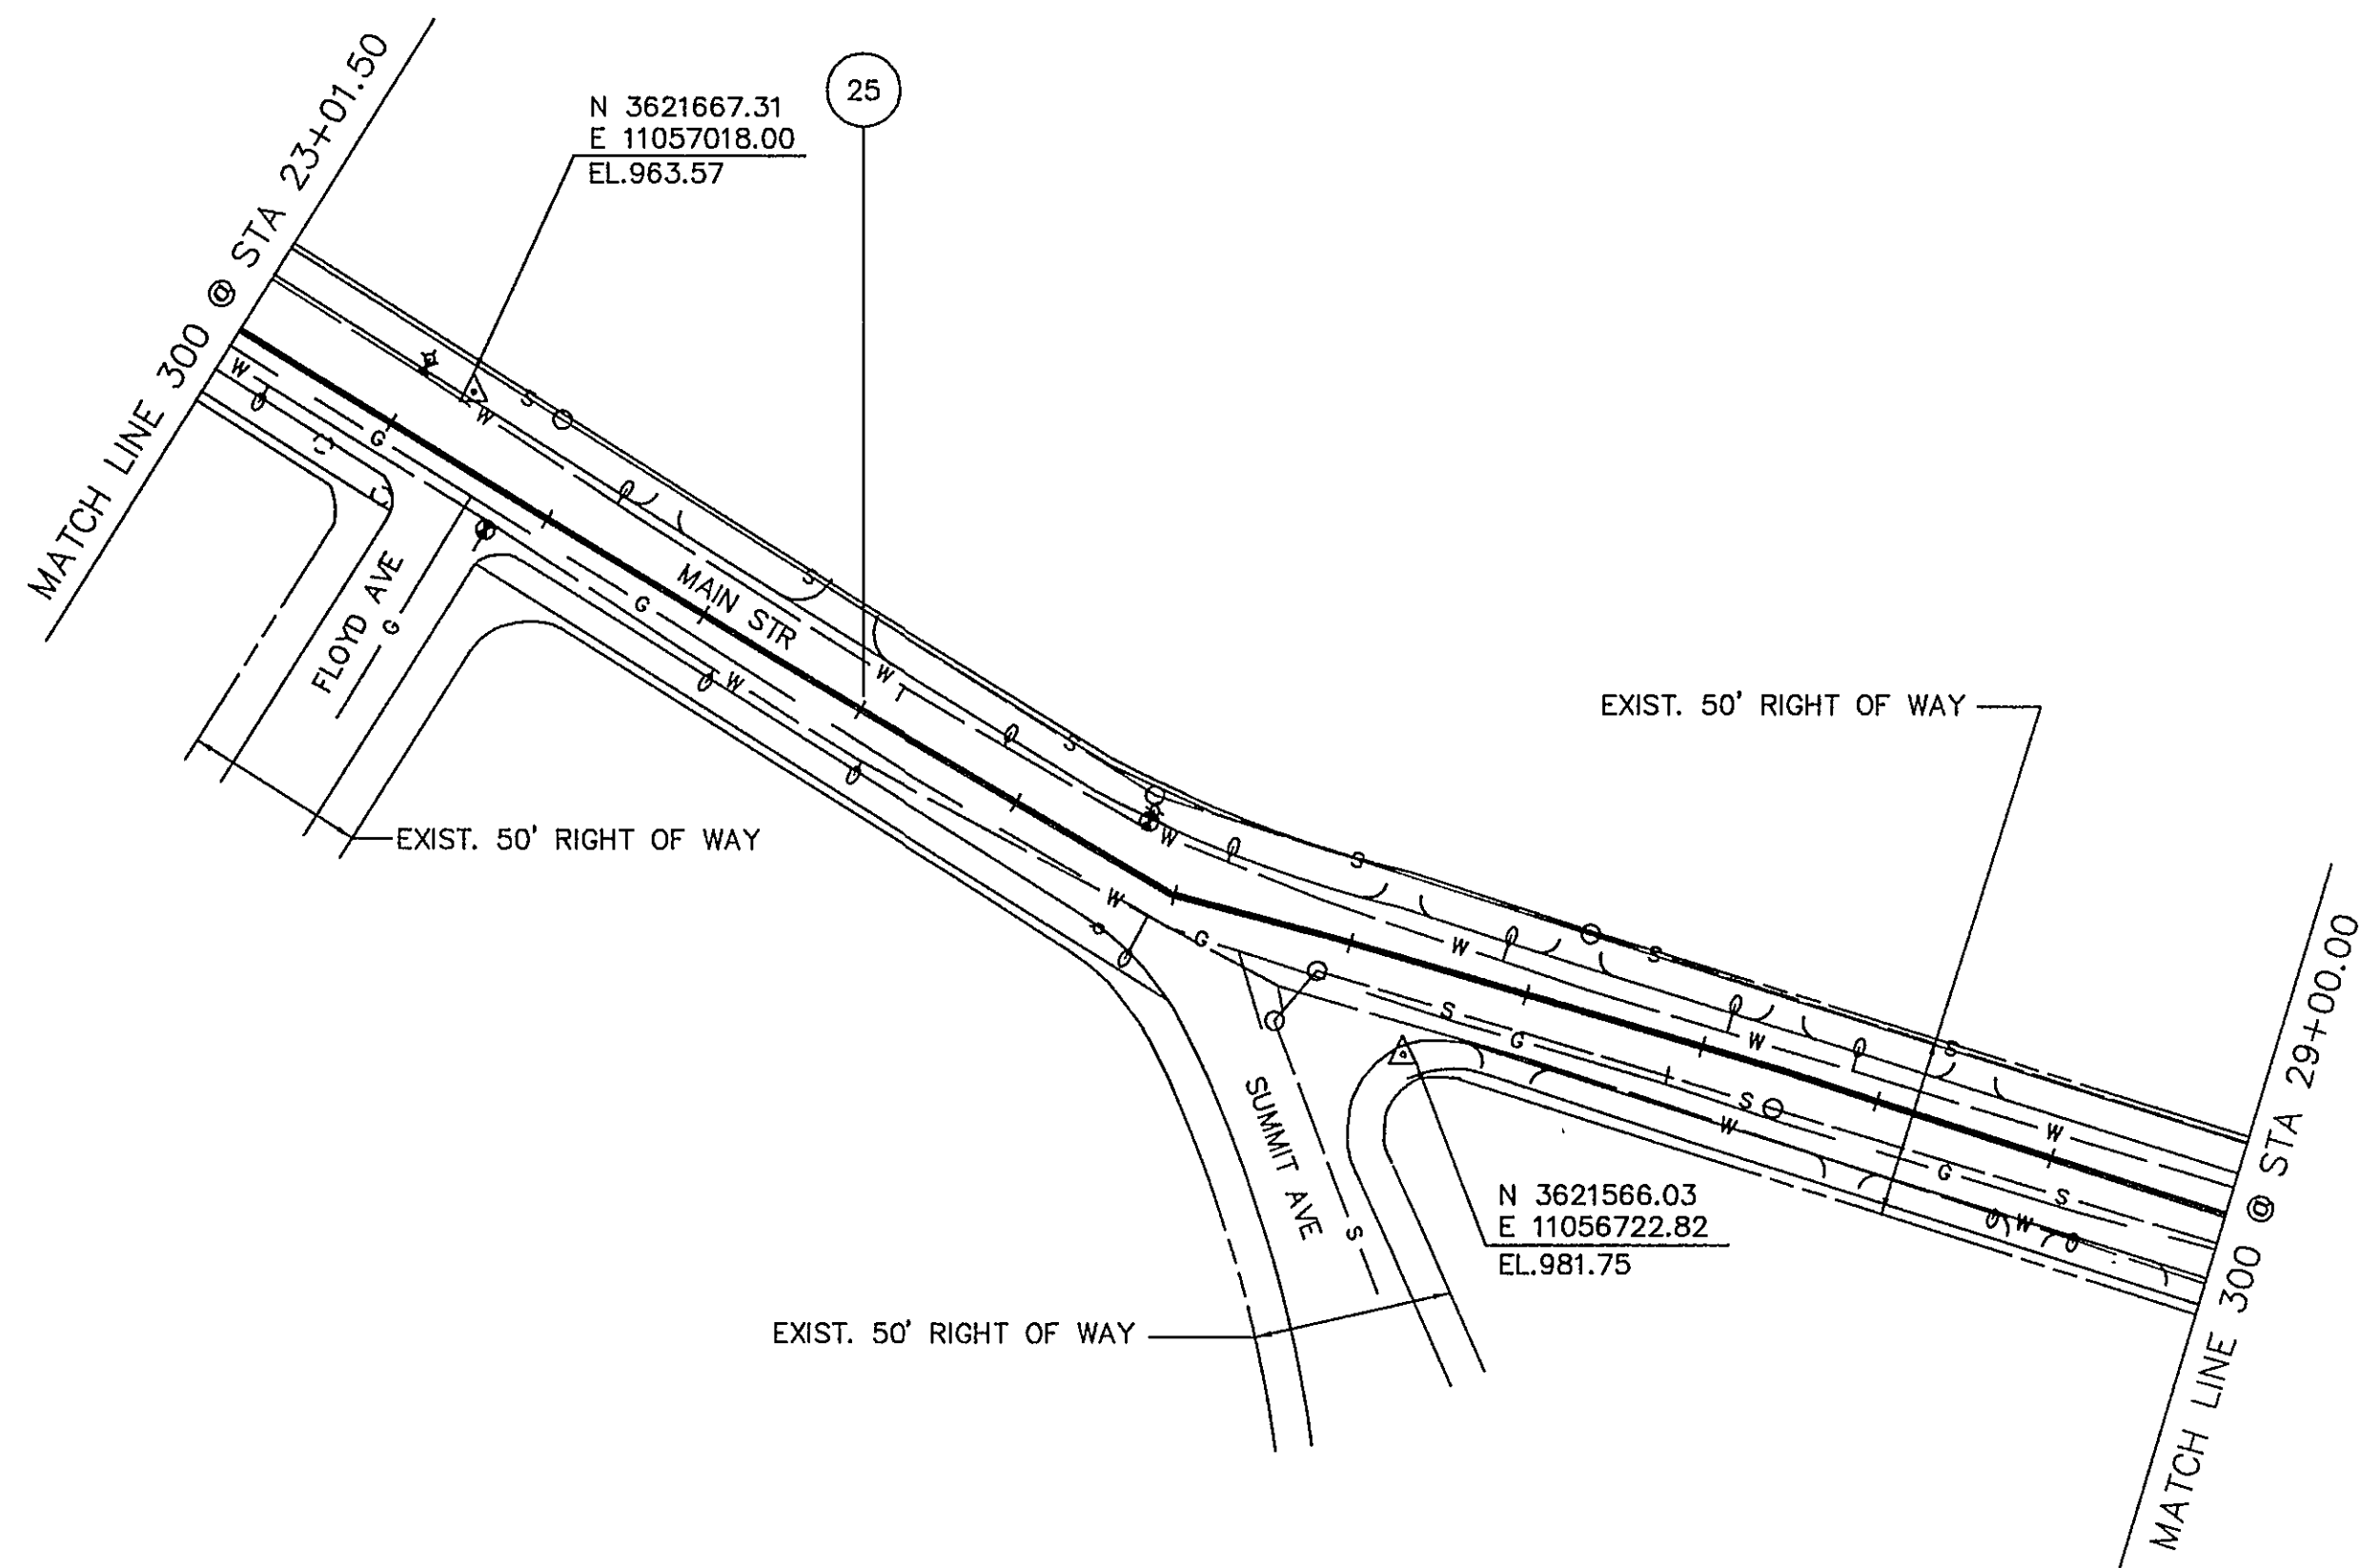

PLAN VIEW LINE 300

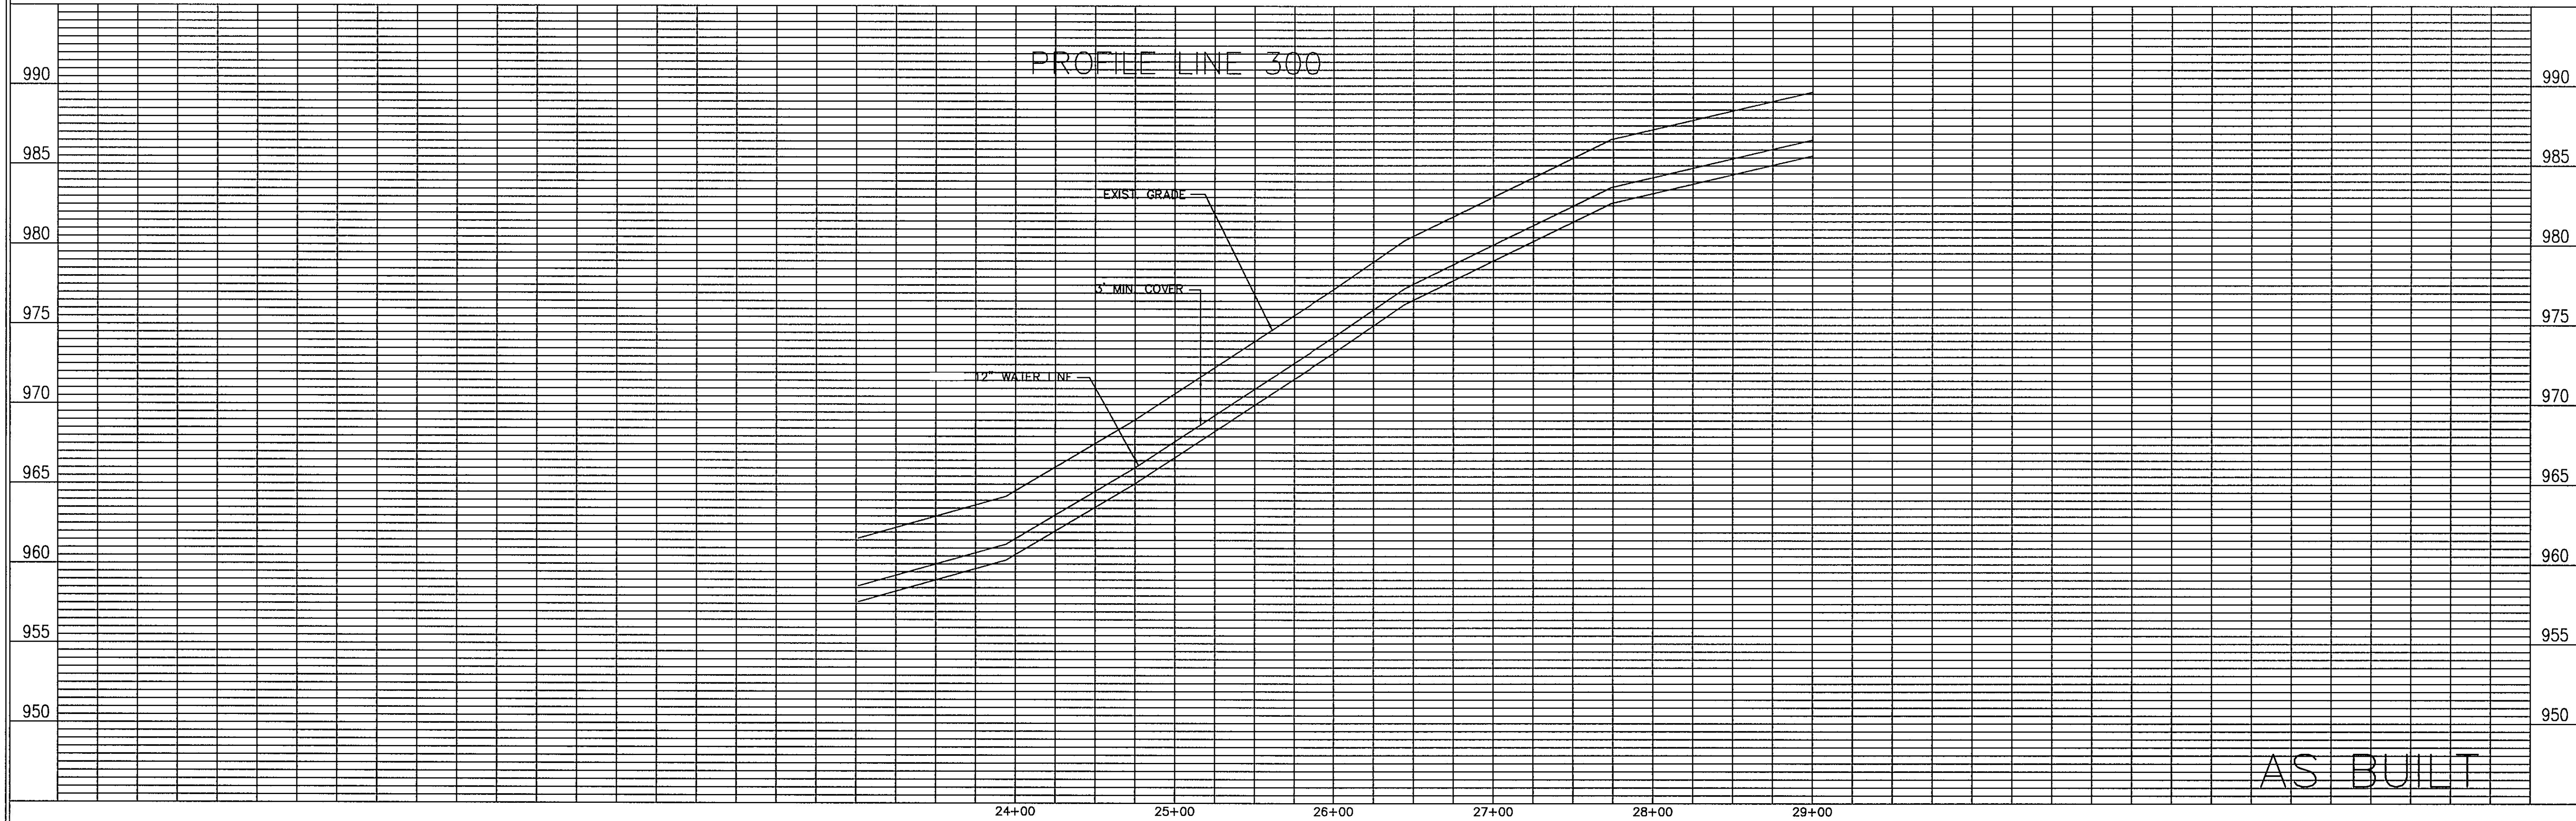

Architects
Engineers
Planners
Surveyors

Dewberry & Davis

5238 Valleypointe Parkway, Suite One-B
Roanoke, Virginia 24019
☎ 703 362-7726

Carvins Cove, Phase II
City of Roanoke
Roanoke, Virginia

CONTRACT "B2"
LINE 300
STA 23+01.50 - 29+00.00

Drawn By REH/ACF
Designed By RBS
Checked By SEH
Date APRIL 93
Scale V: 1" = 5'
H: 1" = 50'
Plan Number MS3
Zoned NONE
Sheet **16** of 22
File Number C1160