



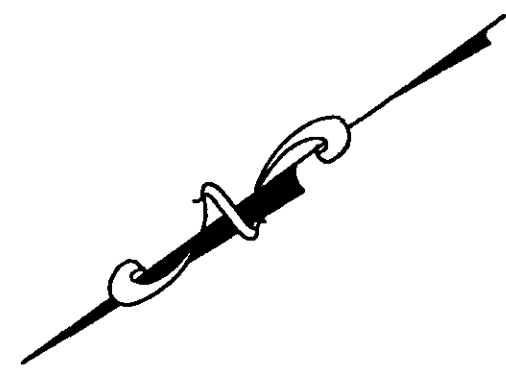

753 LF 12" W/M IN
1-12" TAPPING VALVE
1-4" BLOWOFF
1-6" TAPPING VALVE
1-12" GATE VALVE
1-1" PVC

PLAN VIEW LINE 300

MATCH LINE 300 @ STA 29+00.00

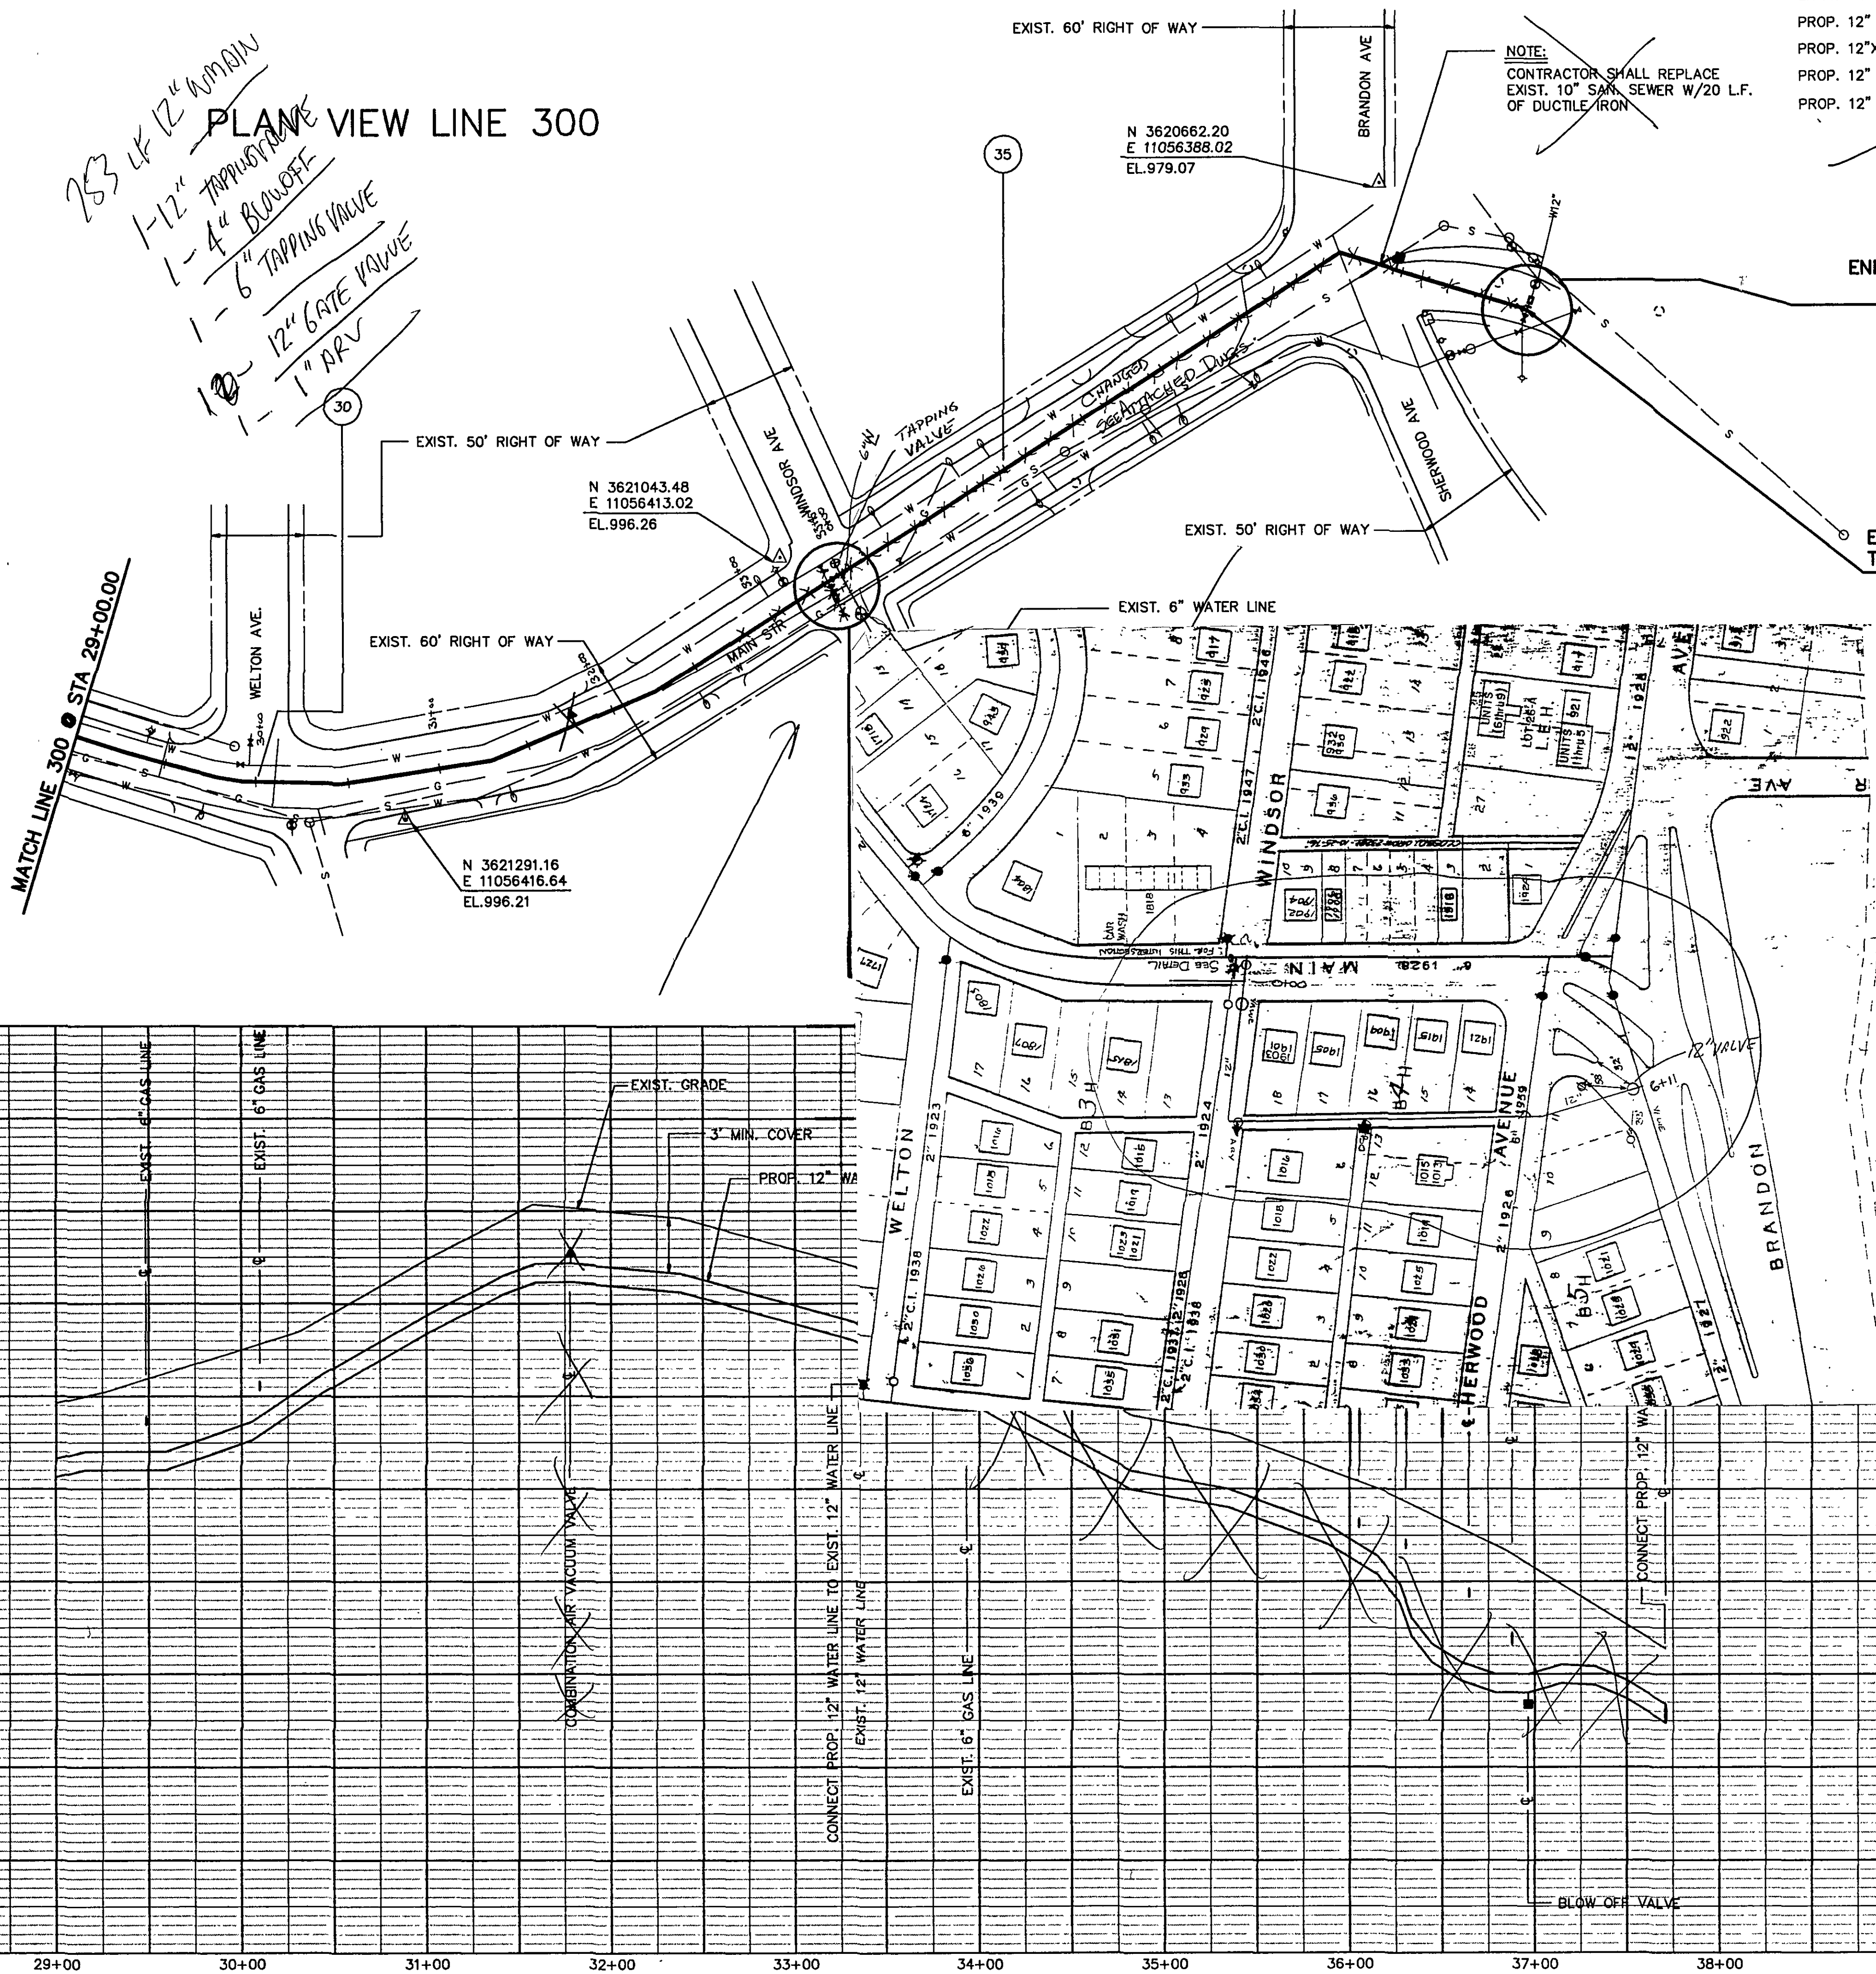

EXIST. 60' RIGHT OF WAY
N 3620662.20
E 11056388.02
EL.979.07

NOTE:
CONTRACTOR SHALL REPLACE
EXIST. 10" SAN. SEWER W/20 L.F.
OF DUCTILE IRON

EXIST. 12" WATER LINE
PROP. 12" DRESSER COUPLING
PROP. 12"x12"x12" TEE
PROP. 12" WATER LINE
PROP. 12" GATE VALVE



ENLARGED PLAN VIEW INTERCONNECTS TO
PROPOSED / EXISTING WATER LINE

NTS

753 LF 12" WATERMAIN

END LINE 300 WITH INTERCONNECT
TO EXIST. 12" WATER LINE @ STA 37+70.77

PROFILE LINE 300

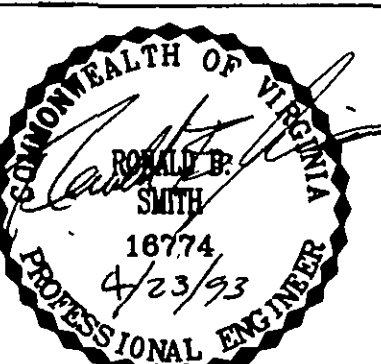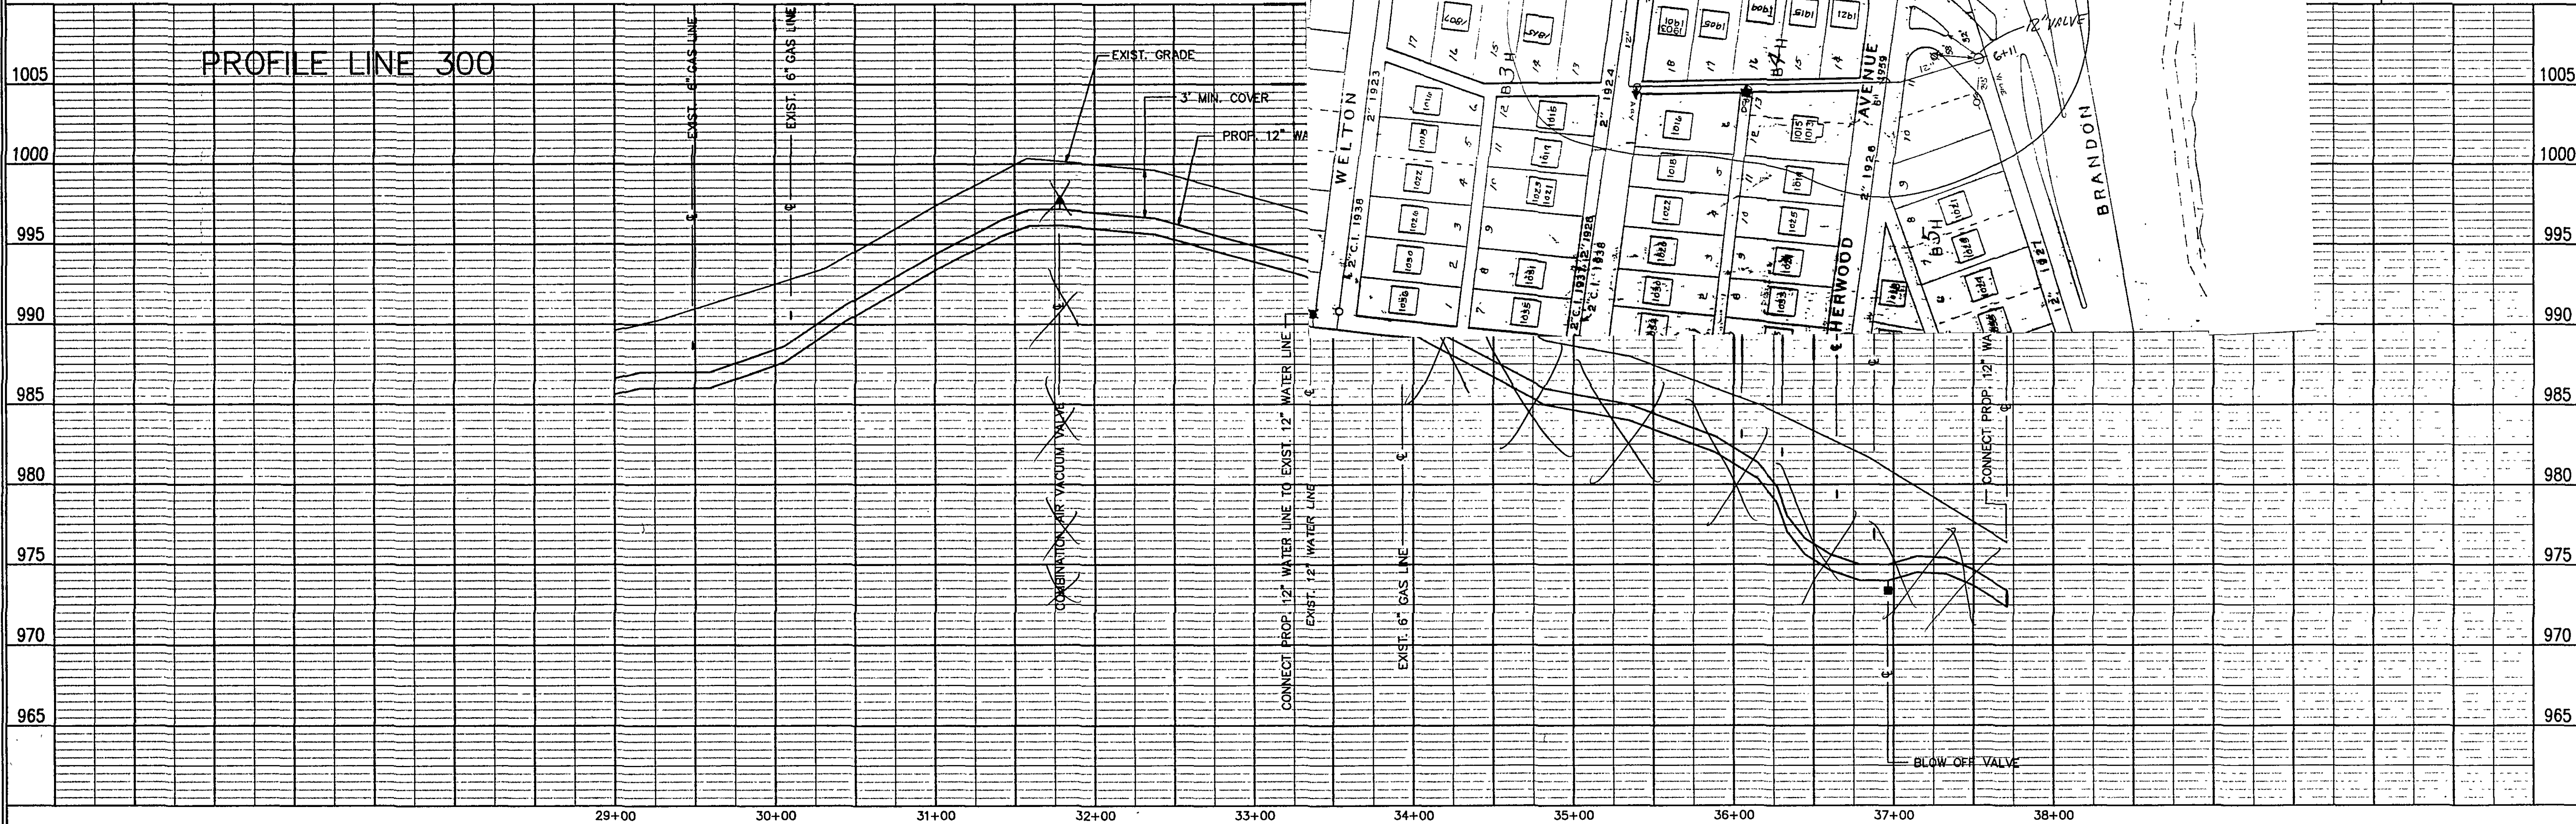

SEAL

ENGINEER'S SEAL

Carvins Cove, Phase II
City of Roanoke
Roanoke, Virginia

CONTRACT "B2"
END LINE 300
STA 29+00.00 - 37+70.77

Drawn By REH/ACF
Designed By RBS
Checked By SEH
Date APRIL 93
Scale
V: 1" = 5'
H: 1" = 50'
Plan Number MS4
Zoned NONE
Sheet 17 of 22
File Number C1160

Dewberry & Davis
Architects
Engineers
Planners
Surveyors
5238 Valleypointe Parkway, Suite One-B
Roanoke, Virginia 24019
703 362-1725