



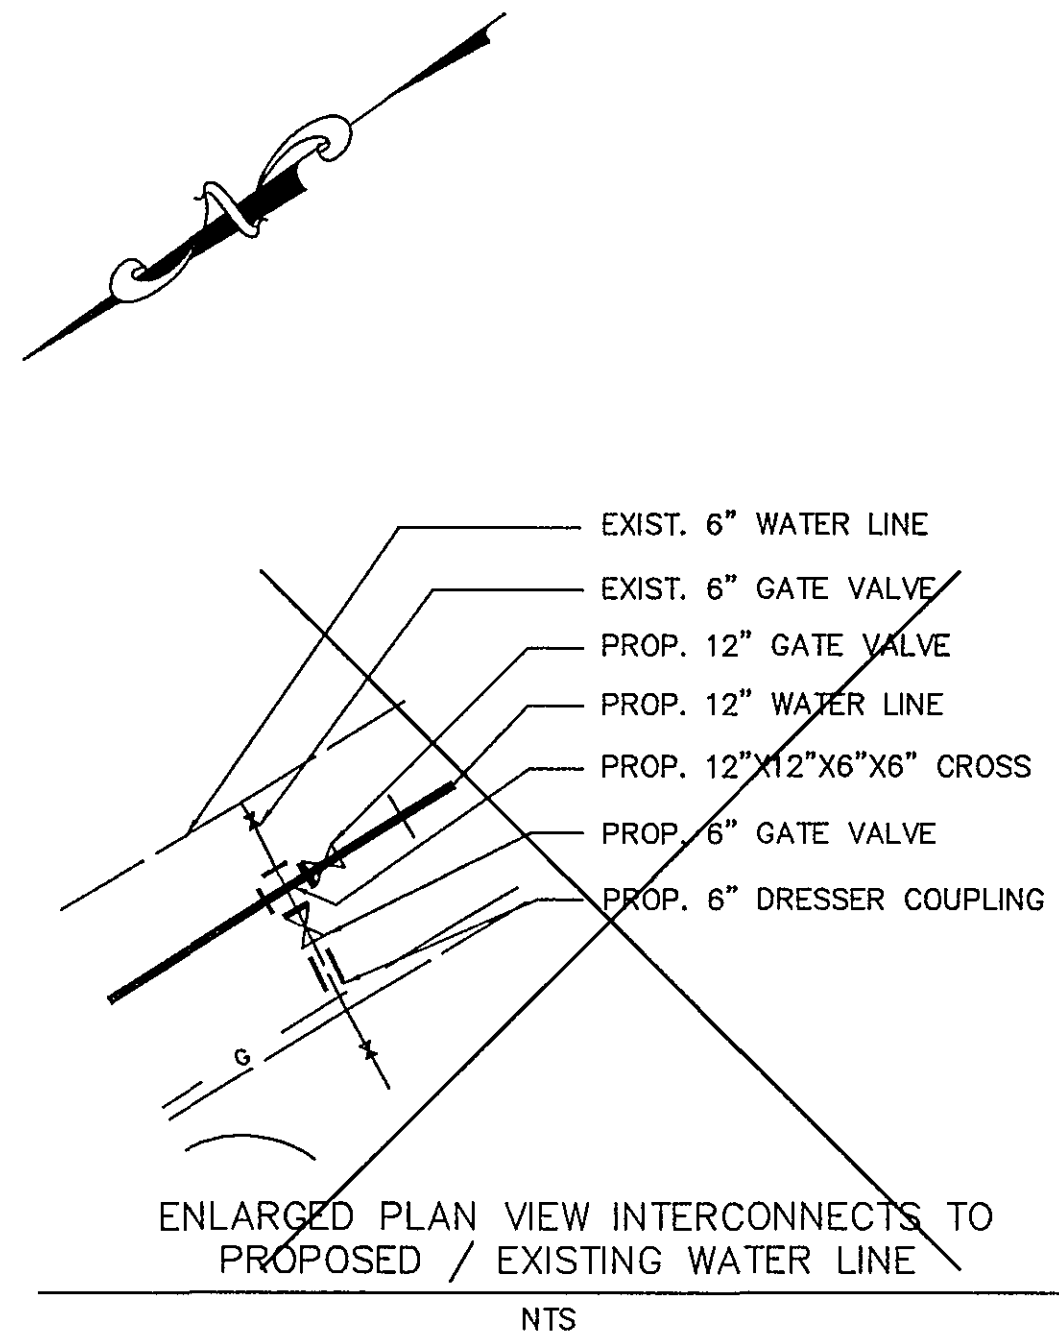


PLAN VIEW LINE 300

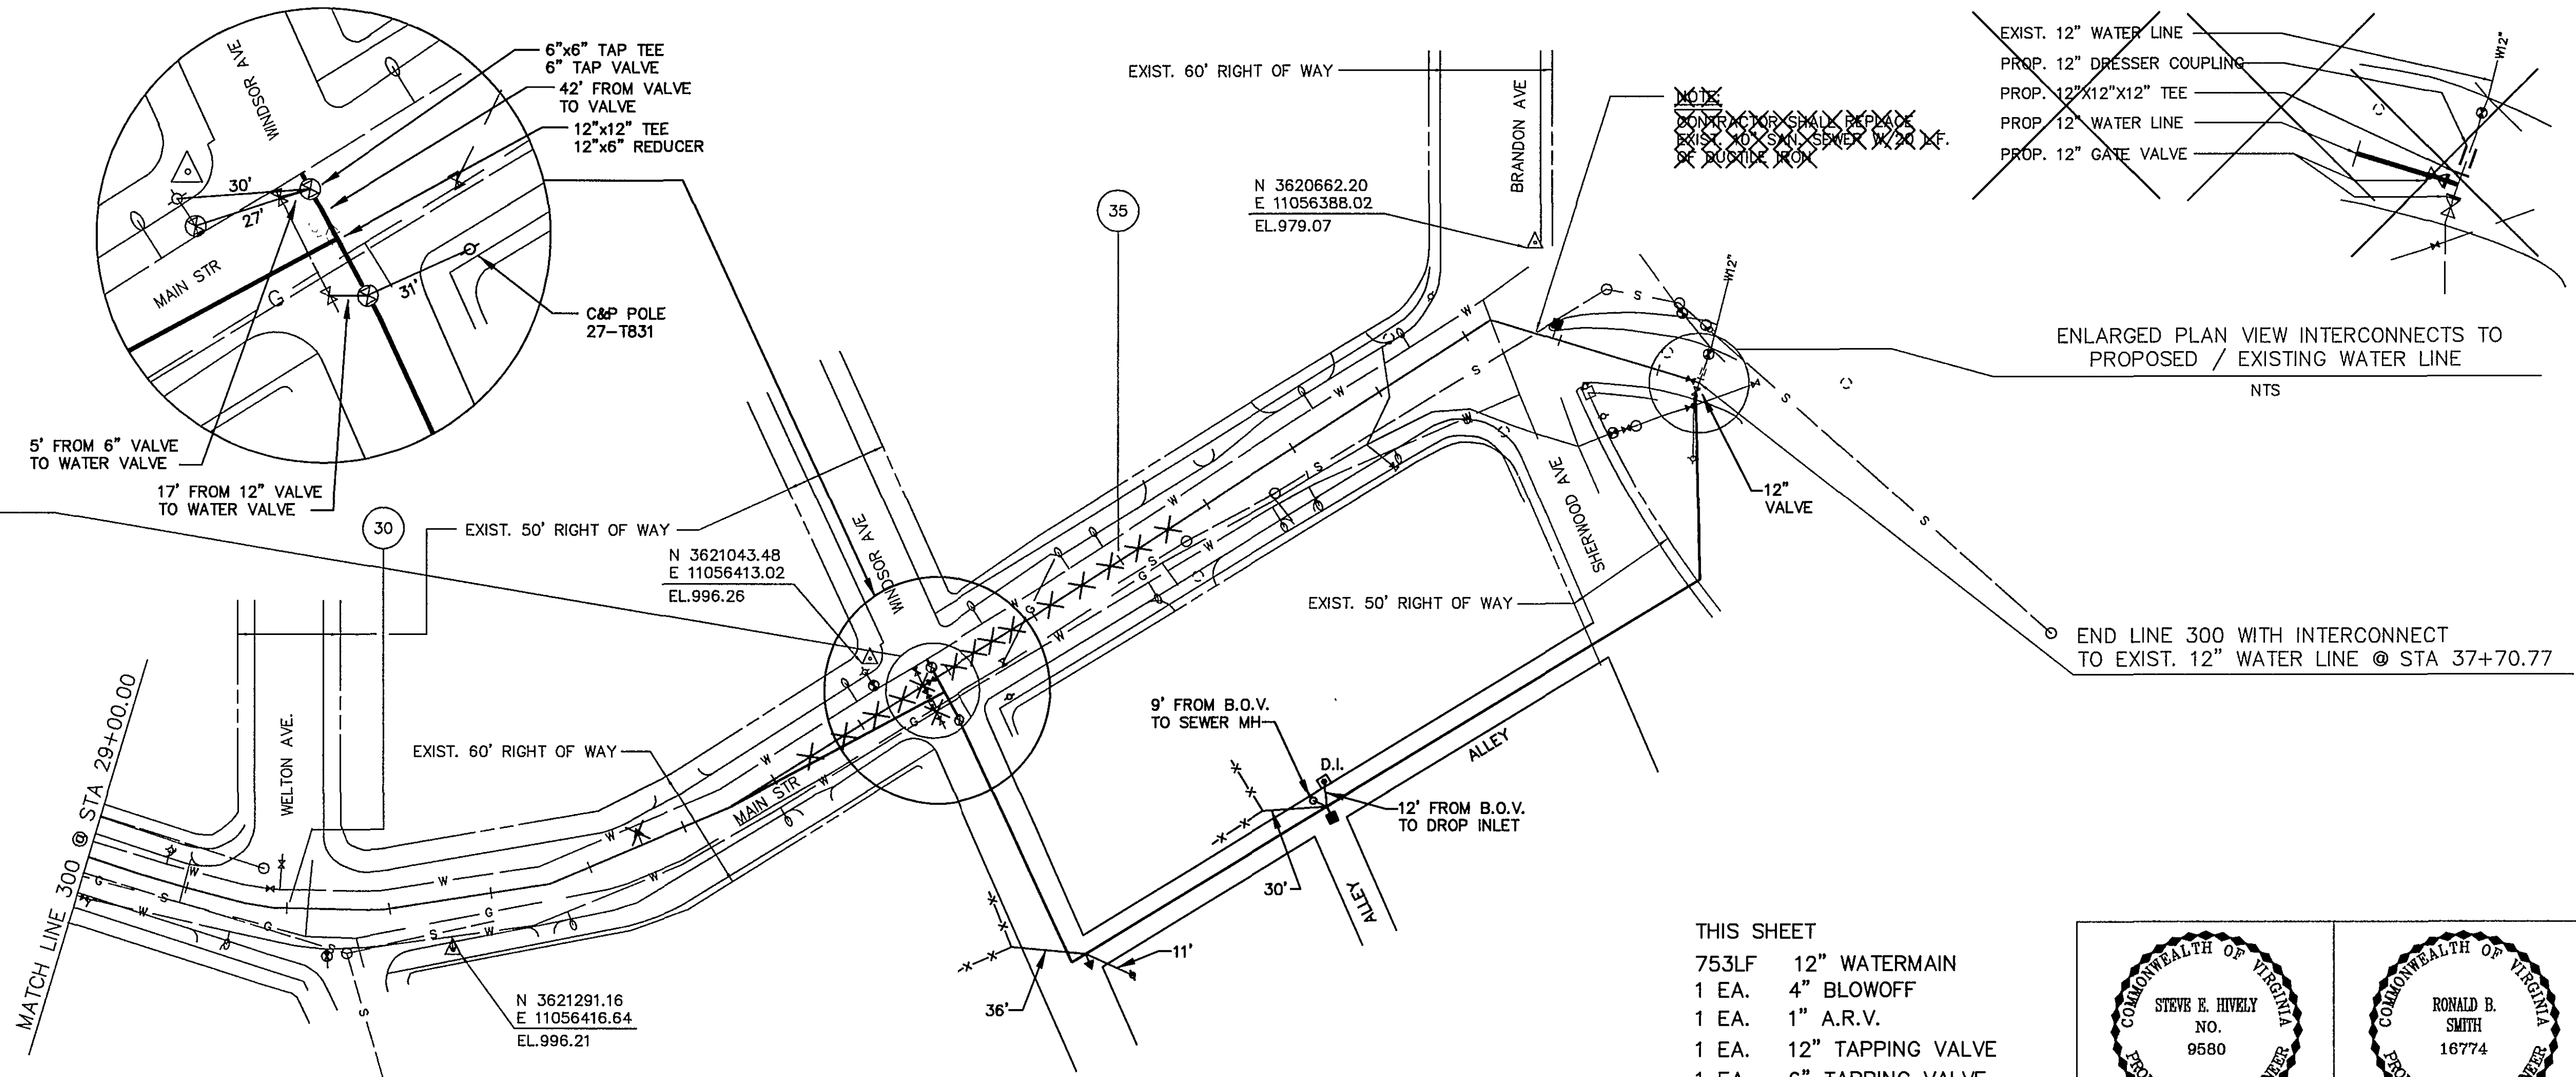

- THIS SHEET
- 753LF 12" WATERMAIN
 - 1 EA. 4" BLOWOFF
 - 1 EA. 1" A.R.V.
 - 1 EA. 12" TAPPING VALVE
 - 1 EA. 6" TAPPING VALVE
 - 1 EA. 12" GATE VALVE

ENGINEER'S SEAL	ENGINEER'S SEAL

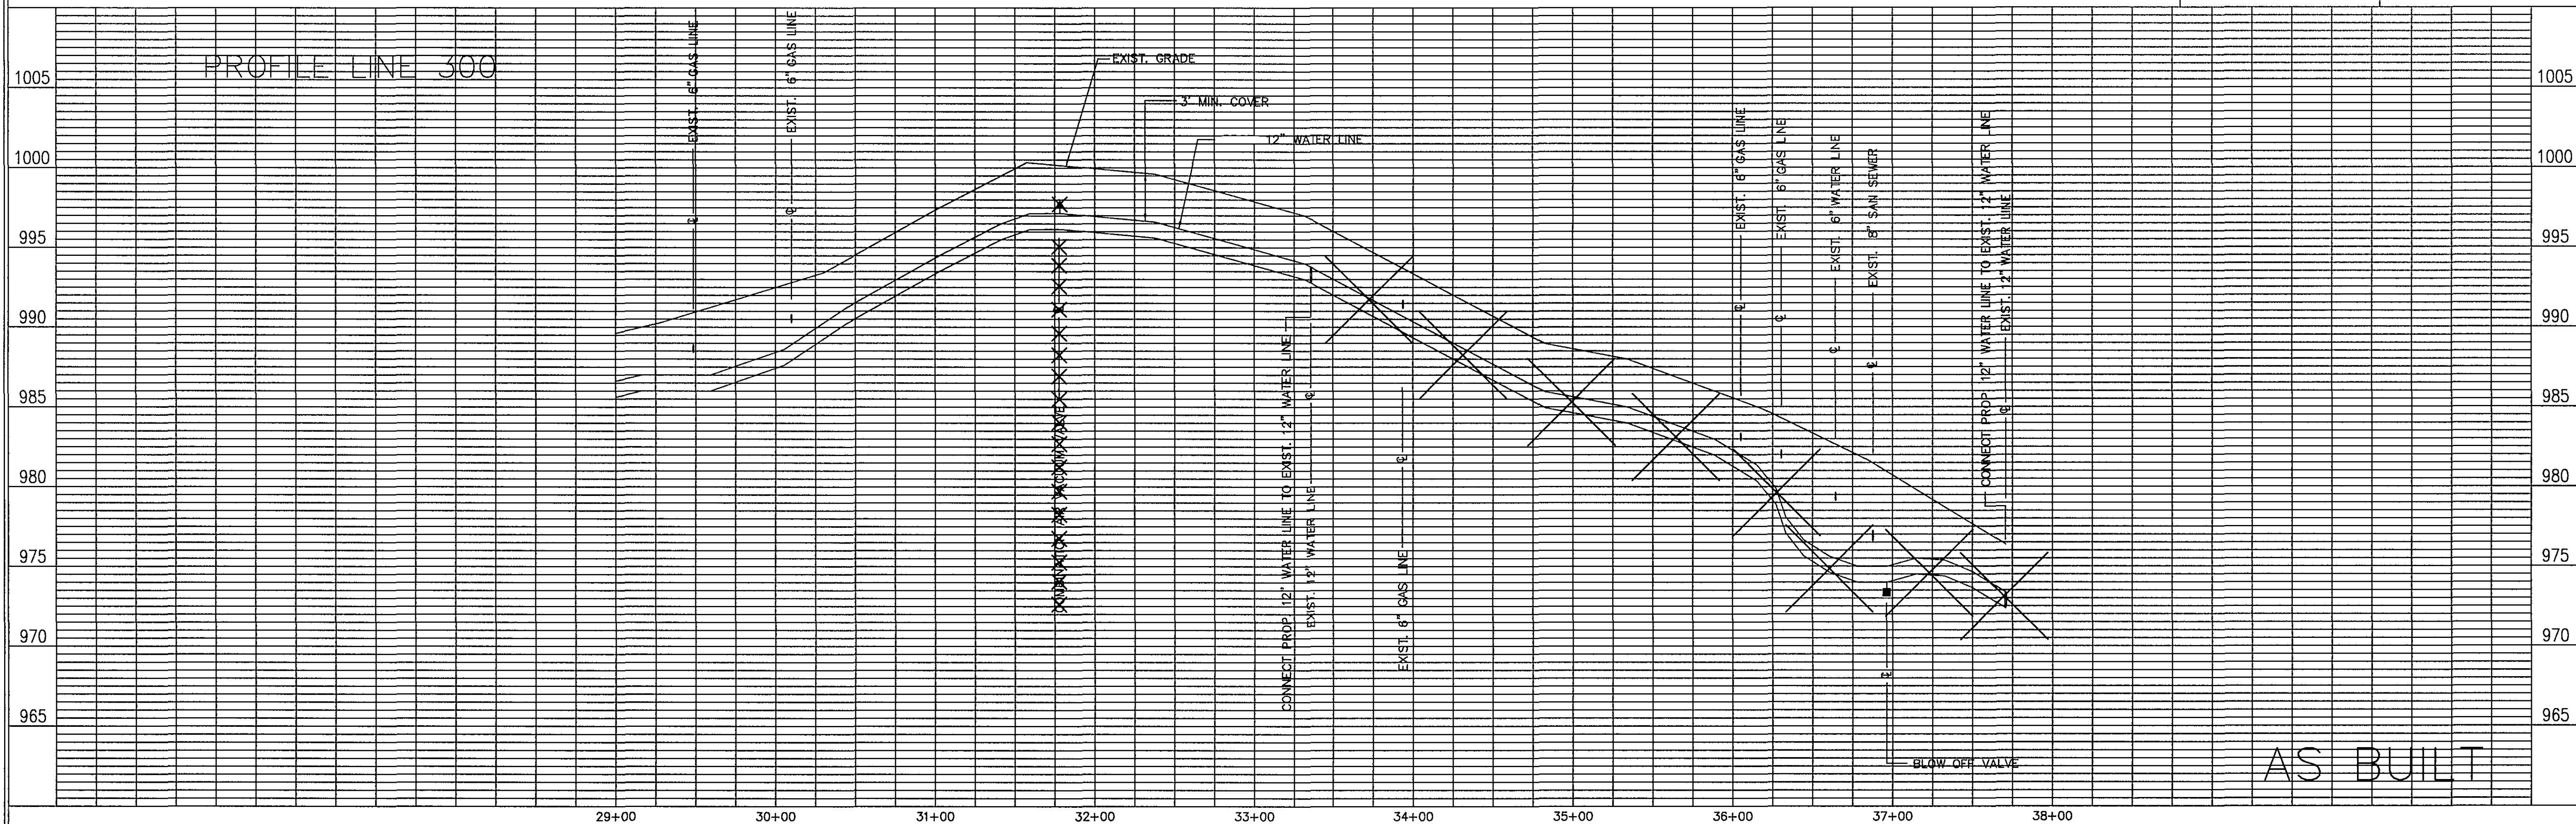

AS BUILT

 Architects Engineers Planners Surveyors 5238 Valleypointe Parkway, Suite One-B Roanoke, Virginia 24019 703 862-7726	Carvins Cove, Phase II City of Roanoke Roanoke, Virginia
	CONTRACT "B2" END LINE 300 STA 29+00.00 - 37+70.77
Drawn By REH/ACF Designed By RBS Checked By SEH Date APRIL 93 Scale V: 1" = 5' H: 1" = 50' Plan Number MS4 Zoned NONE Sheet 17 of 22 File Number C1160	