
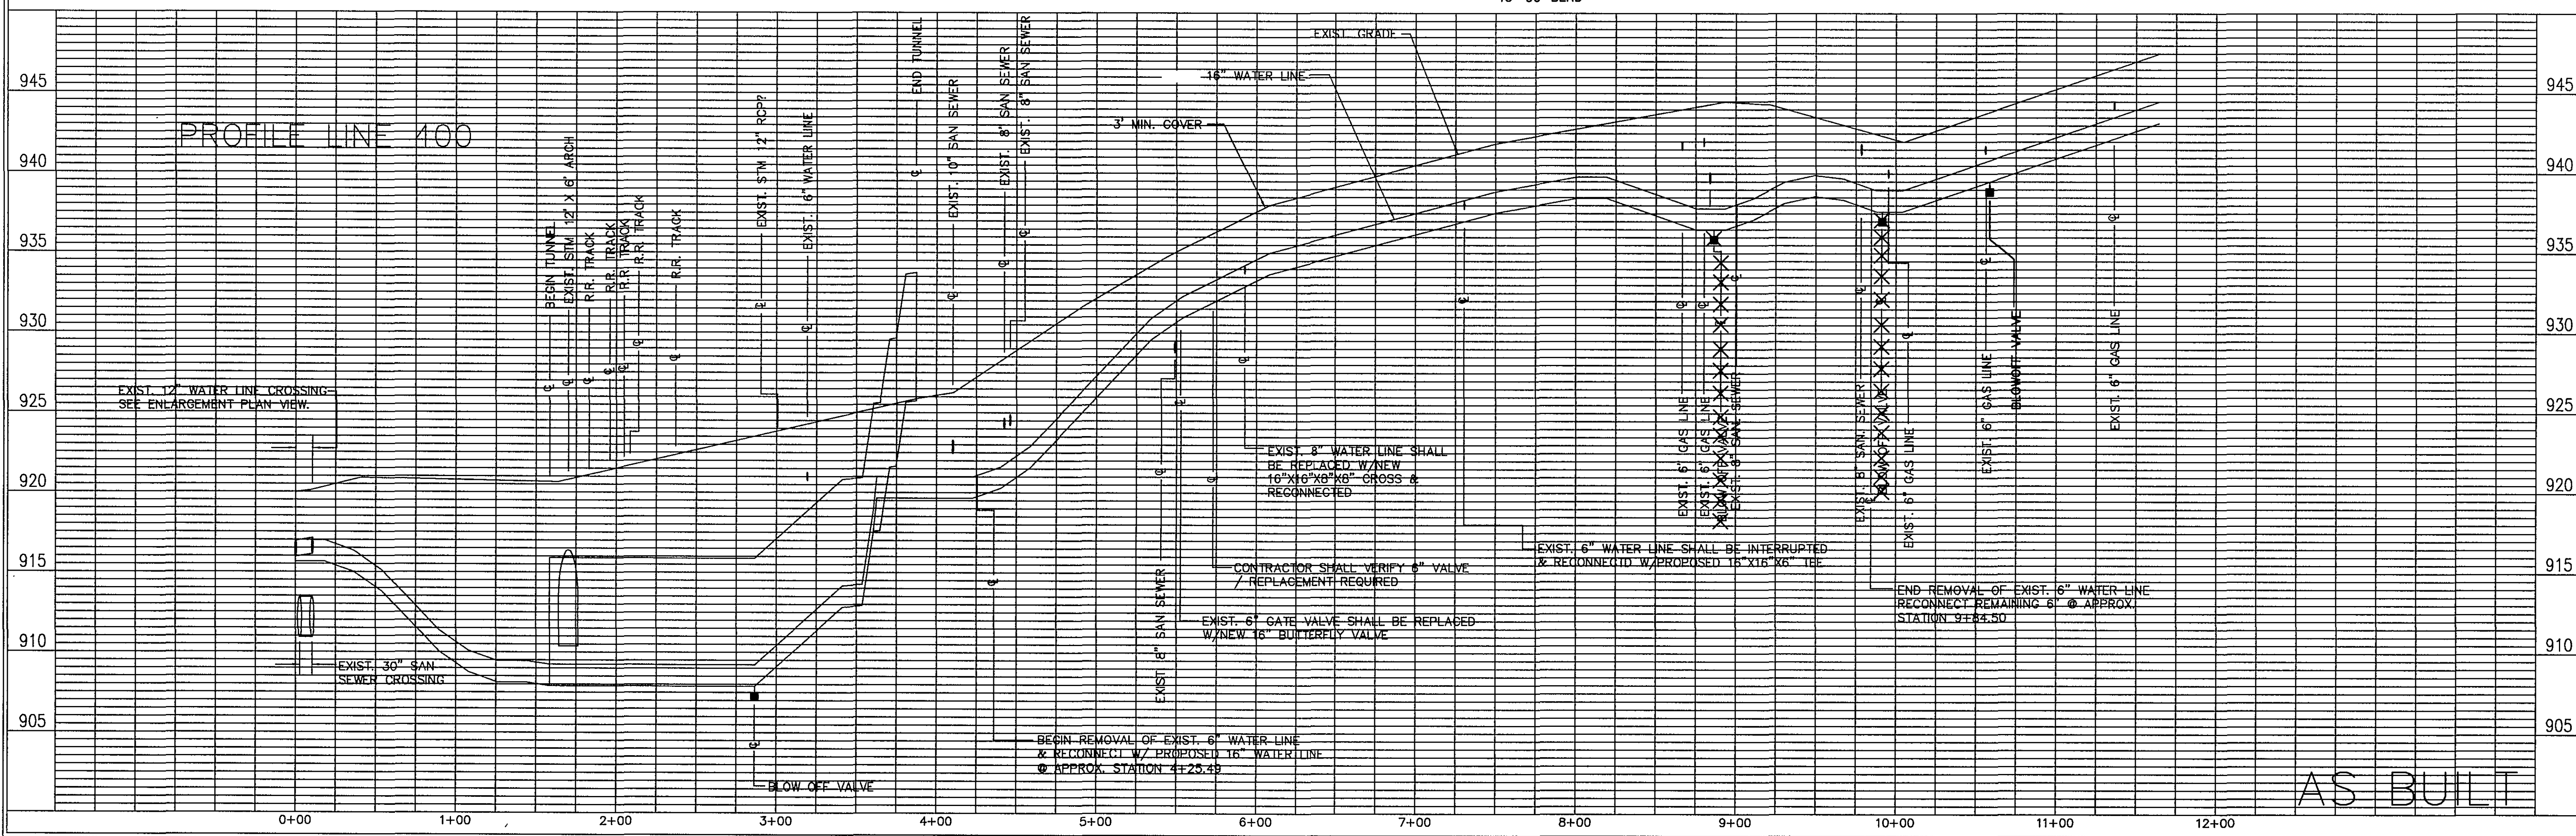


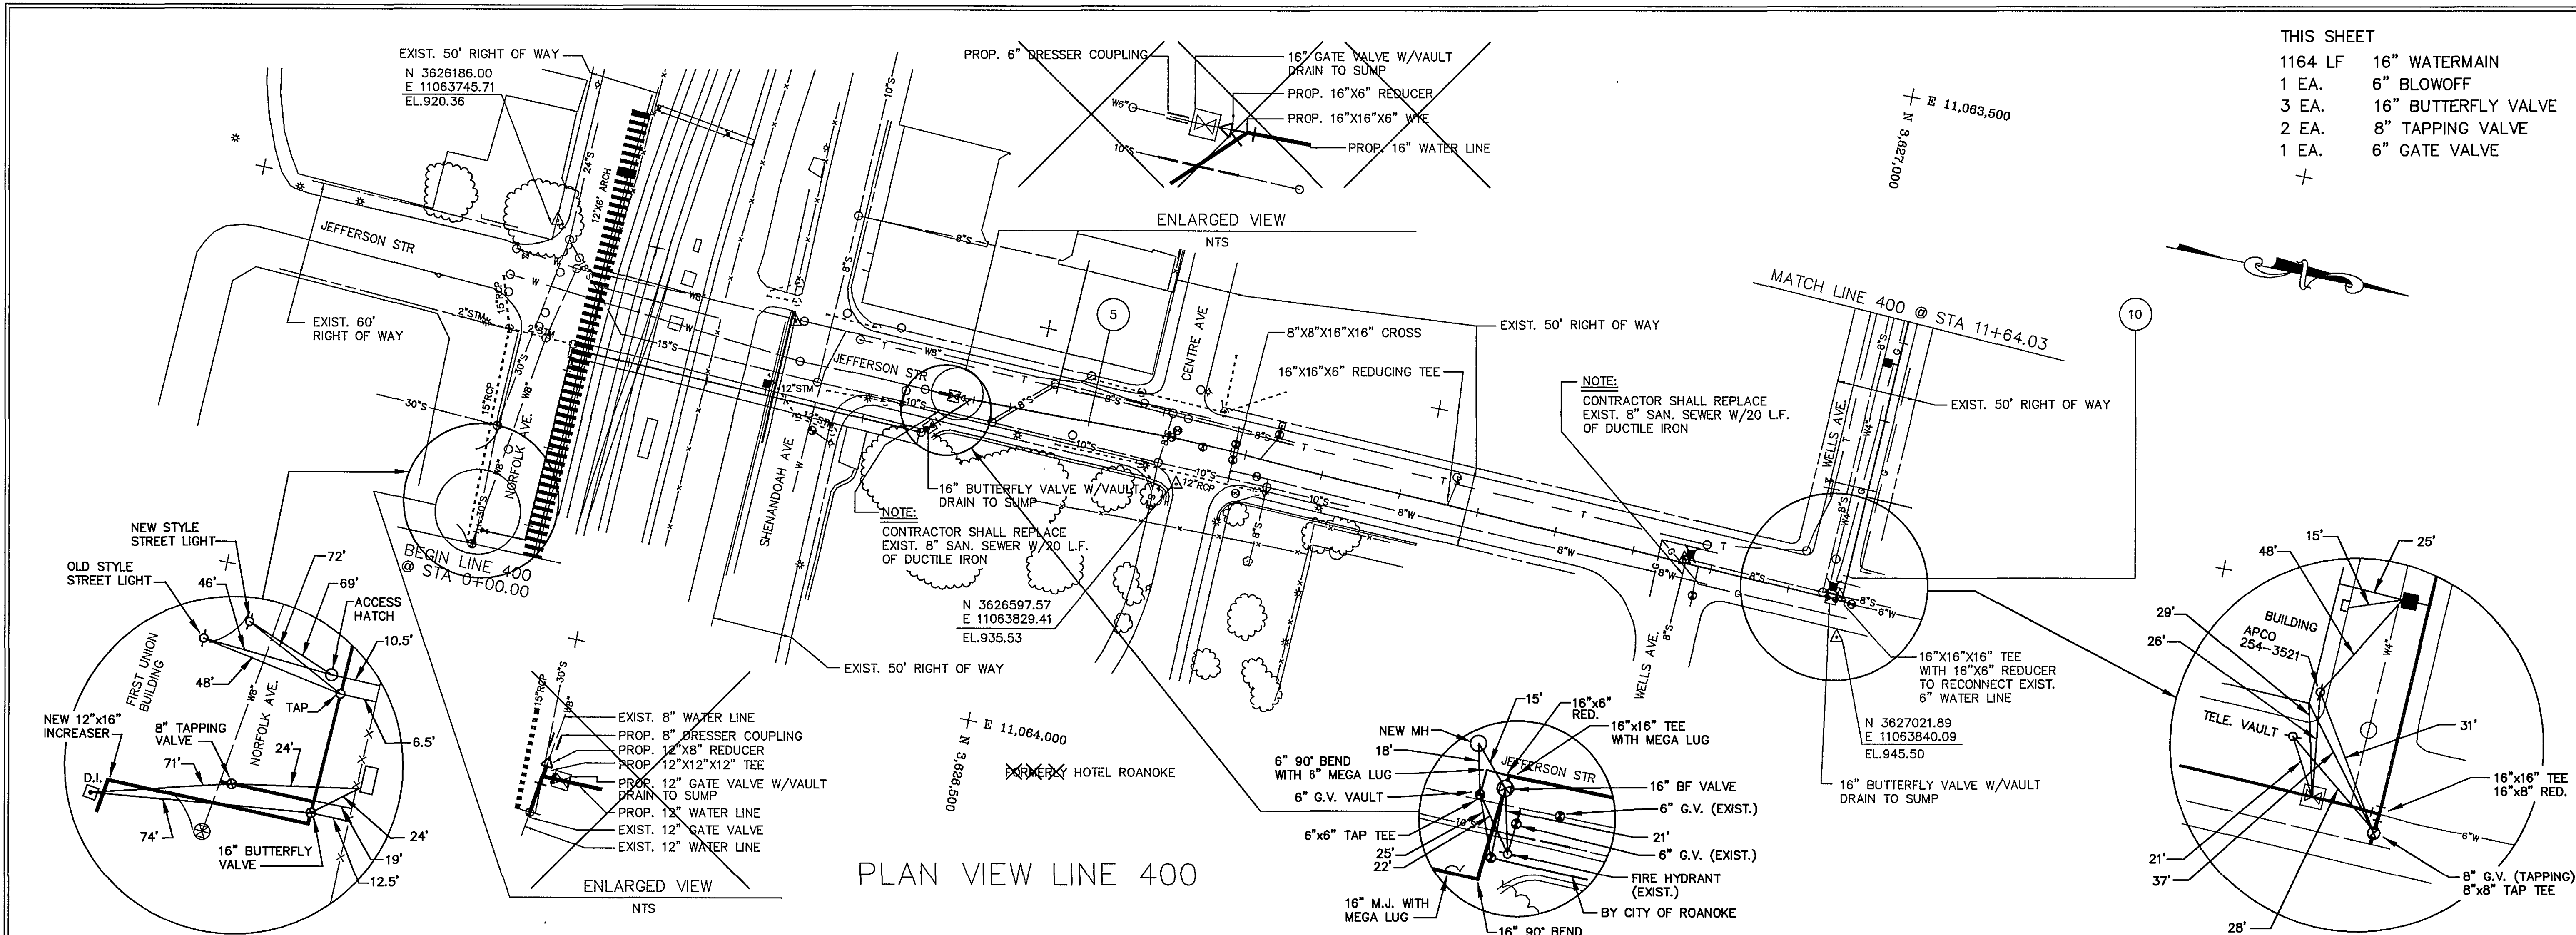

- THIS SHEET
- | | |
|---------|---------------------|
| 1164 LF | 16" WATERMAIN |
| 1 EA. | 6" BLOWOFF |
| 3 EA. | 16" BUTTERFLY VALVE |
| 2 EA. | 8" TAPPING VALVE |
| 1 EA. | 6" GATE VALVE |

Architects
Engineers
Planners
Surveyors

Dewberry & Davis

5238 Valleypointe Parkway, Suite One-B
Roanoke, Virginia 24019
703 362-7725

Carvins Cove, Phase II

City of Roanoke
Roanoke, Virginia

CONTRACT "B2"

BEGIN LINE 400

STA 0+00.00 - 11+64.03

Drawn By REH/ACF

Designed By RBS

Checked By SEH

Date APRIL 93

Scale
V: 1" = 5'
H: 1" = 50'

Plan Number C1

Zoned NONE

Sheet
18 of 22

File Number C1160