
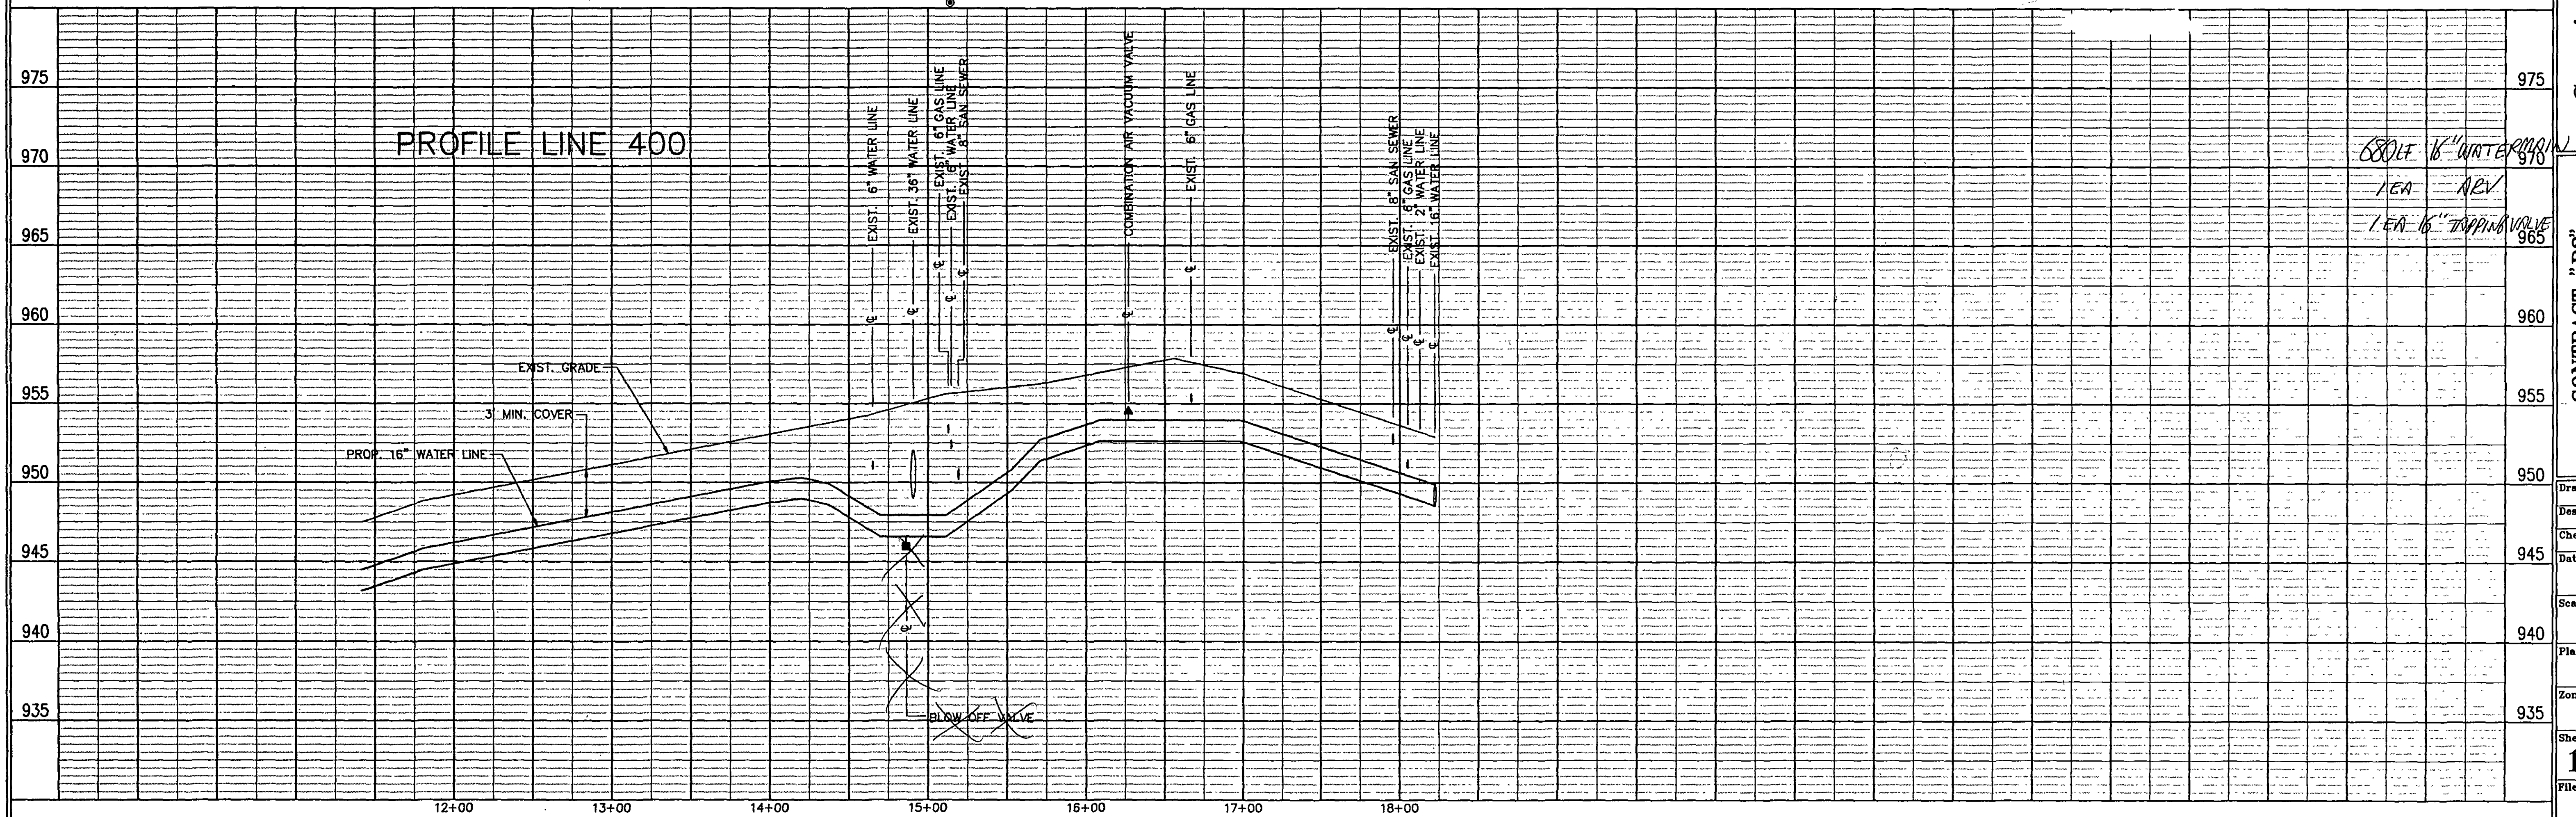


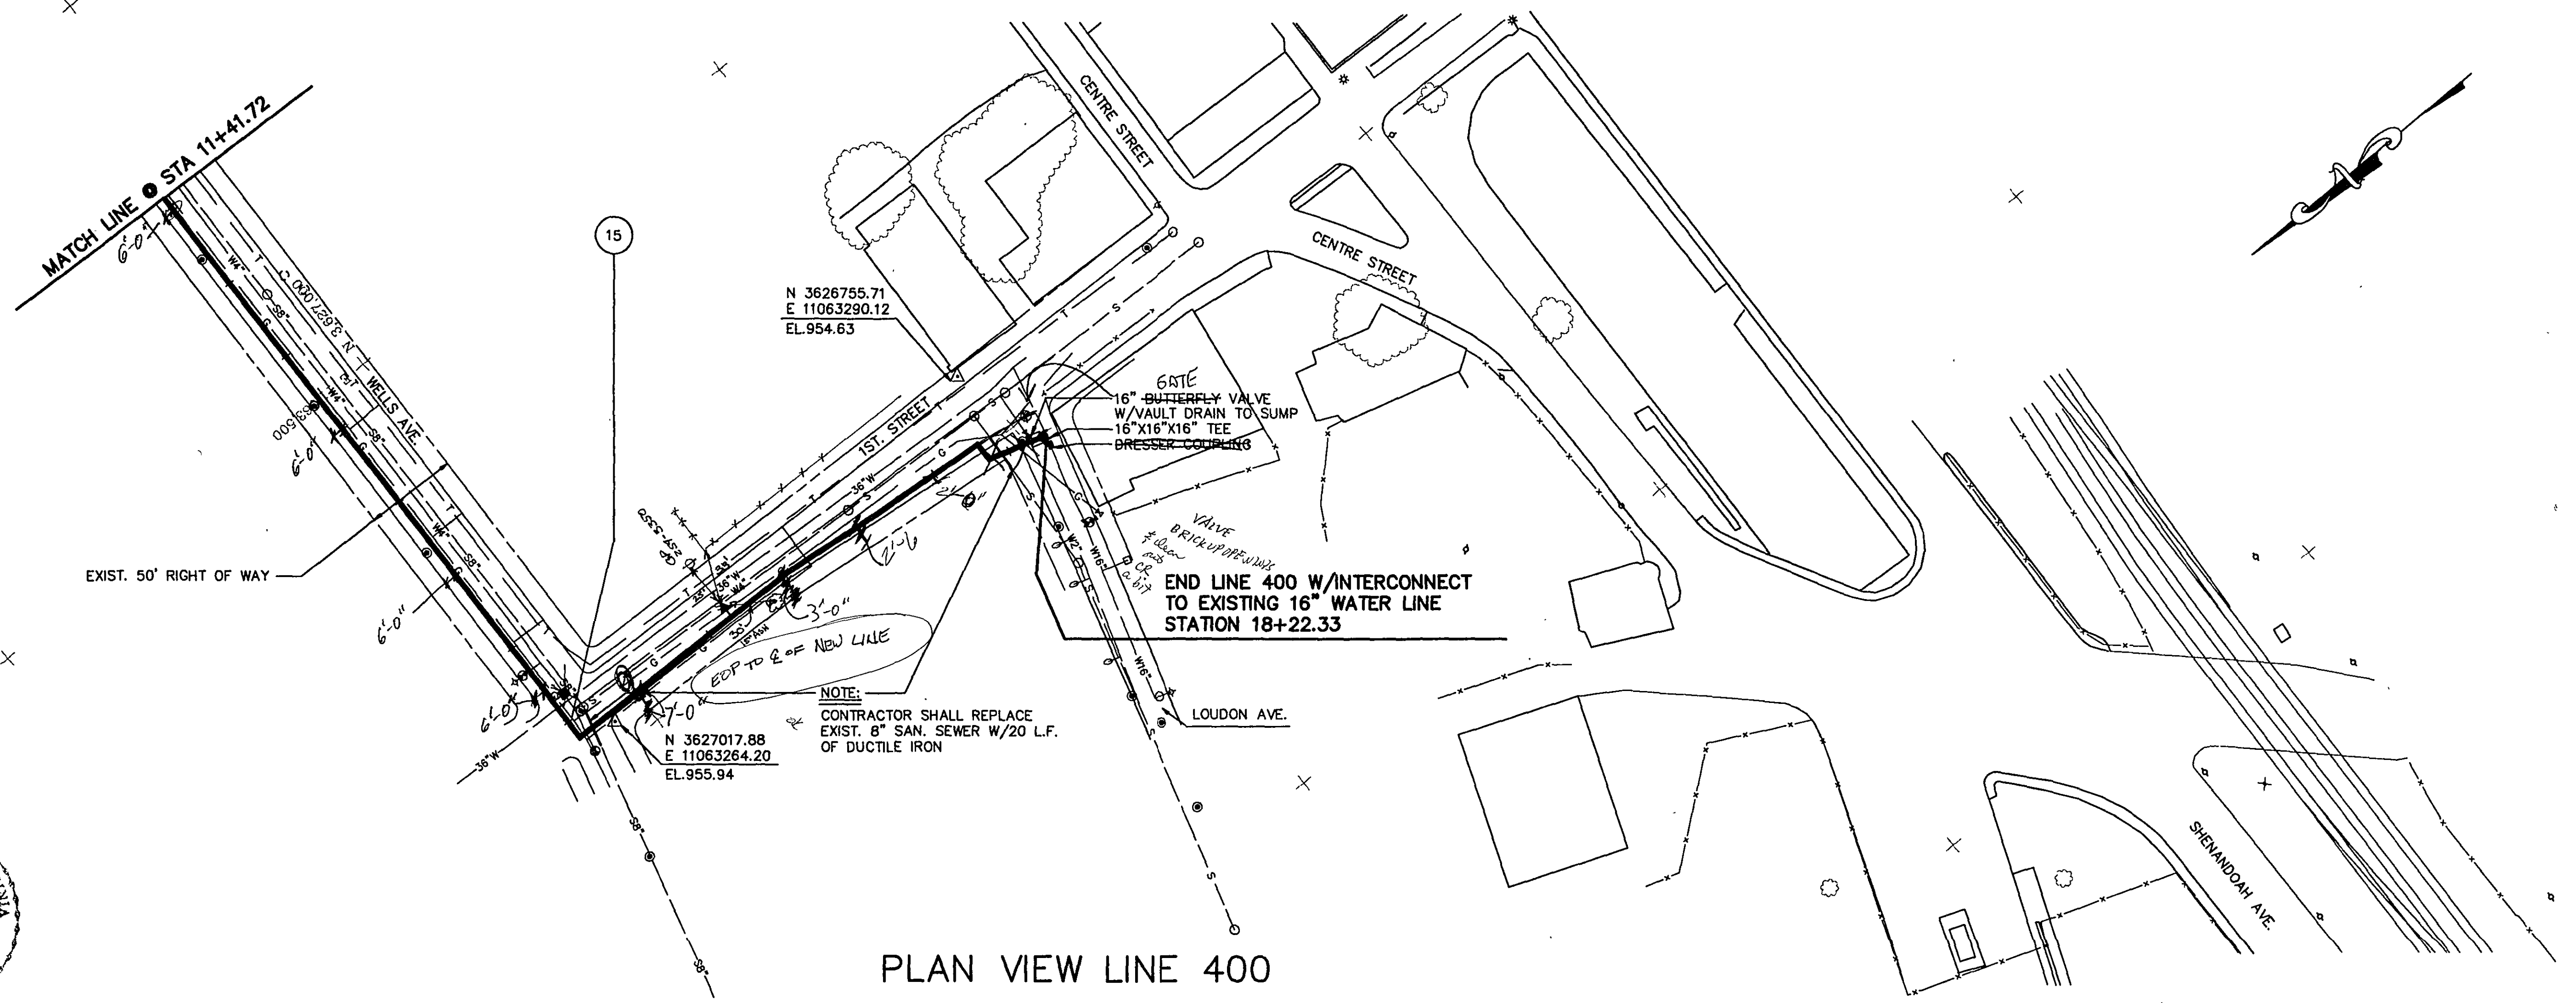

**Engineers
Planners
Surveyors**

Dewberry & Davis
5238 Valleypointe Parkway, Suite One-B

Roanoke, Virginia 24019
☎ 703 362-7725

City of Roanoke
Roanoke, Virginia

END LINE 400	STA 11+64.03 - 18+22.33
--------------	-------------------------

By	REH/ACF
By	RBS
By	SEH
APRIL 93	
1" =	5'
1" =	50'
Number	
C2	
NONE	
9 of 22	
Number	
C1160	