



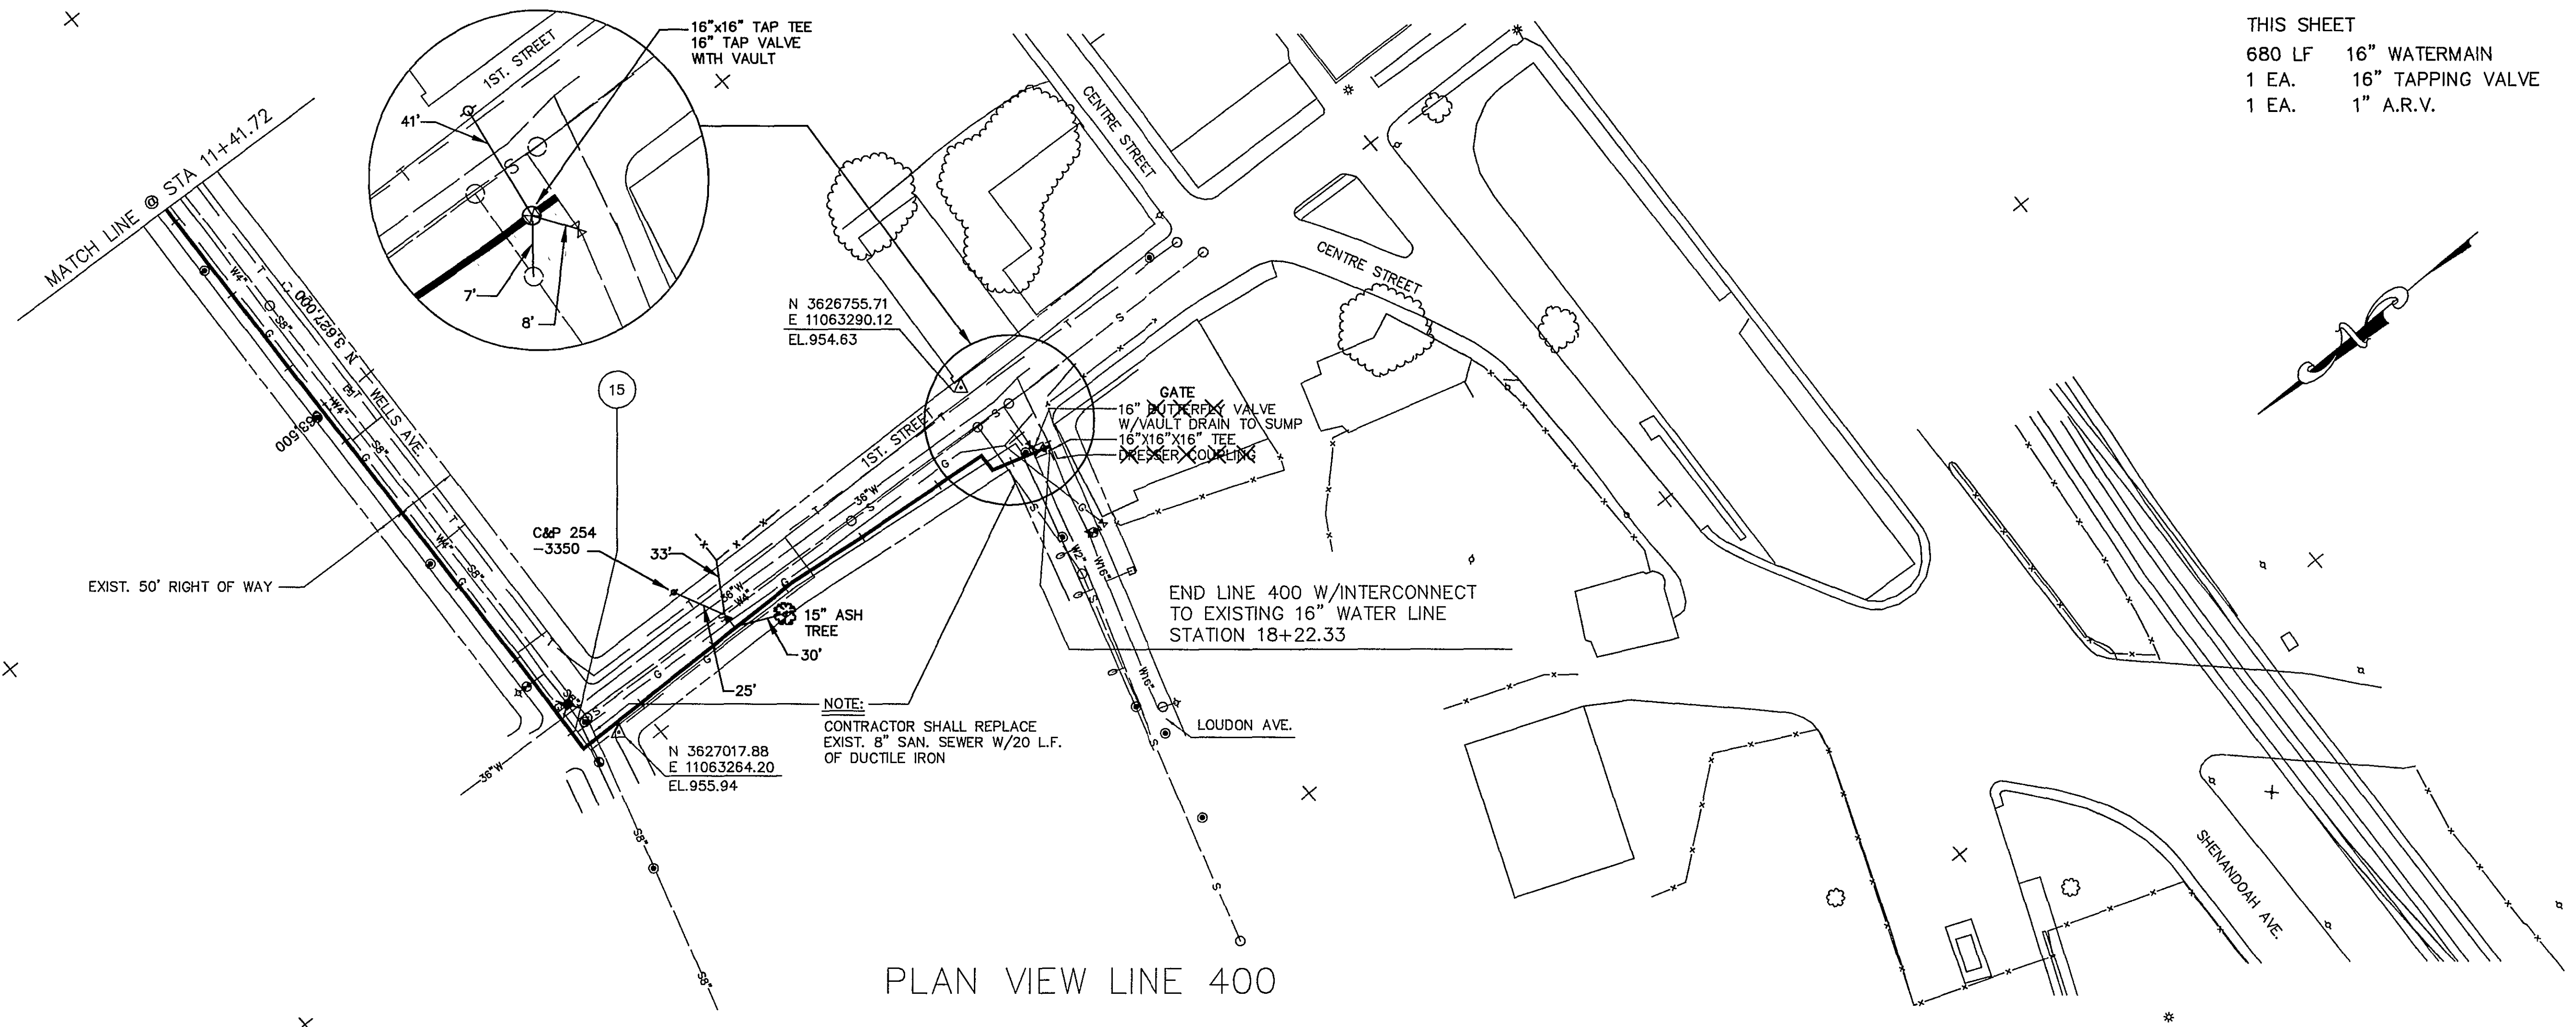

THIS SHEET
680 LF 16" WATERMAIN
1 EA. 16" TAPPING VALVE
1 EA. 1" A.R.V.

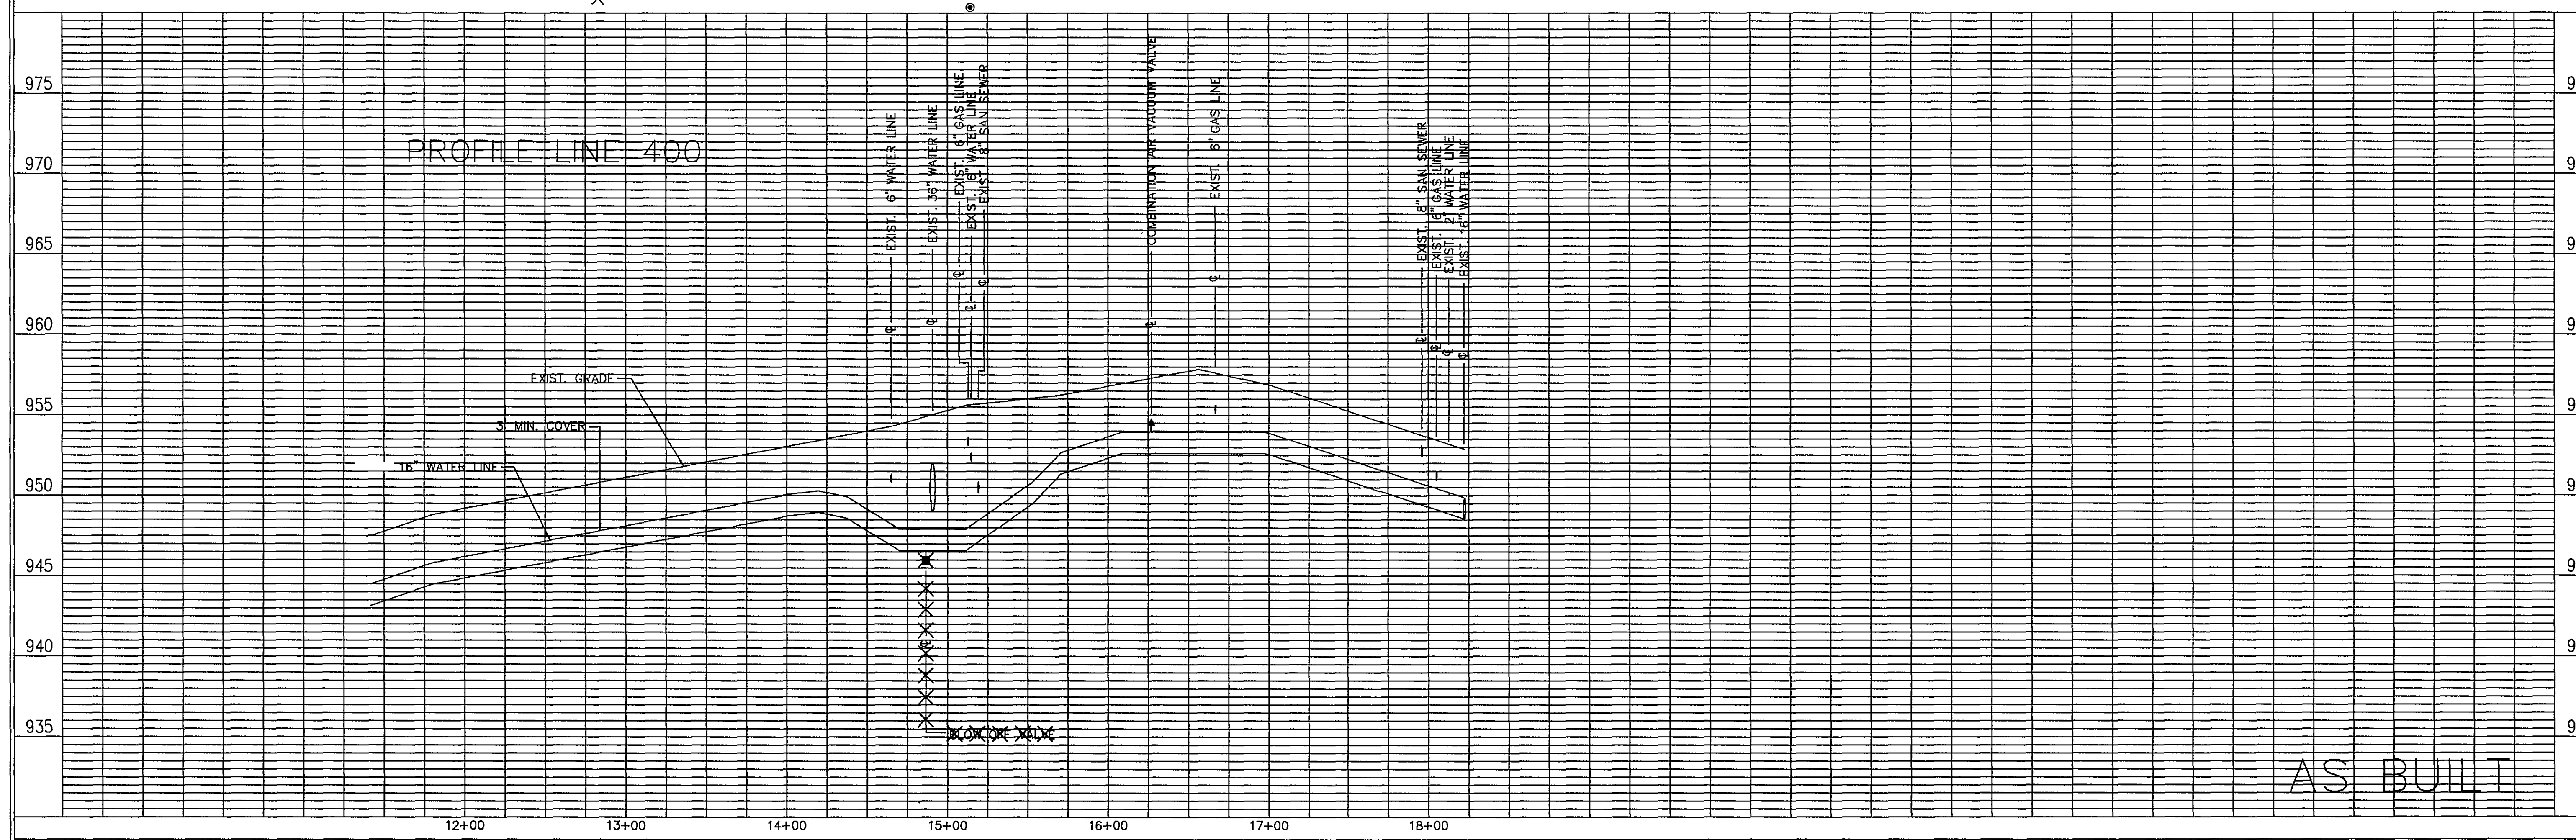

Architects
Engineers
Planners
Surveyors

Dewberry & Davis

5238 Valleypointe Parkway, Suite One-B
Roanoke, Virginia 24019
703 962-7725

Carvins Cove, Phase II
City of Roanoke
Roanoke, Virginia

CONTRACT "B2"
END LINE 400
STA 11+64.03 - 18+22.33

Drawn By REH/ACF
Designed By RBS
Checked By SEH
Date APRIL 93
Scale V: 1" = 5'
H: 1" = 50'
Plan Number C2
Zoned NONE
Sheet 19 of 22
File Number C1160