



MAJOR DIVISIONS			LETTER SYMBOL	TYPICAL DESCRIPTIONS
Coarse Grained Soils More than 50% of Material by Weight is Coarser than No. 200 Sieve Size	Gravel and Gravelly Soils More than 50% of Coarse Fraction Retained on No. 4 Sieve	Clean Gravels 0–5% Fines*	GW	Fully–Graded Gravels, Gravel–Sand Mixtures, Little or No Fines
		Gravels with Fines >12% Fines*	GP	Gap or Uniform–Graded Gravels, Gravel–Sand Mixtures, Little or No Fines
			GM	Silty Gravels, Gravel–Sand Silt Mixtures
			GC	Clayey Gravels, Gravel–Sand–Clay Mixtures
	Sand and Sandy Soils More than 50% of Coarse Fraction Passing No. 4 Sieve	Clean Sand 0–5% fines*	SW	Well–Graded Sands, Gravelly Sands, Little or No Fines
		Sands with Fines >12% Fines	SP	Gap or Uniform Graded Sands, Gravelly Sands, Little or No Fines
			SM	Silty Sands, Sand–Silt Mixtures
			SC	Clayey Sands, Sand–Clay Mixtures
Fine Gravels Soils More than 50% of Material by Weight is Finer than No. 200 Sieve Size	Silt and Clays Low Compressibility Liquid Limit Less than 50%	ML	Inorganic Silts and Very Fine Sands, Rock Flour, Silty or Clayey Fine Sands or Clayey Silts with Slight Plasticity	
		CL	Inorganic Clays of Low to Medium Plasticity, Gravelly Clays, Sandy Clays, Silty Clays	
		OL	Organic Silts and Organic Silty Clays of Low Plasticity	
	Silt and Clays High Compressibility Liquid Limit Greater than 50%	MH	Inorganic Silts, Micaceous or Diatomaceous Fine Sands or Silty Sands	
		CH	Inorganic Clays of High Plasticity	
		OH	Organic Clays of Medium to High Plasticity, Organic Silts	
Highly Organic Soils		PT	Peat, Humus, Swamp Soils with High Organic Contents	
* For soils having 5 to 12% fines, use dual symbol such as SP–SM.				
UNIFIED SOIL CLASSIFICATION SYSTEM				

UNIFIED SOIL CLASSIFICATION SYSTEM


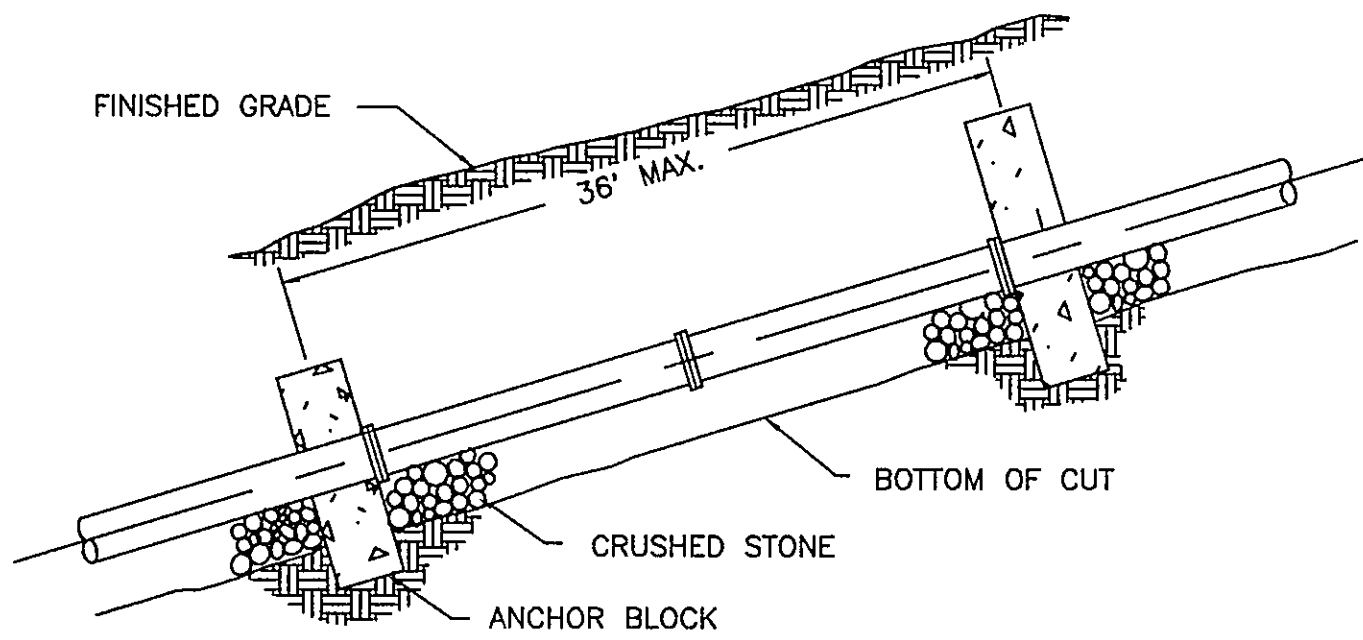


SLOPE ANCHOR SPACING



SLOPE	SPACING
20%-35%	36'
35%-50%	24'
50%-OVER	16'

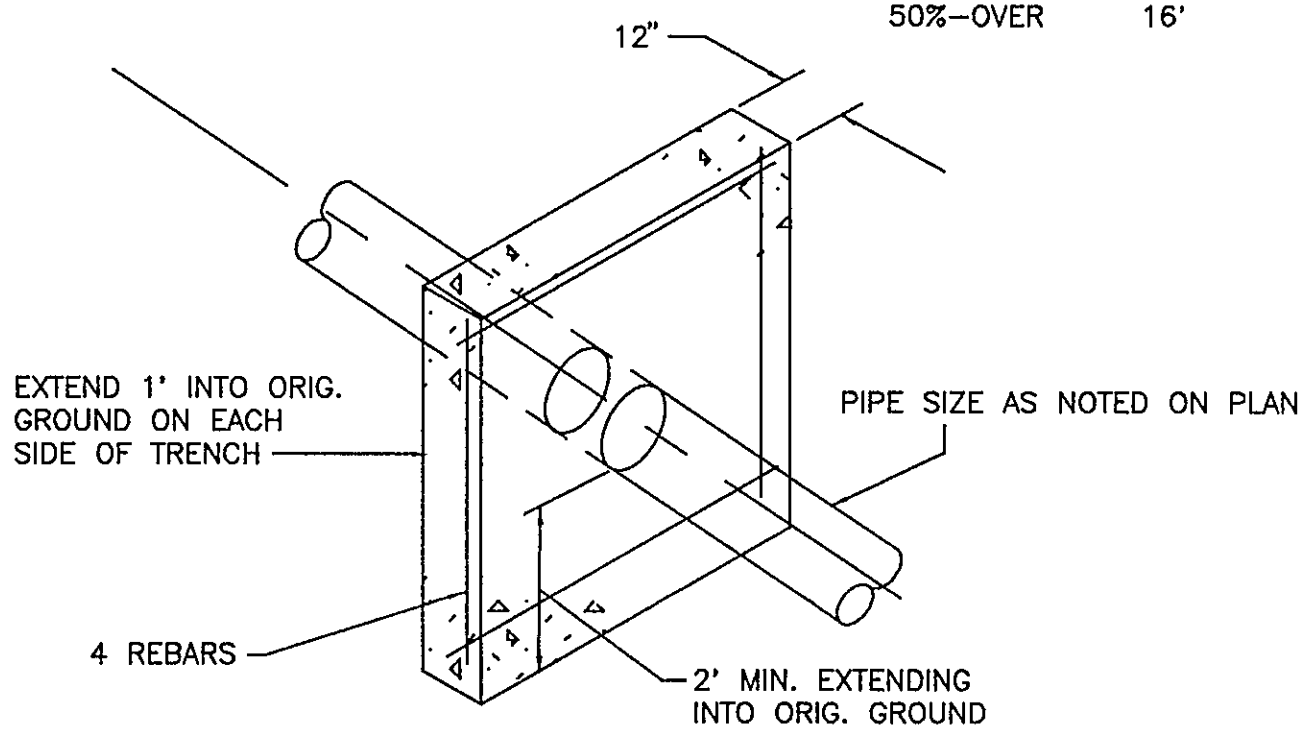


ANCHOR BLOCK DETAIL  
NTS

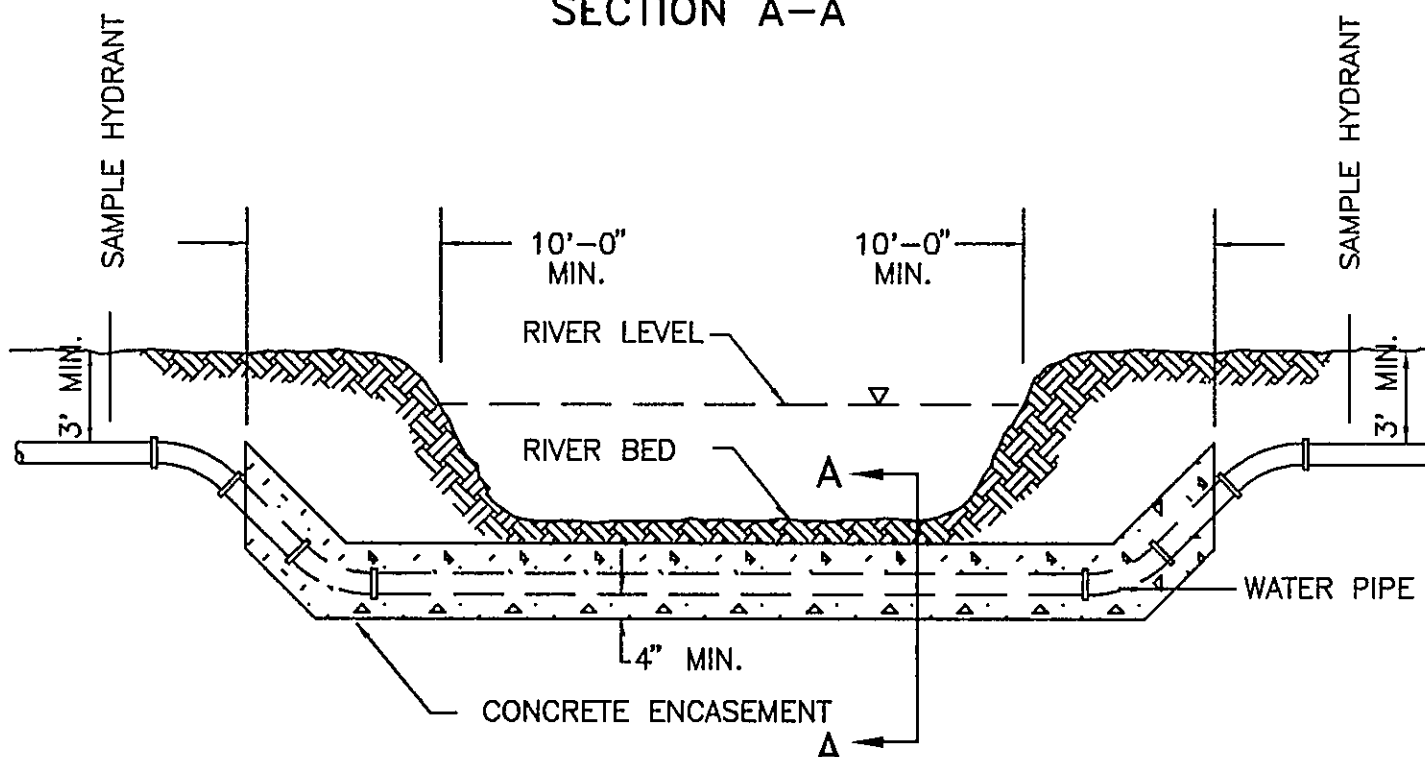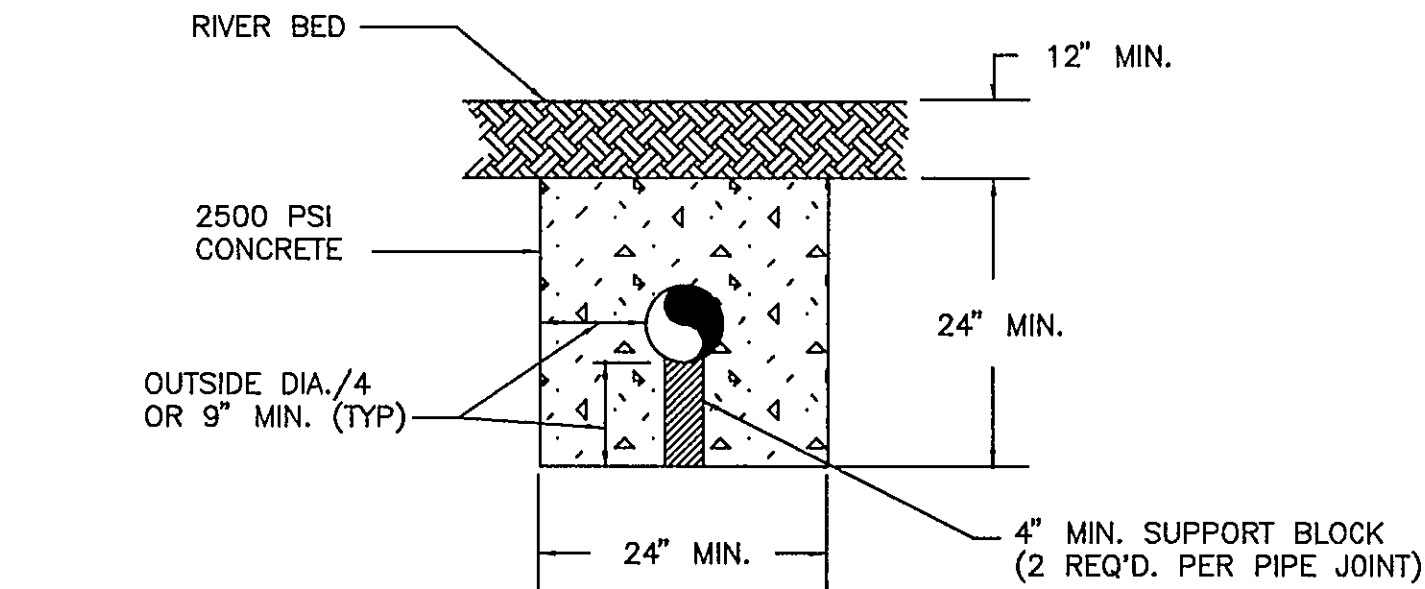

RIVER CROSSING DETAIL  
NTS

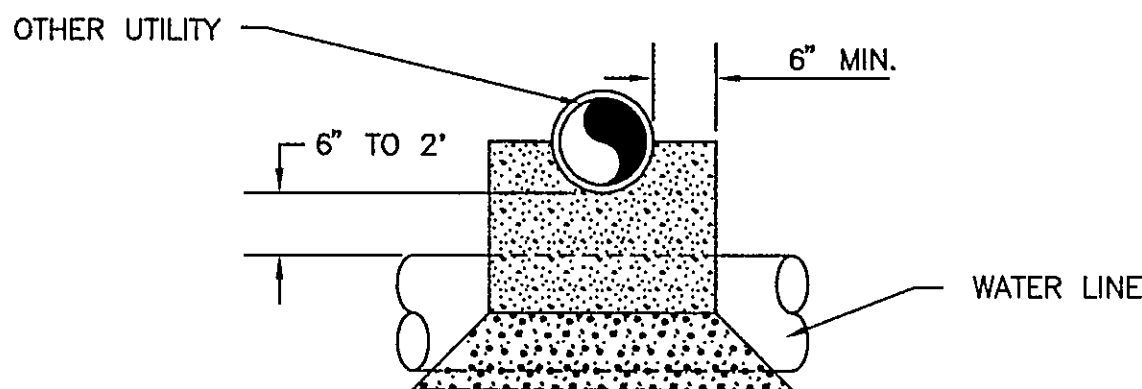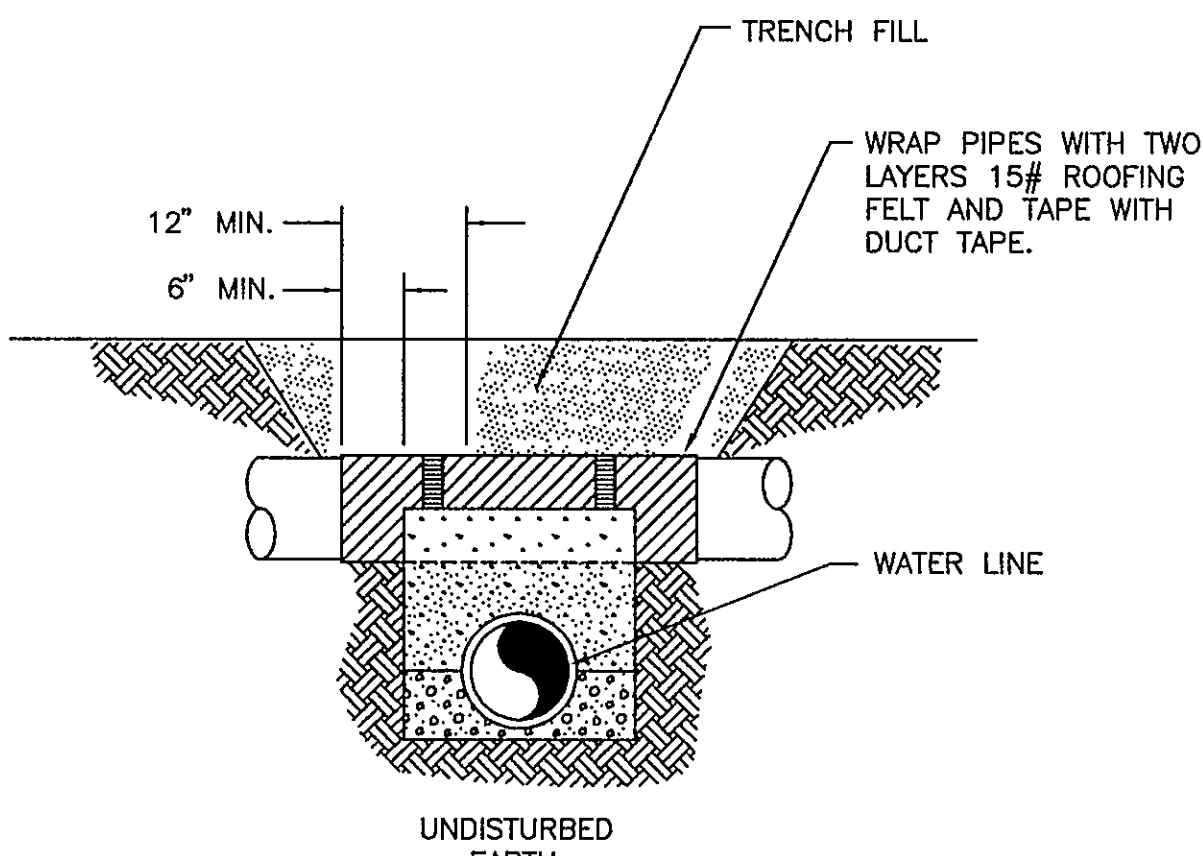


PIPE CROSSING OTHER THAN  
SANITARY SEWER  
NTS

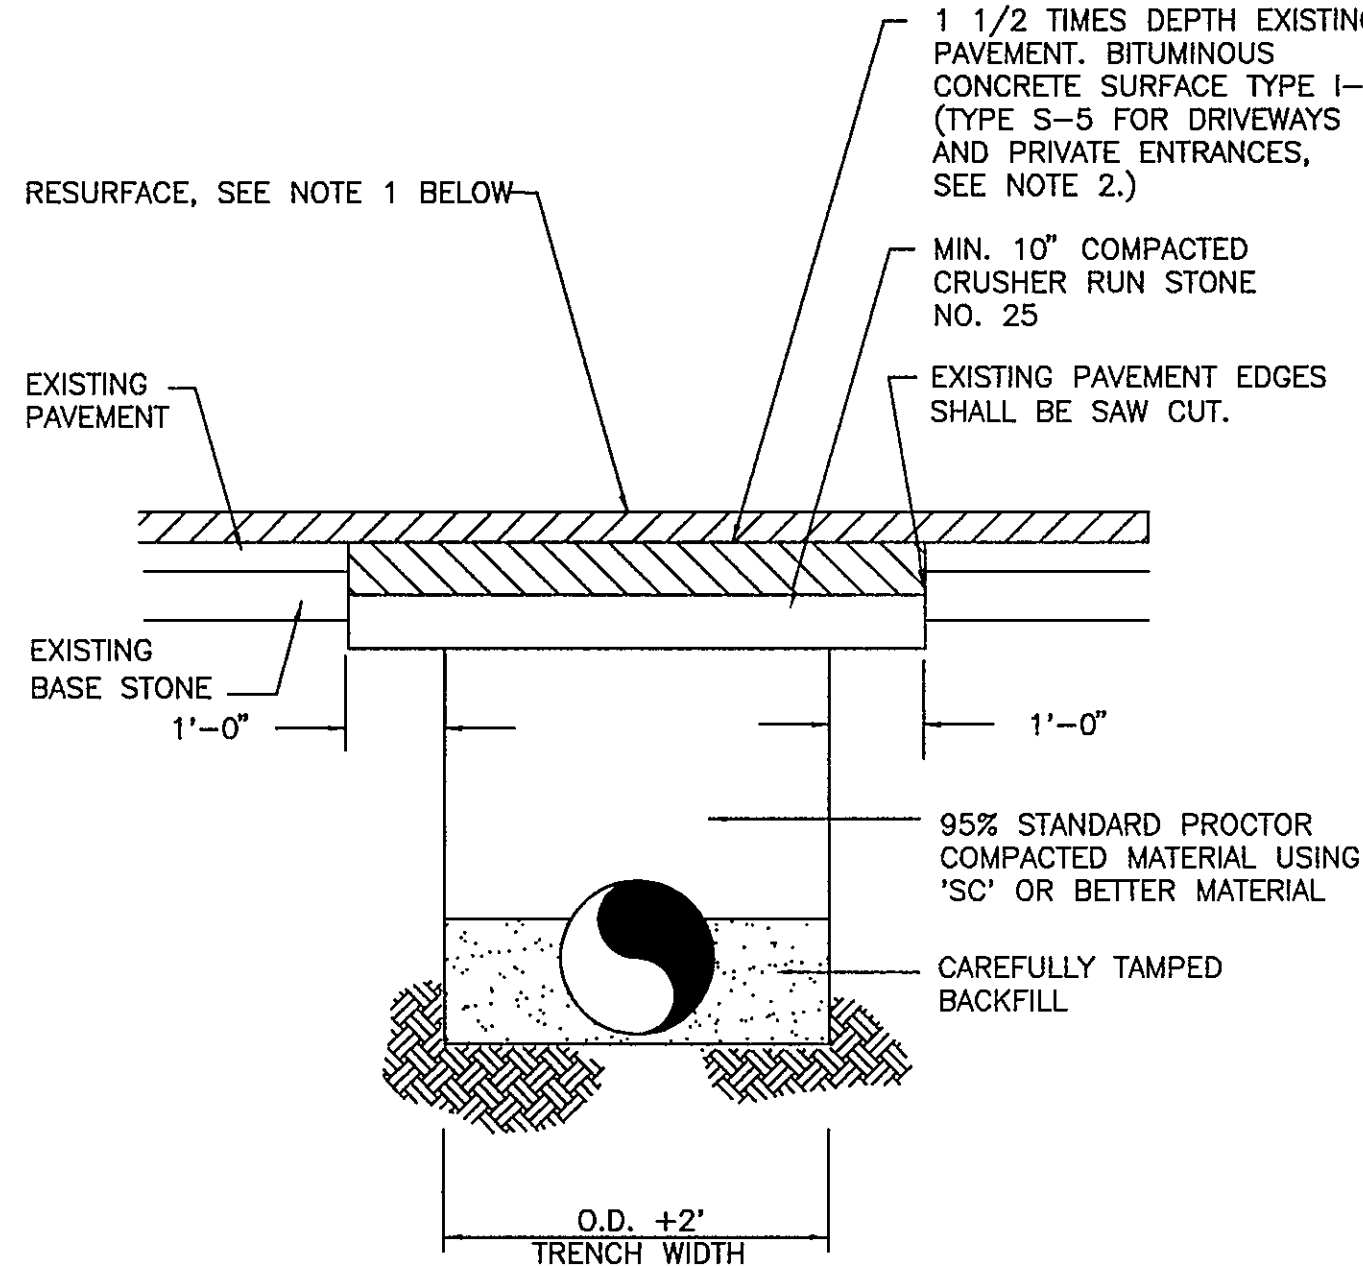


OPEN CUT ROAD and CROSSING DETAIL  
NTS

- NOTES:
- 1) ALL PAVED SURFACES OWNED BY THE STATE SHALL BE RESURFACED 25' EACH SIDE OF CUT, AS PER V.D.O.T. SPECIFICATIONS. ALL PAVED ROADWAYS OWNED BY THE CITY OF ROANOKE, AND CUT BY THE CONTRACTOR SHALL HAVE THE TRENCH WIDTH PLUS FIVE FEET ON EACH SIDE OF THE CUT RESURFACED TO A COMPACTED THICKNESS OF 1.5"
  - 2) THIS DETAIL ALSO APPLIES TO ALL PAVED DRIVEWAYS AND ENTRANCES- EXCLUDING 25' RESURFACING EACH WAY.
  - 3) WHERE EXISTING SURFACE IS GRAVEL, REPLACEMENT SURFACE TO BE CRUSHER RUN STONE NO. 25.
  - 4) MAXIMUM DEPTH OF ASPHALT TRENCH PATCH IS 6 INCHES COMPACTED.

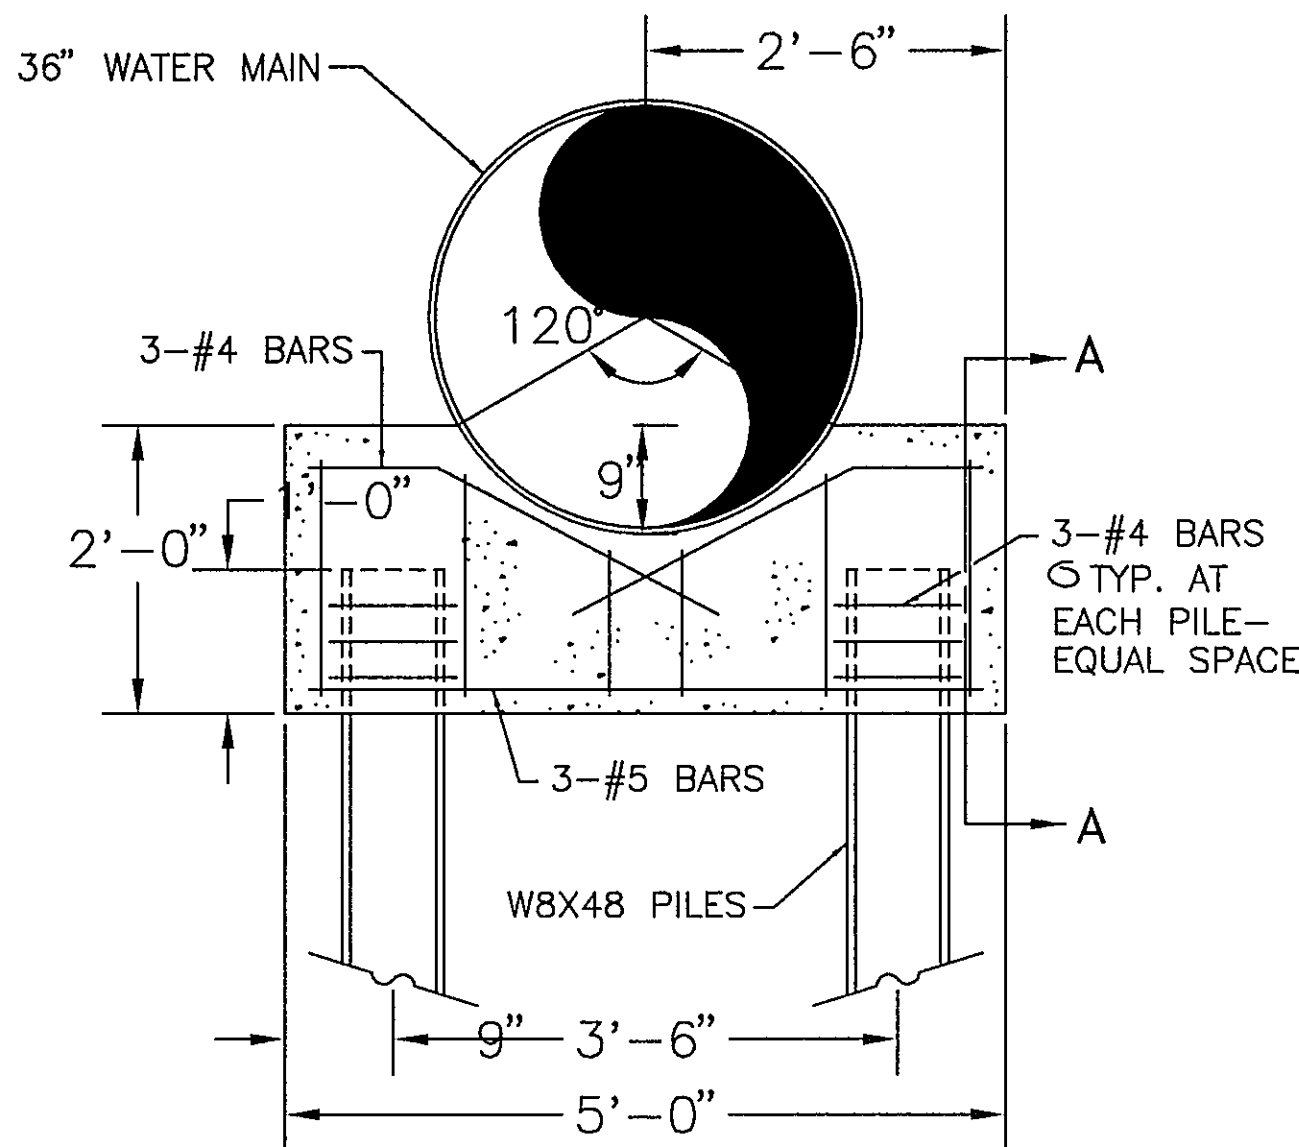


SECTION A-A  
PILE CAP DETAIL  
NTS

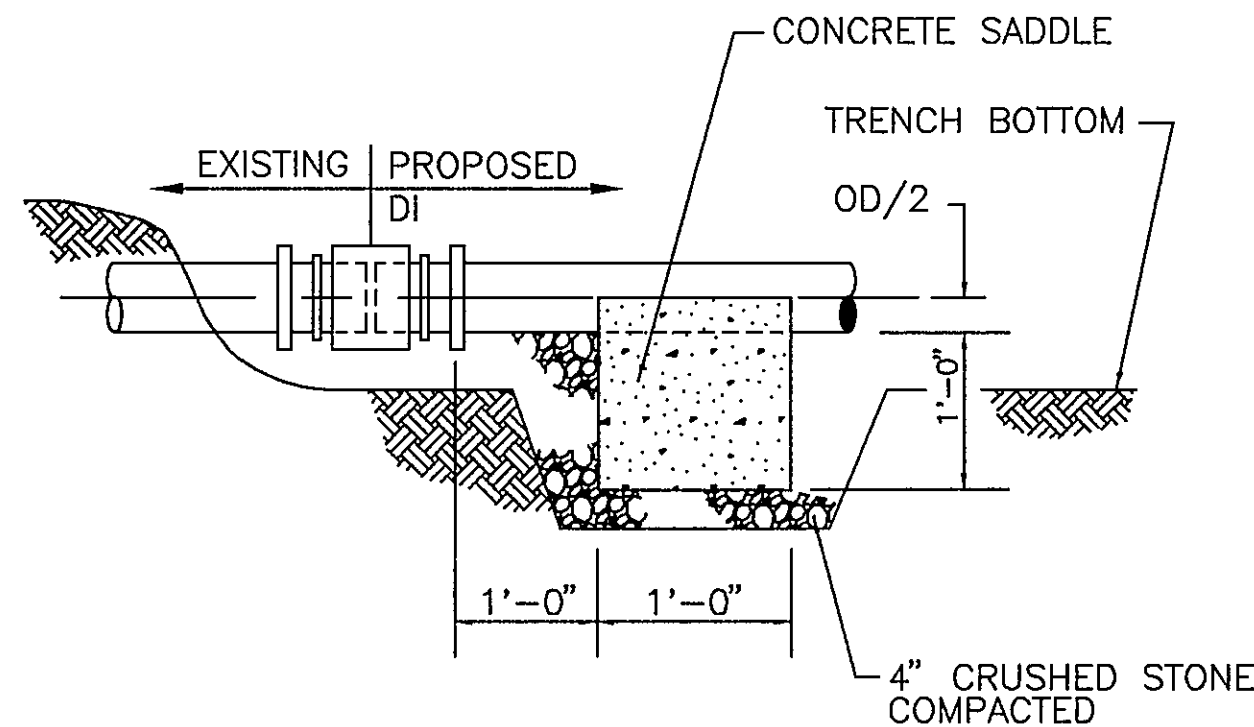

- COUPLING EQUAL TO FERNCO:
- SERIES 1051 WHEN EXISTING IS ASBESTOS CEMENT
- SERIES 1002 WHEN EXISTING IS VITRIFIED CLAY
- SERIES 1006 WHEN EXISTING IS CONCRETE

TYPICAL SEWER LINE COUPLING DETAIL  
NTS

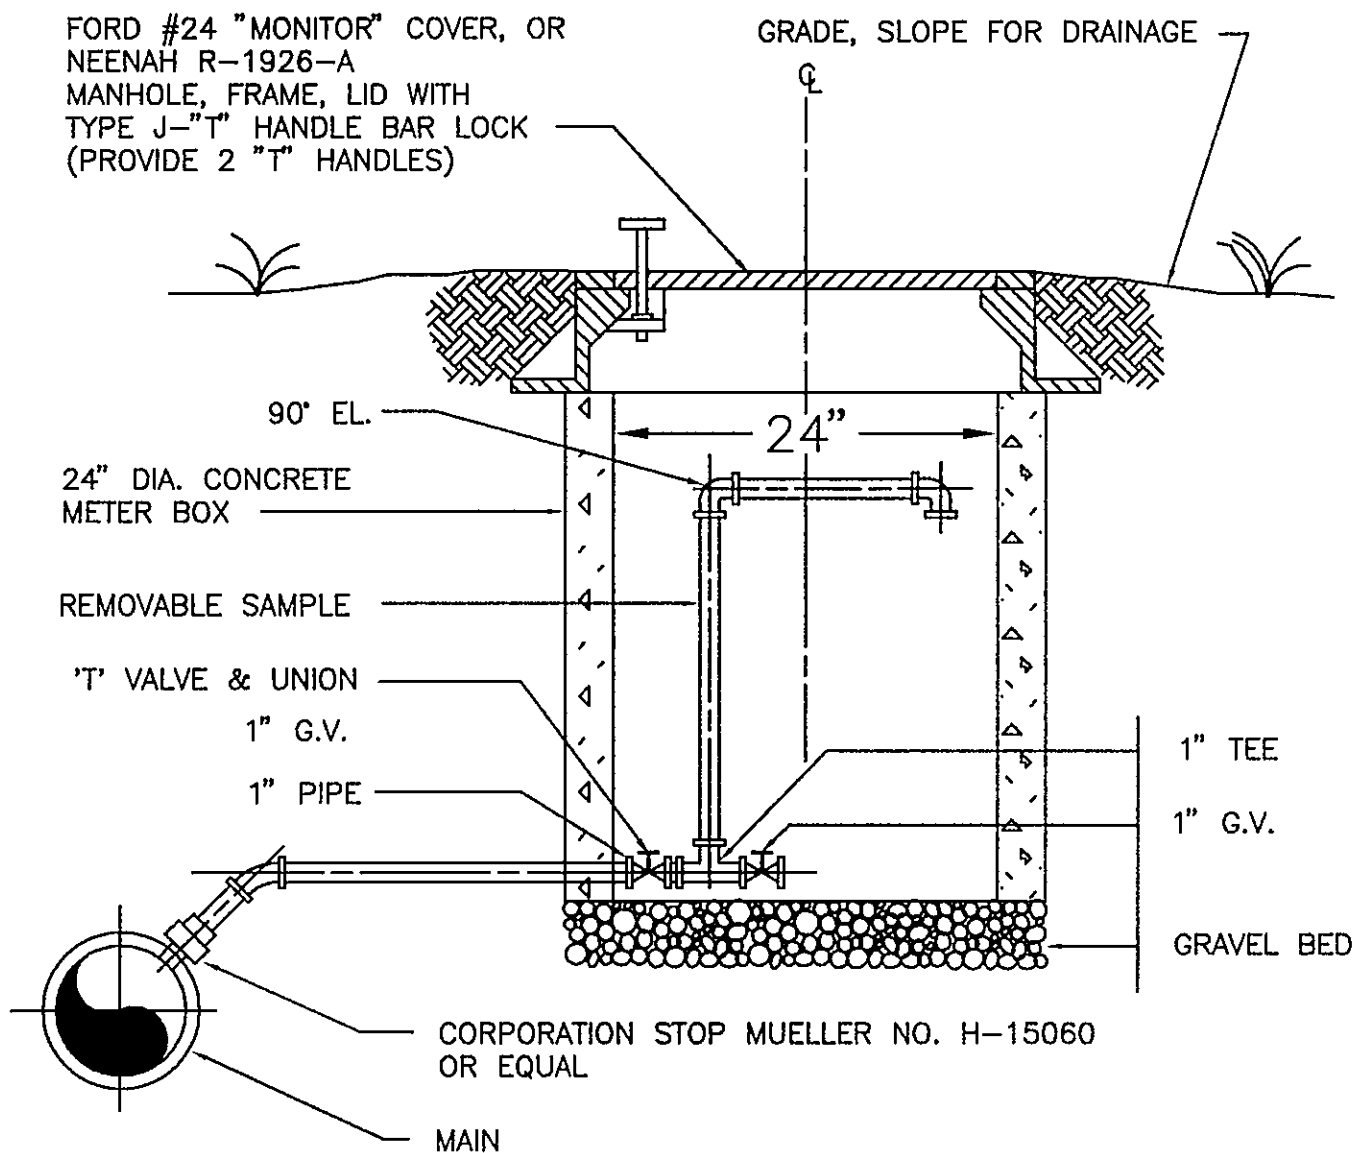

TYPICAL SAMPLE HYDRANT  
NTS

AS BUILT

ENGINEER'S SEAL	ENGINEER'S SEAL

Architects  
Engineers  
Planners  
Surveyors

**Dewberry & Davis**  
5238 Valleypointe Parkway, Suite One-B  
Roanoke, Virginia 24019  
703 362-7726

**Carvins Cove, Phase II**  
City of Roanoke  
Roanoke, Virginia

**CONTRACT "B2"**  
DETAILS

Drawn By	ACF
Designed By	RBS
Checked By	SEH
Date	APRIL 93
Scale	AS SHOWN
Plan Number	B2DTRWL2
Zoned	NONE
Sheet	21 of 22
File Number	C1160