


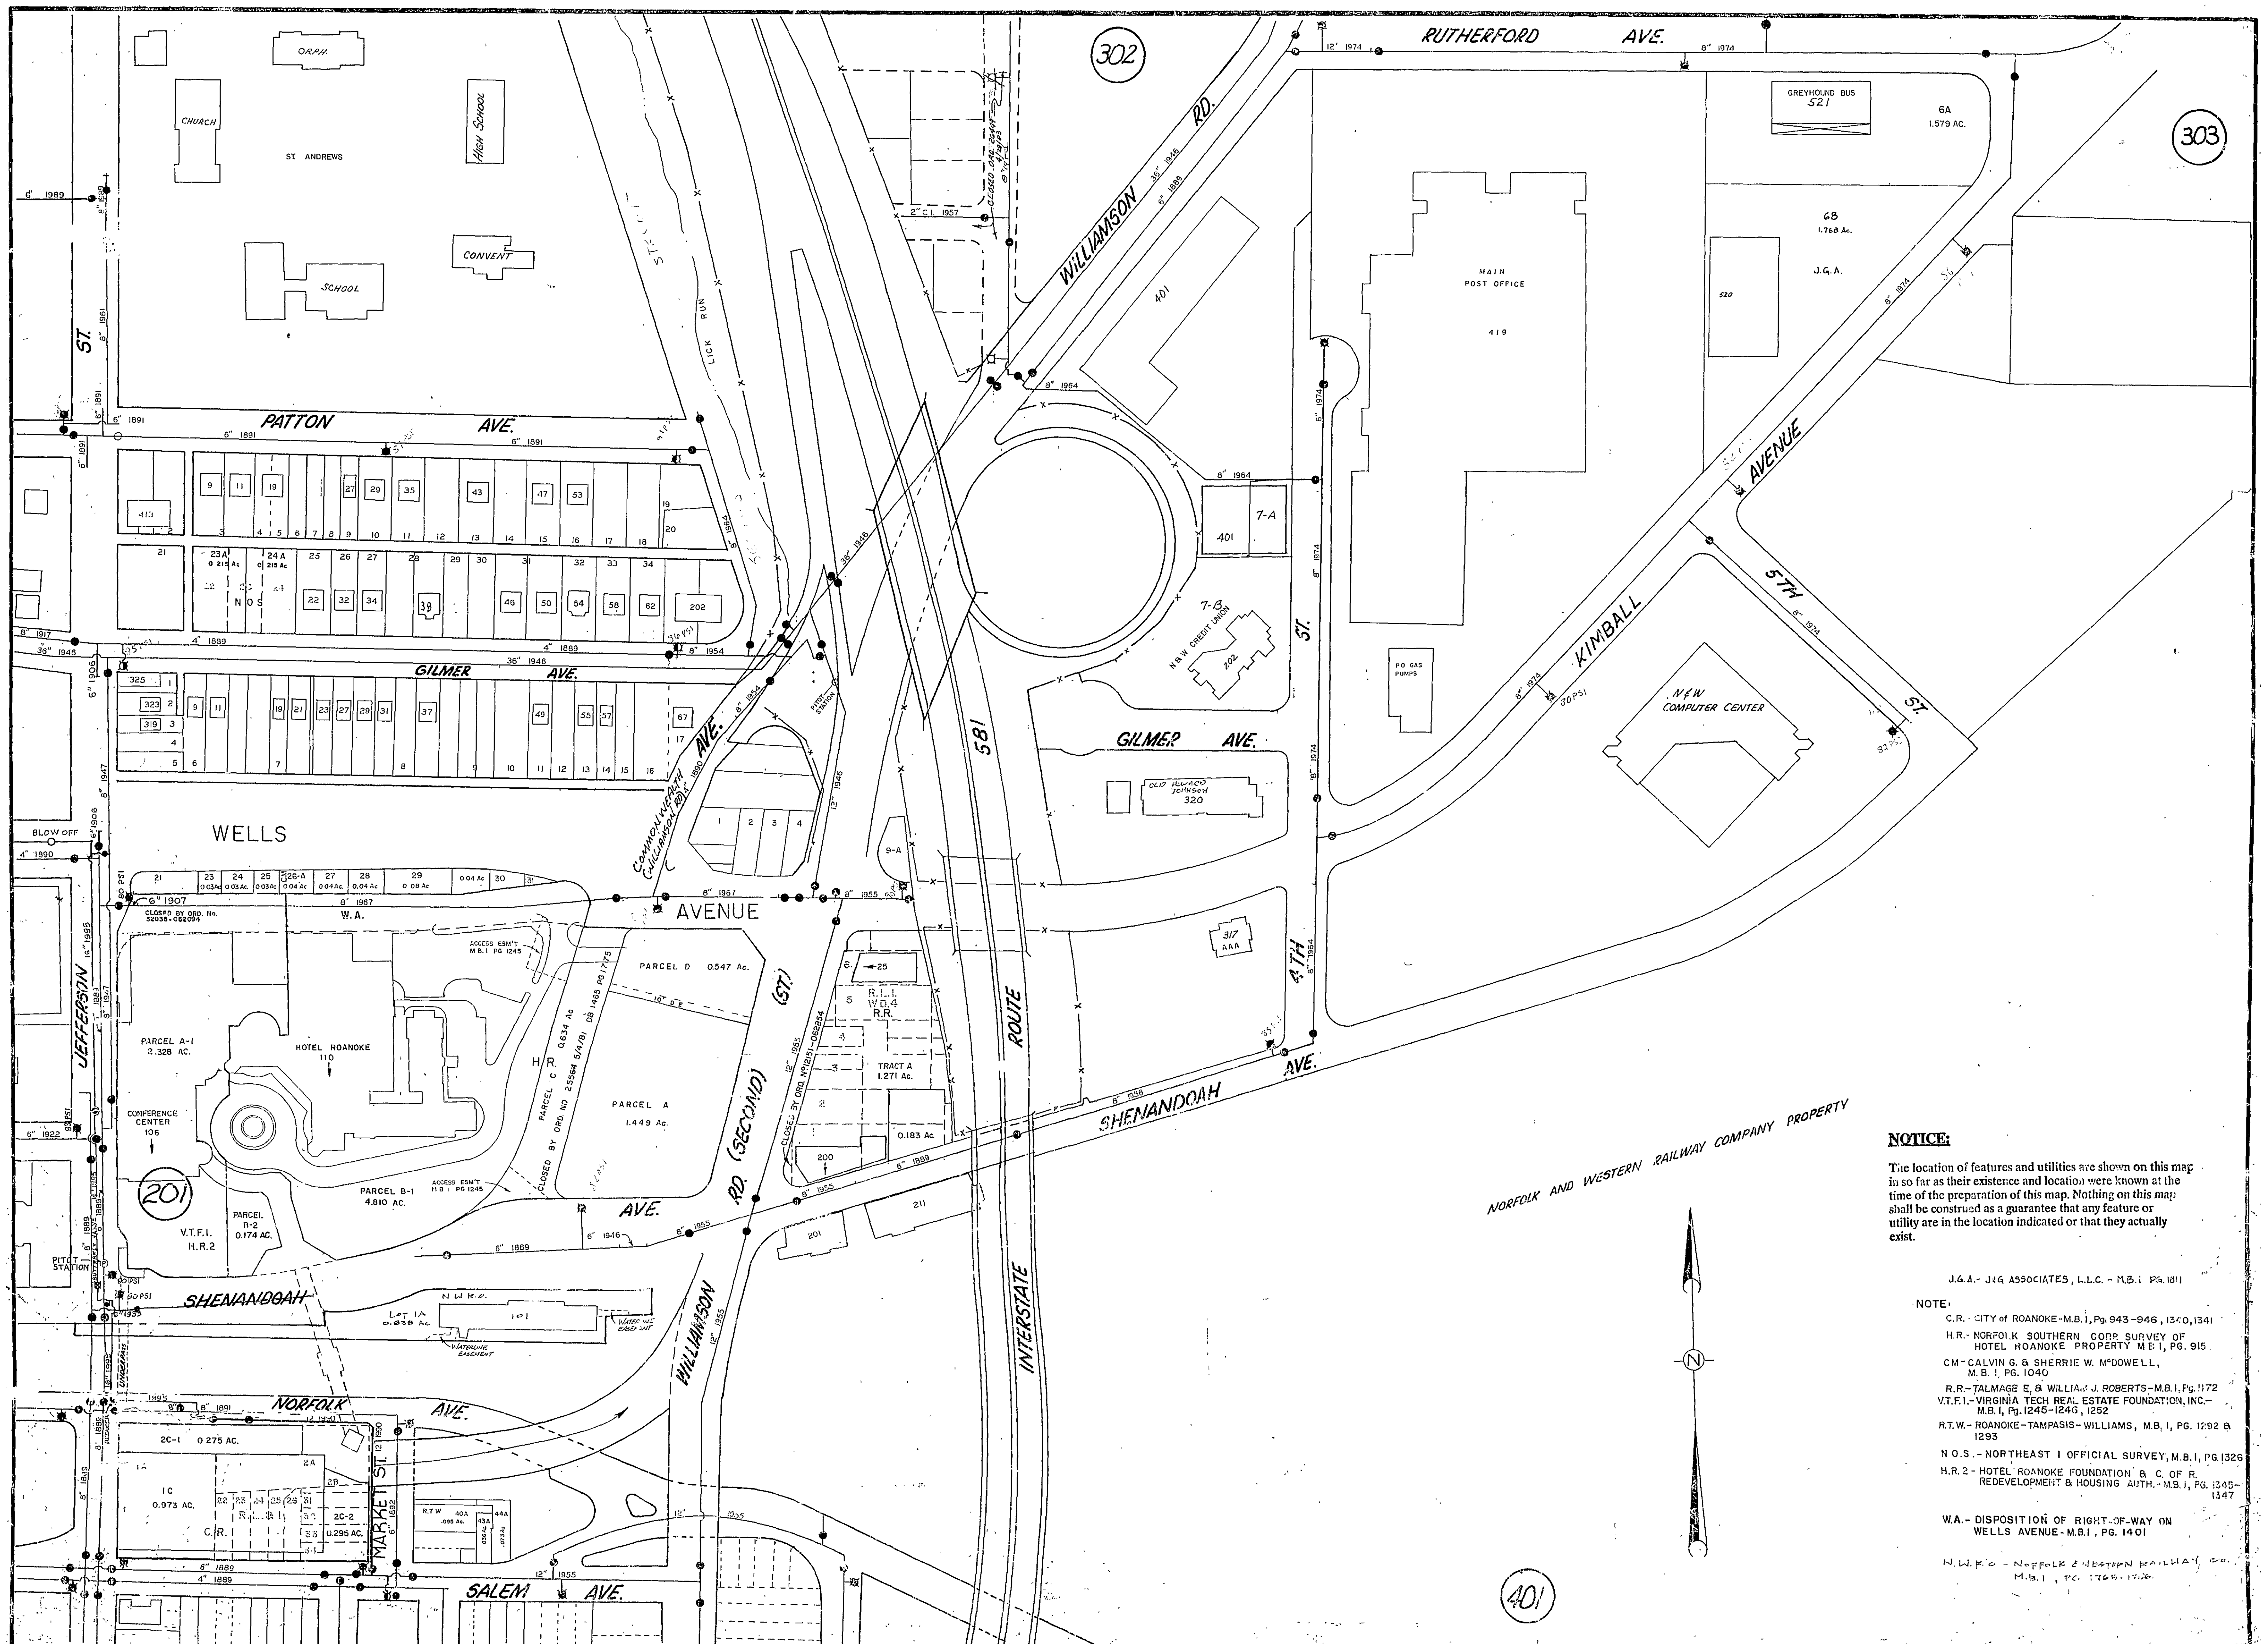

NOTICE:

The location of features and utilities are shown on this map in so far as their existence and location were known at the time of the preparation of this map. Nothing on this map shall be construed as a guarantee that any feature or utility are in the location indicated or that they actually exist.

J.G.A. - J&G ASSOCIATES, L.L.C. - M.B.1 PG. 101

NOTE:

- C.R. - CITY OF ROANOKE - M.B.1, PG. 943-946, 1340, 1341
- H.R. - NORFOLK SOUTHERN CORP. SURVEY OF HOTEL ROANOKE PROPERTY M.B.1, PG. 915
- CM - CALVIN G. & SHERRIE W. McDOWELL, M.B.1, PG. 1040
- R.R. - TALMAGE E. & WILLIAM J. ROBERTS - M.B.1, PG. 1172
- V.T.F.1 - VIRGINIA TECH REAL ESTATE FOUNDATION, INC. - M.B.1, PG. 1245-1246, 1252
- R.T.W. - ROANOKE-TAMPASIS-WILLIAMS, M.B.1, PG. 1292 & 1293
- N.O.S. - NORTHEAST 1 OFFICIAL SURVEY, M.B.1, PG. 1326
- H.R.2 - HOTEL ROANOKE FOUNDATION & C. OF R. REDEVELOPMENT & HOUSING AUTH. - M.B.1, PG. 1345-1347
- W.A. - DISPOSITION OF RIGHT-OF-WAY ON WELLS AVENUE - M.B.1, PG. 1401
- N.W.R. - NORFOLK & WESTERN RAILWAY CO. - M.B.1, PG. 1749-1750