

CARVINS COVE PHASE II

WATER IMPROVEMENTS PROJECT



CONTRACT C1

ROANOKE, VIRGINIA

AS BUILT


VICINITY MAP

NOT TO SCALE

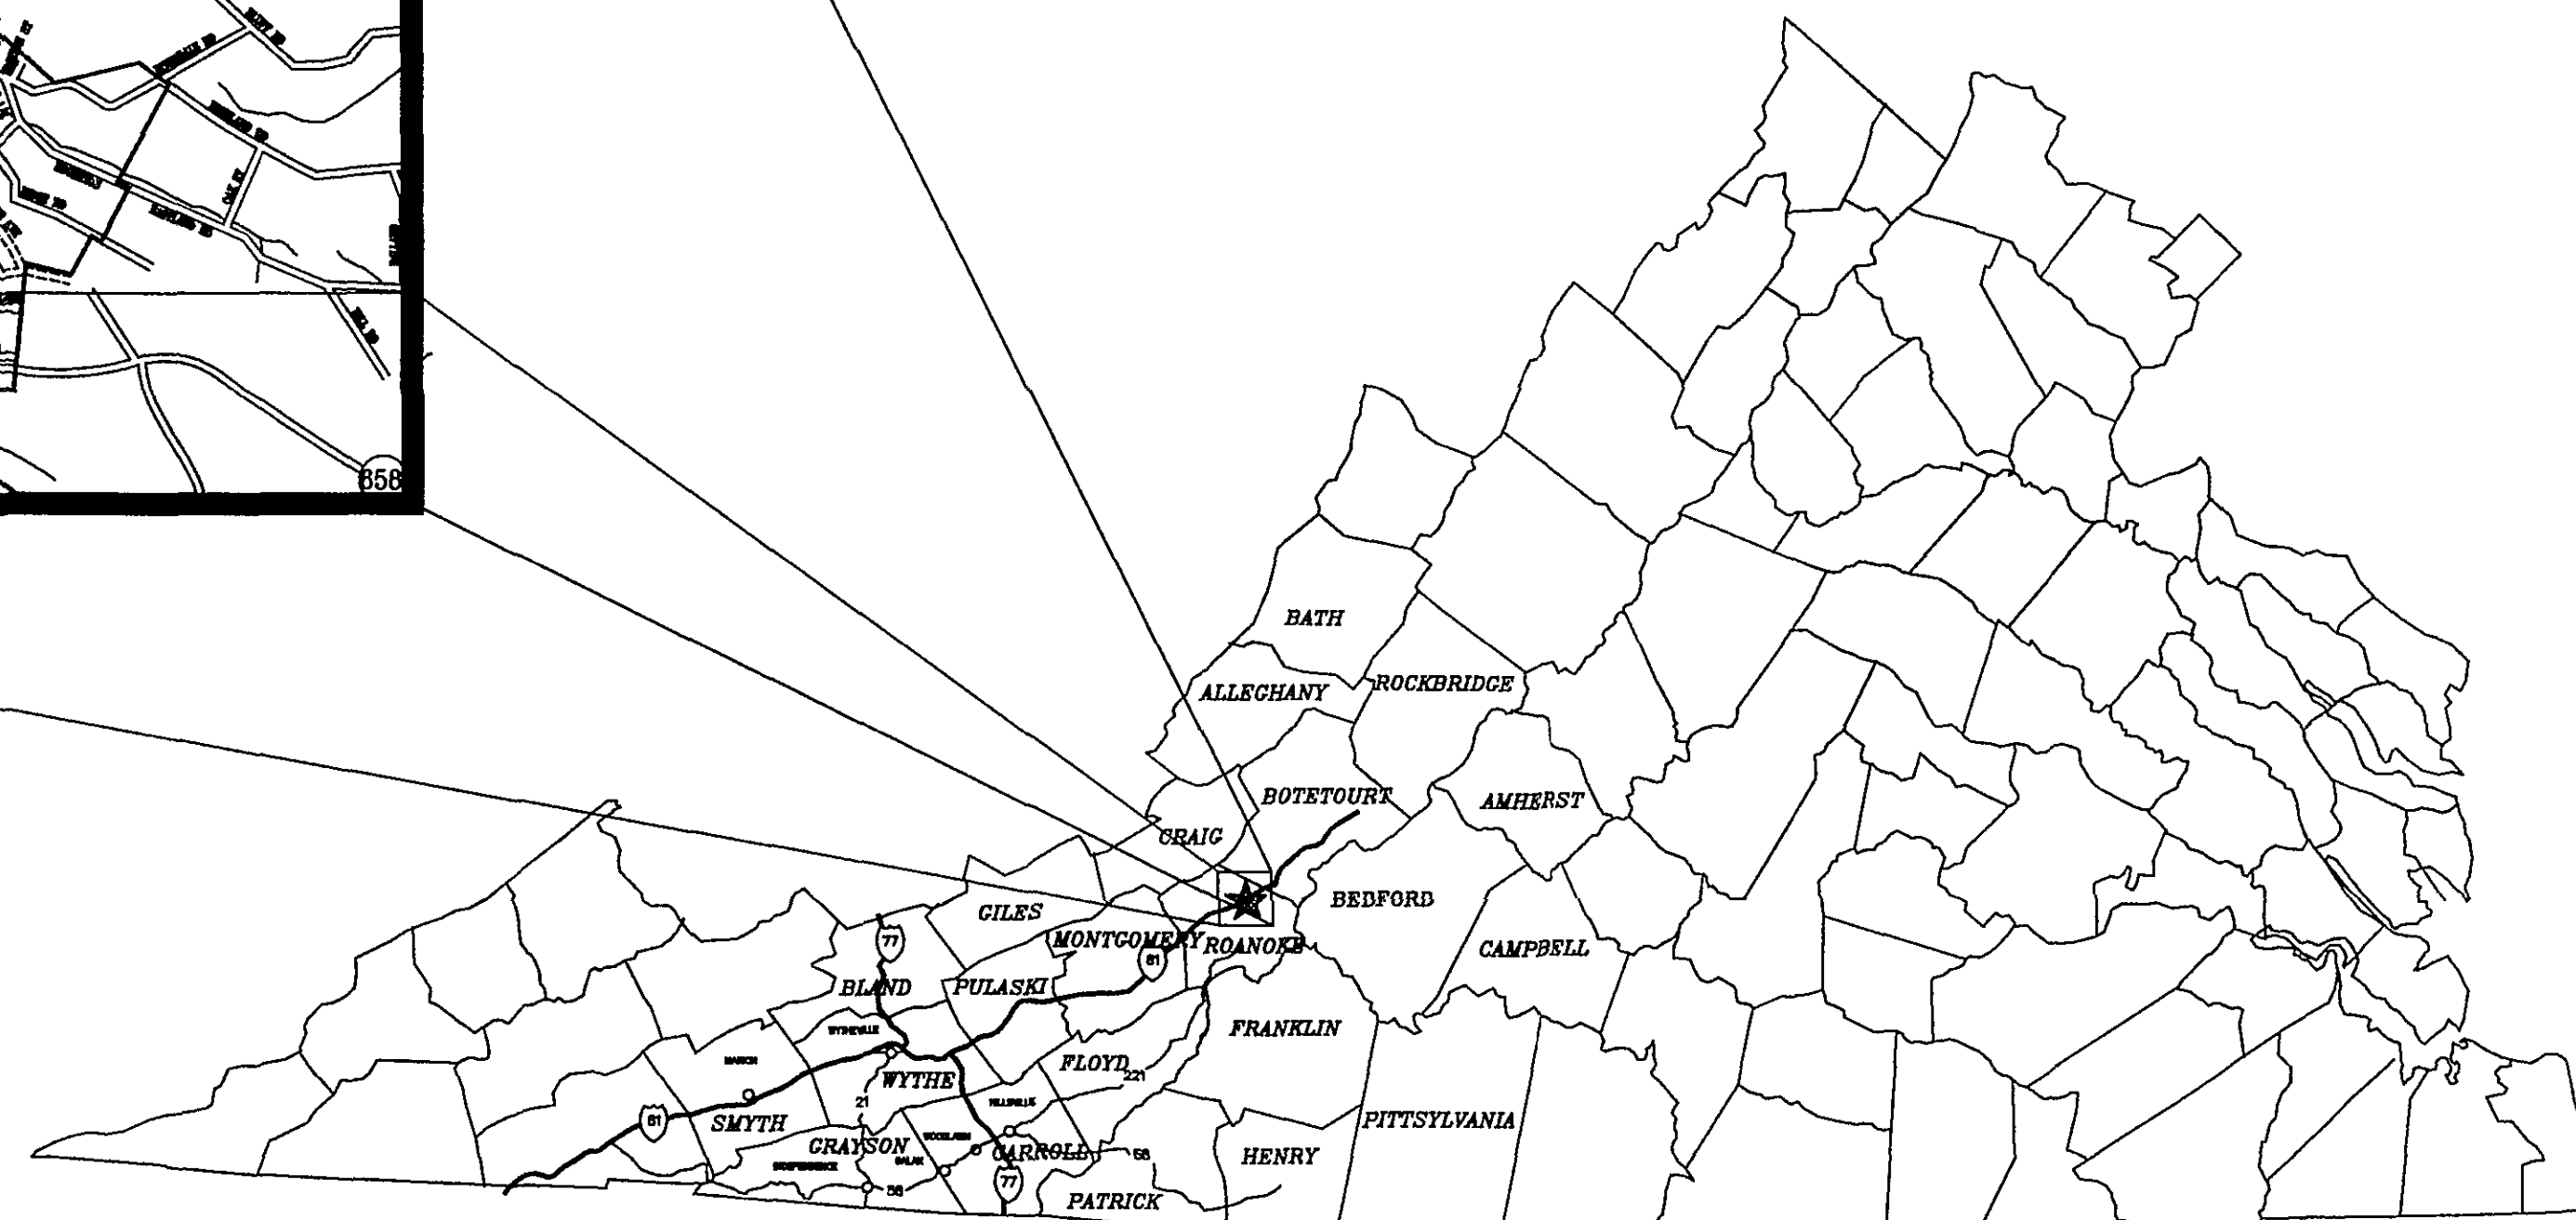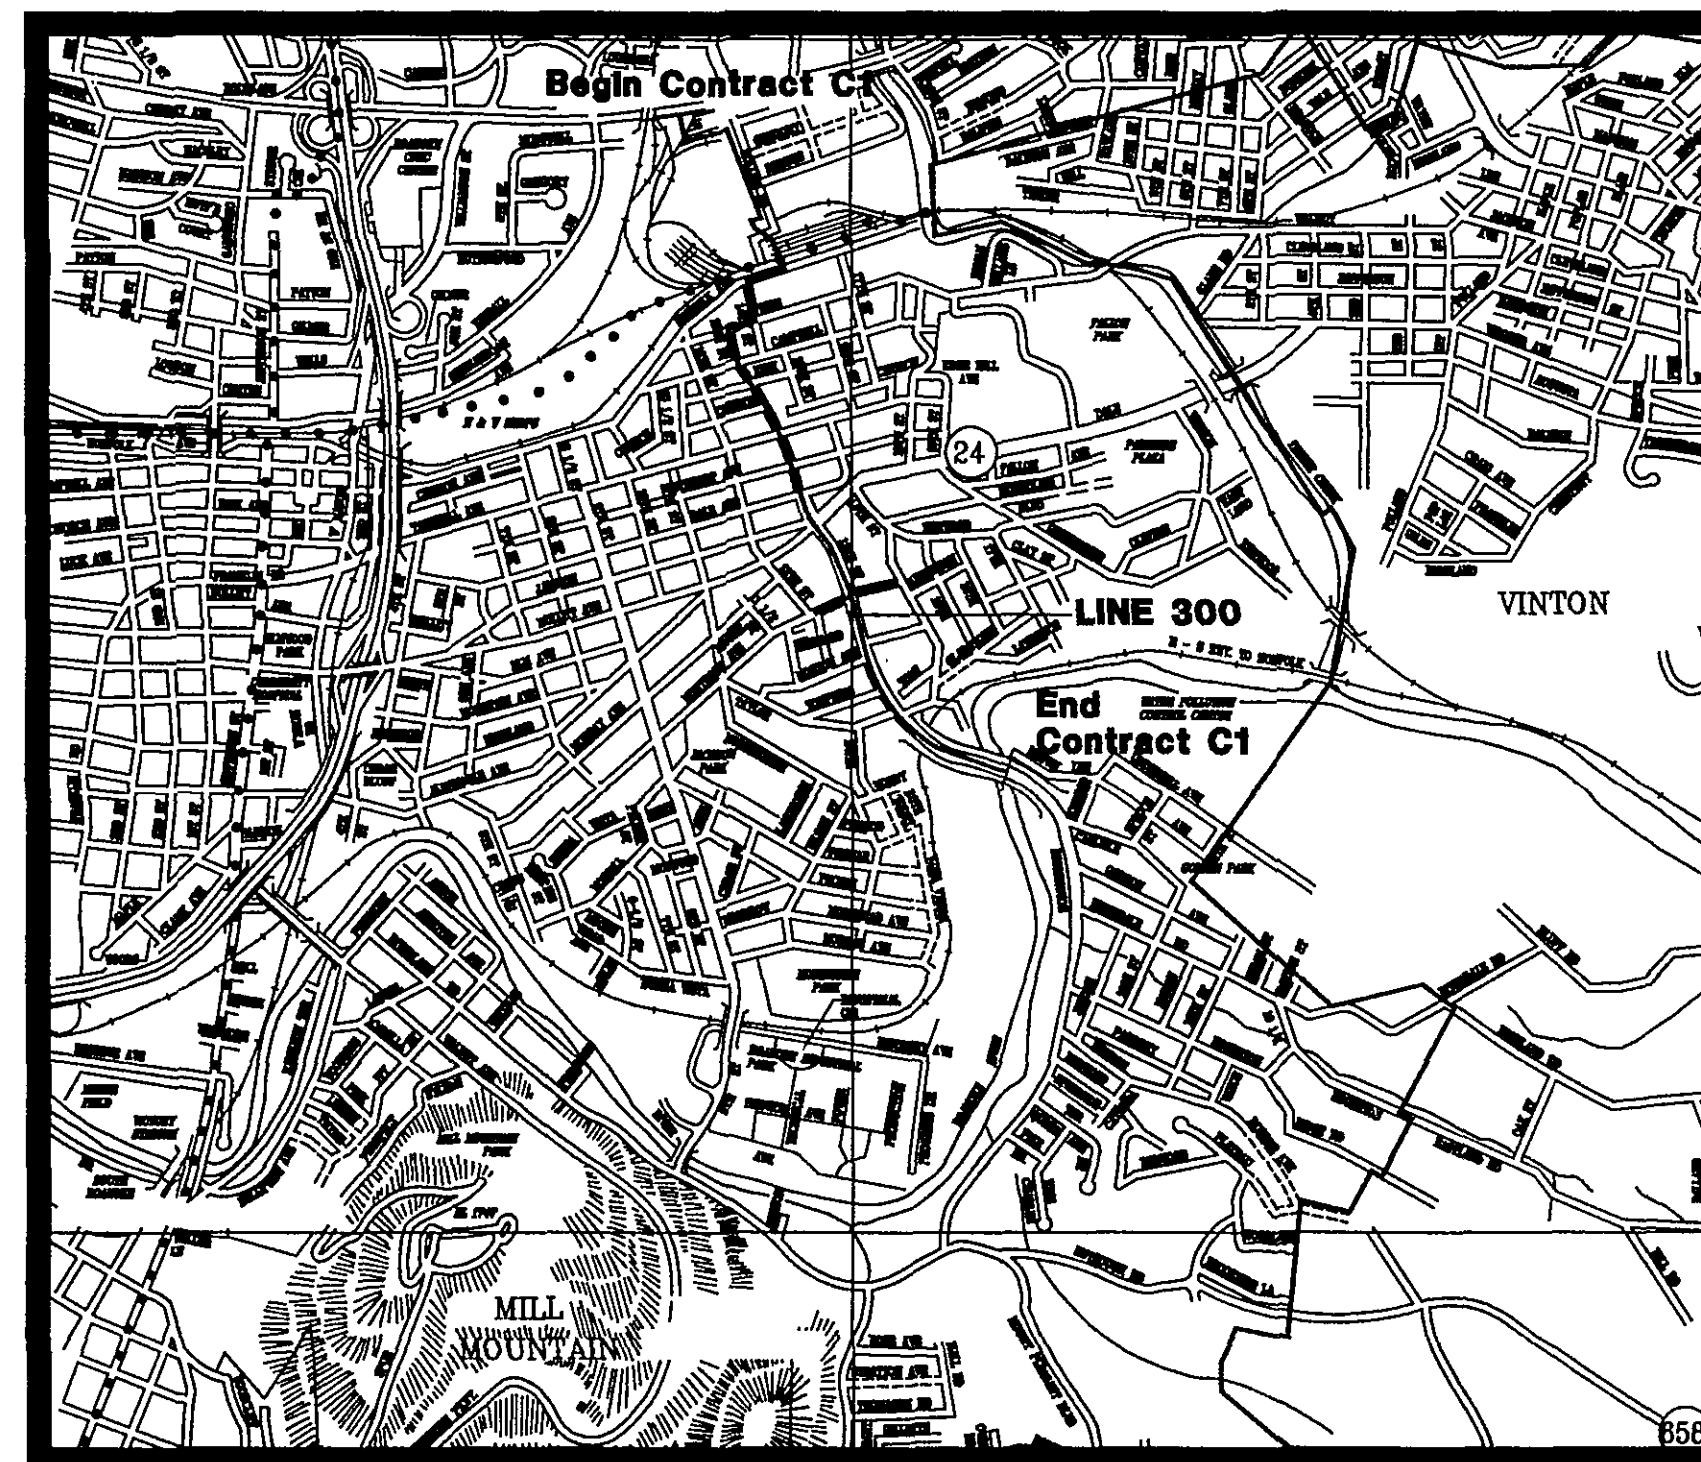

INDEX OF SHEETS

SHEET	TITLE		
1	LINE 300	0+00.00	8+73.19
2	LINE 300	8+73.19	17+16.97
3	LINE 300	17+16.97	30+78.17
4	LINE 300	30+78.17	44+29.53
5	LINE 300	44+29.53	55+51.20
6	LINE 300	55+51.20	68+55.80
7	LINE 300	68+55.80	80+93.34
8	LINE 300	80+93.34	94+74.65
9	MONTROSE INTERCONNECT		
	LINE 400	0+00.00	4+87.28
	LINE 400A	0+00.00	4+81.29
10	DETAILS		
11	DETAILS		
12	DETAILS/EROSION/LEGEND		

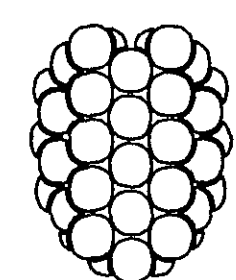

Dewberry & Davis

5238 VALLEYPONTE PARKWAY
SUITE ONE-B
ROANOKE, VIRGINIA 24019
(703) 362-7725

CONTRACT C-1 WATERPLAN #93-24

COMPLETED 4/24/1995

CONTRACTOR: E.C. PACE

