


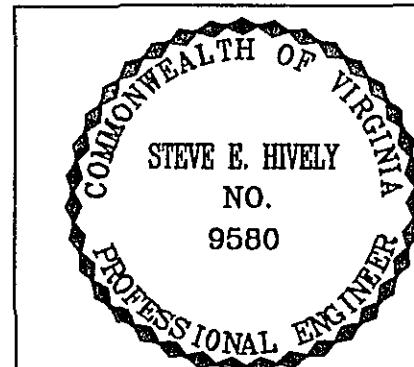


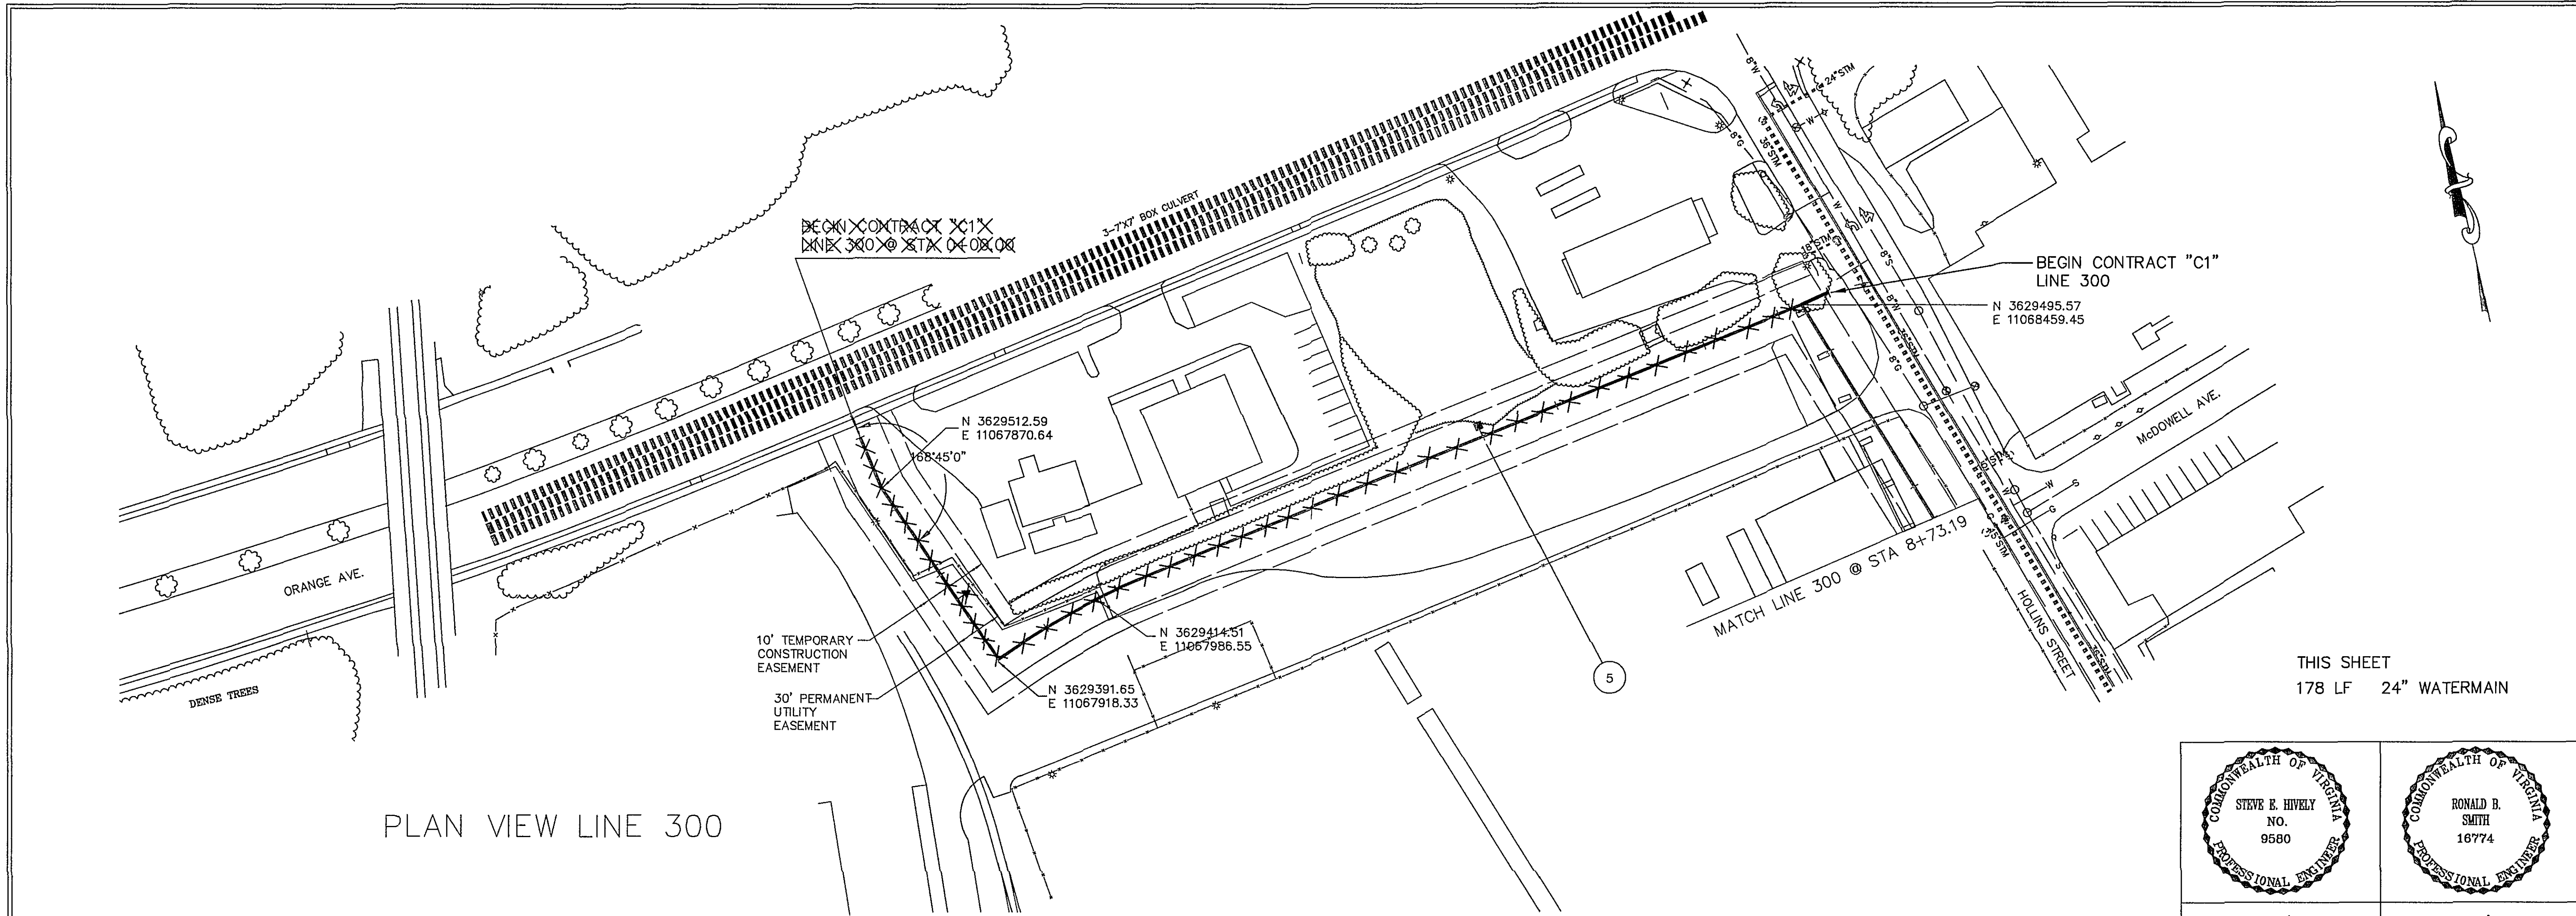

ENGINEER'S SEAL

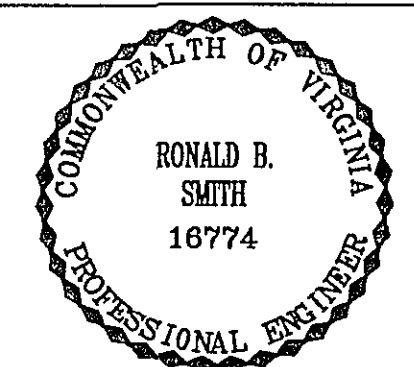

ENGINEER'S SEAL

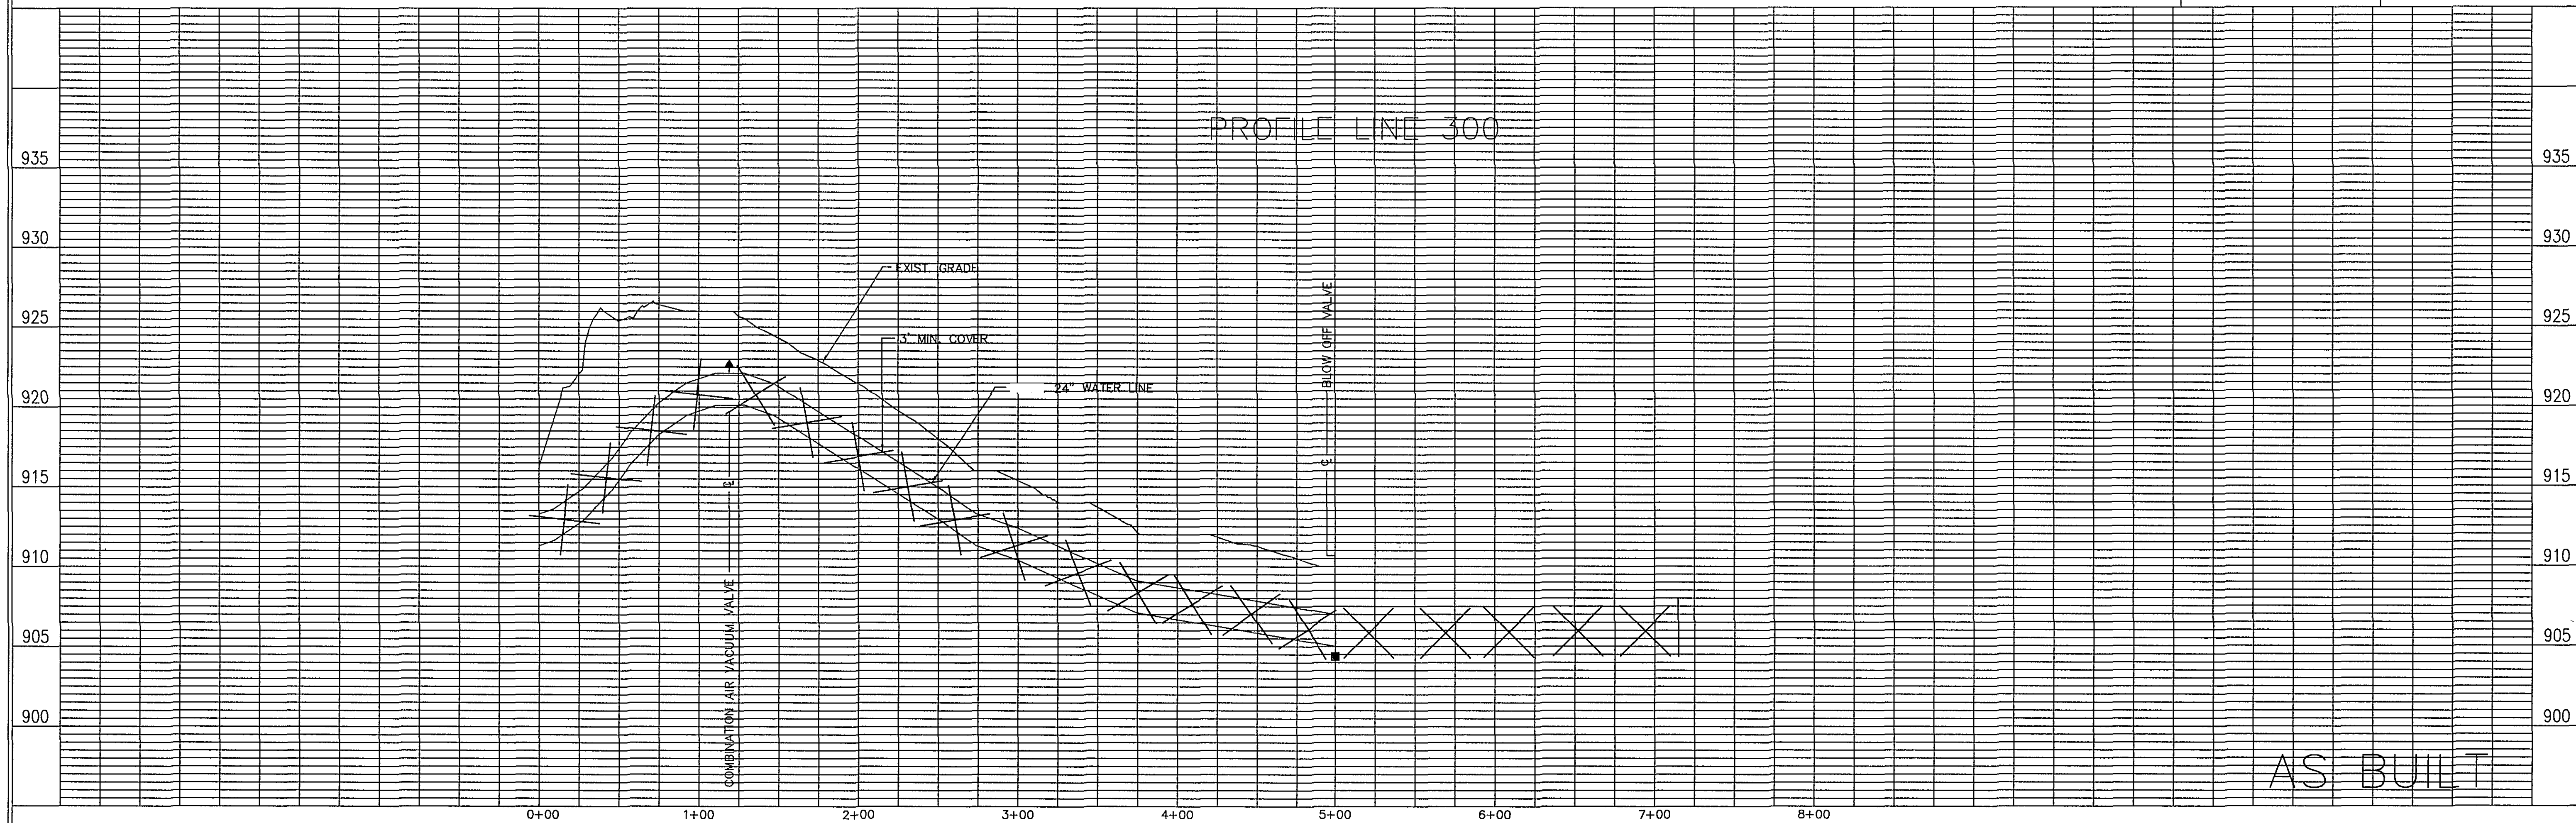

Dewberry & Davis
Architects
Engineers
Planners
Surveyors
5238 Valleypointe Parkway, Suite One-B
Roanoke, Virginia 24019
703-362-7725

Carvins Cove, Phase II
City of Roanoke
Roanoke, Virginia

BEGIN CONTRACT "C1"
BEGIN LINE 300
STA 0+00.00 - 8+73.19

Drawn By REH/ACF
Designed By RBS
Checked By SEH
Date APRIL 93
Scale
V: 1" = 5'
H: 1" = 50'
Plan Number B5
Zoned NONE
Sheet 1 of 12
File Number C1160