

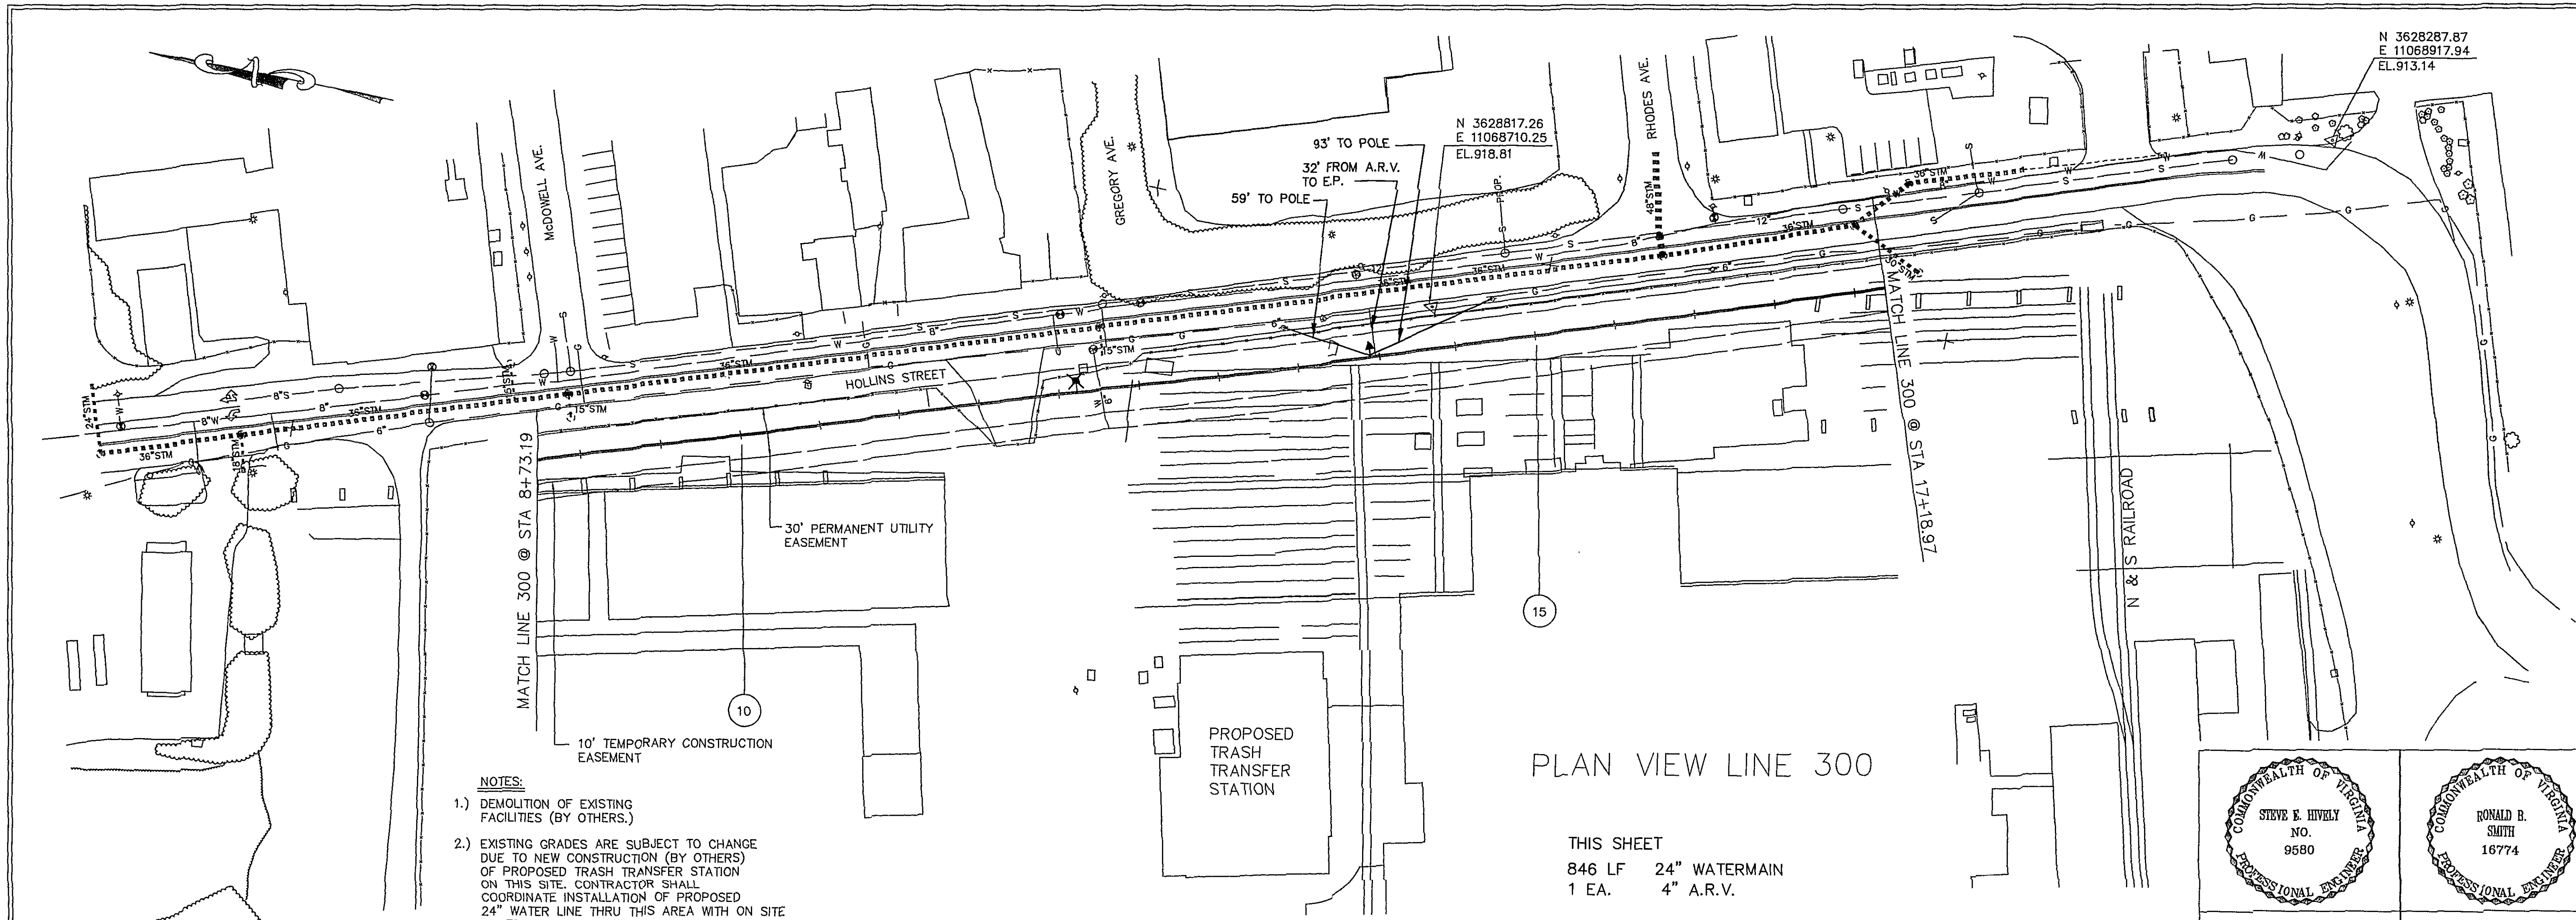


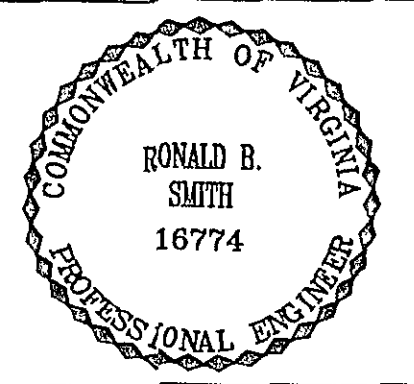

- NOTES:
- 1.) DEMOLITION OF EXISTING FACILITIES (BY OTHERS.)
 - 2.) EXISTING GRADES ARE SUBJECT TO CHANGE DUE TO NEW CONSTRUCTION (BY OTHERS) OF PROPOSED TRASH TRANSFER STATION ON THIS SITE. CONTRACTOR SHALL COORDINATE INSTALLATION OF PROPOSED 24" WATER LINE THRU THIS AREA WITH ON SITE CONTRACTOR.


PLAN VIEW LINE 300

THIS SHEET
846 LF 24" WATERMAIN
1 EA. 4" A.R.V.

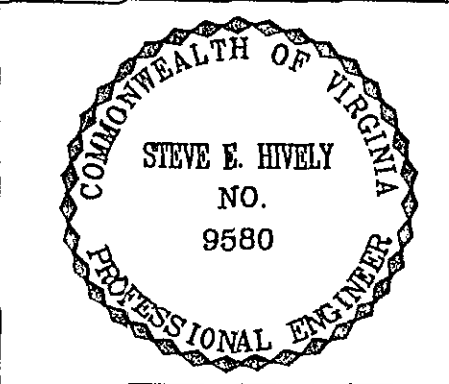

ENGINEER'S SEAL

ENGINEER'S SEAL

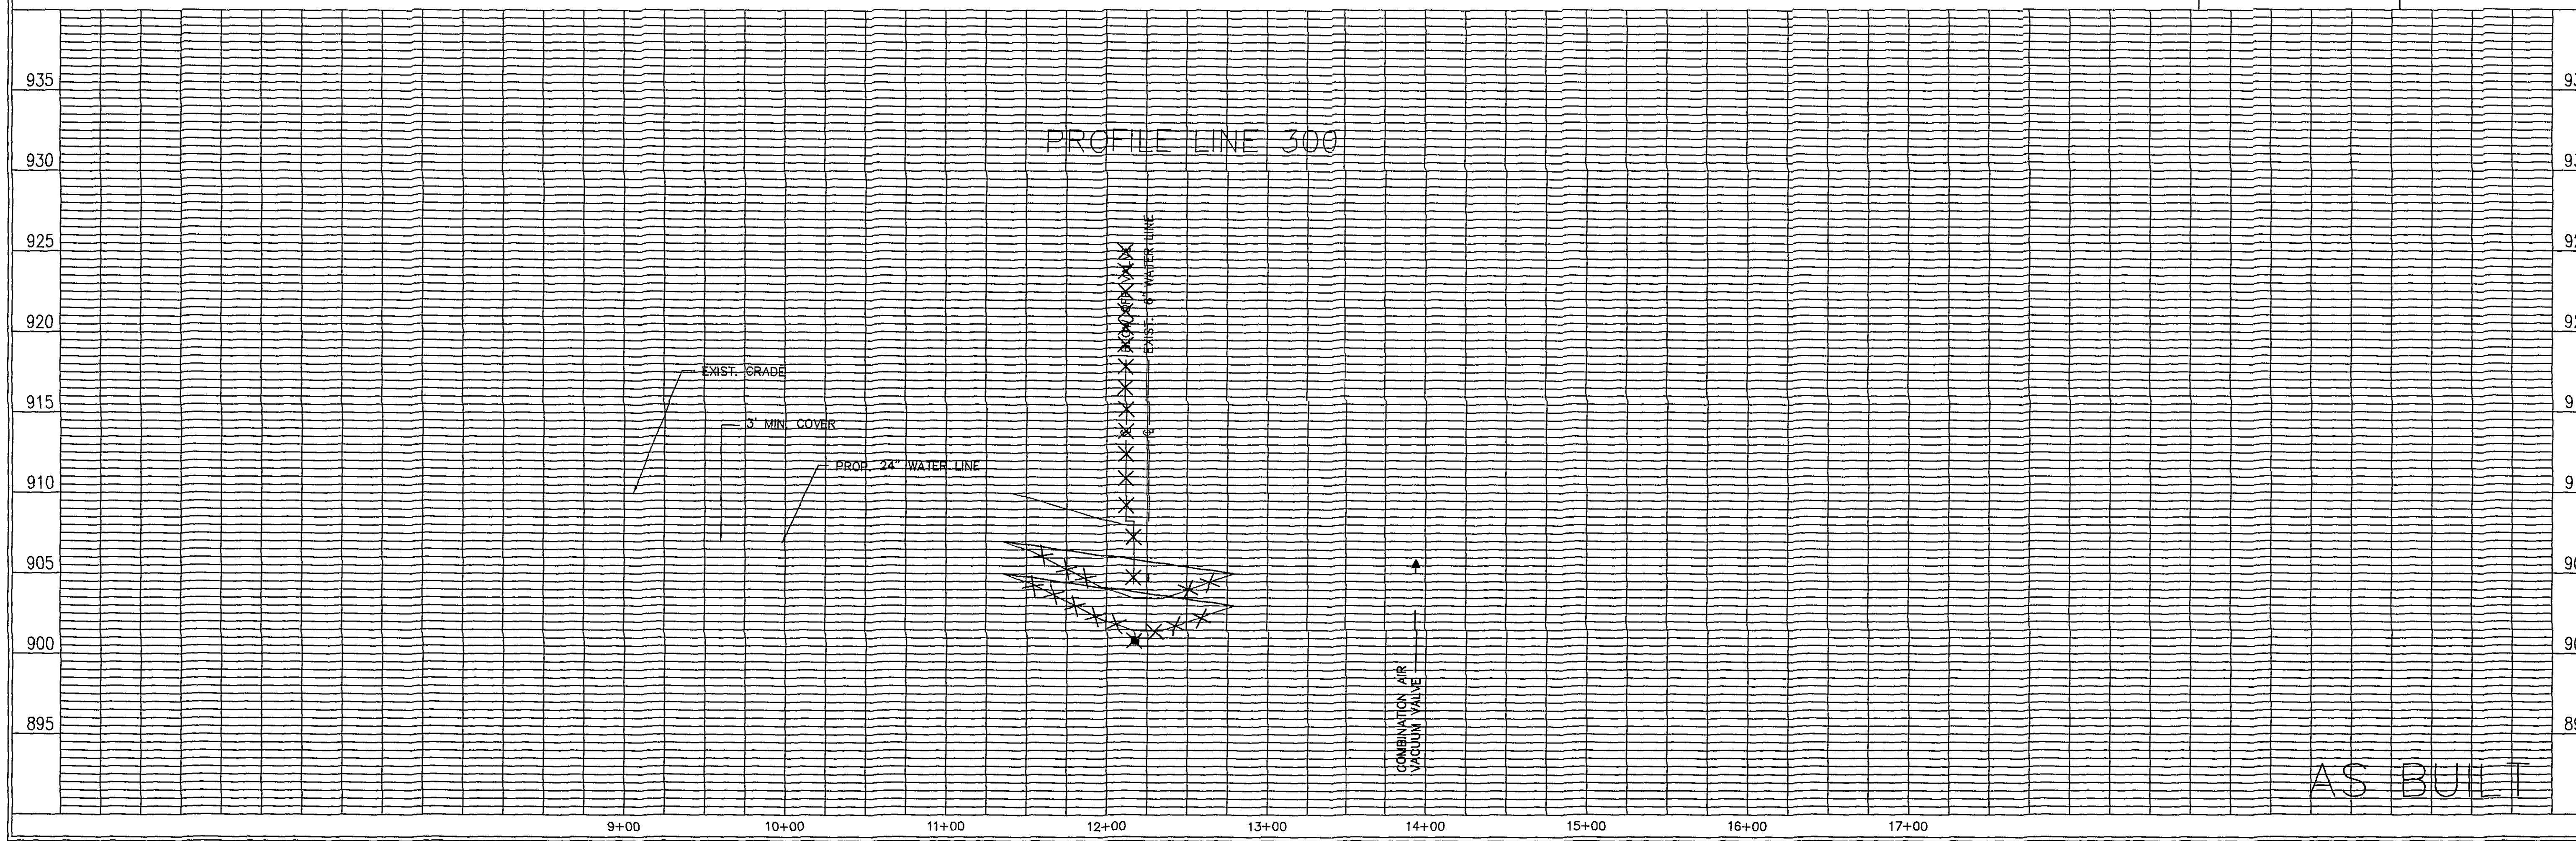

AS BUILT

Architects
Engineers
Planners
Surveyors

Dewberry & Davis

5238 Valleypointe Parkway, Suite One-B
Roanoke, Virginia 24019
703 962-7725

Carvins Cove, Phase II

City of Roanoke
Roanoke, Virginia

CONTRACT "C1"
LINE 300
STA 8+73.19 - 17+18.97

Drawn By REH/ACF
Designed By RBS
Checked By SEH
Date APRIL 93
Scale
V: 1" = 5'
H: 1" = 50'
Plan Number B5A
Zoned NONE
Sheet **2** of 12
File Number C1160