
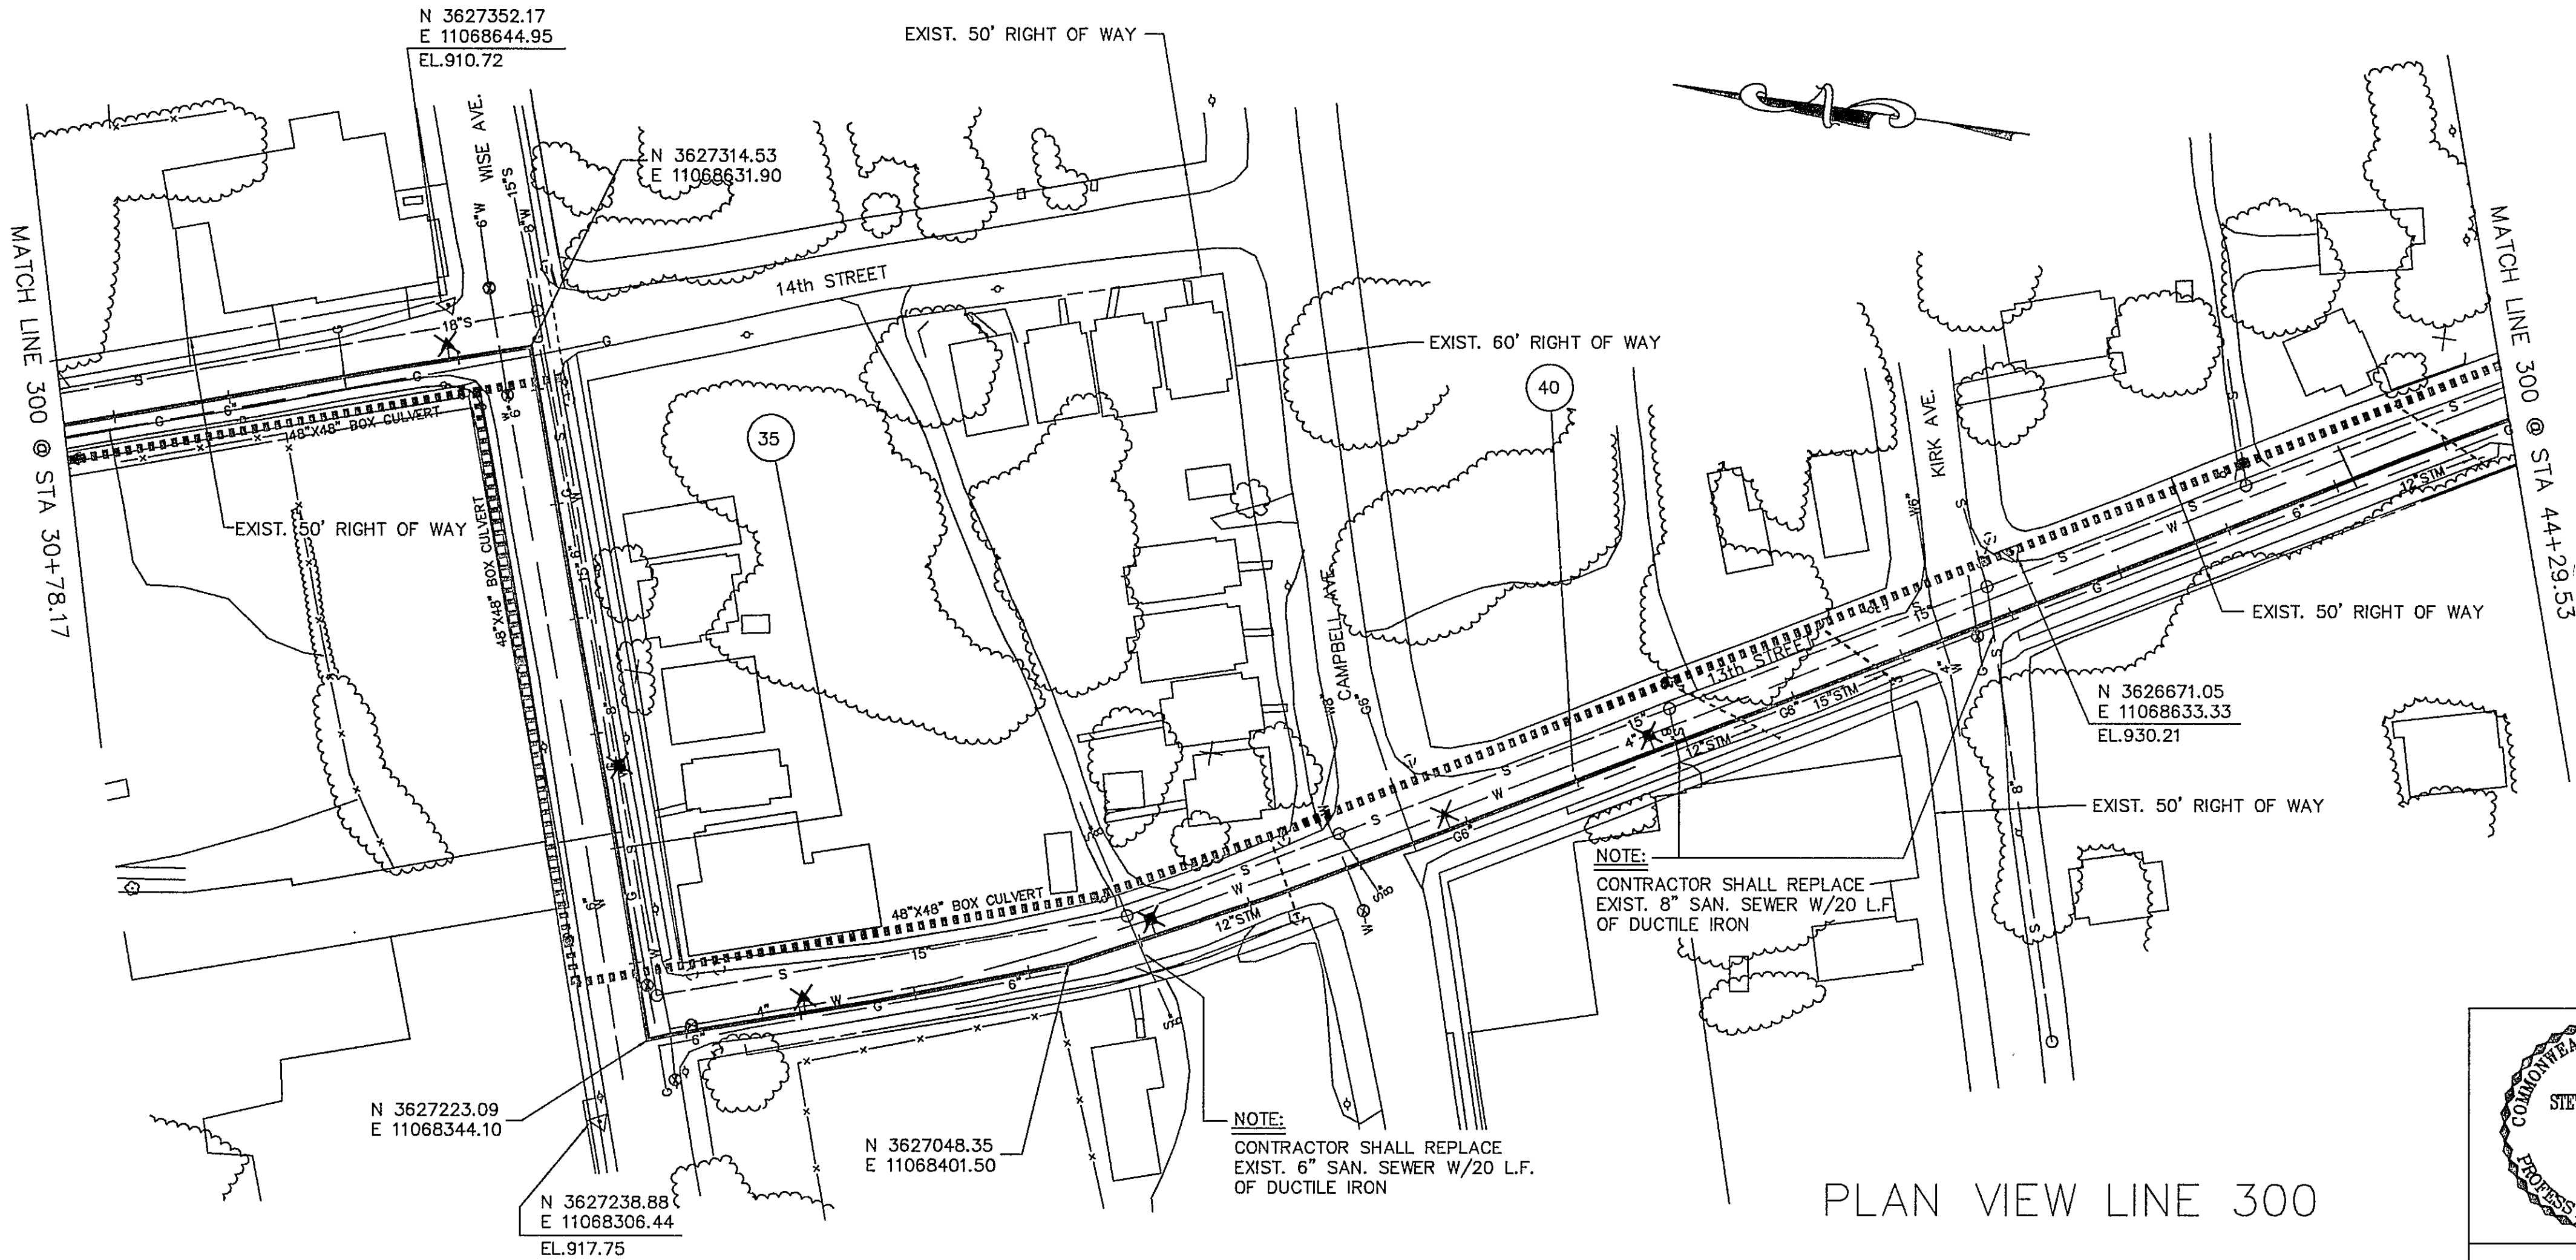
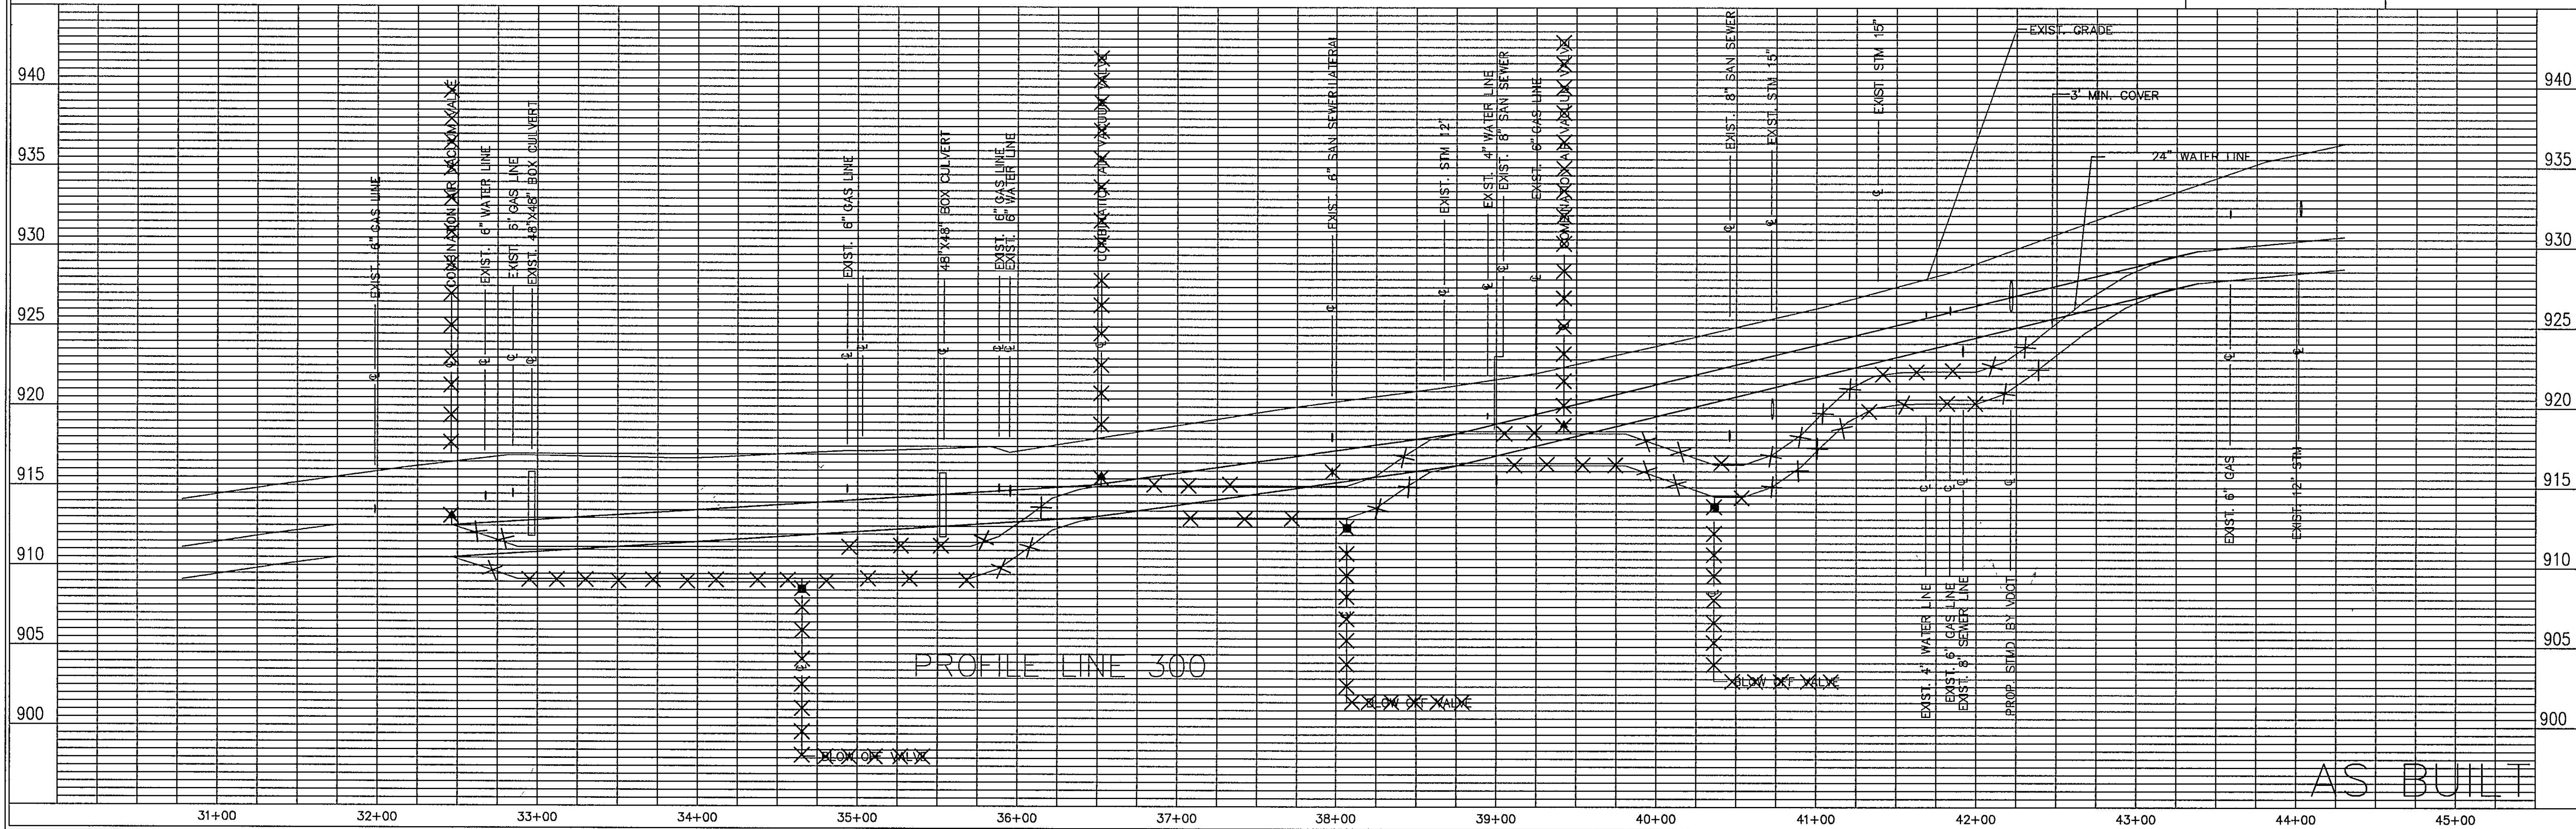
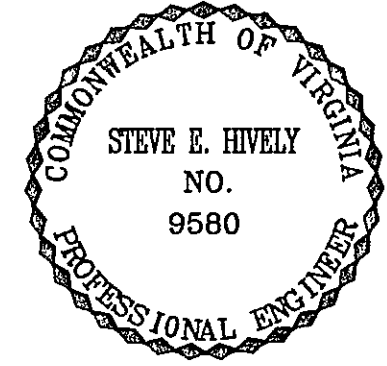
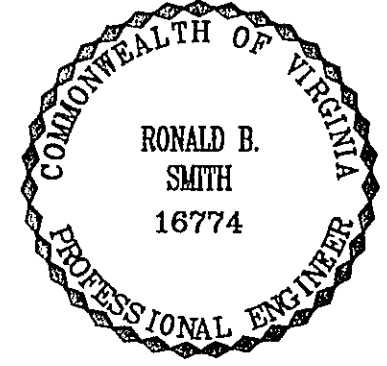


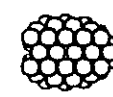

 ENGINEER'S SEAL	 ENGINEER'S SEAL
---	---

THIS SHEET
1352 LF 24" WATERMAIN

 Dewberry & Davis Architects Engineers Planners Surveyors 5238 Valleypointe Parkway, Suite One-B Roanoke, Virginia 24019 703 362-7725	Carvins Cove, Phase II City of Roanoke Roanoke, Virginia	CONTRACT "C1" LINE 300 STA 30+78.17 - 44+29.53
	Drawn By REH/ACF Designed By RBS Checked By SEH Date APRIL 93 Scale V: 1" = 5' H: 1" = 50' Plan Number B7 Zoned NONE Sheet 4 of 12 File Number C1160	