

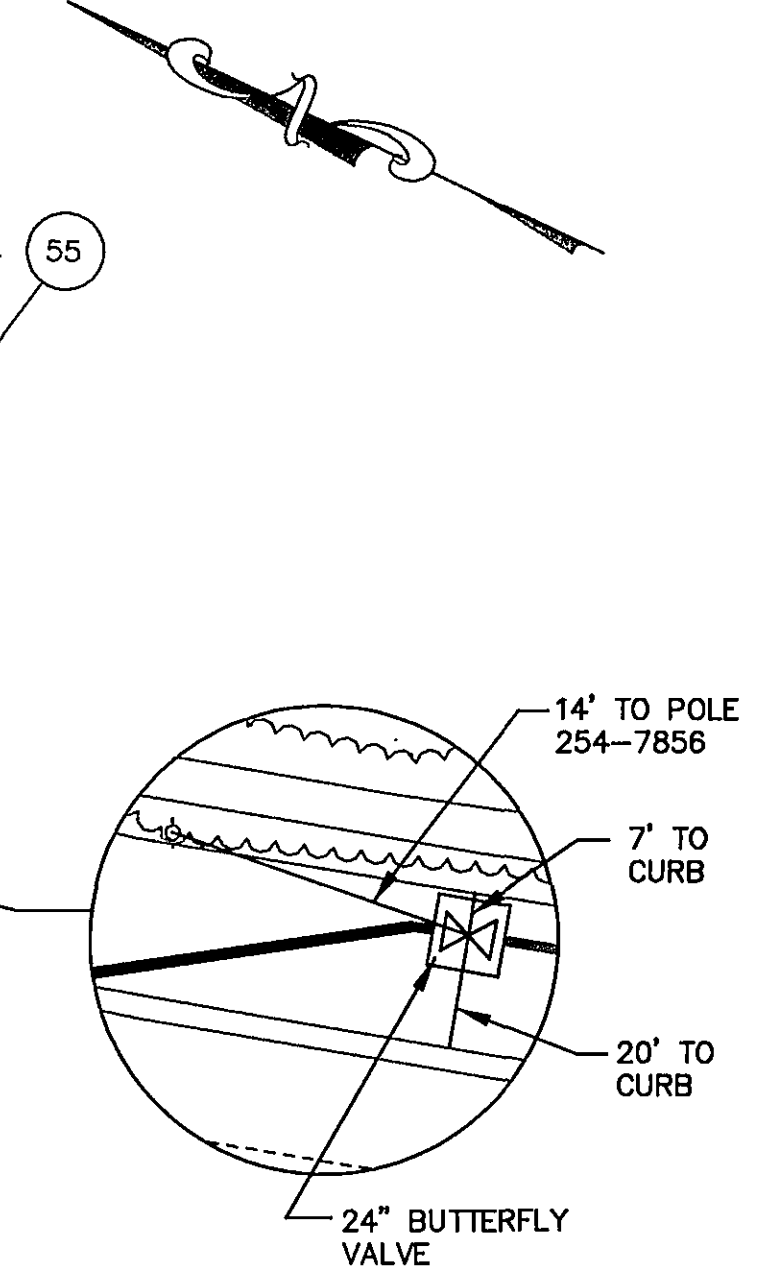
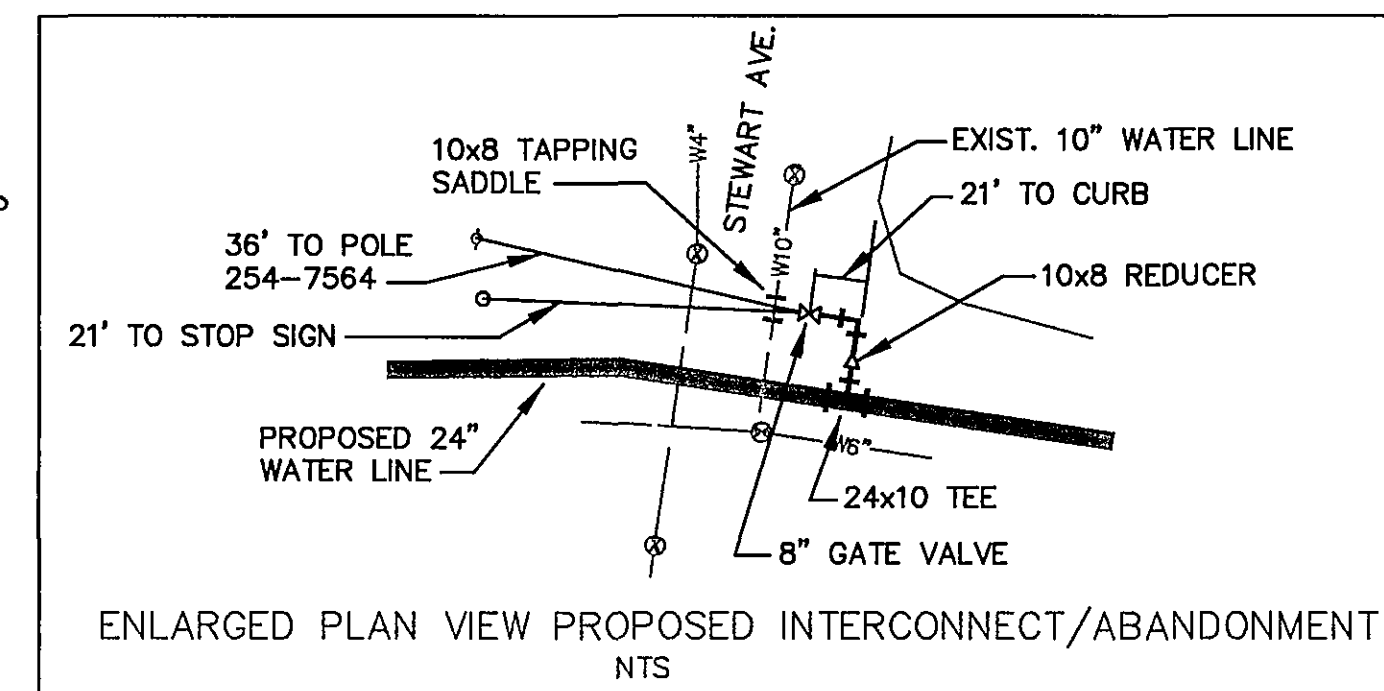
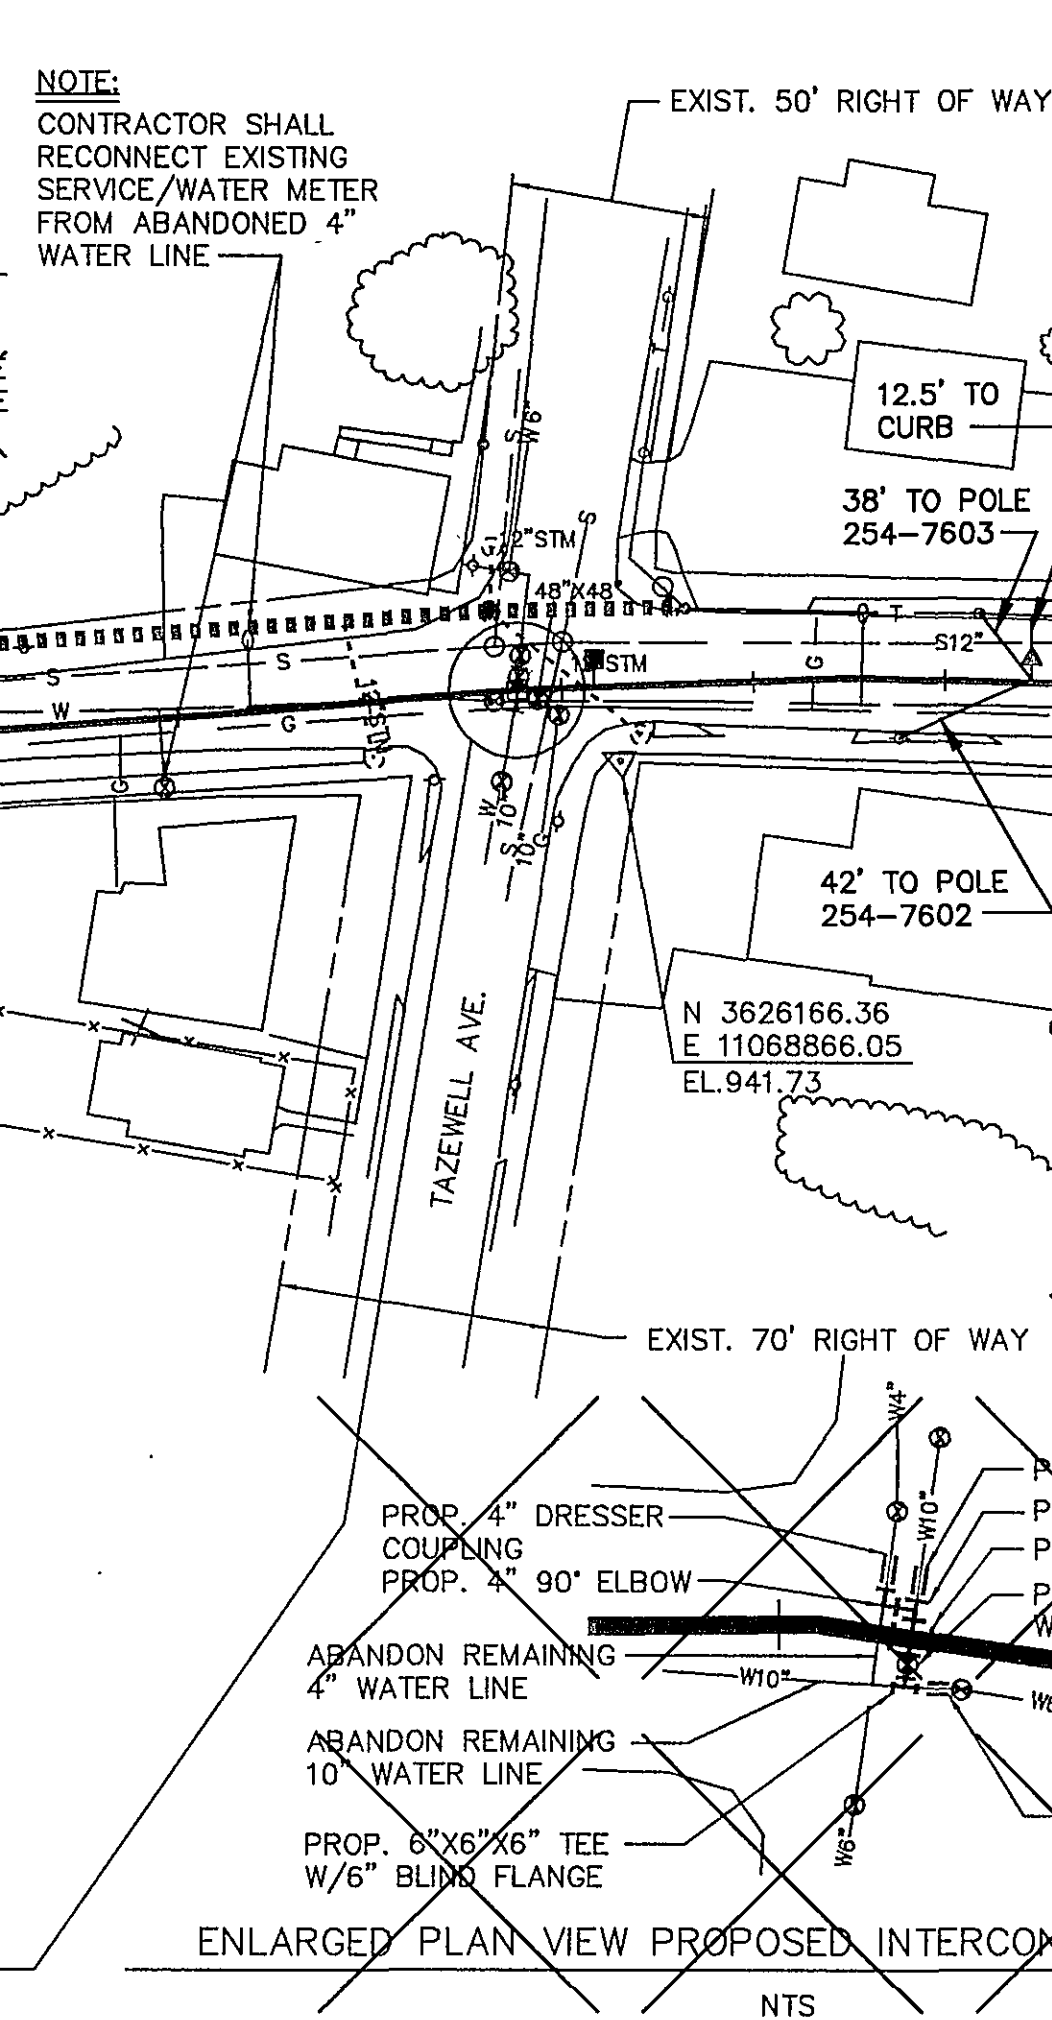
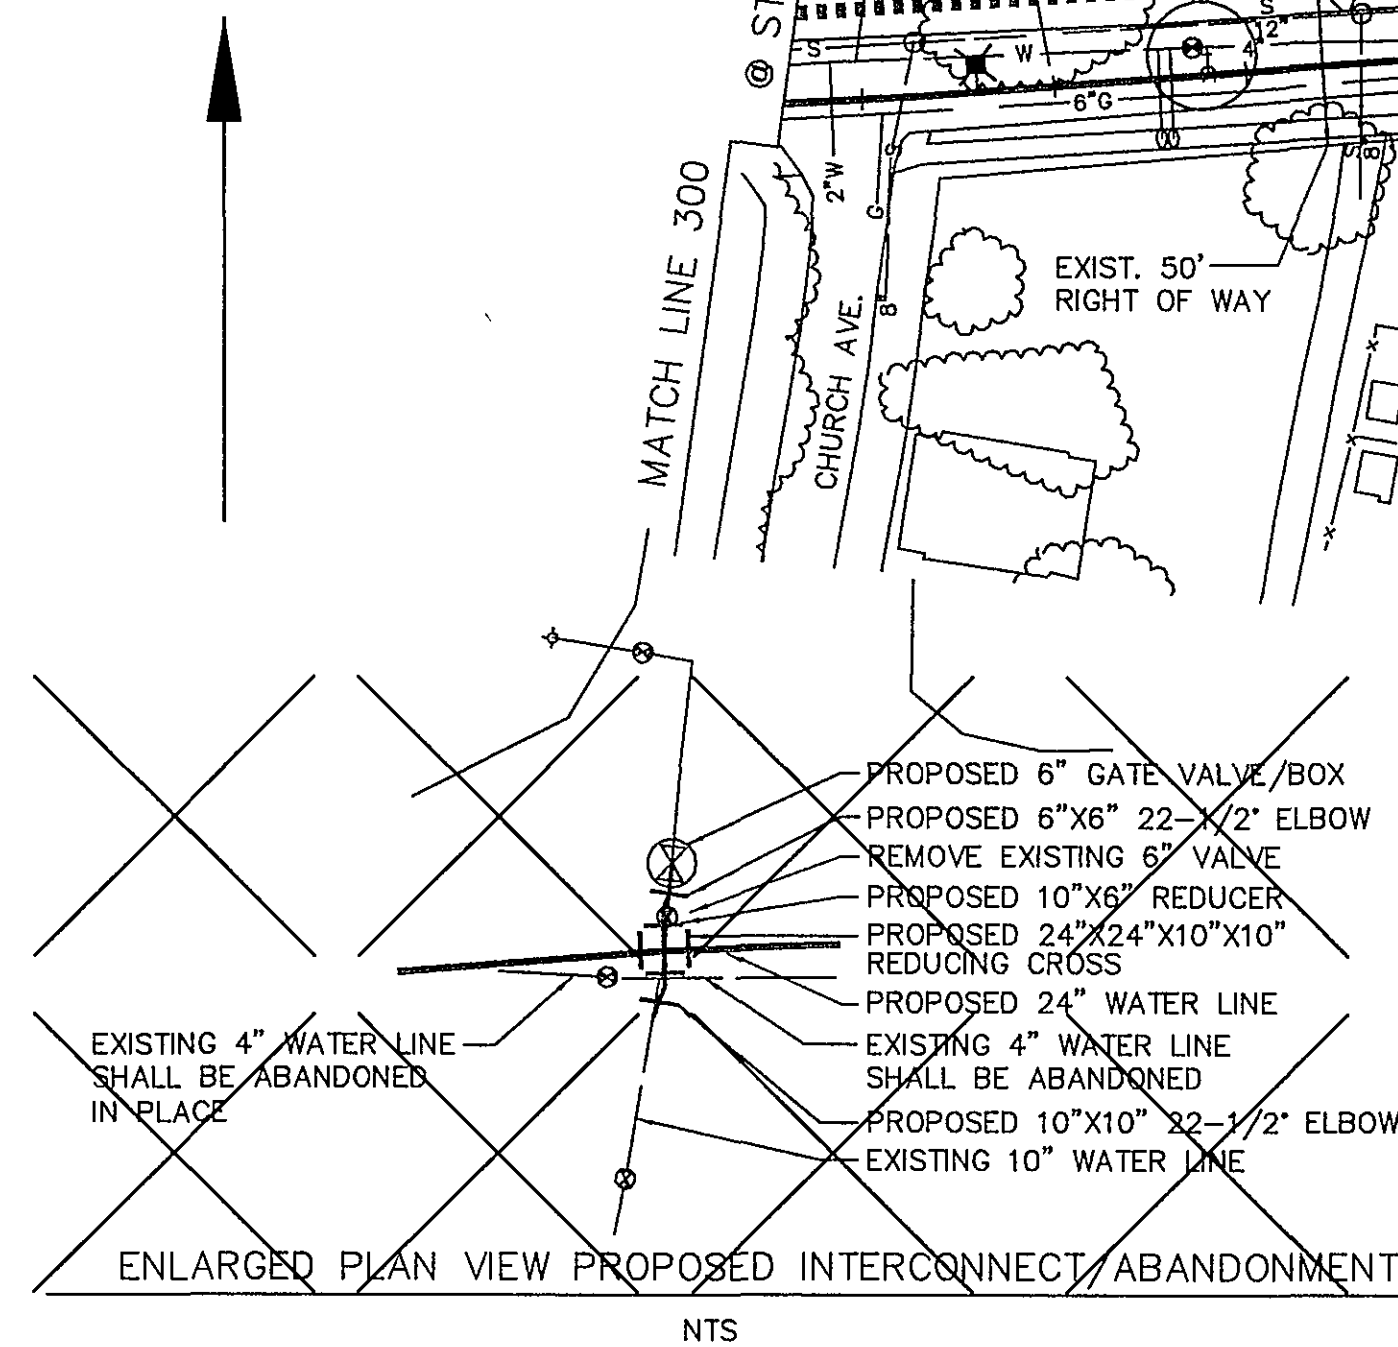
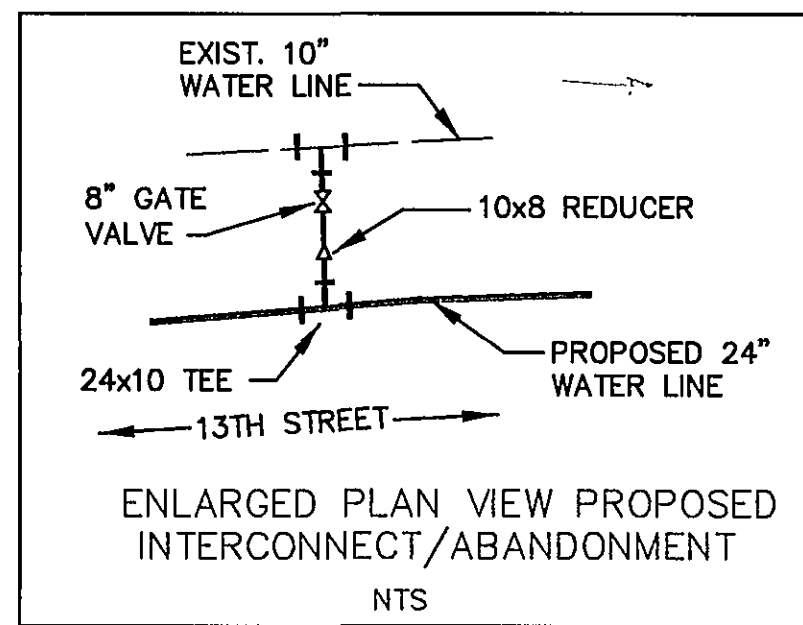


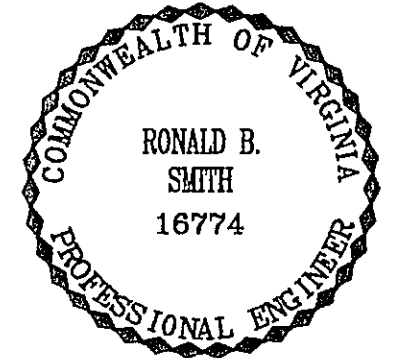


THIS SHEET
1122 LF 24" WATERMAIN
1 EA. 4" A.R.V.
1 EA. 24" BUTTERFLY VALVE
2 EA. 8" TAPPING VALVE

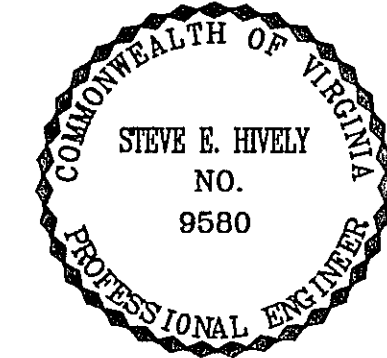

ENGINEER'S SEAL

ENGINEER'S SEAL

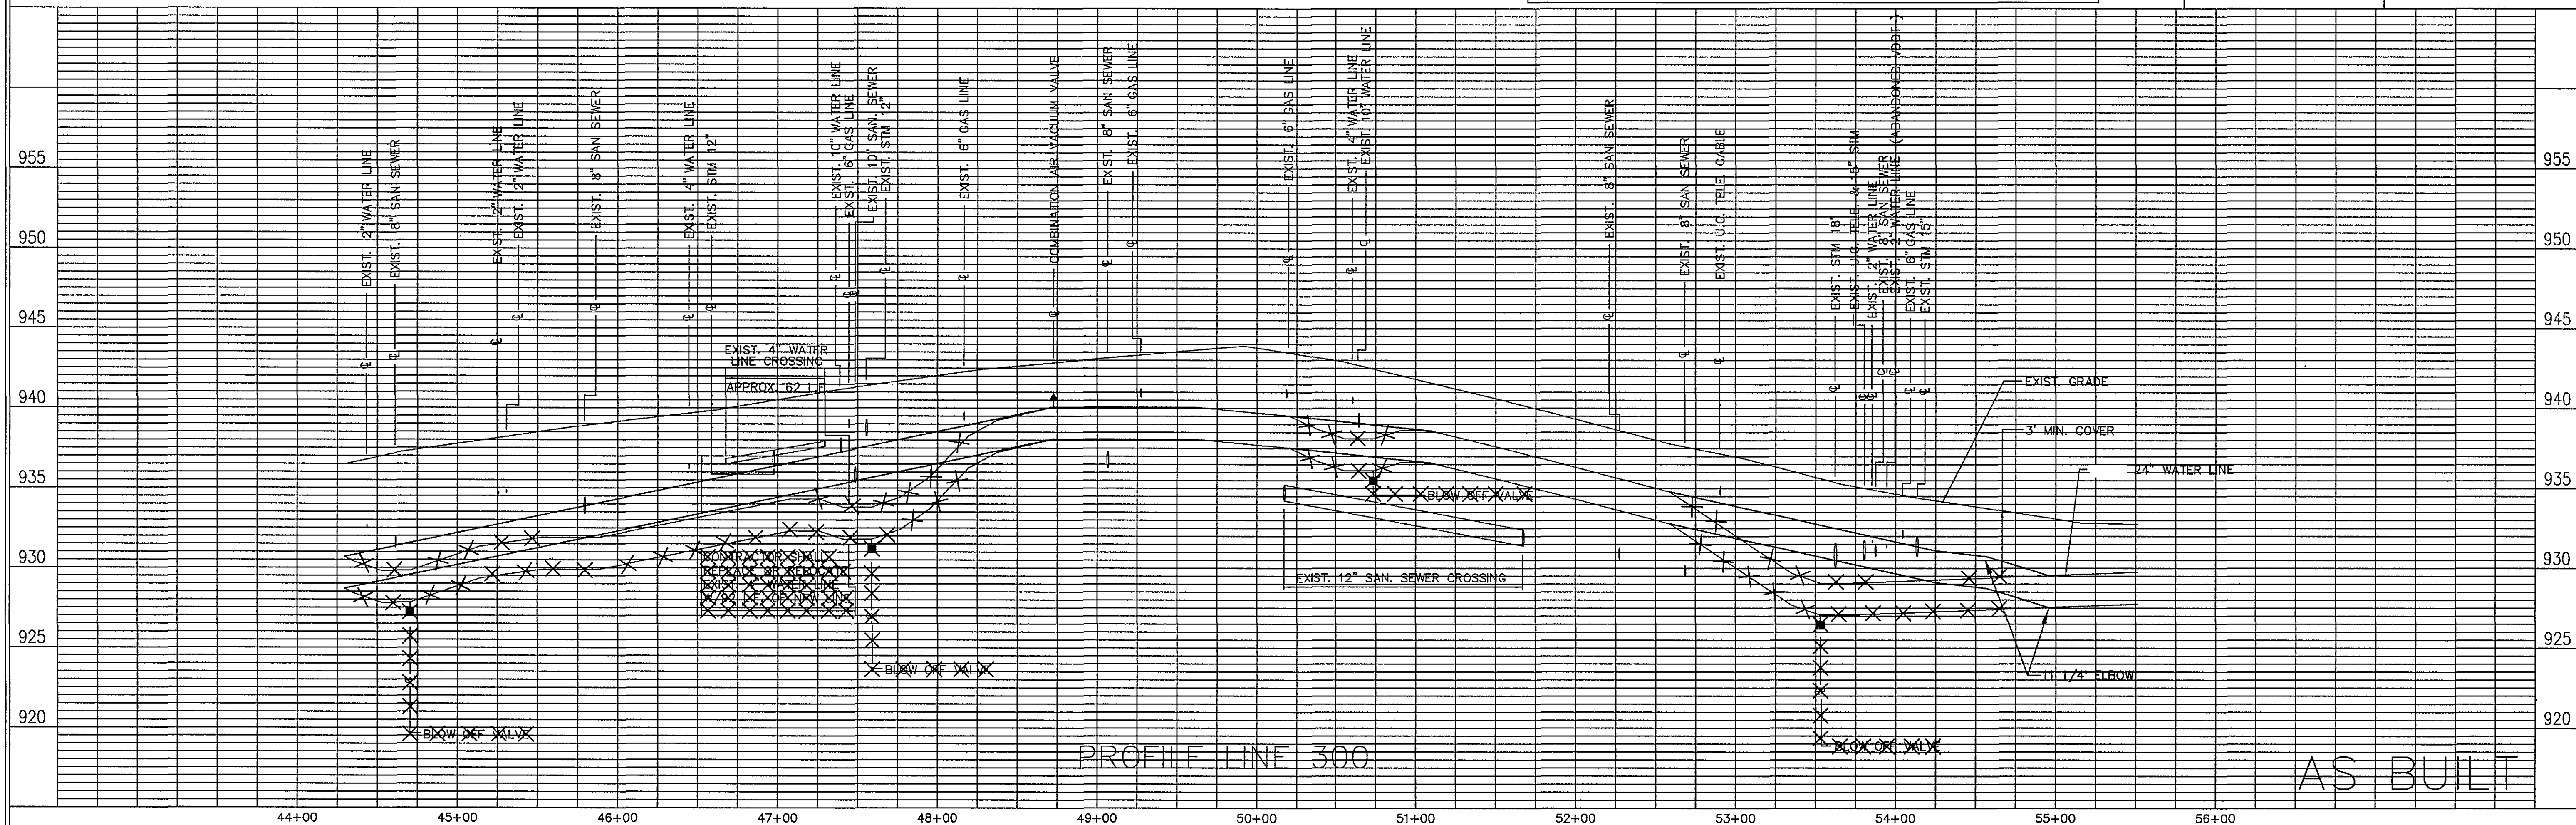

PLAN VIEW LINE 300

Architects
Engineers
Planners
Surveyors

Dewberry & Davis

5238 Valleypointe Parkway, Suite One-B
Roanoke, Virginia 24019
703 362-7725

Carvins Cove, Phase II
City of Roanoke
Roanoke, Virginia

CONTRACT "C1"
LINE 300
STA 44+29.53 - 55+51.20

Drawn By REH/ACF
Designed By RBS
Checked By SEH
Date APRIL 93
Scale V: 1" = 5'
H: 1" = 50'
Plan Number BB
Zoned NONE
Sheet 5 of 12
File Number C1160