



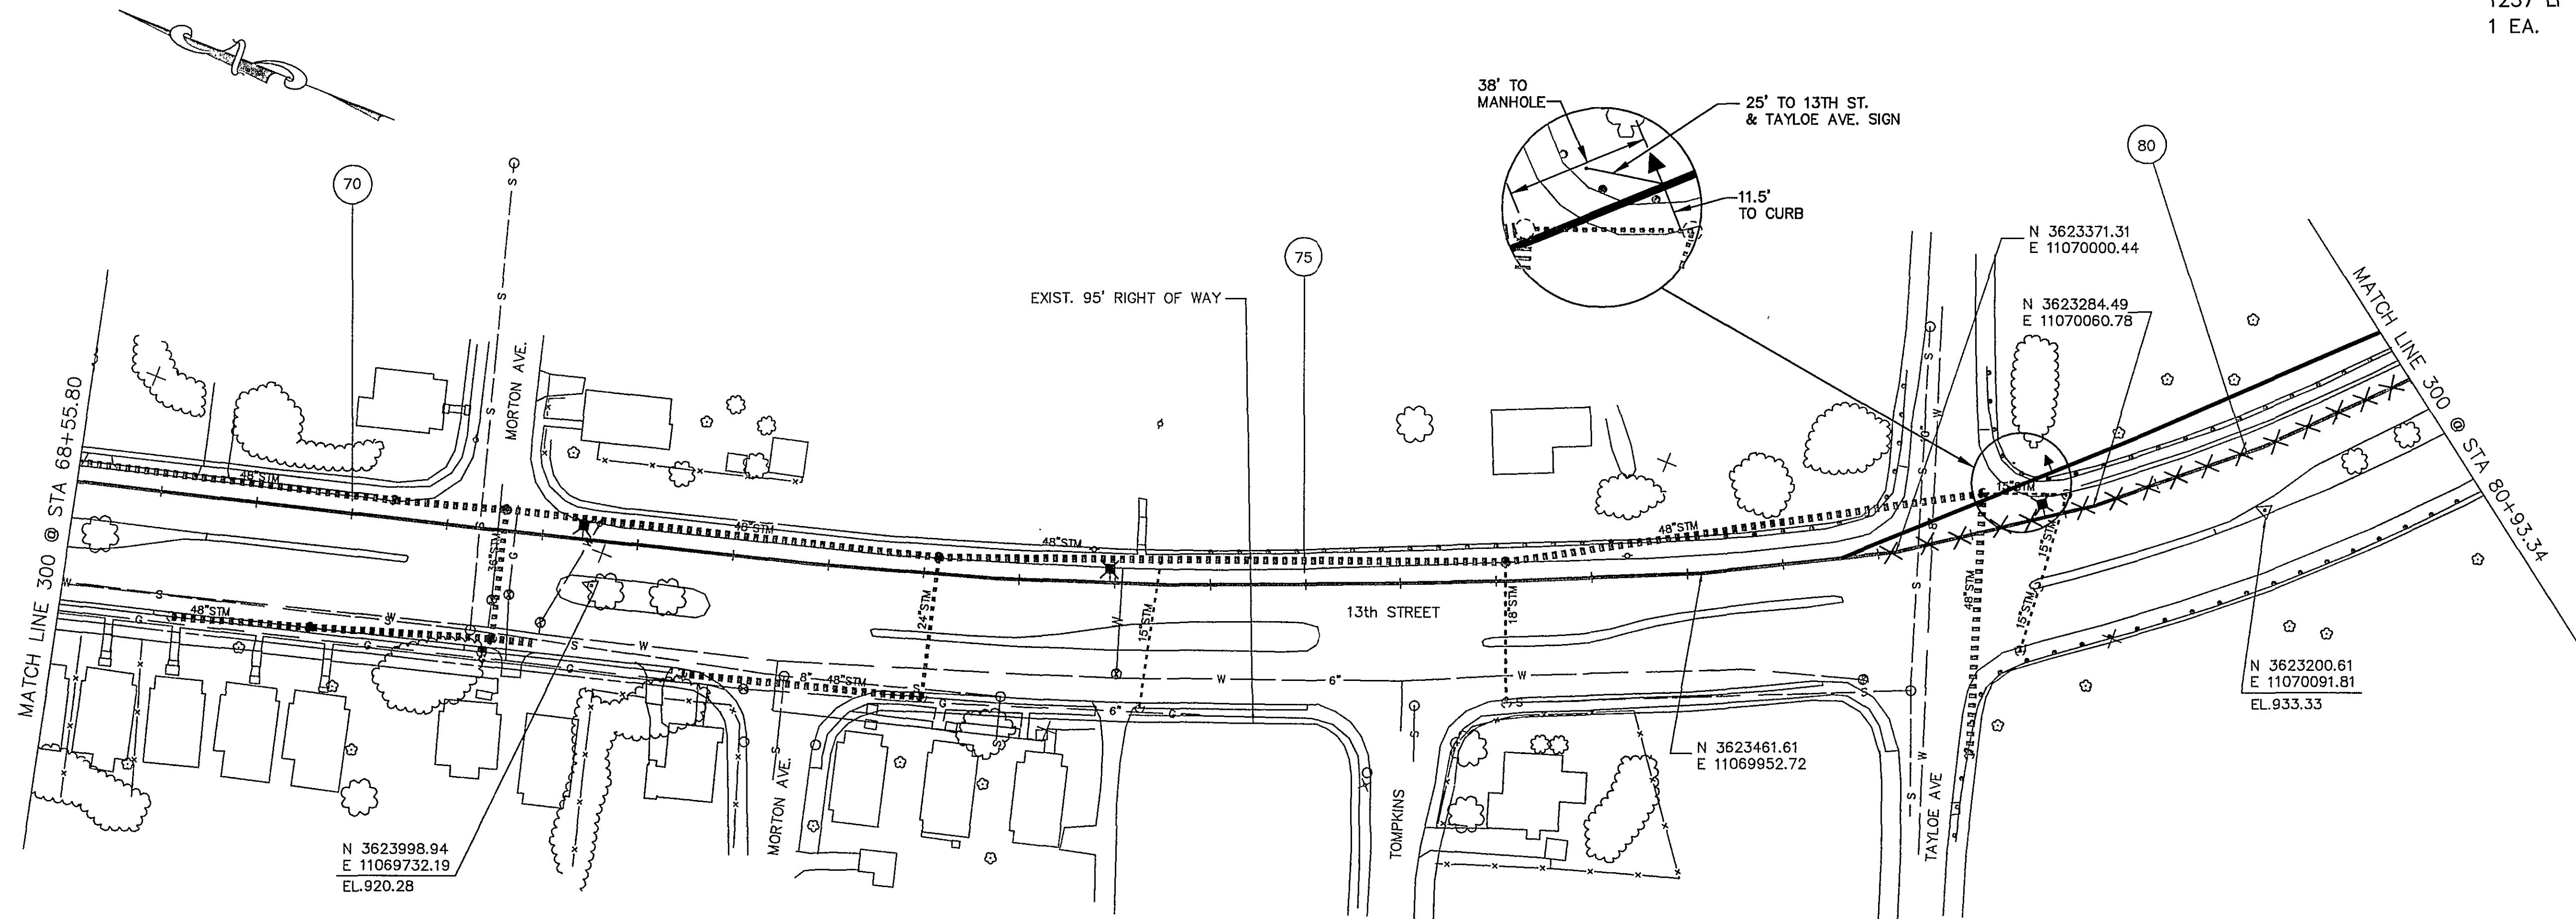

PLAN VIEW LINE 300

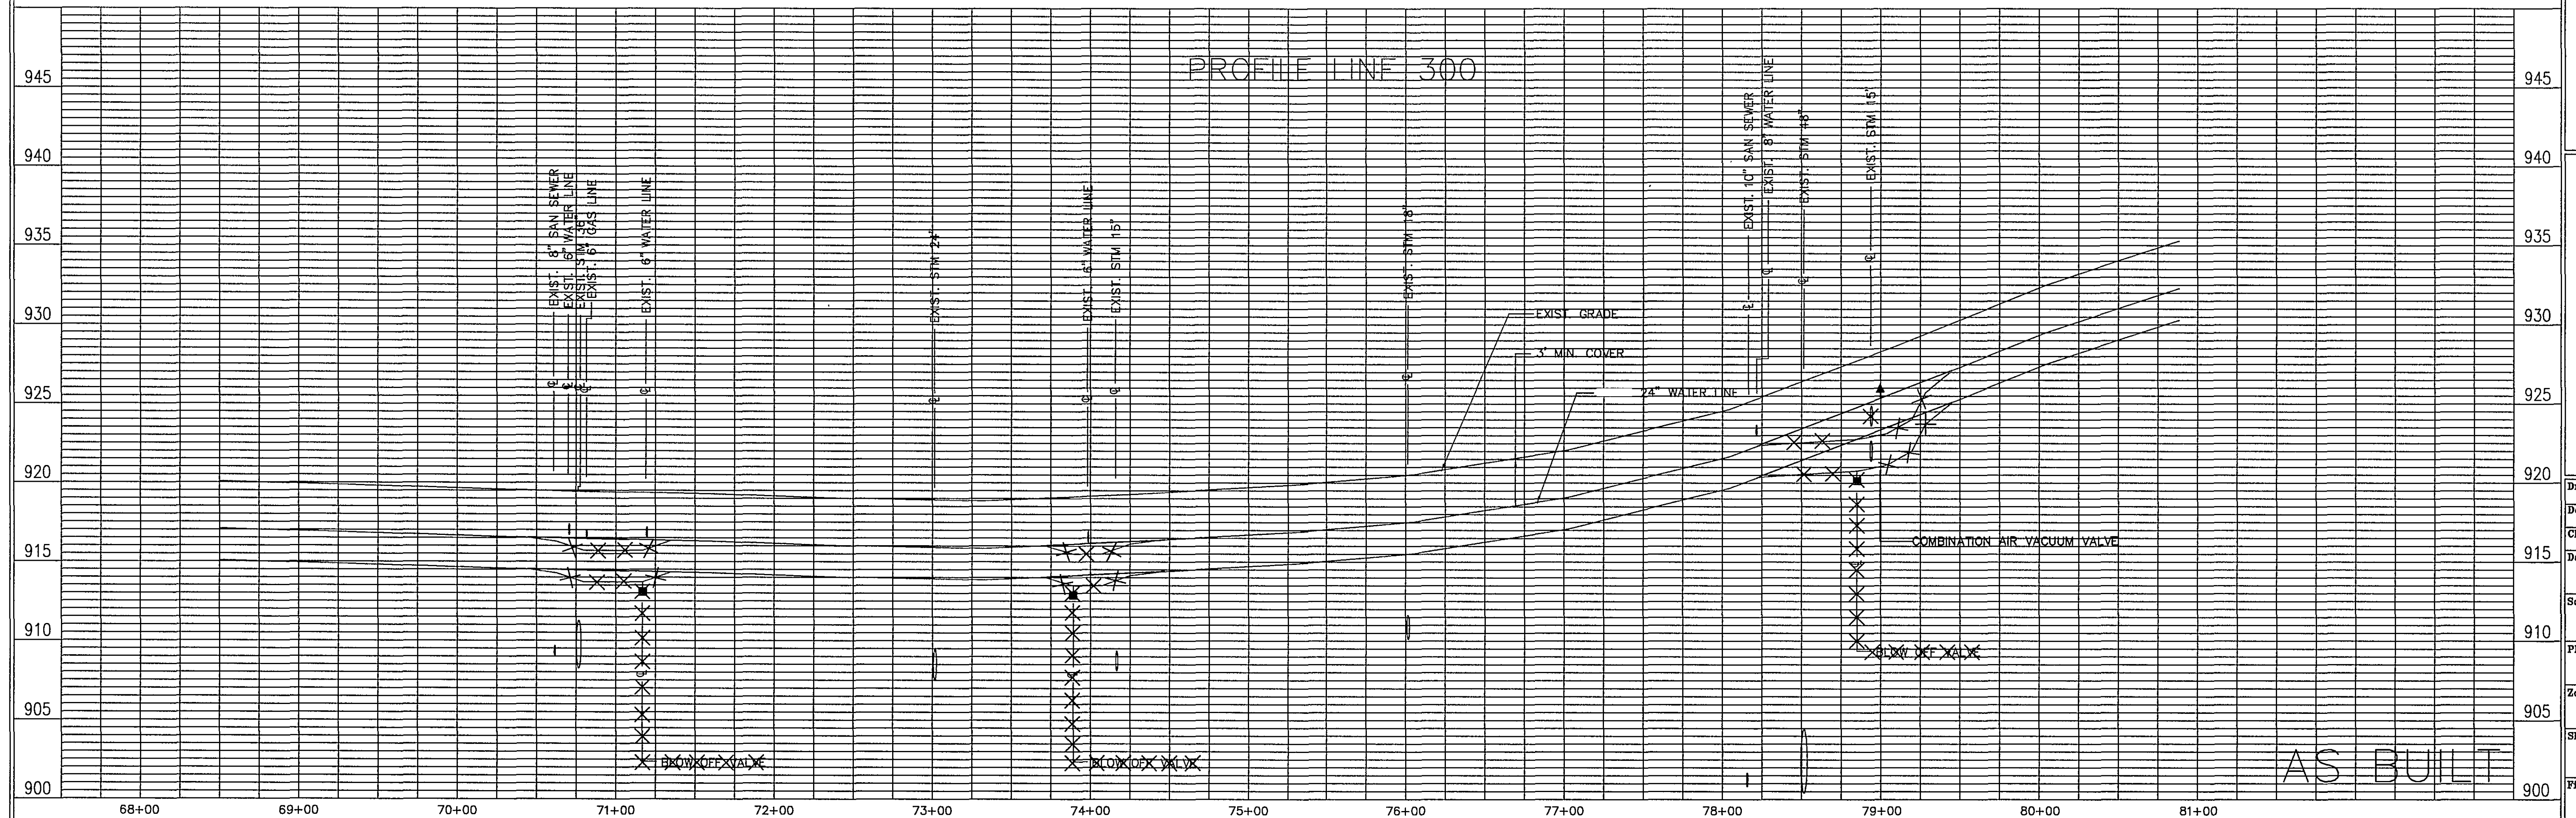

AS BUILT

THIS SHEET
1237 LF 24" WATERMAIN
1 EA. 4" A.R.V.

Architects
Engineers
Planners
Surveyors

Dewberry & Davis
5238 Valleypointe Parkway, Suite One-B
Roanoke, Virginia 24019
703 362-7725

Carvins Cove, Phase II
City of Roanoke
Roanoke, Virginia

CONTRACT "C1"
LINE 300
STA 68+55.80 - 80+93.34

Drawn By ACF/REH
Designed By RBS
Checked By SEH
Date APRIL 93
Scale
V: 1" = 5'
H: 1" = 50'
Plan Number D2
Zoned NONE
Sheet 7 of 12
File Number C1160