
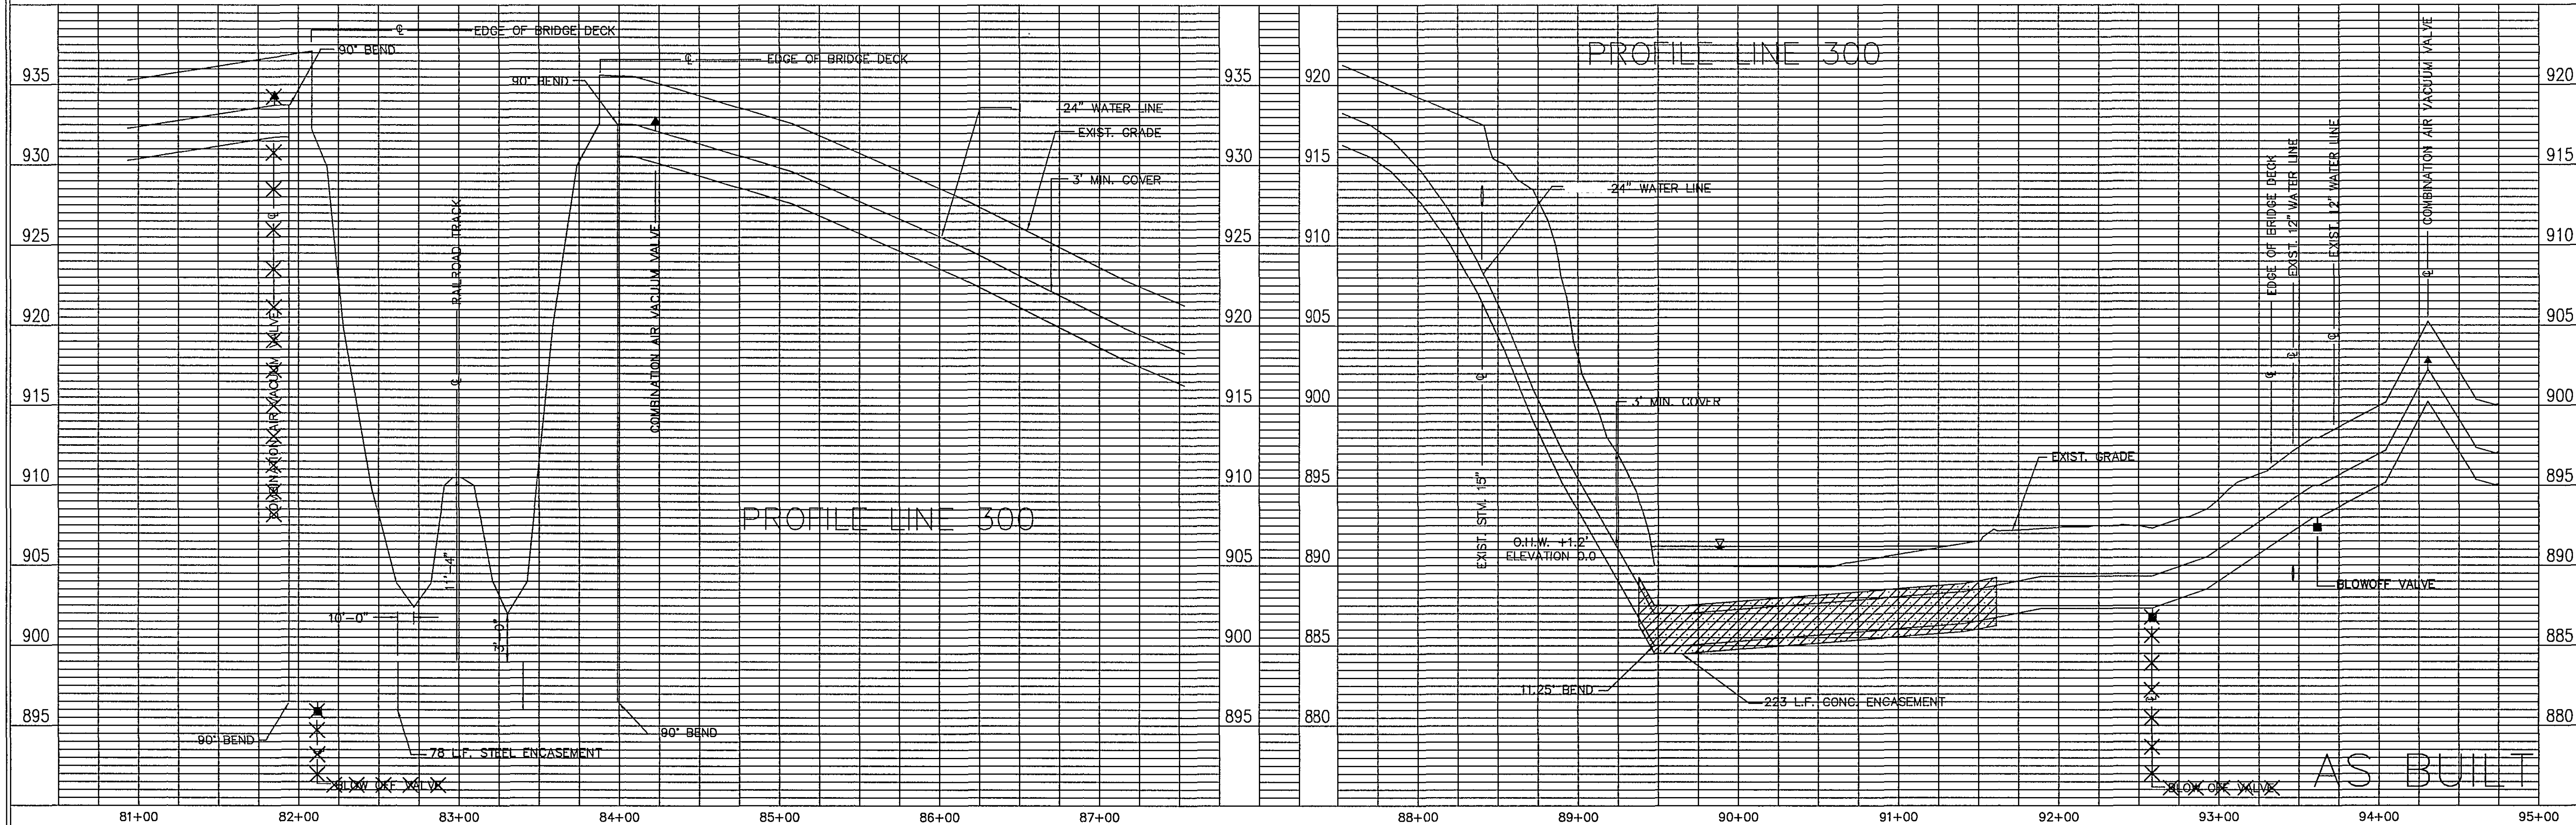


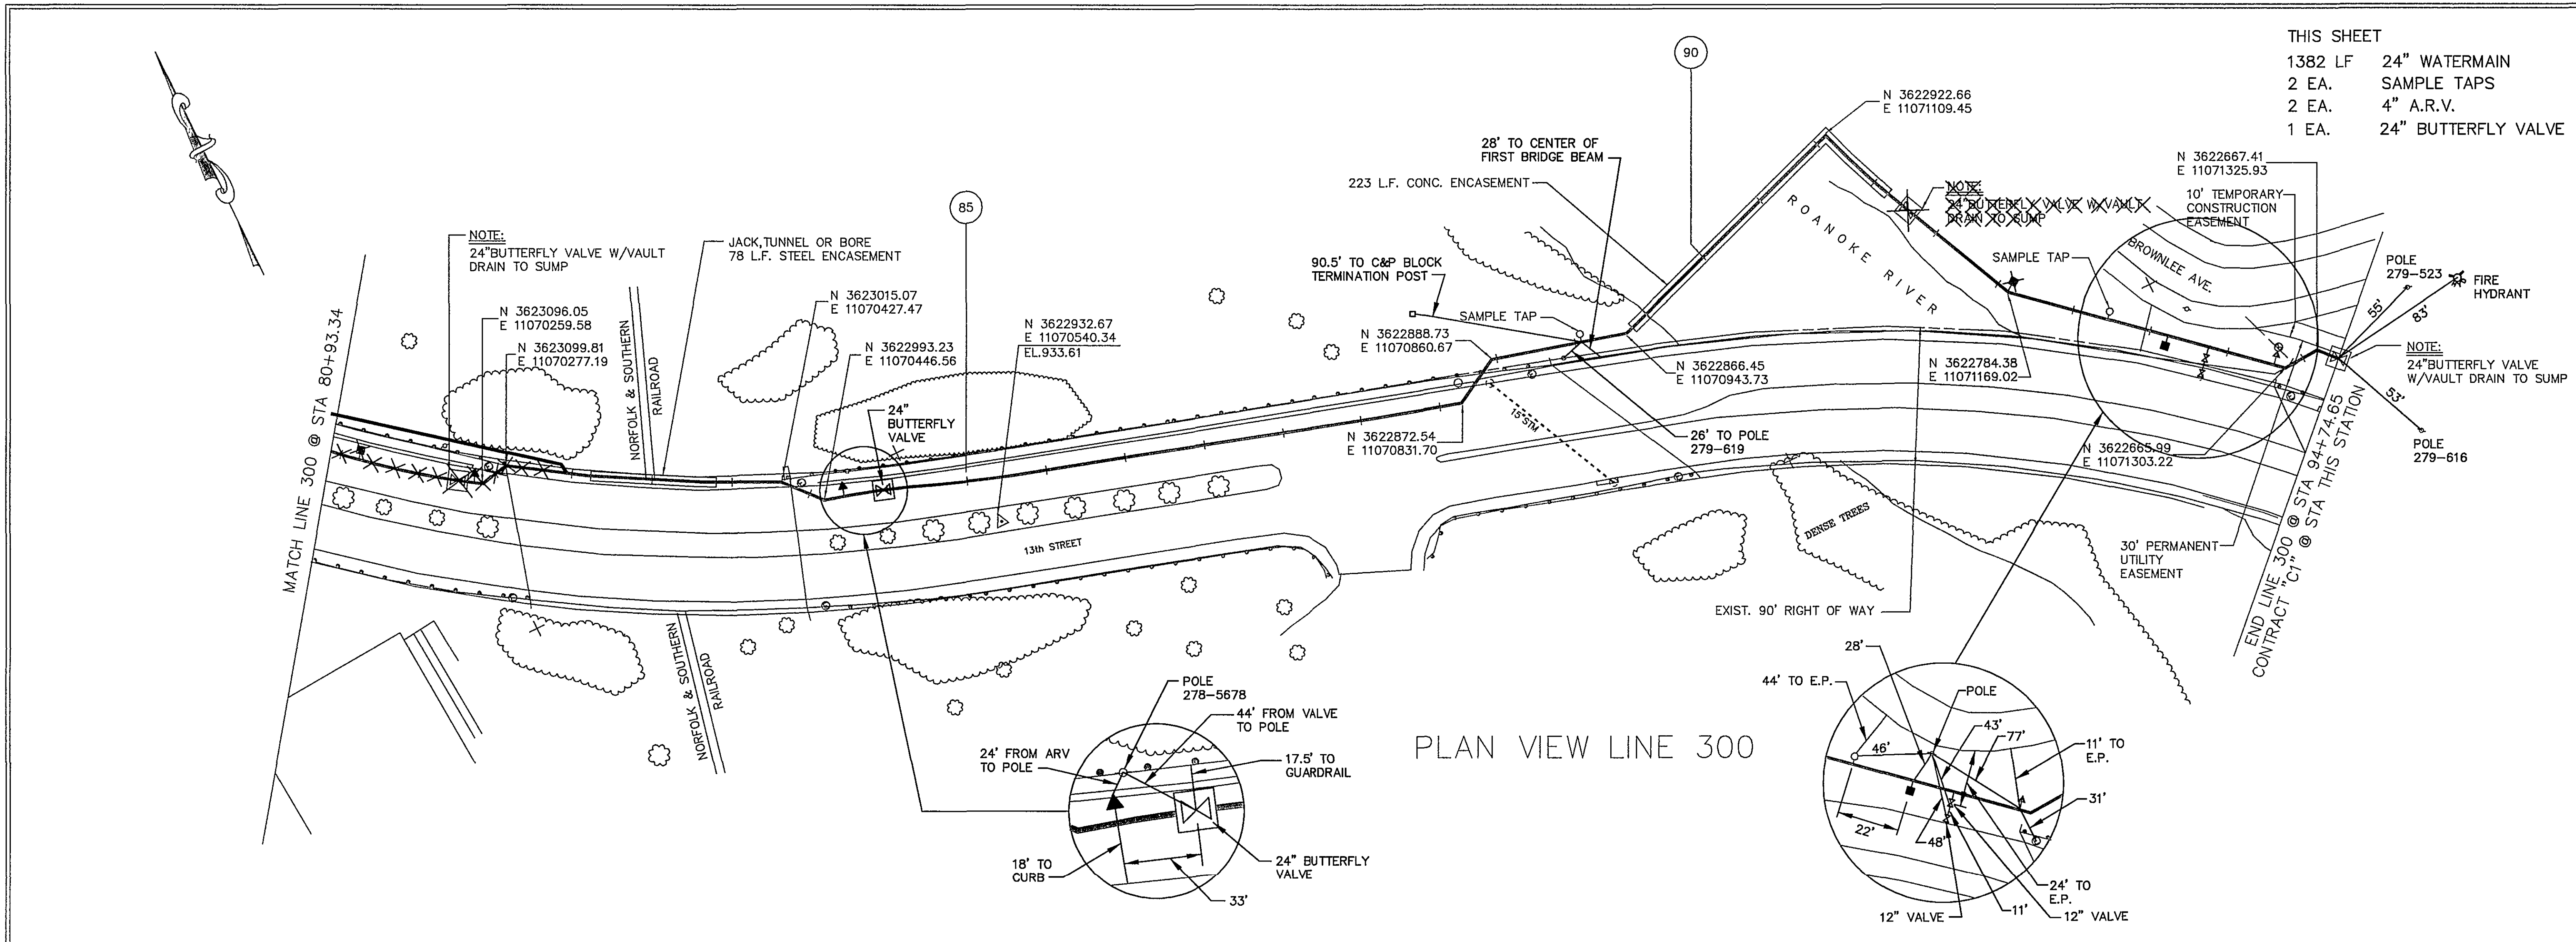

THIS SHEET
1382 LF 24" WATERMAIN
2 EA. SAMPLE TAPS
2 EA. 4" A.R.V.
1 EA. 24" BUTTERFLY VALVE

Architects
Engineers
Planners
Surveyors

Dewberry & Davis

5238 Valleypointe Parkway, Suite One-B
Roanoke, Virginia 24019
703 382-7725

Carvins Cove, Phase II
City of Roanoke
Roanoke, Virginia

CONTRACT "C1"
END LINE 300
STA 80+93.34 - 94+74.65

Drawn By ACF/REH
Designed By RBS
Checked By SEH
Date APRIL 93
Scale V: 1" = 5'
H: 1" = 50'
Plan Number D3
Zoned NONE
Sheet 8 of 12
File Number C1160