

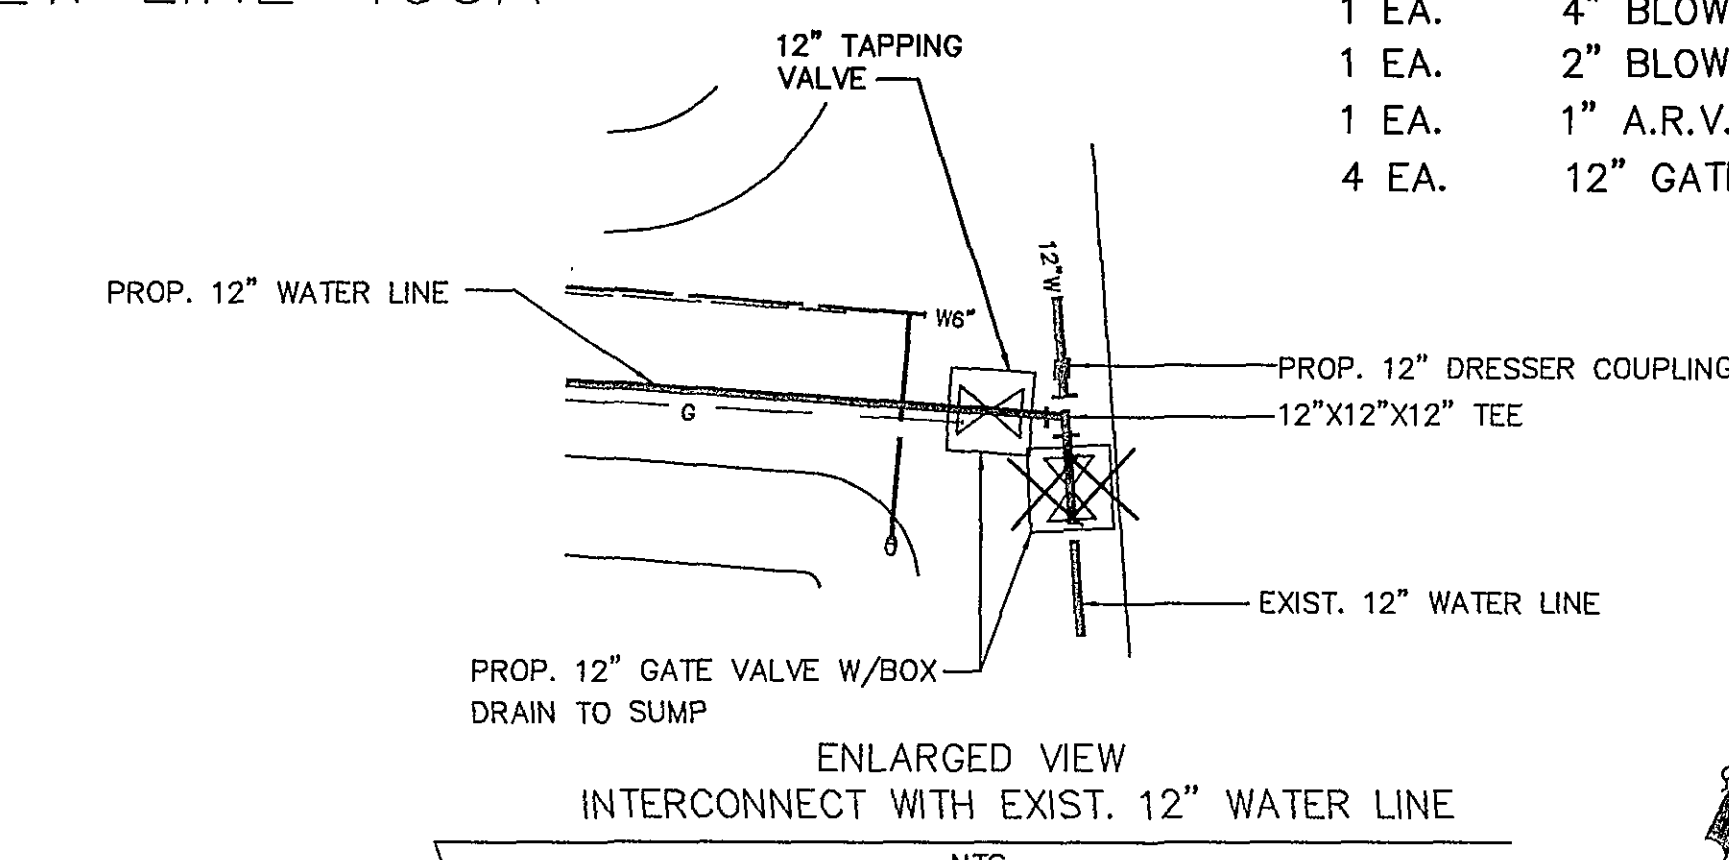



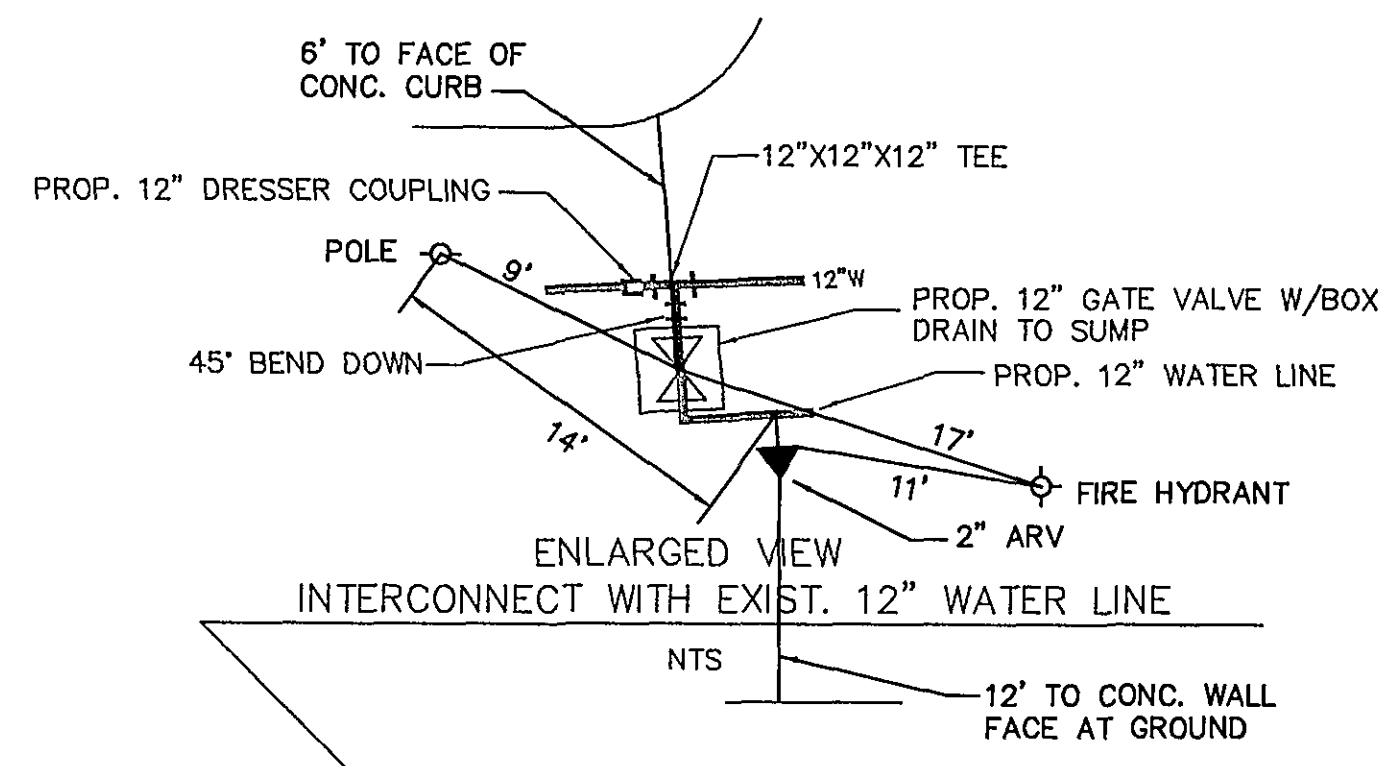


THIS SHEET
 948 LF 12" WATERMAIN
 1 EA. 4" BLOWOFF
 1 EA. 2" BLOWOFF
 1 EA. 1" A.R.V.
 4 EA. 12" GATE VALVE

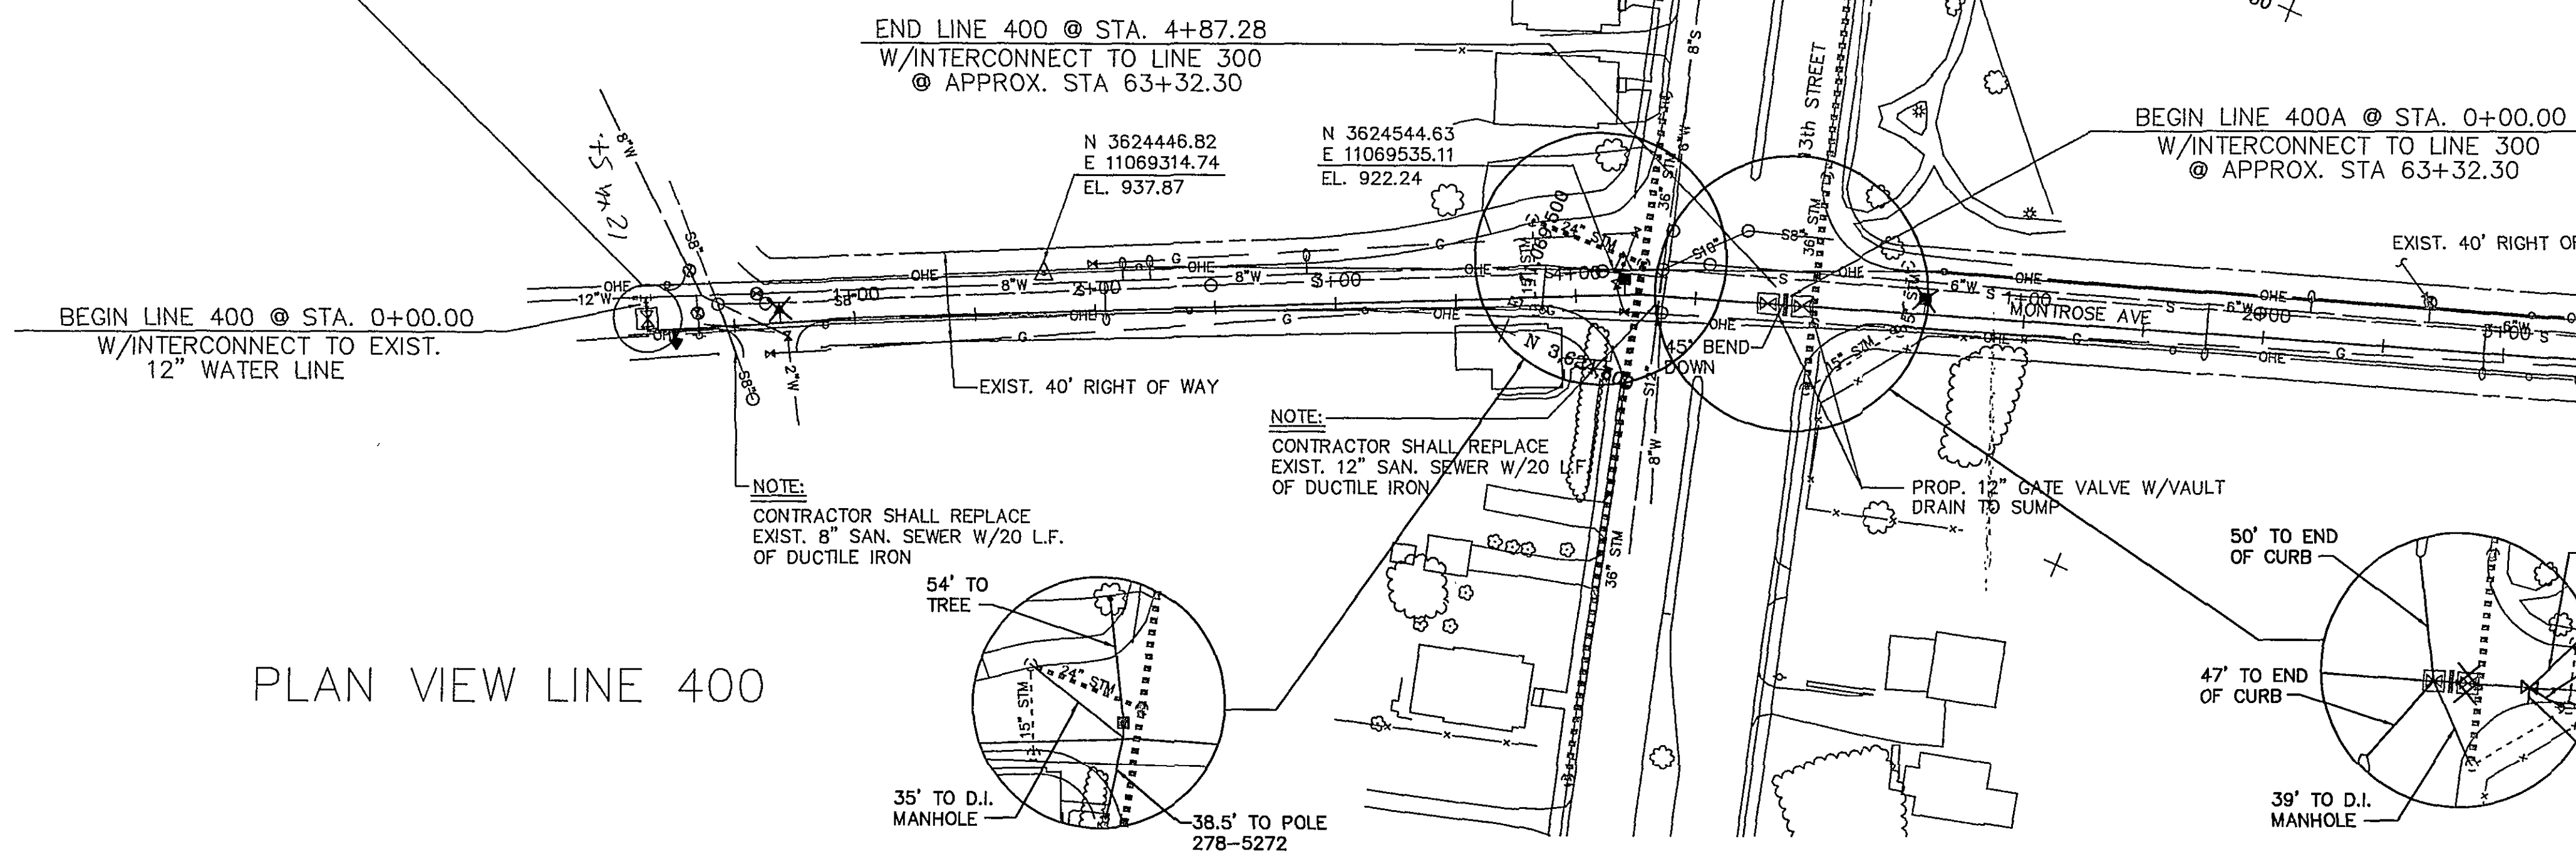


PLAN VIEW LINE 400

PLAN VIEW LINE 400A

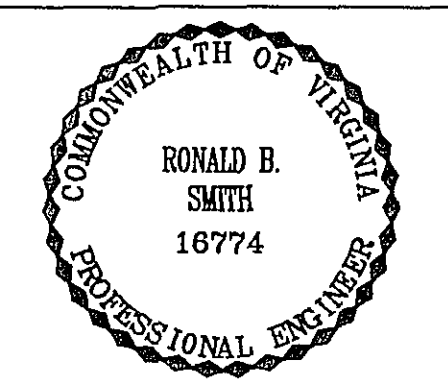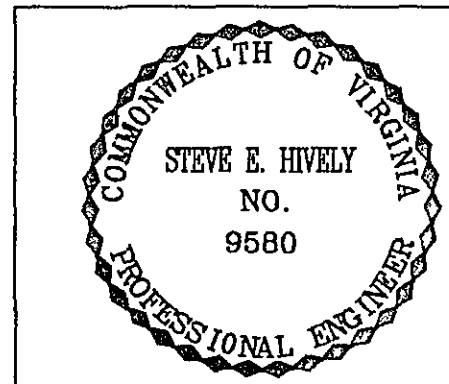


ENGINEER'S SEAL

ENGINEER'S SEAL

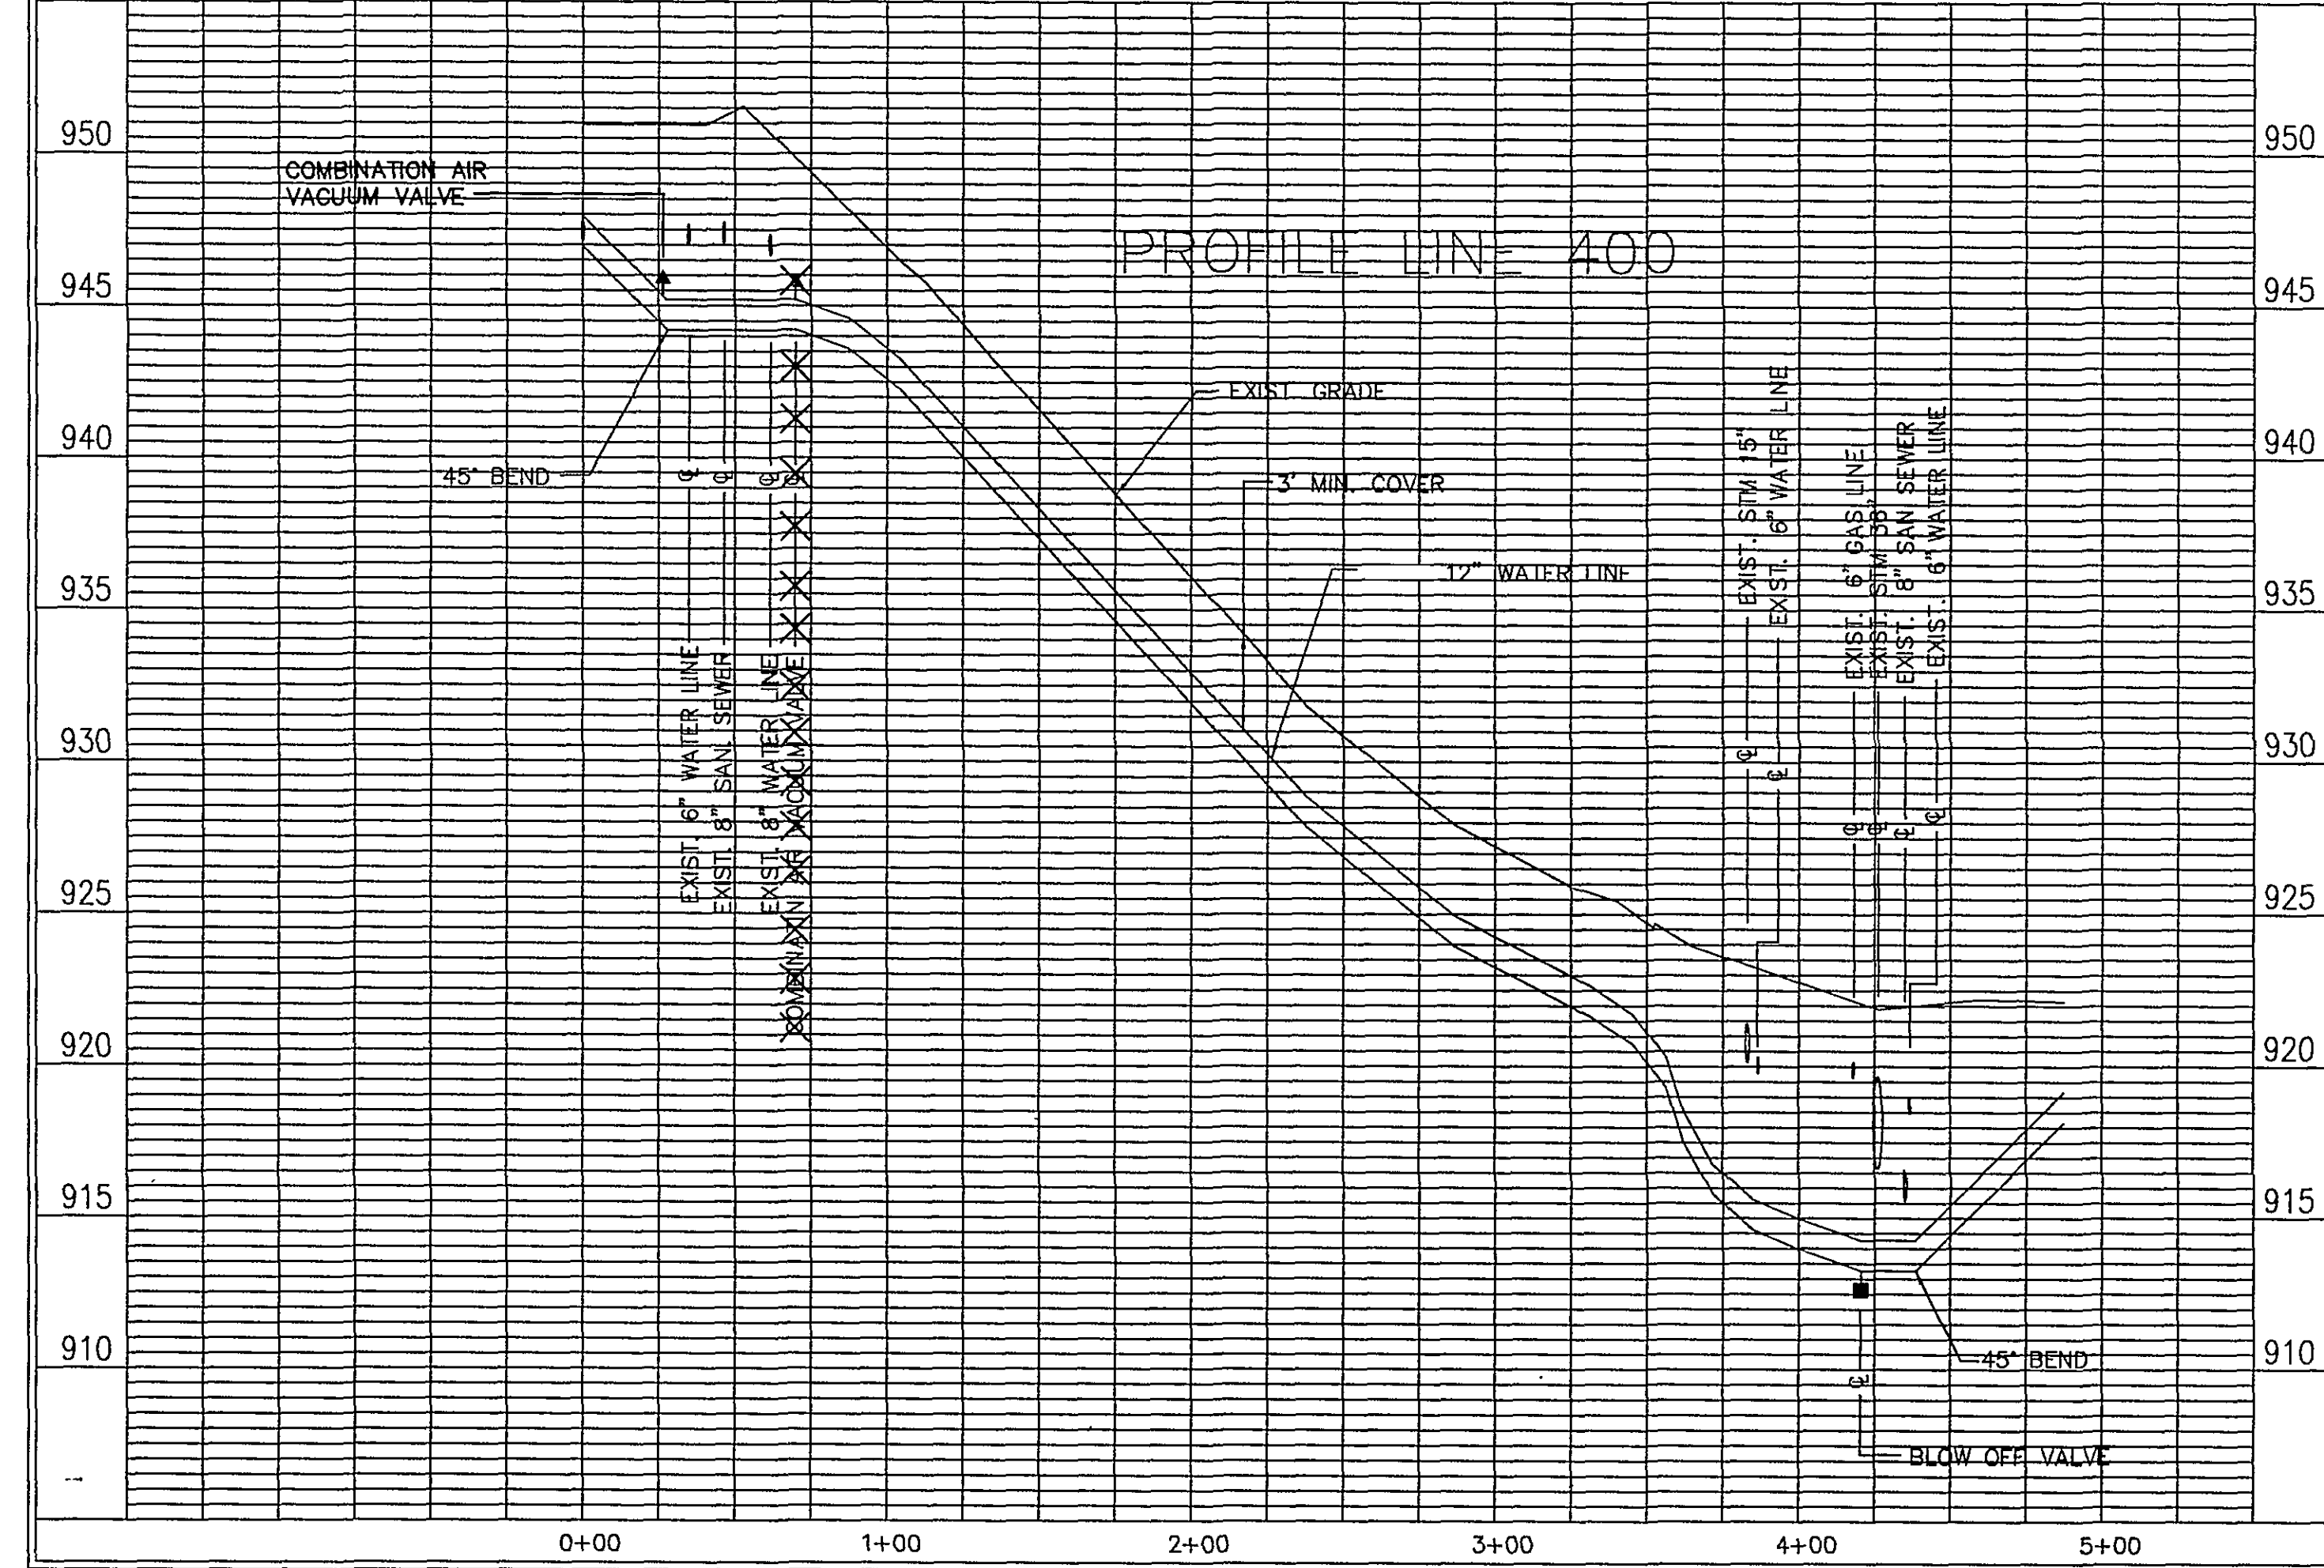

PROFILE LINE 400

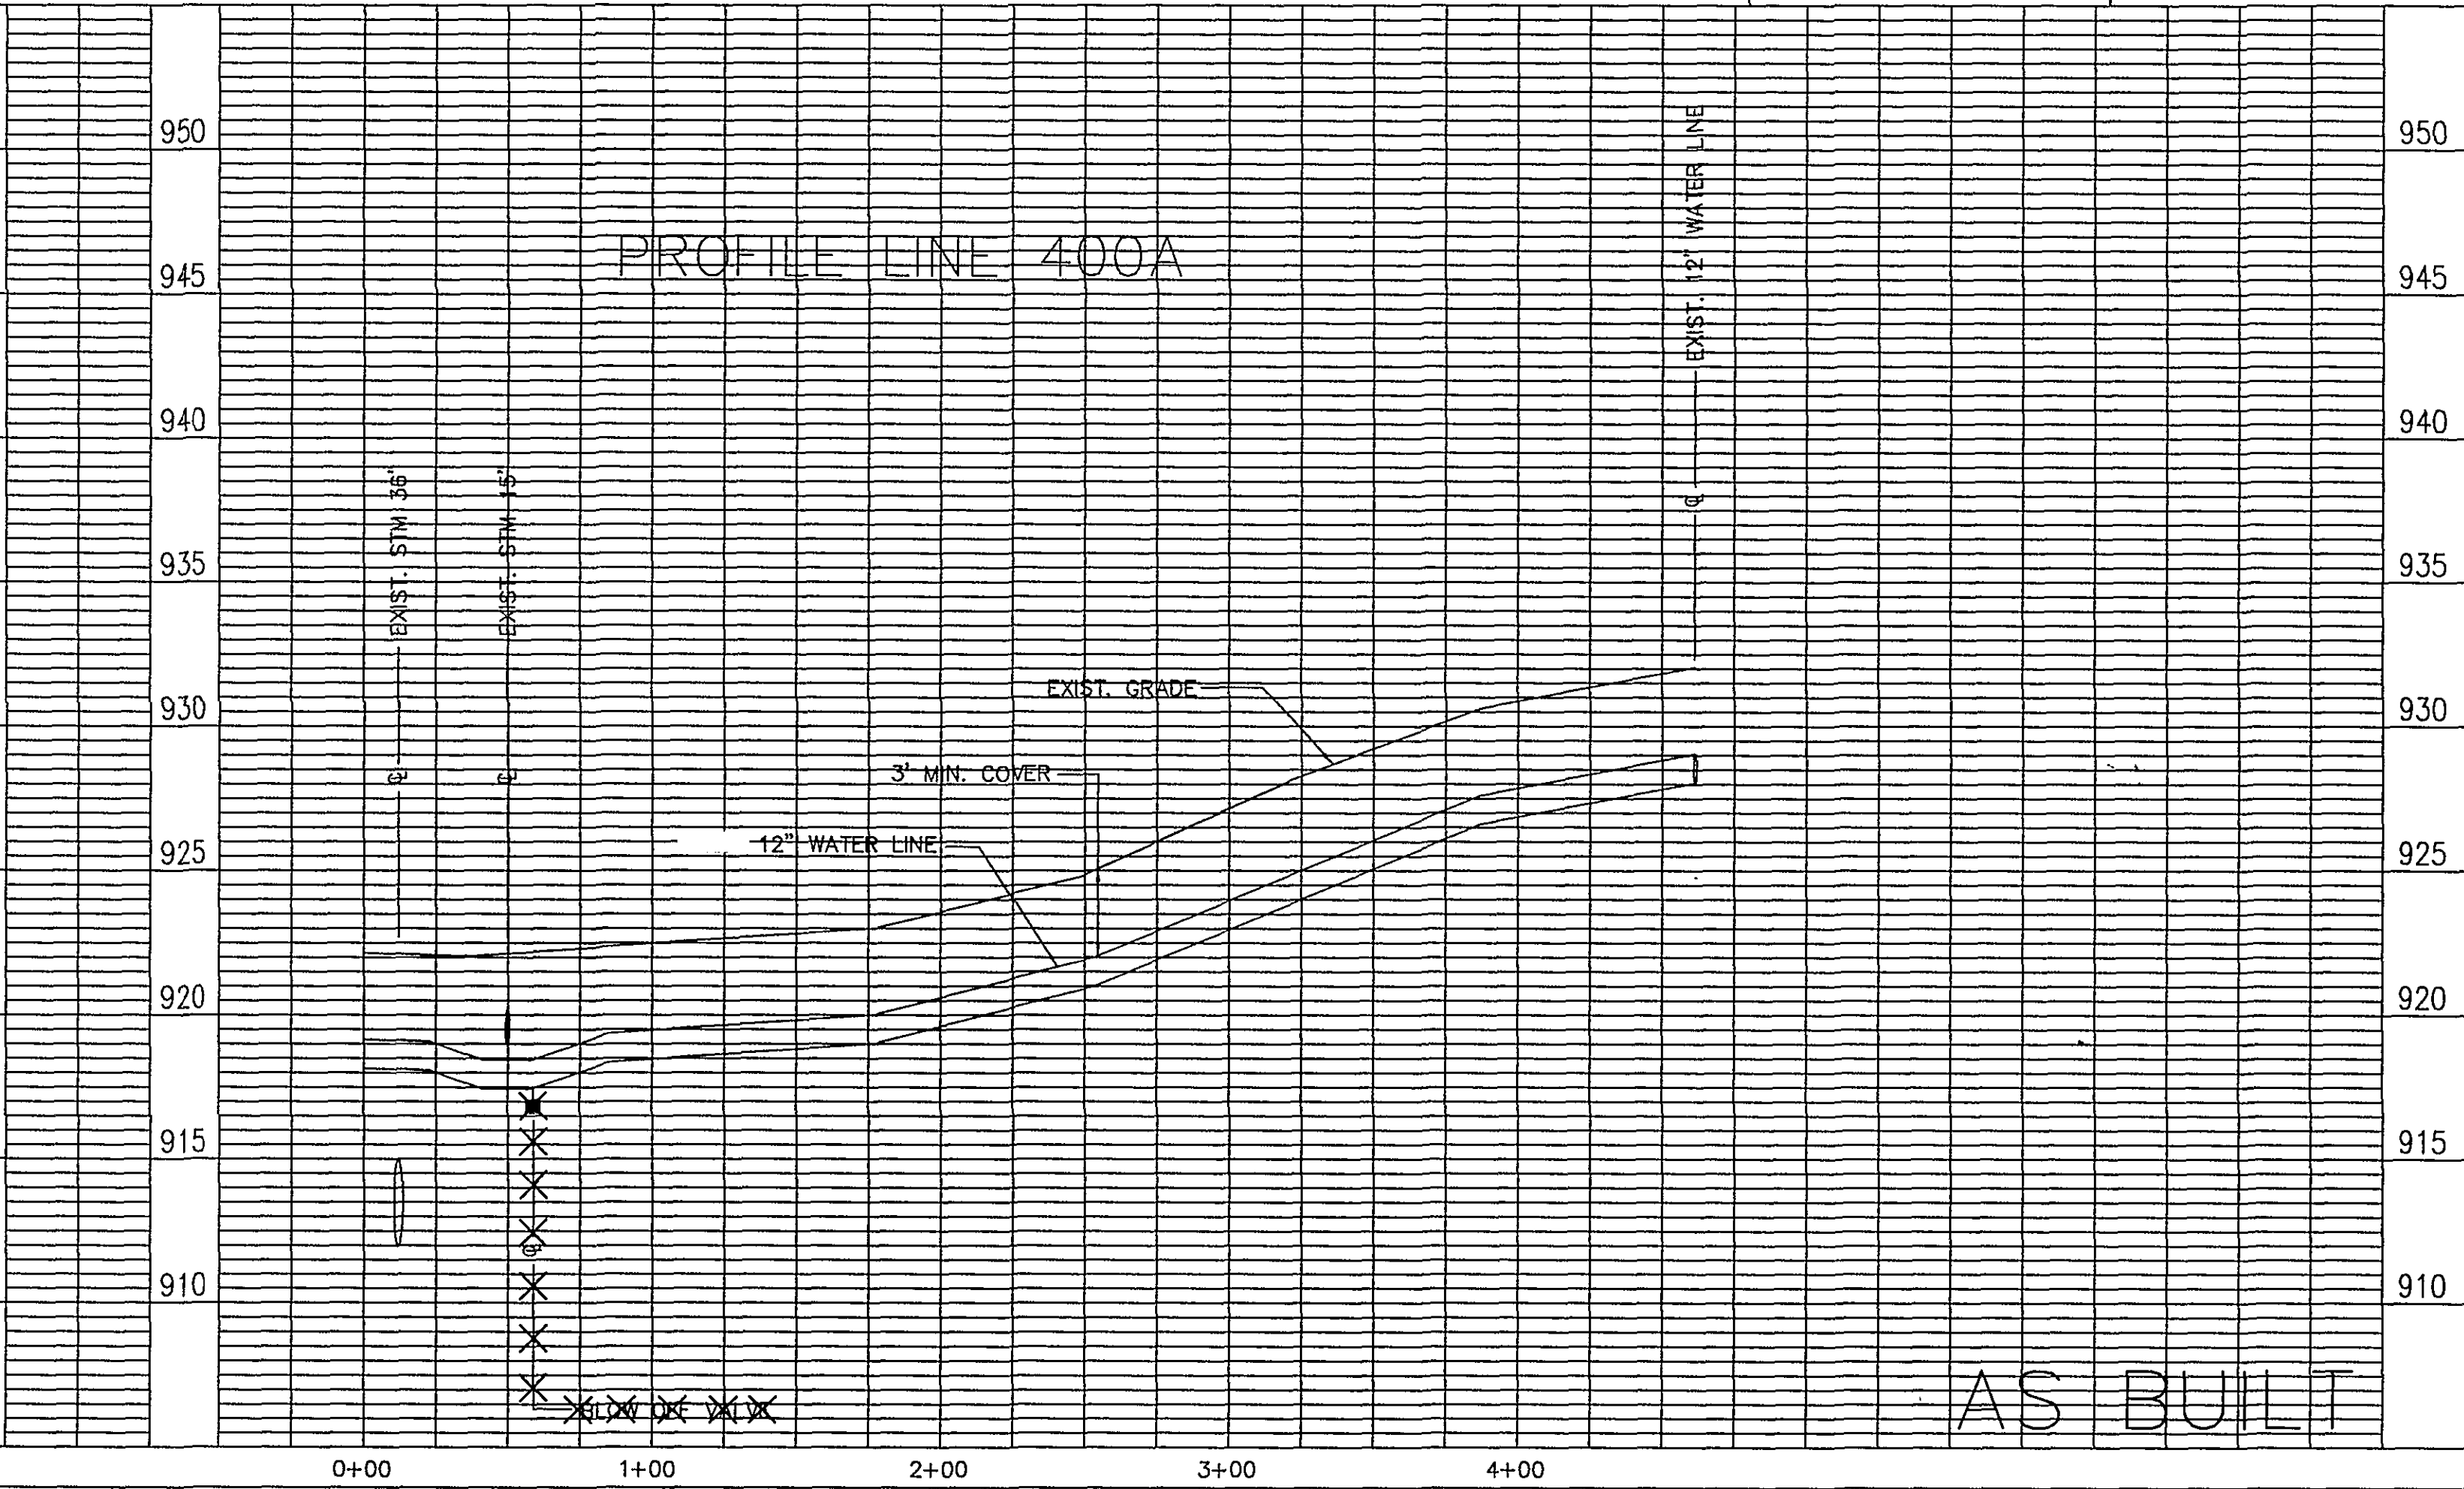

PROFILE LINE 400A

AS BUILT

Dewberry & Davis
 Architects
 Engineers
 Planners
 Surveyors
 5238 Valleypointe Parkway, Suite One-B
 Roanoke, Virginia 24019
 800 703 362-7725

Carvins Cove, Phase II
 City of Roanoke
 Roanoke, Virginia

CONTRACT "C1"
 MONTROSE INTERCONNECT
 LINE 400
 STA 0+00.00 - 4+87.28
 LINE 400A
 STA 0+00.00 - 4+61.29

Drawn By REH/ACF
 Designed By RBS
 Checked By SEH
 Date APRIL 93
 Scale V: 1" = 5'
 H: 1" = 50'
 Plan Number D1A
 Zoned NONE
 Sheet 9 of 12
 File Number C1160