

CARVINS COVE PHASE II


WATER IMPROVEMENTS PROJECT

CONTRACT C2


ROANOKE, VIRGINIA

VICINITY MAP

NOT TO SCALE

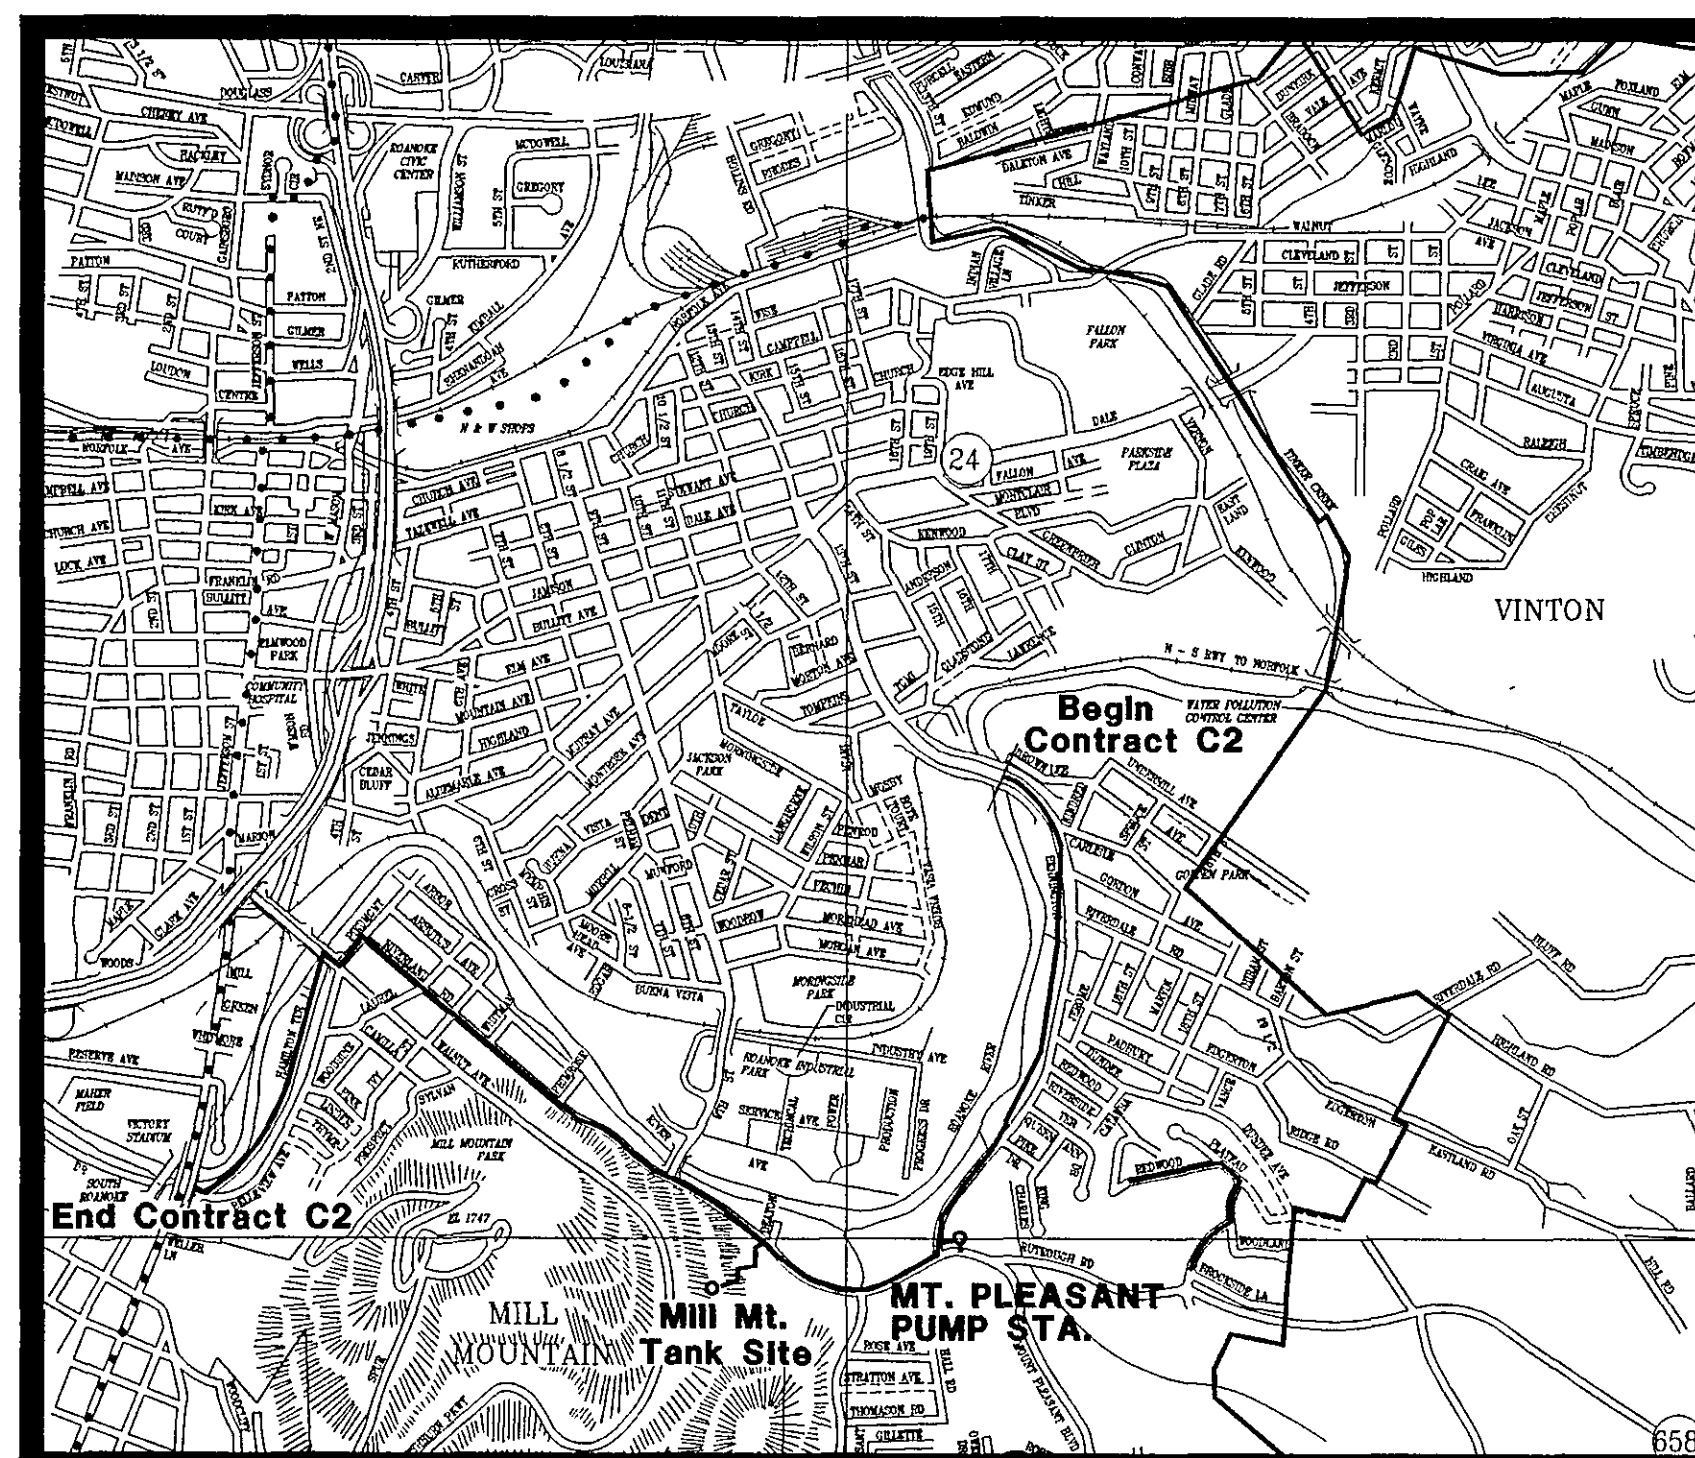


AS BUILT

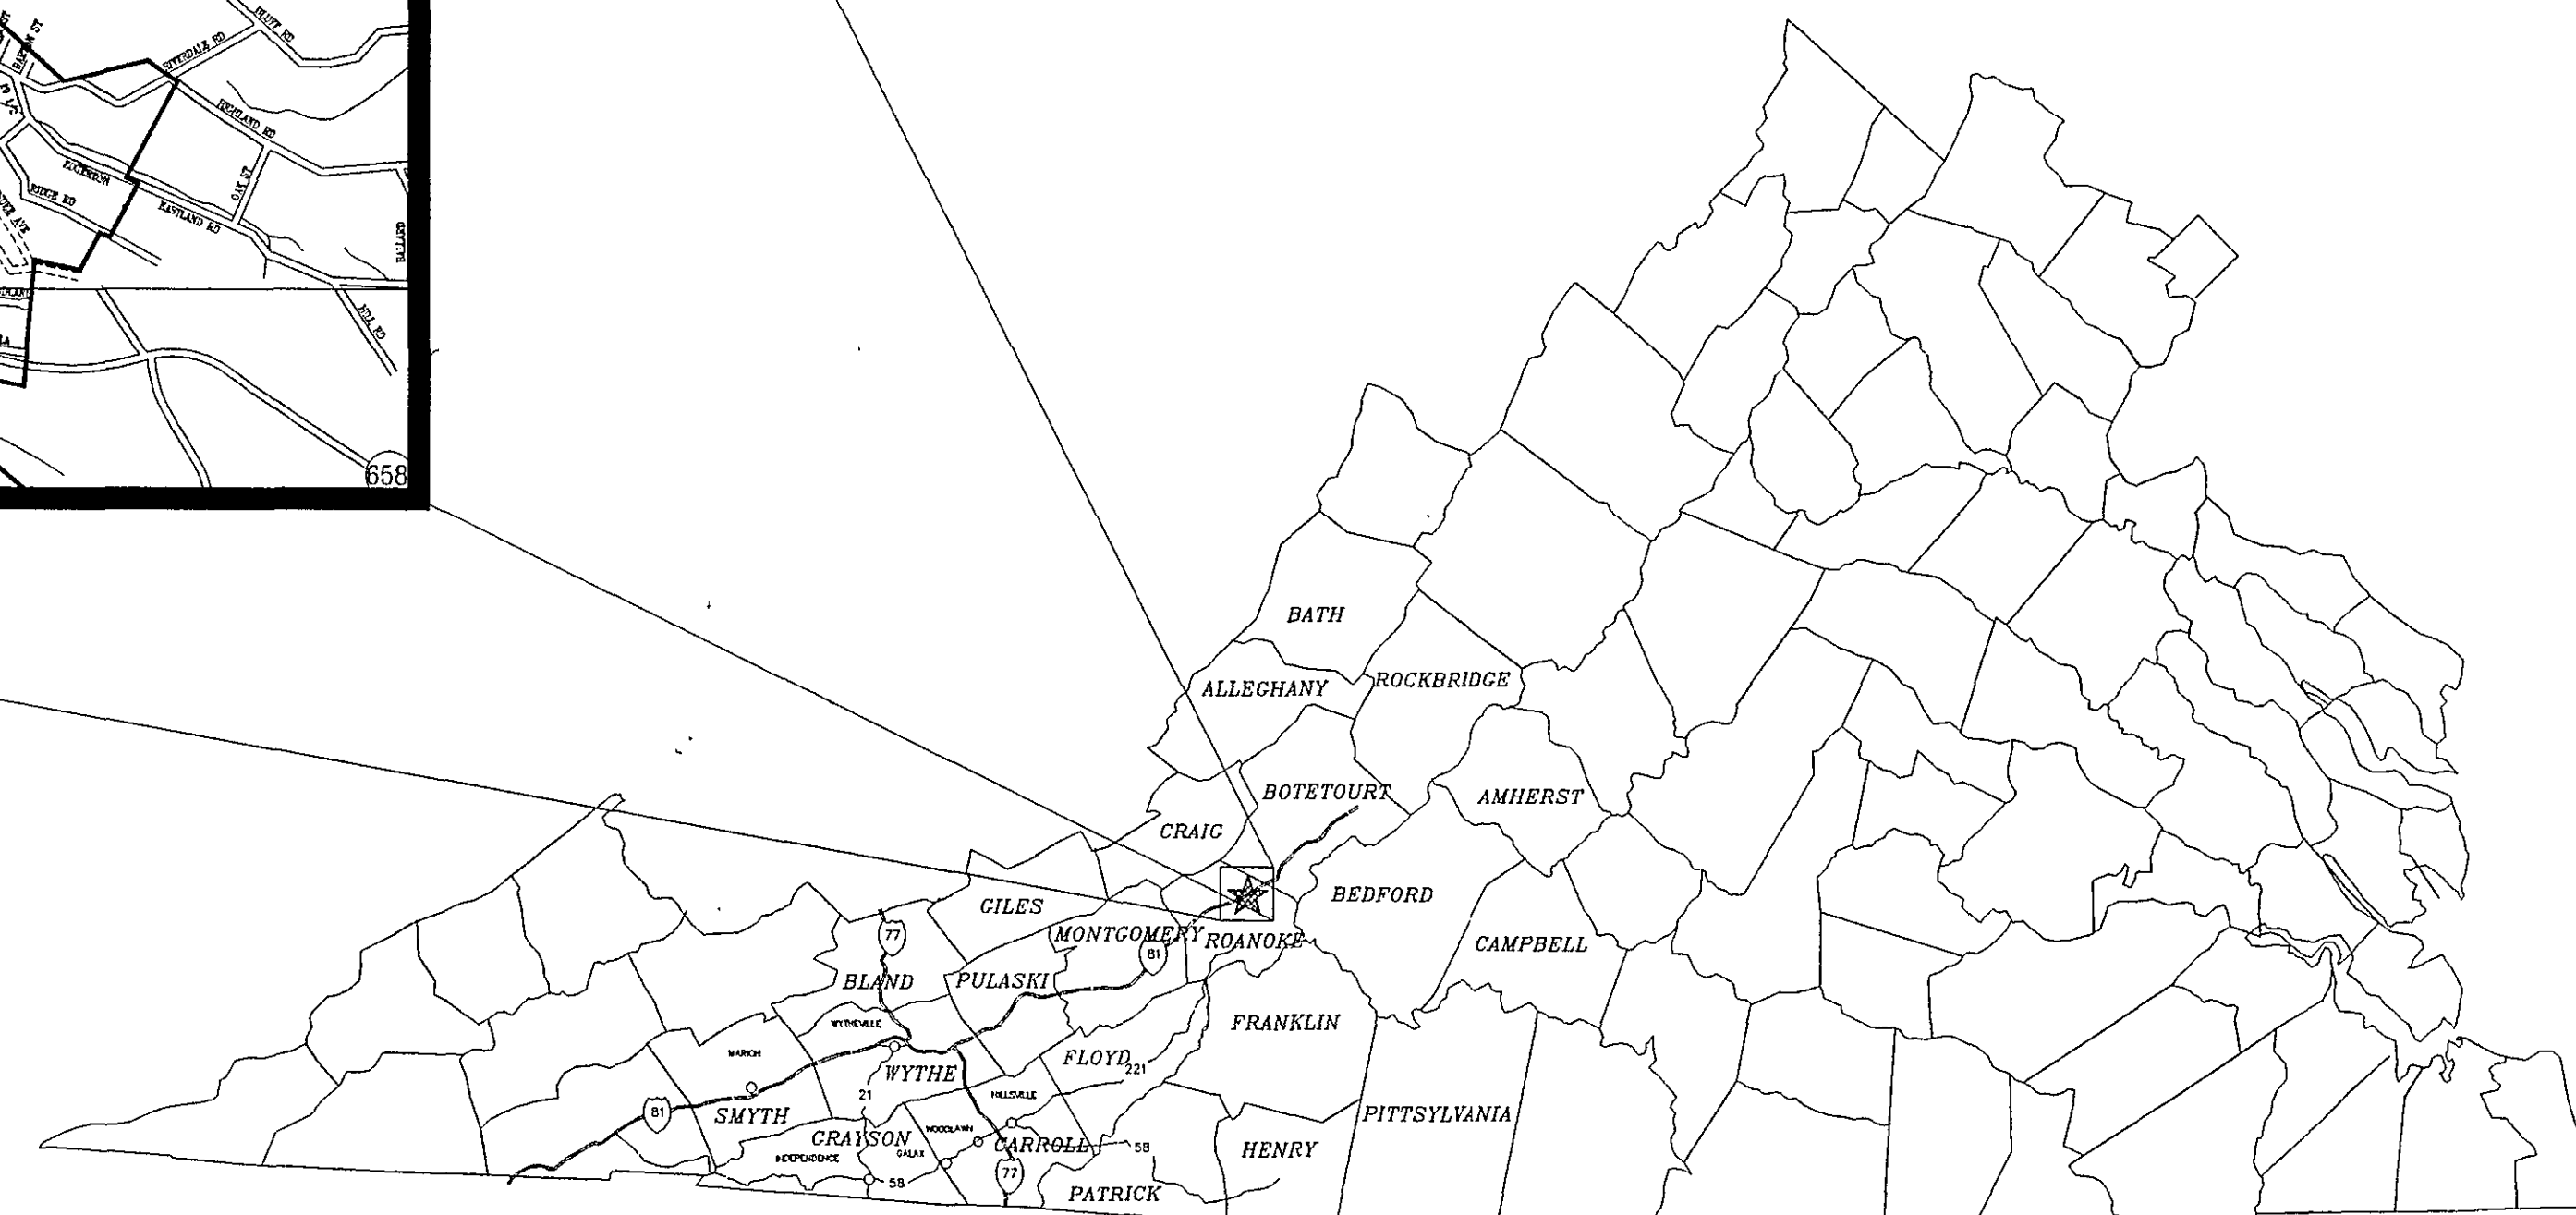

INDEX OF SHEETS

SHEET	TITLE	
	COVER SHEET	
1	LINE 350	0+00.00 11+54.88
2	LINE 350	11+54.88 23+70.51
3	LINE 350	23+70.51 36+35.50
4	LINE 350	36+35.50 48+43.63
5	LINE 350	48+43.63 61+20.27
6	LINE 350	61+20.27 73+51.10
7	LINE 350	73+51.10 86+04.51
8	LINE 350	86+04.51 98+51.26
9	LINE 350	98+51.26 109+95.49
10	LINE 350	109+95.49 120+71.44
11	LINE 350	120+71.44 133+54.10
12	LINE 350	133+54.10 144+72.02
13	LINE 350	144+72.02 157+05.54
14	PROP. MT. PLEASANT PUMP STA.	
	LINE 351	0+00.00 0+44.70
	LINE 351A	0+00.00 0+32.59
15	LINE 352	0+00.00 8+17.11
	PROP. MT. PLEASANT TANK/SITE	
	LINE 352A	0+00.00 1+03.67
16	LINE 352	8+17.11 18+80.57
17	PROP. MILL MOUNTAIN TANK	
	LINE 353	0+00.00 11+97.30
18	LINE 353	11+97.30 15+45.77
19	SITE PLAN	
20	DETAIL	
21	DETAIL	
22	DETAIL	
23	DETAILS	
24	DETAILS	
25	DETAILS/ST. EROSION/LEGEND	
	PROP. MT. PLEASANT PUMP STATION	
E1	ELECTRICAL	
E2	ELECTRICAL	

ENGINEERING #6252

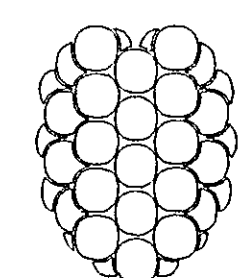



Dewberry & Davis

5238 VALLEYPONTE PARKWAY
SUITE ONE-B
ROANOKE, VIRGINIA 24019
(703) 362-7725

CONTRACT C-2 WATER PLAN #93-25

COMPLETED 1/31/1995

CONTRACTOR: HAMNER GAYE

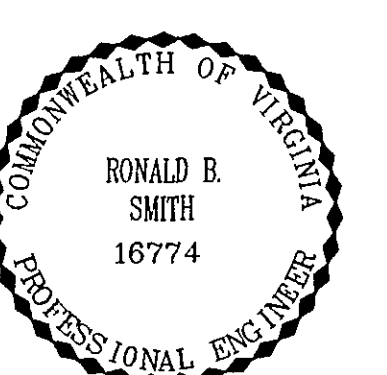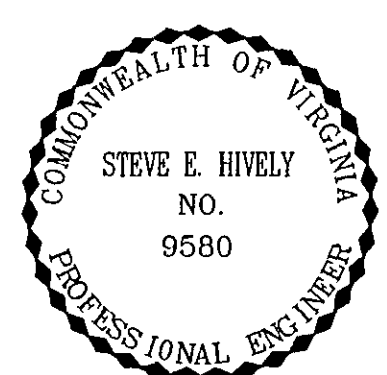

WATER DEP'T. # 93-25