

NOTE
CONTRACTOR SHALL COORDINATE INSTALLATION OF PROPOSED 24" WATER LINE, WITH REPRESENTATIVES OF THE PLANTATION PIPE LINE COMPANY INC. WHERE CROSSING PETROLEUM PIPE LINES OCCUR. PHONE (704) 864-2603




24"x24"x12" TEE W/CAP FOR CONNECTION OF PROP. LINE 351 TO MOUNT PLEASANT PUMP STATION APPROX. STA. 51+90.98 OF LINE 350

NOTE:
24" BUTTERFLY VALVE W/VAULT DRAIN TO SUMP

NOTE:
CONTRACTOR SHALL REPLACE EXIST 24" SAN. SEWER W/20 L.F OF DUCTILE IRON


NOTE:
CONTRACTOR SHALL REPAVE PERMANENT UTILITY EASEMENT & TEMPORARY CONSTRUCTION EASEMENT AS PART OF CONTRACT "C2"

- THIS SHEET
- | | |
|---------|---------------------|
| 1277 LF | 24" WATERMAIN |
| 15 LF | 12" WATERMAIN |
| 2 EA. | 6" BLOWOFF |
| 2 EA. | 1" A.R.V. |
| 1 EA. | 24" BUTTERFLY VALVE |

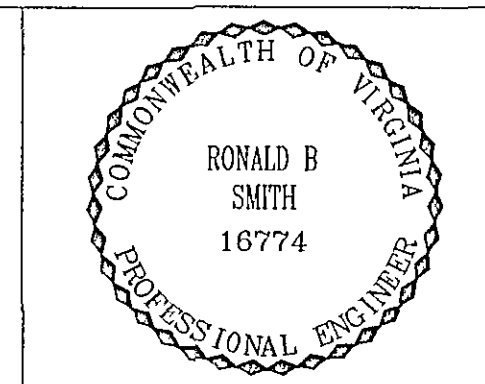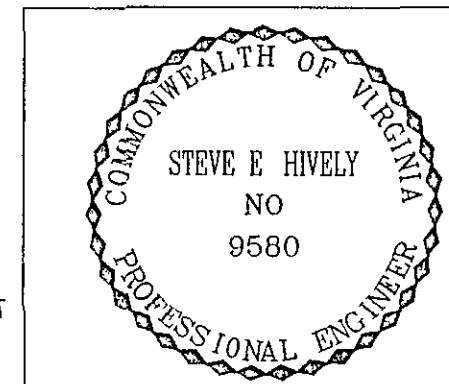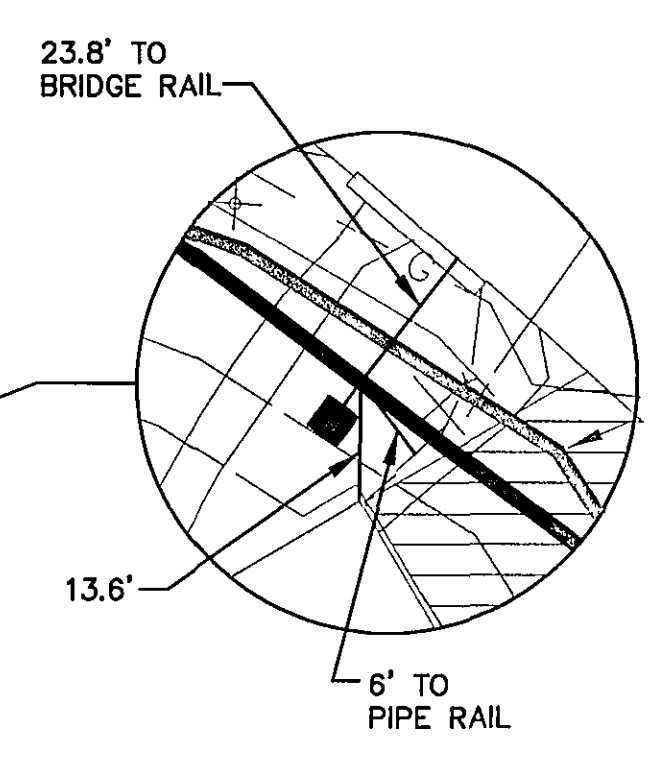

PLAN VIEW LINE 350

PROFILE LINE 350

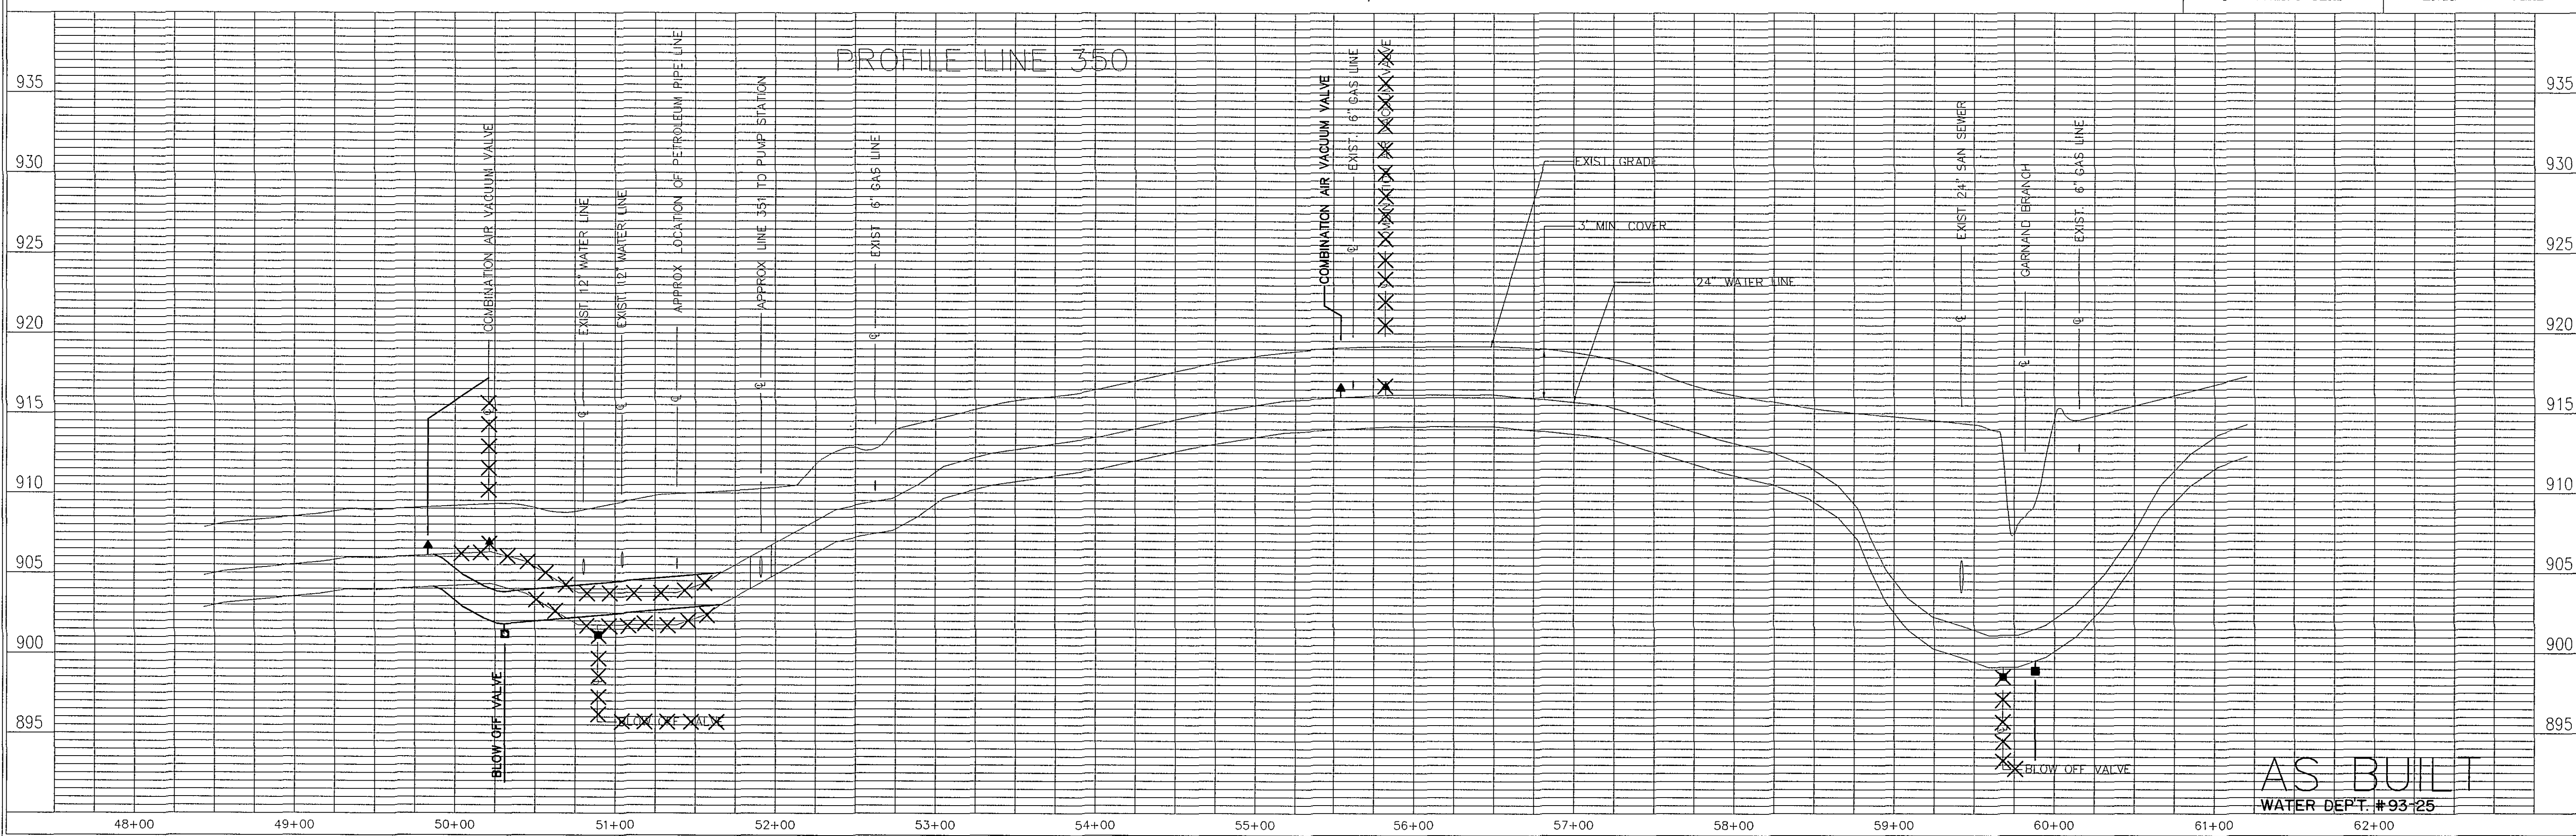

AS BUILT
WATER DEPT. #93-25

Architects
Engineers
Planners
Surveyors

Dewberry & Davis

5238 Valleypointe Parkway, Suite One-B
Roanoke, Virginia 24019
☎ 703 362-7725

Carvins Cove, Phase II

City of Roanoke
Roanoke, Virginia

CONTRACT "C2"
LINE 350
STA 48+43.63 - 61+20.27

Drawn By ACF/REH
Designed By RBS
Checked By SEH
Date MARCH 93
Scale V: 1" = 5'
H: 1" = 50'
Plan Number D8
Zoned NONE
Sheet 5 of 25
File Number C1160