



THIS SHEET
1231 LF 24" WATERMAIN
2 EA. 1" A.R.V.
1 EA. 24" BUTTERFLY VALVE

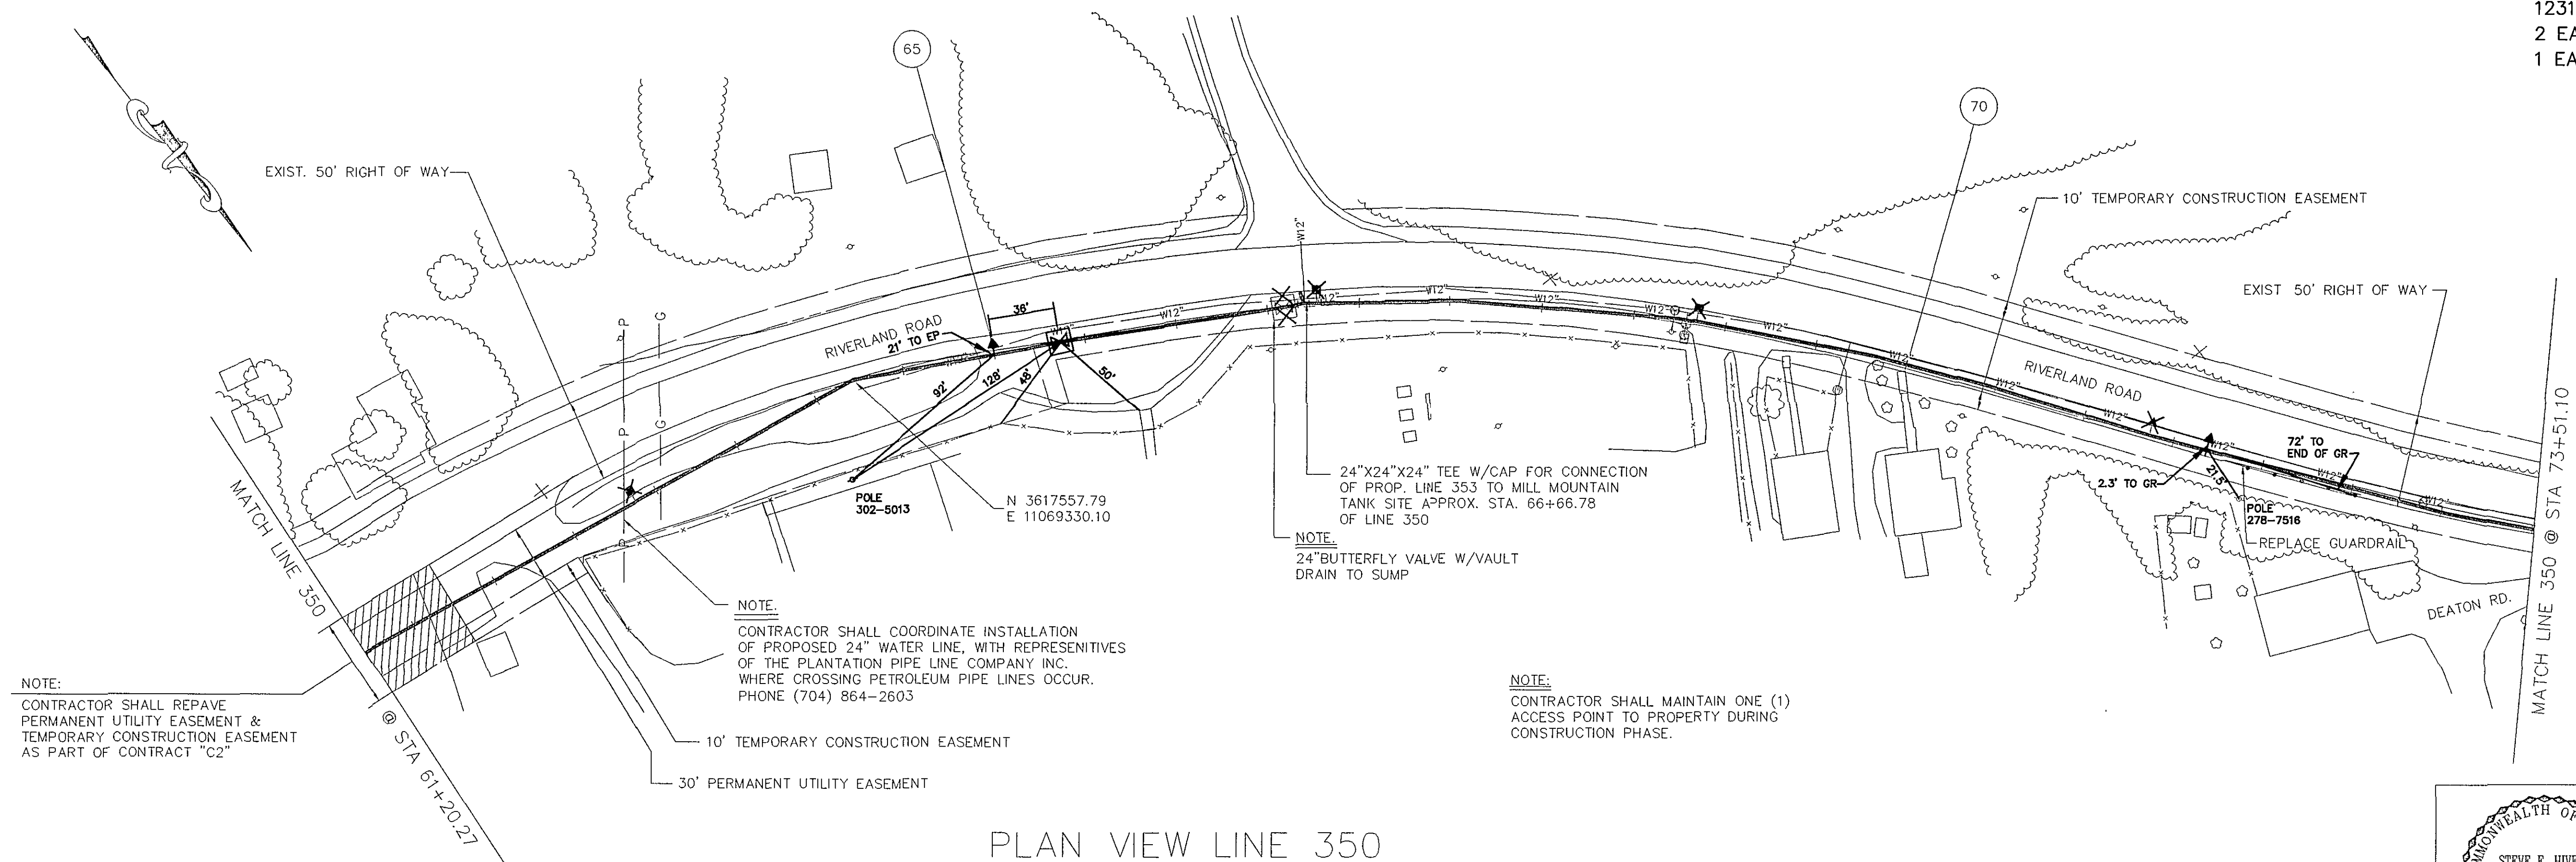

 ENGINEER'S SEAL	 ENGINEER'S SEAL
---------------------	---------------------

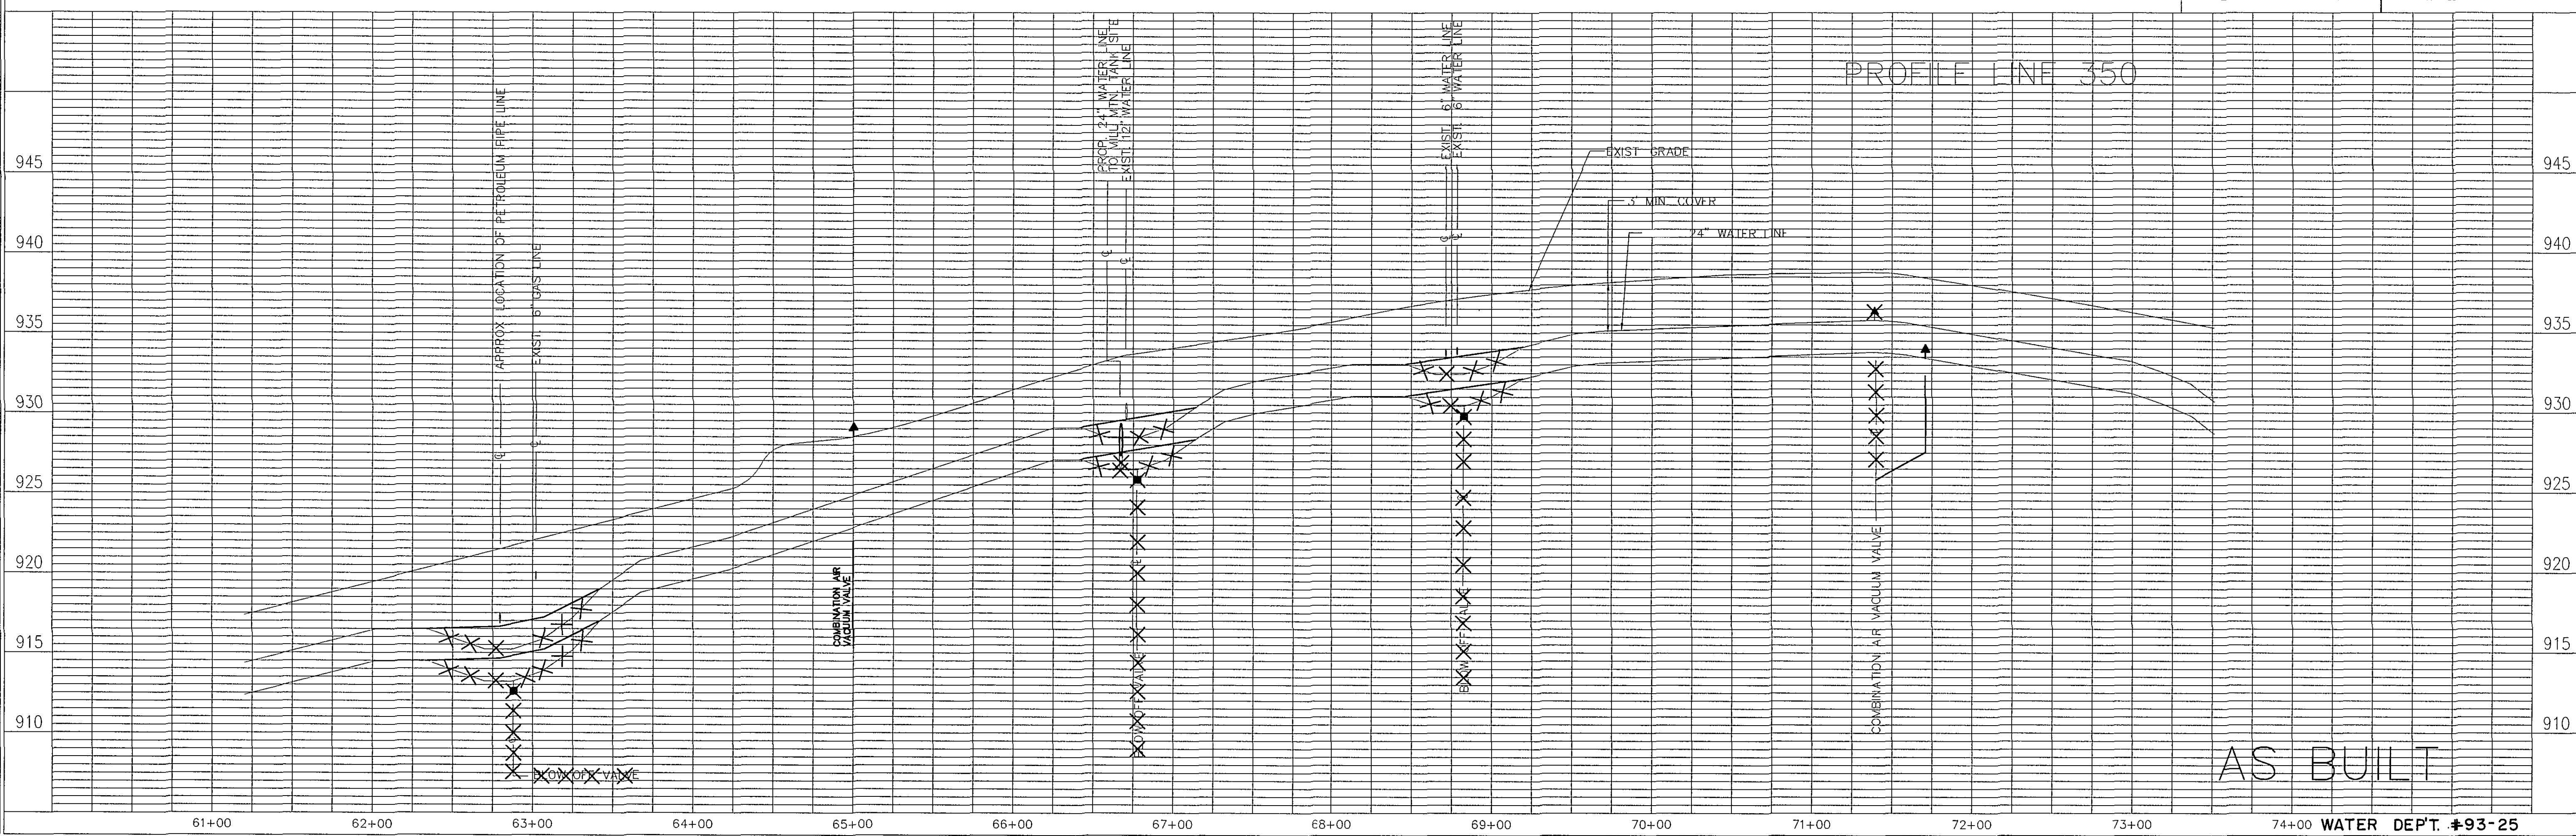

 Architects Engineers Planners Surveyors 5238 Valleypointe Parkway, Suite One-B Roanoke, Virginia 24019 Tel: 703 362-7725	Carvins Cove, Phase II City of Roanoke Roanoke, Virginia	CONTRACT "C2" LINE 350 STA 61+20.27 - 73+51.10	Drawn By ACF/REH Designed By RBS Checked By SEH Date MARCH 93 Scale V: 1" = 5' H: 1" = 50' Plan Number D9 Zoned NONE Sheet 6 of 25 File Number C1160
--	--	--	---