


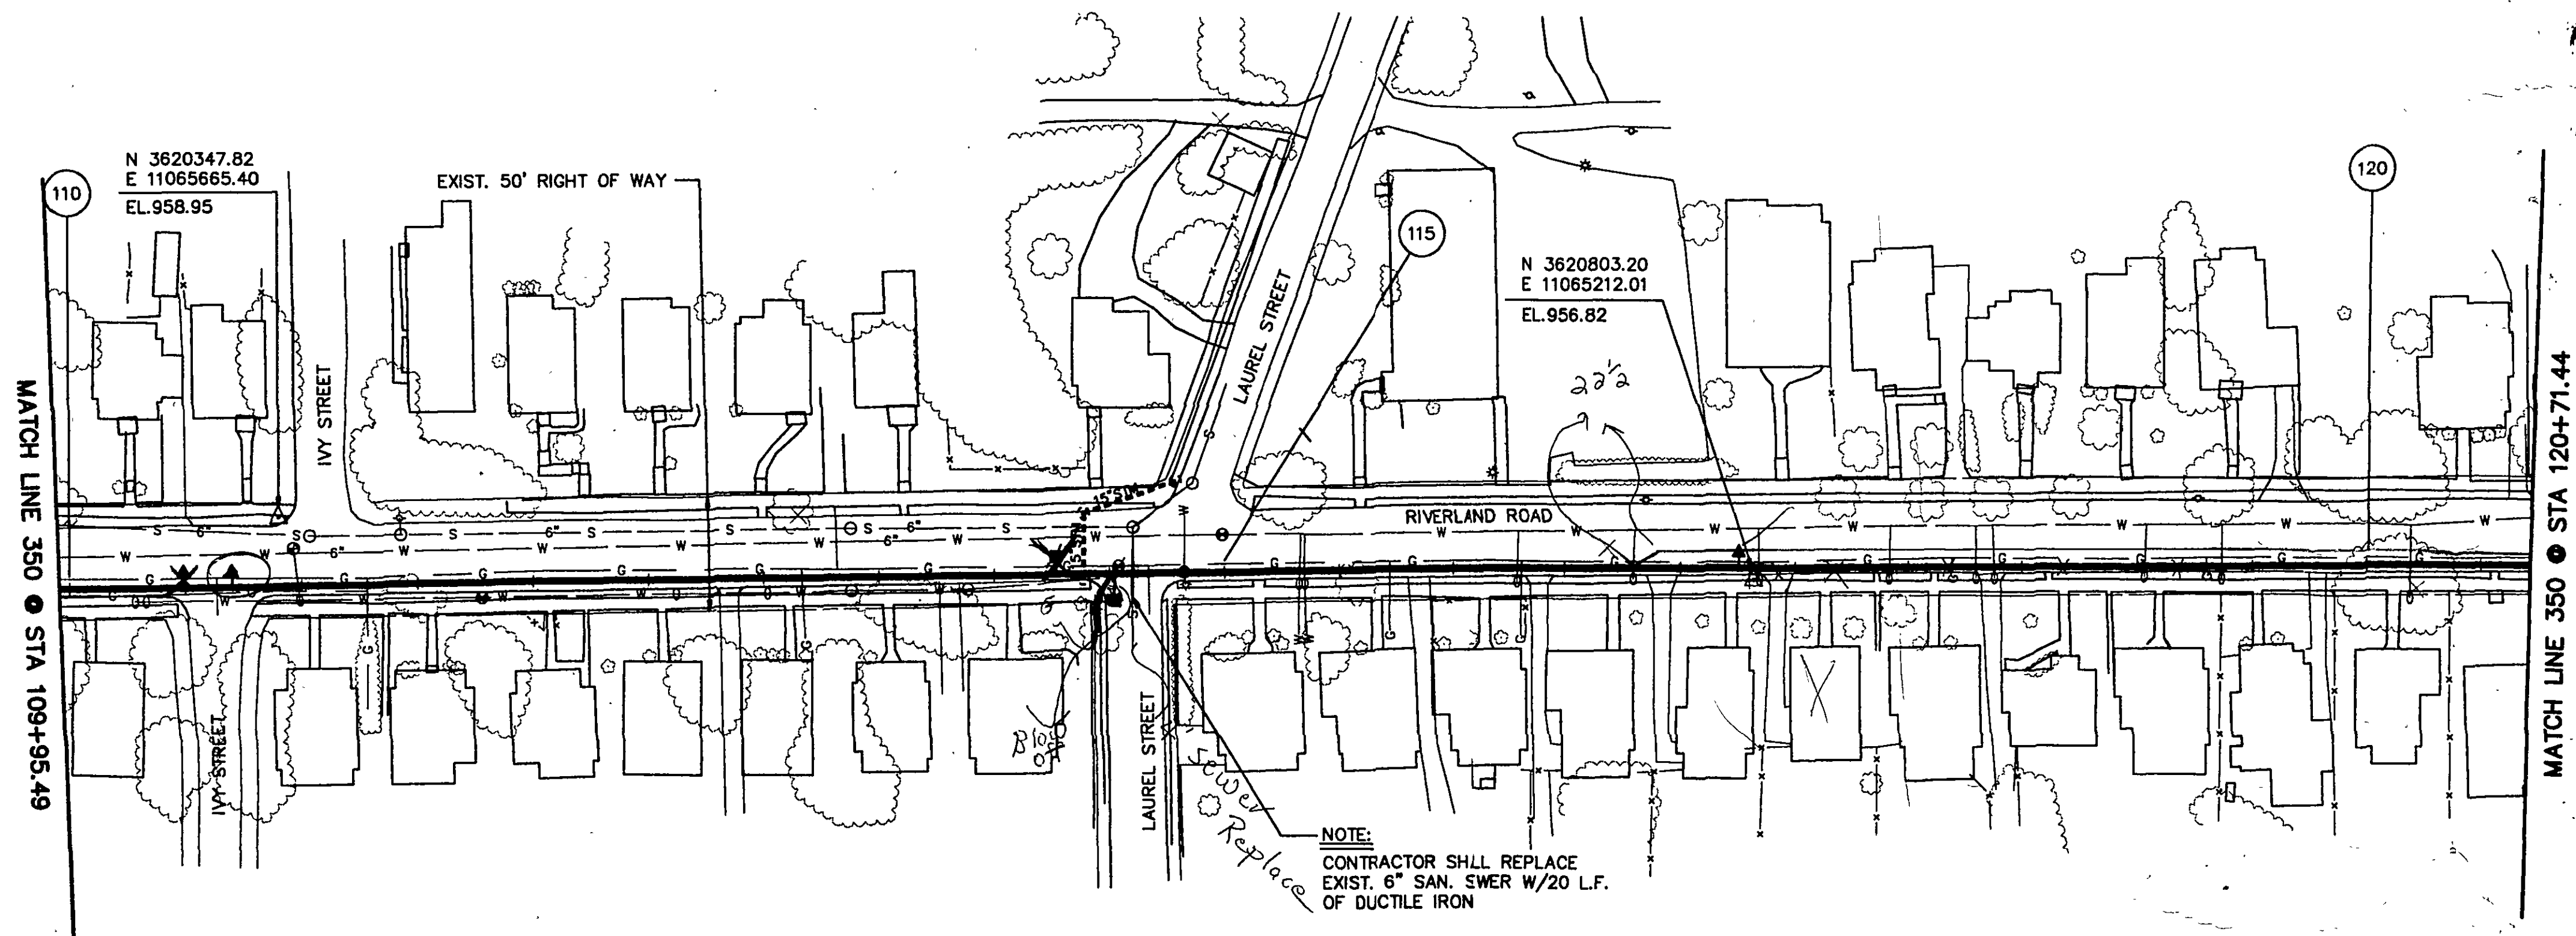
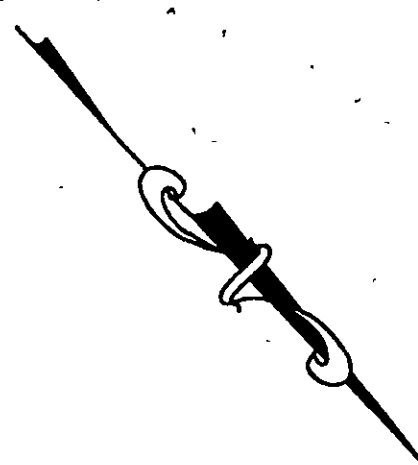


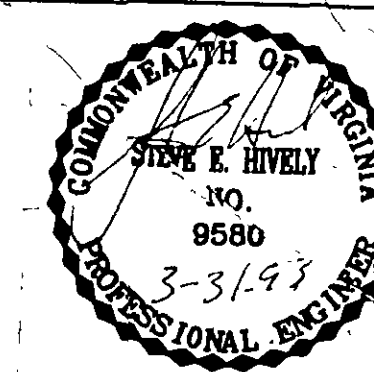

PLAN VIEW LINE 350

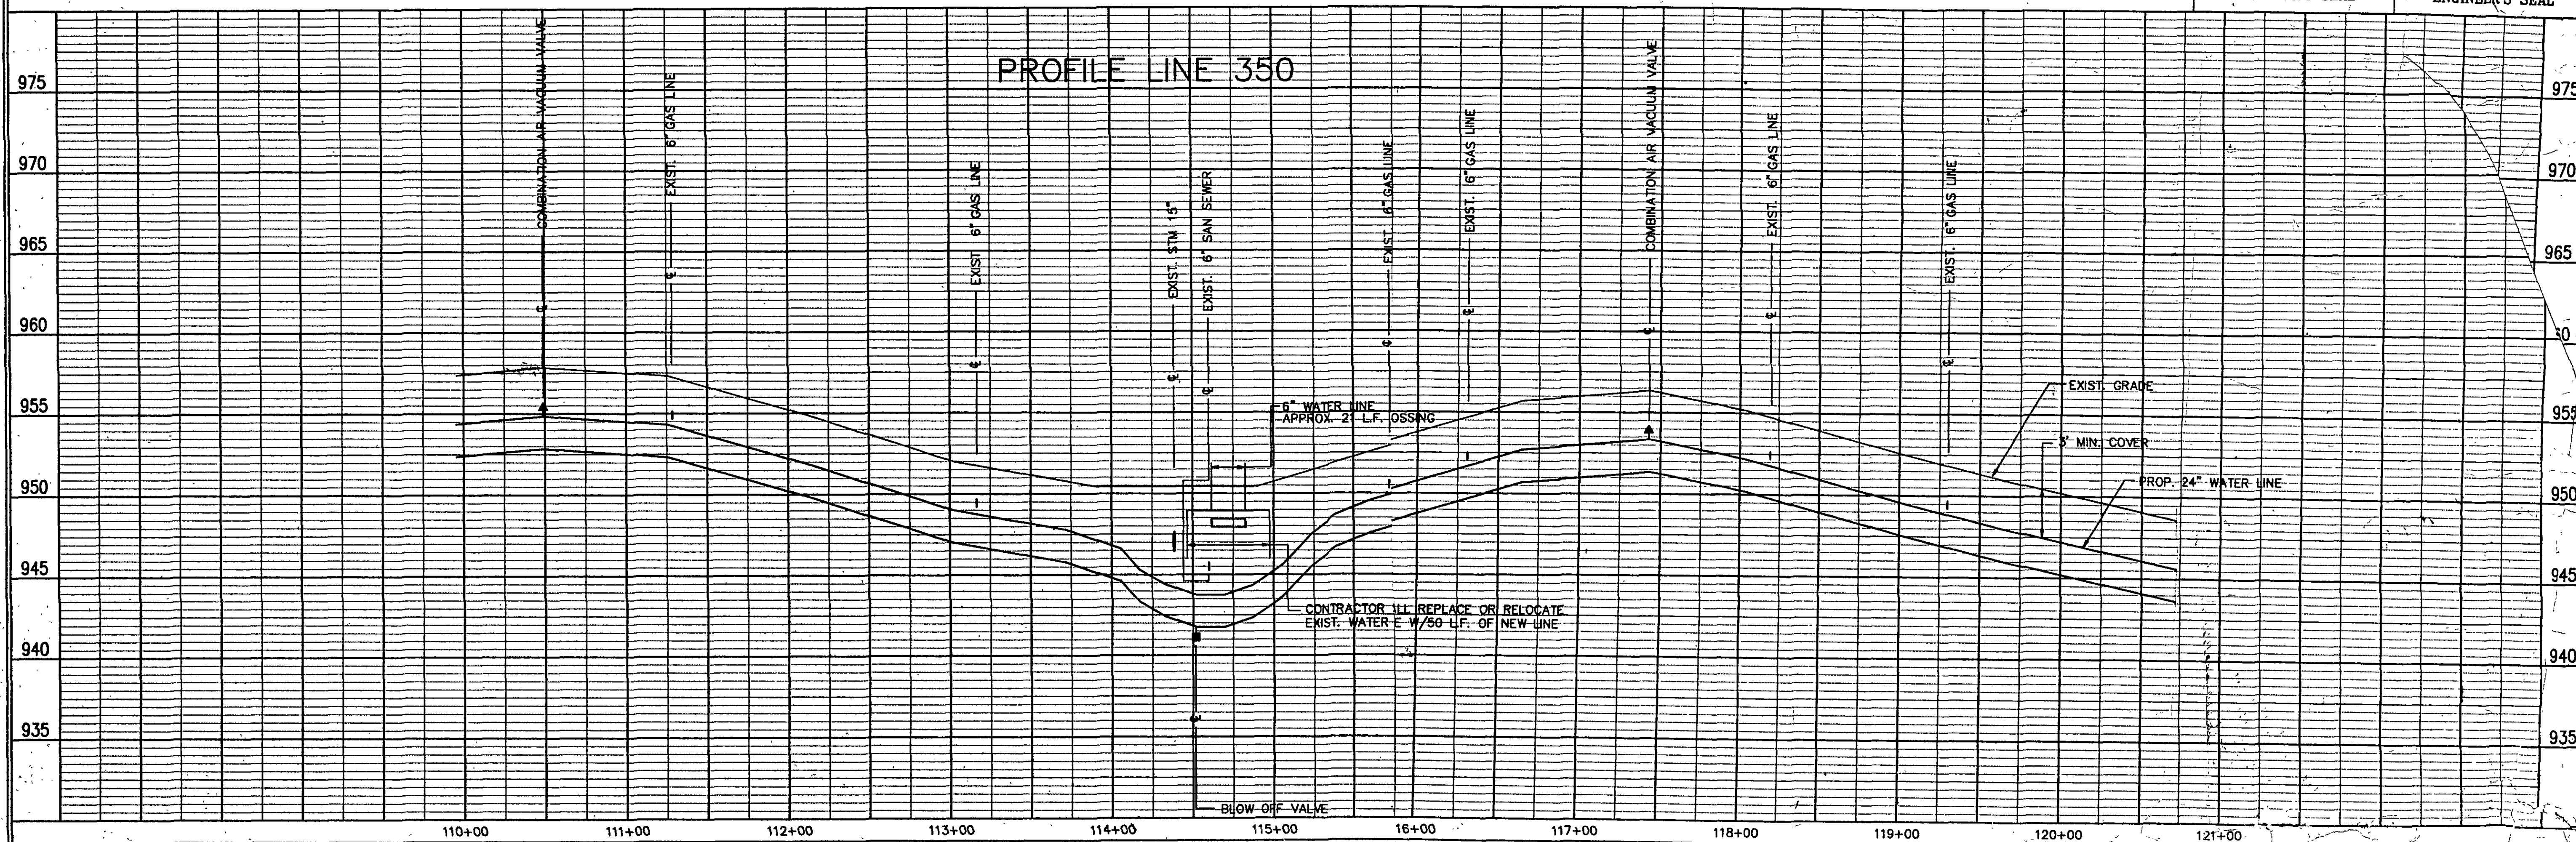

ENGINEER'S SEAL

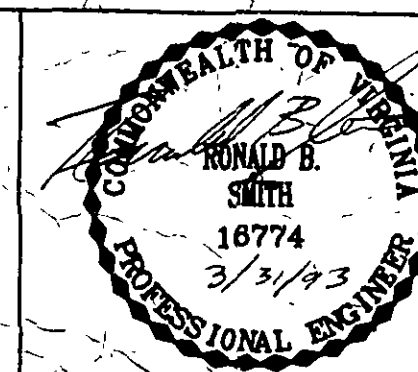

ENGINEER'S SEAL

CONTRACT "C2"
LINE 350
STA 109+95.49 - 120+71.44

Drawn By: REH/ACF
Designed By: BBS
Checked By: SEH
Date: MARCH 93
Scale:
V: 1" = 5'
H: 1" = 50'
Plan Number: D13
Zoned: NONE
Sheet: 10 of 25
File Number: C1160

Carvins Cove, Phase II
City of Roanoke
Roanoke, Virginia

Dewberry & Davis
Architects
Engineers
Planners
Surveyors
5238 Valleyridge Parkway, Suite One-B
Roanoke, Virginia 24019
703 362-7725