



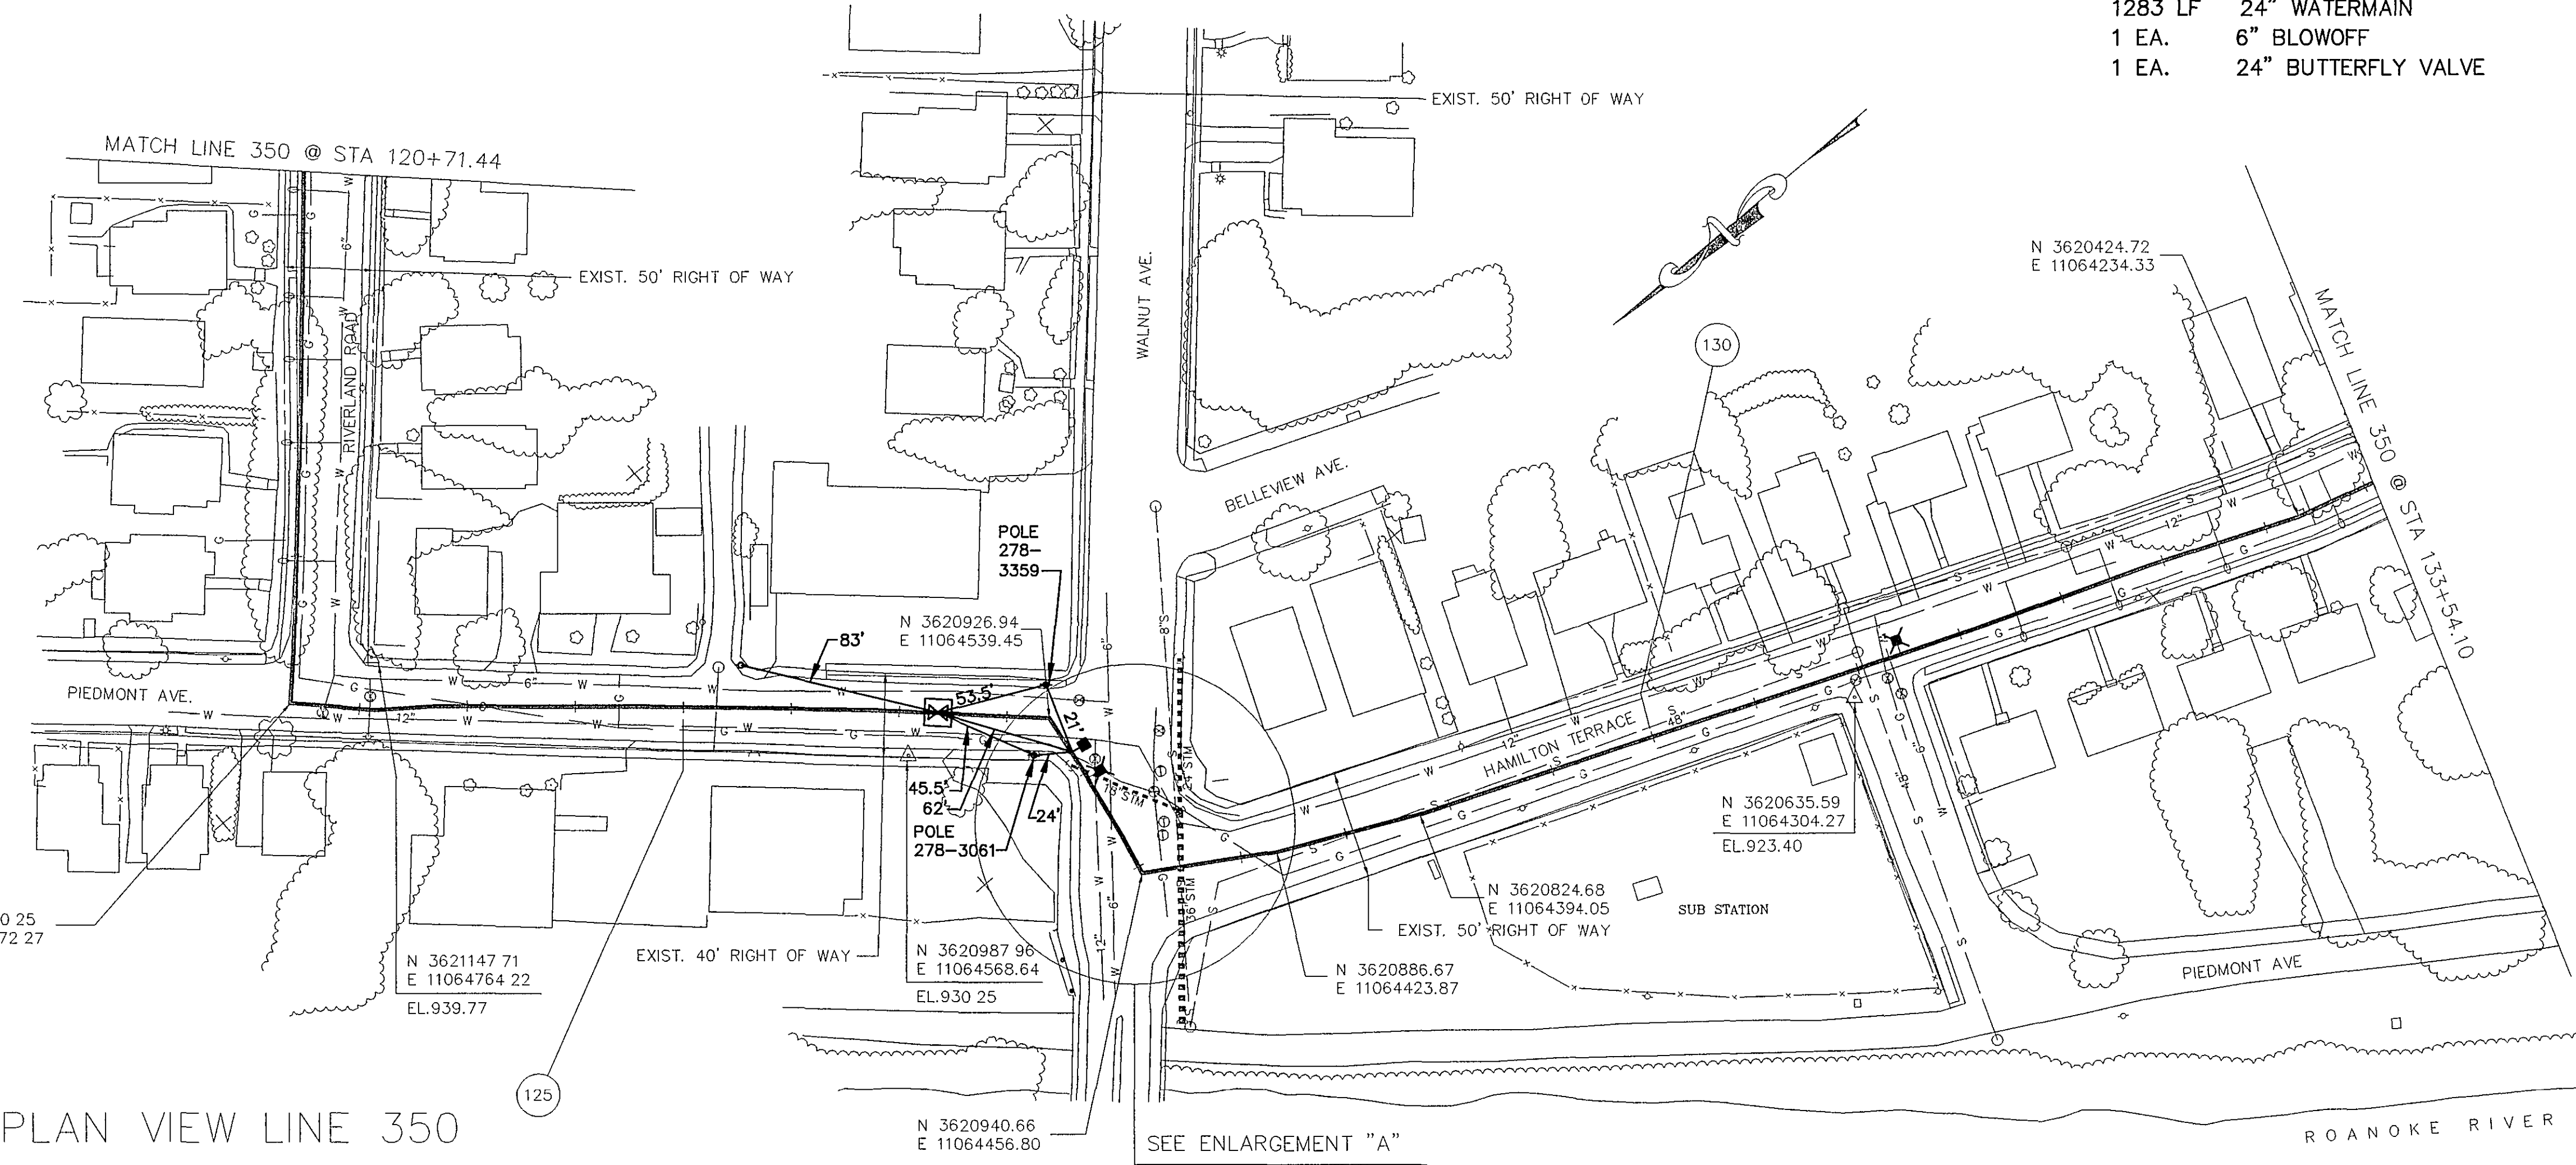


THIS SHEET
1283 LF 24" WATERMAIN
1 EA. 6" BLOWOFF
1 EA. 24" BUTTERFLY VALVE

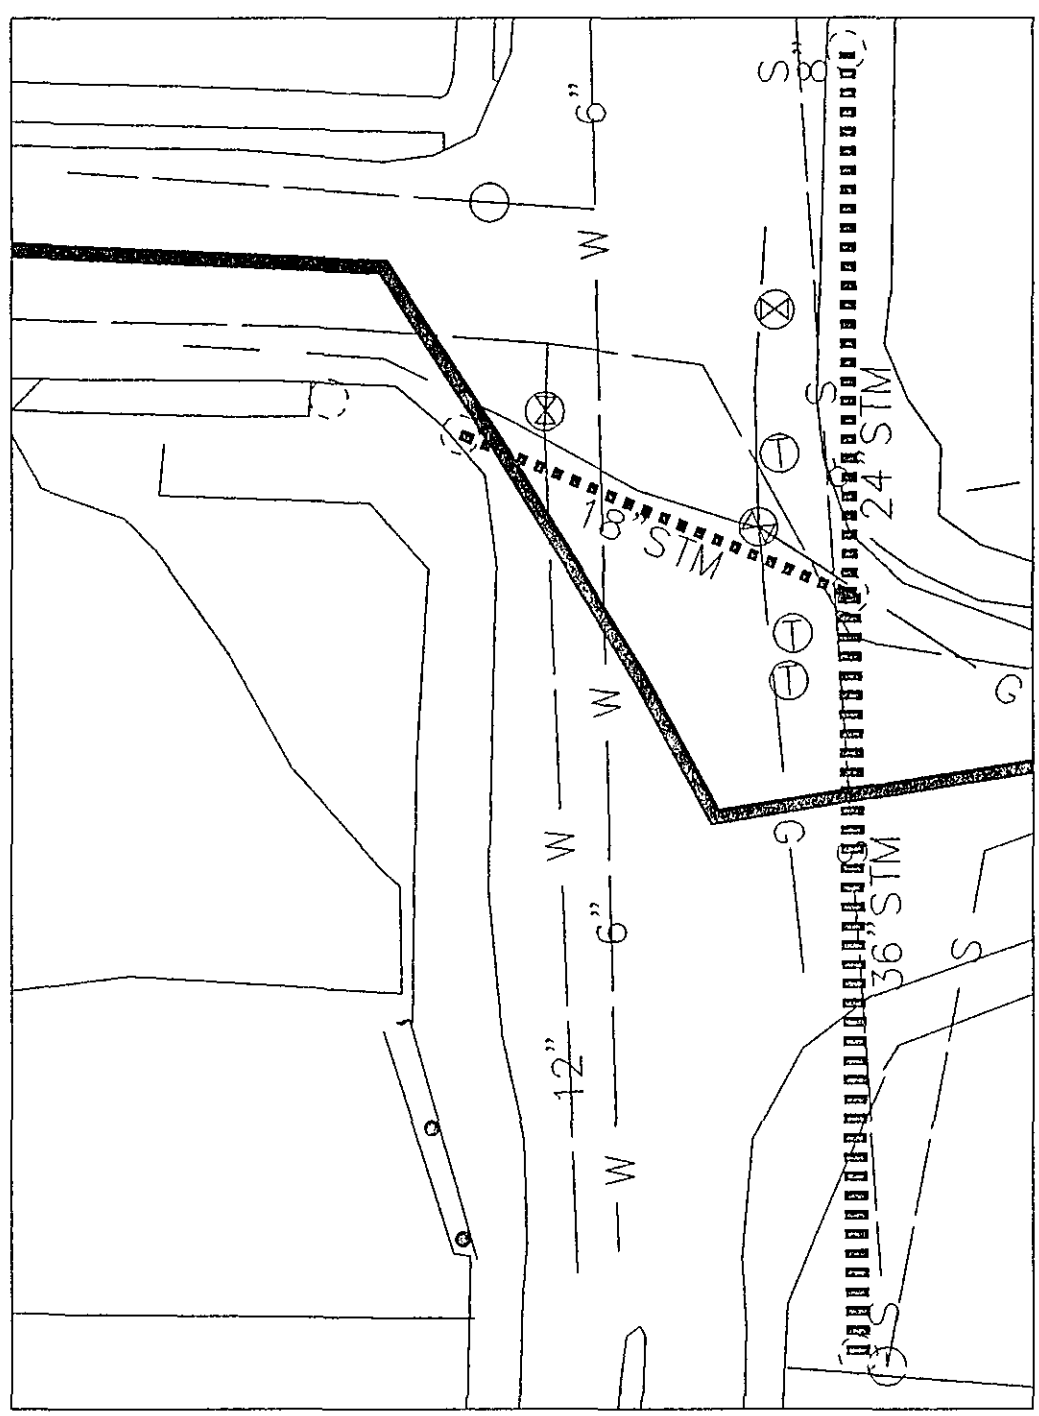

ENLARGEMENT "A"
NTS

 ENGINEER'S SEAL	 ENGINEER'S SEAL
---------------------	---------------------

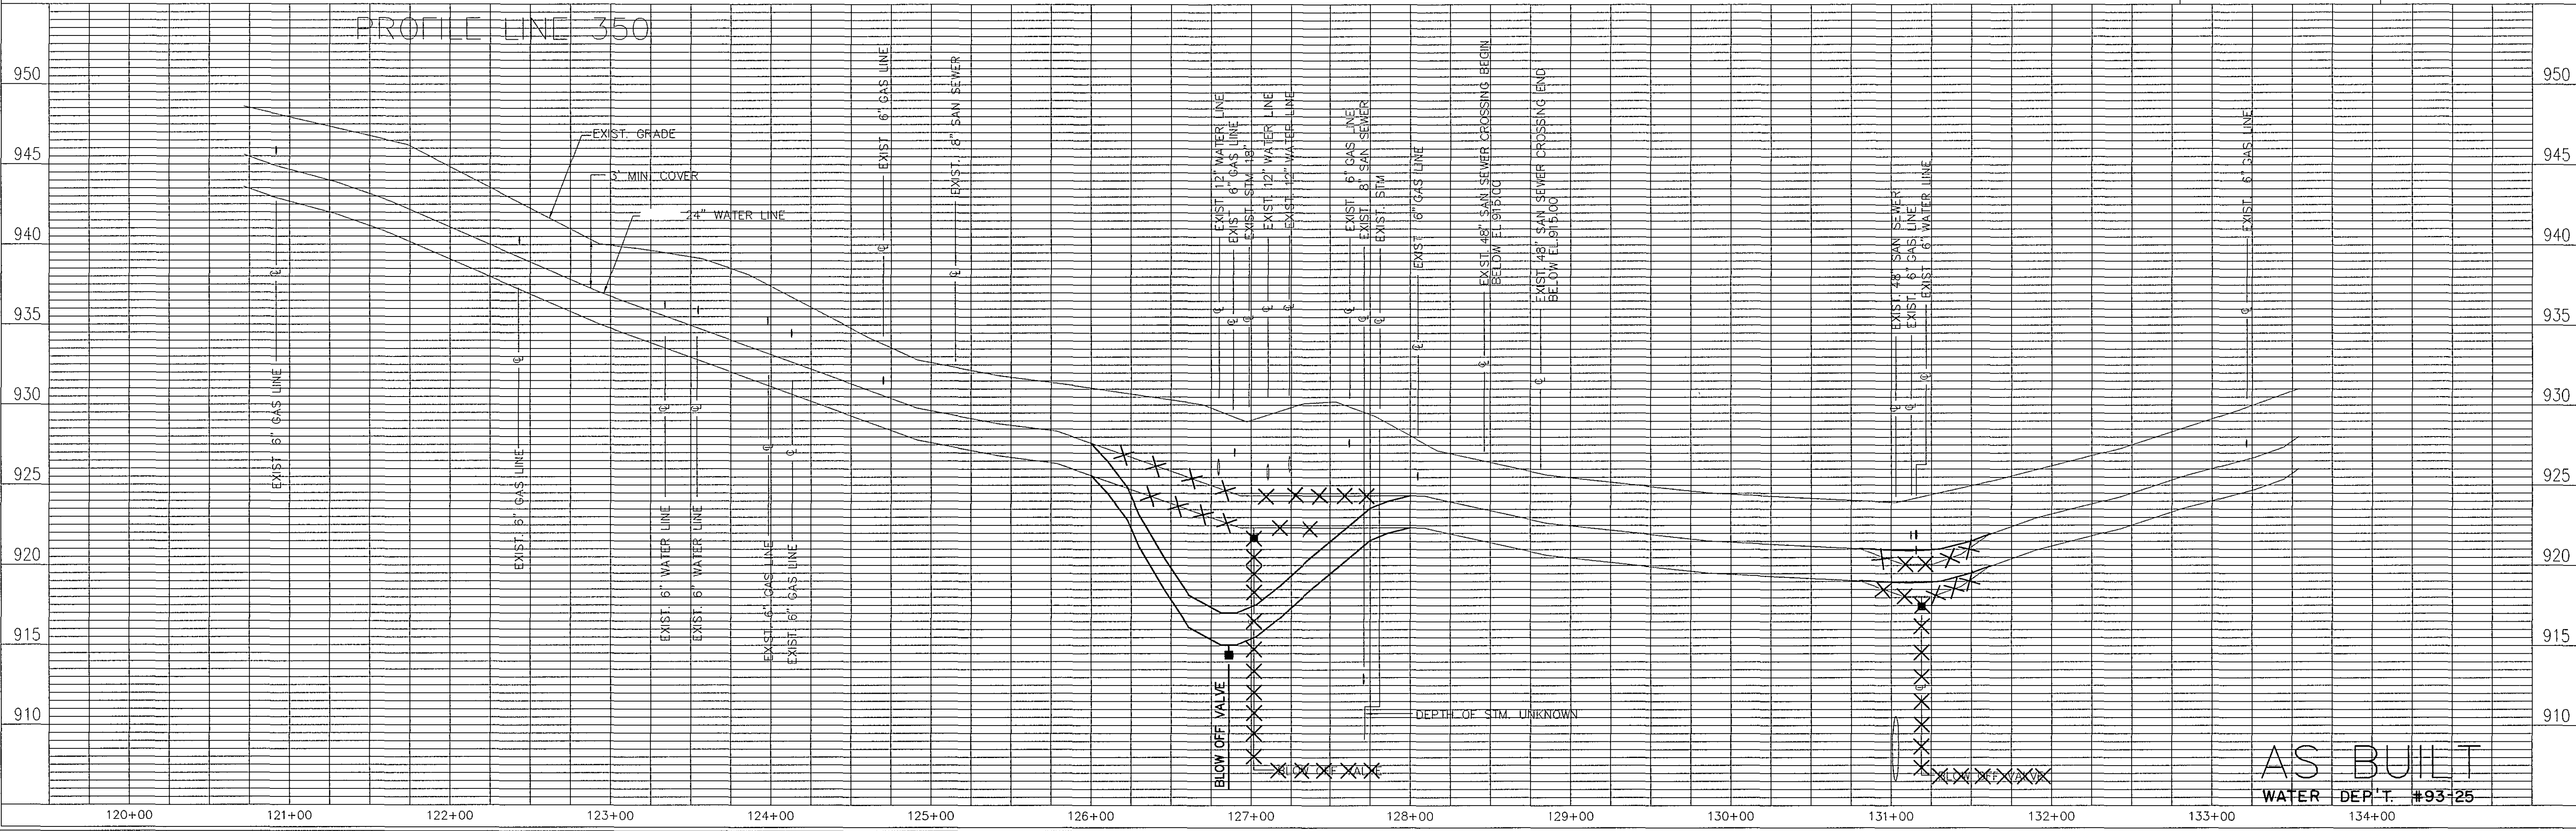

 Architects Engineers Planners Surveyors 5238 Valleypointe Parkway, Suite One-B Roanoke, Virginia 24019 703 362-7725	Carvins Cove, Phase II City of Roanoke Roanoke, Virginia	CONTRACT "C2" LINE 350 STA 120+71.44 - 133+54.10
		Drawn By REH/ACF Designed By RBS Checked By SEH
		Date MARCH 93 Scale V: 1" = 5' H: 1" = 50'
		Plan Number D14 Zoned NONE Sheet 11 of 25 File Number C1160