




THIS SHEET
1118 LF 24" WATERMAIN
1 EA. 1" A.R.V.

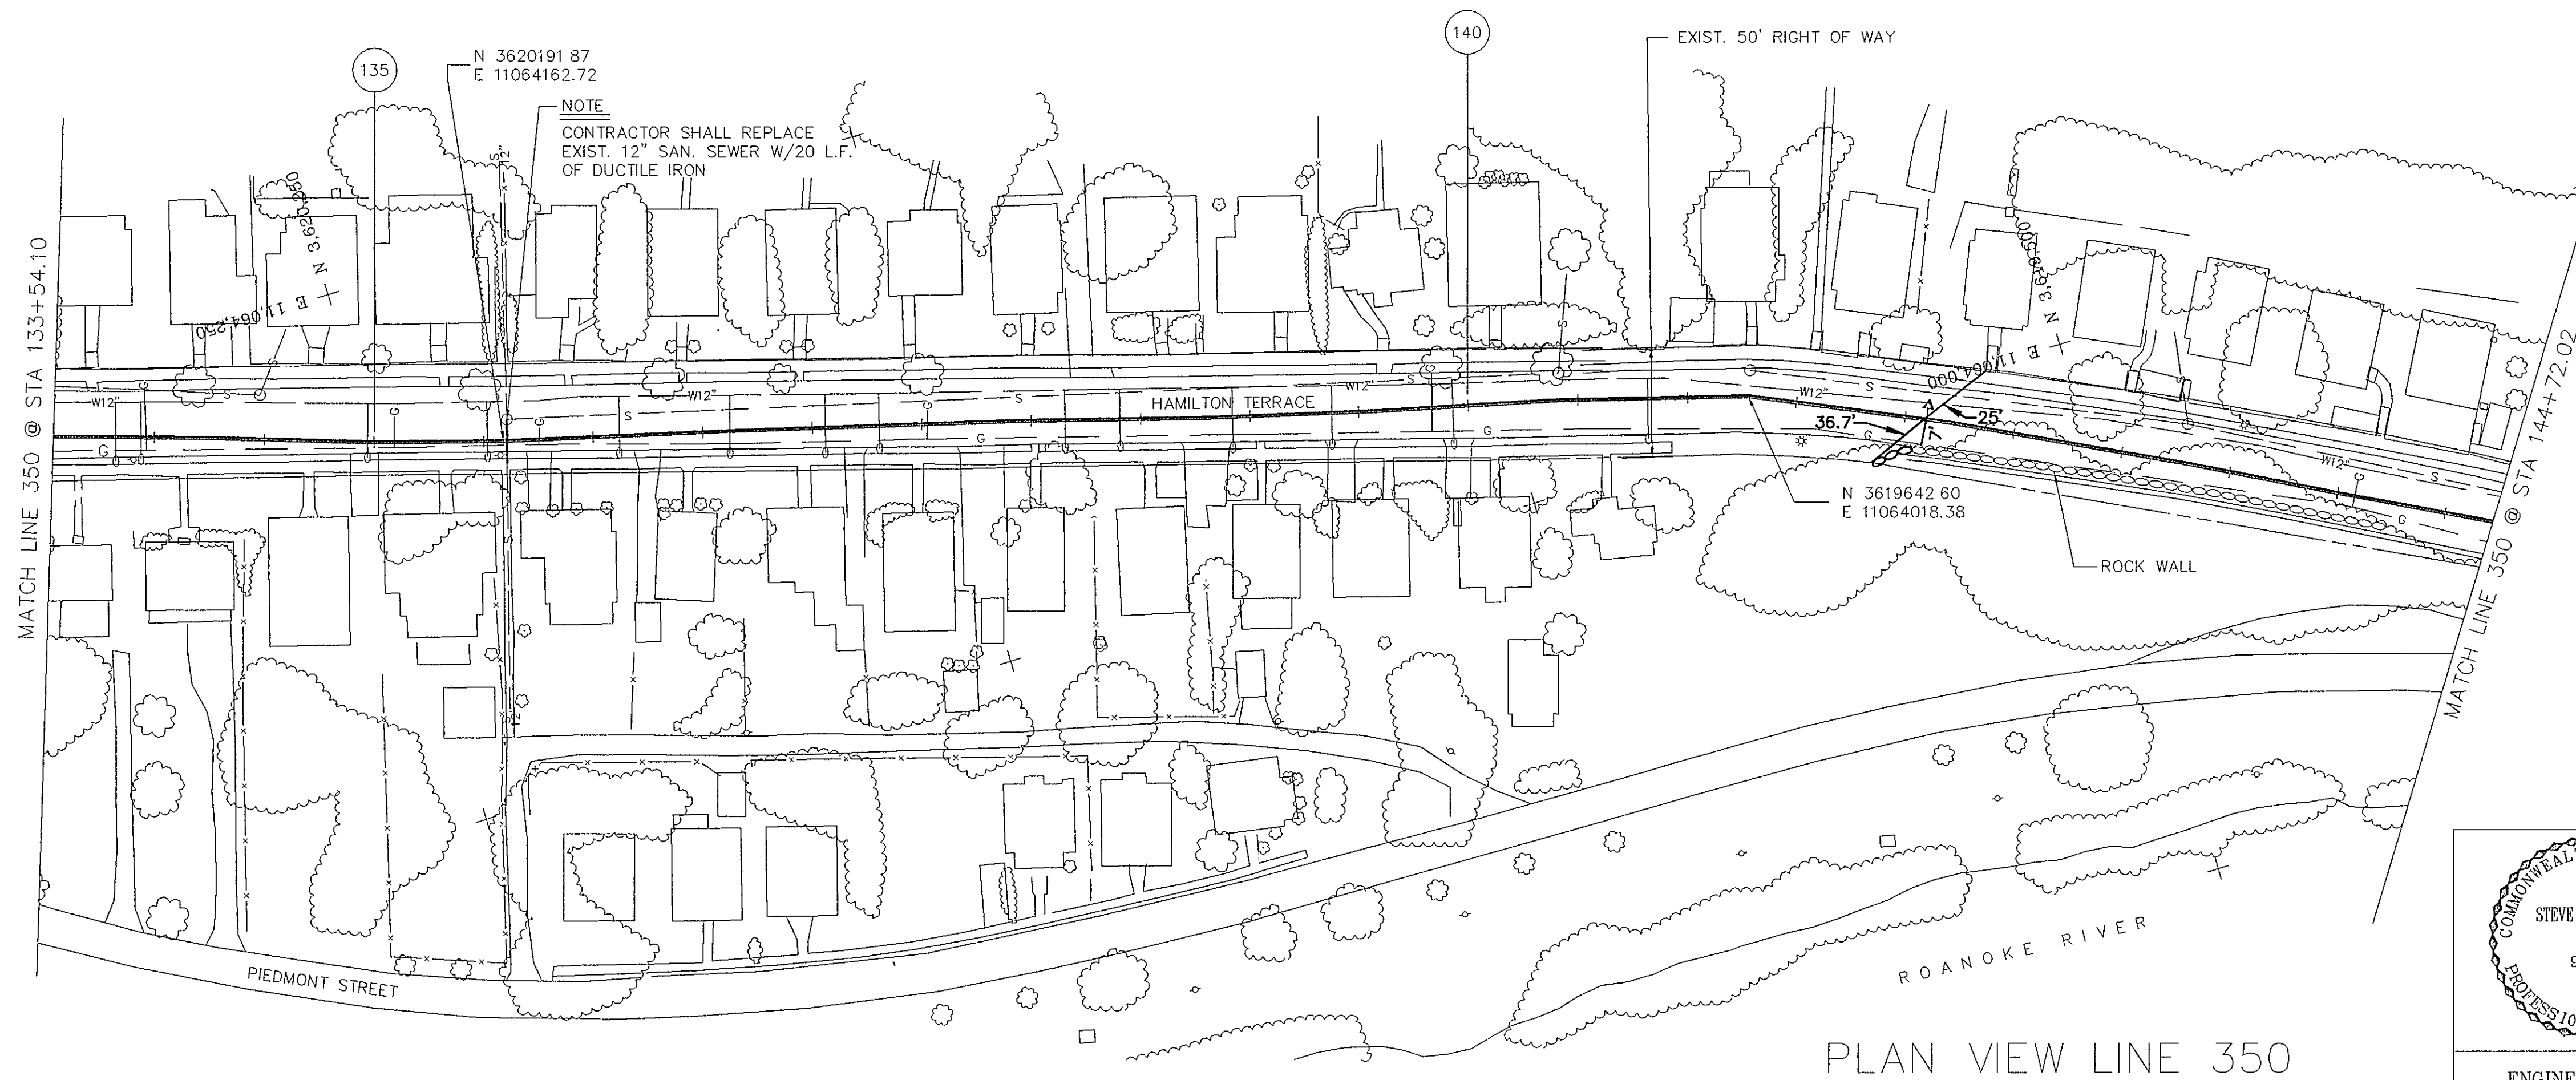


PLAN VIEW LINE 350

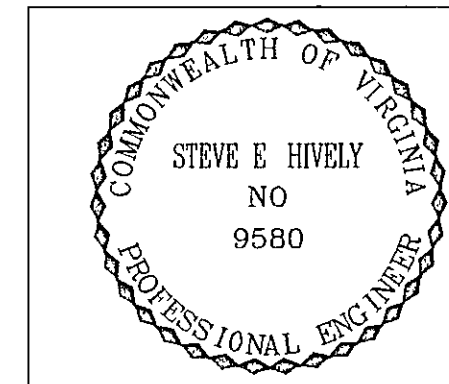

ENGINEER'S SEAL

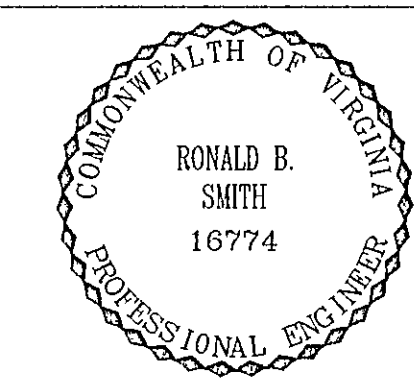

ENGINEER'S SEAL

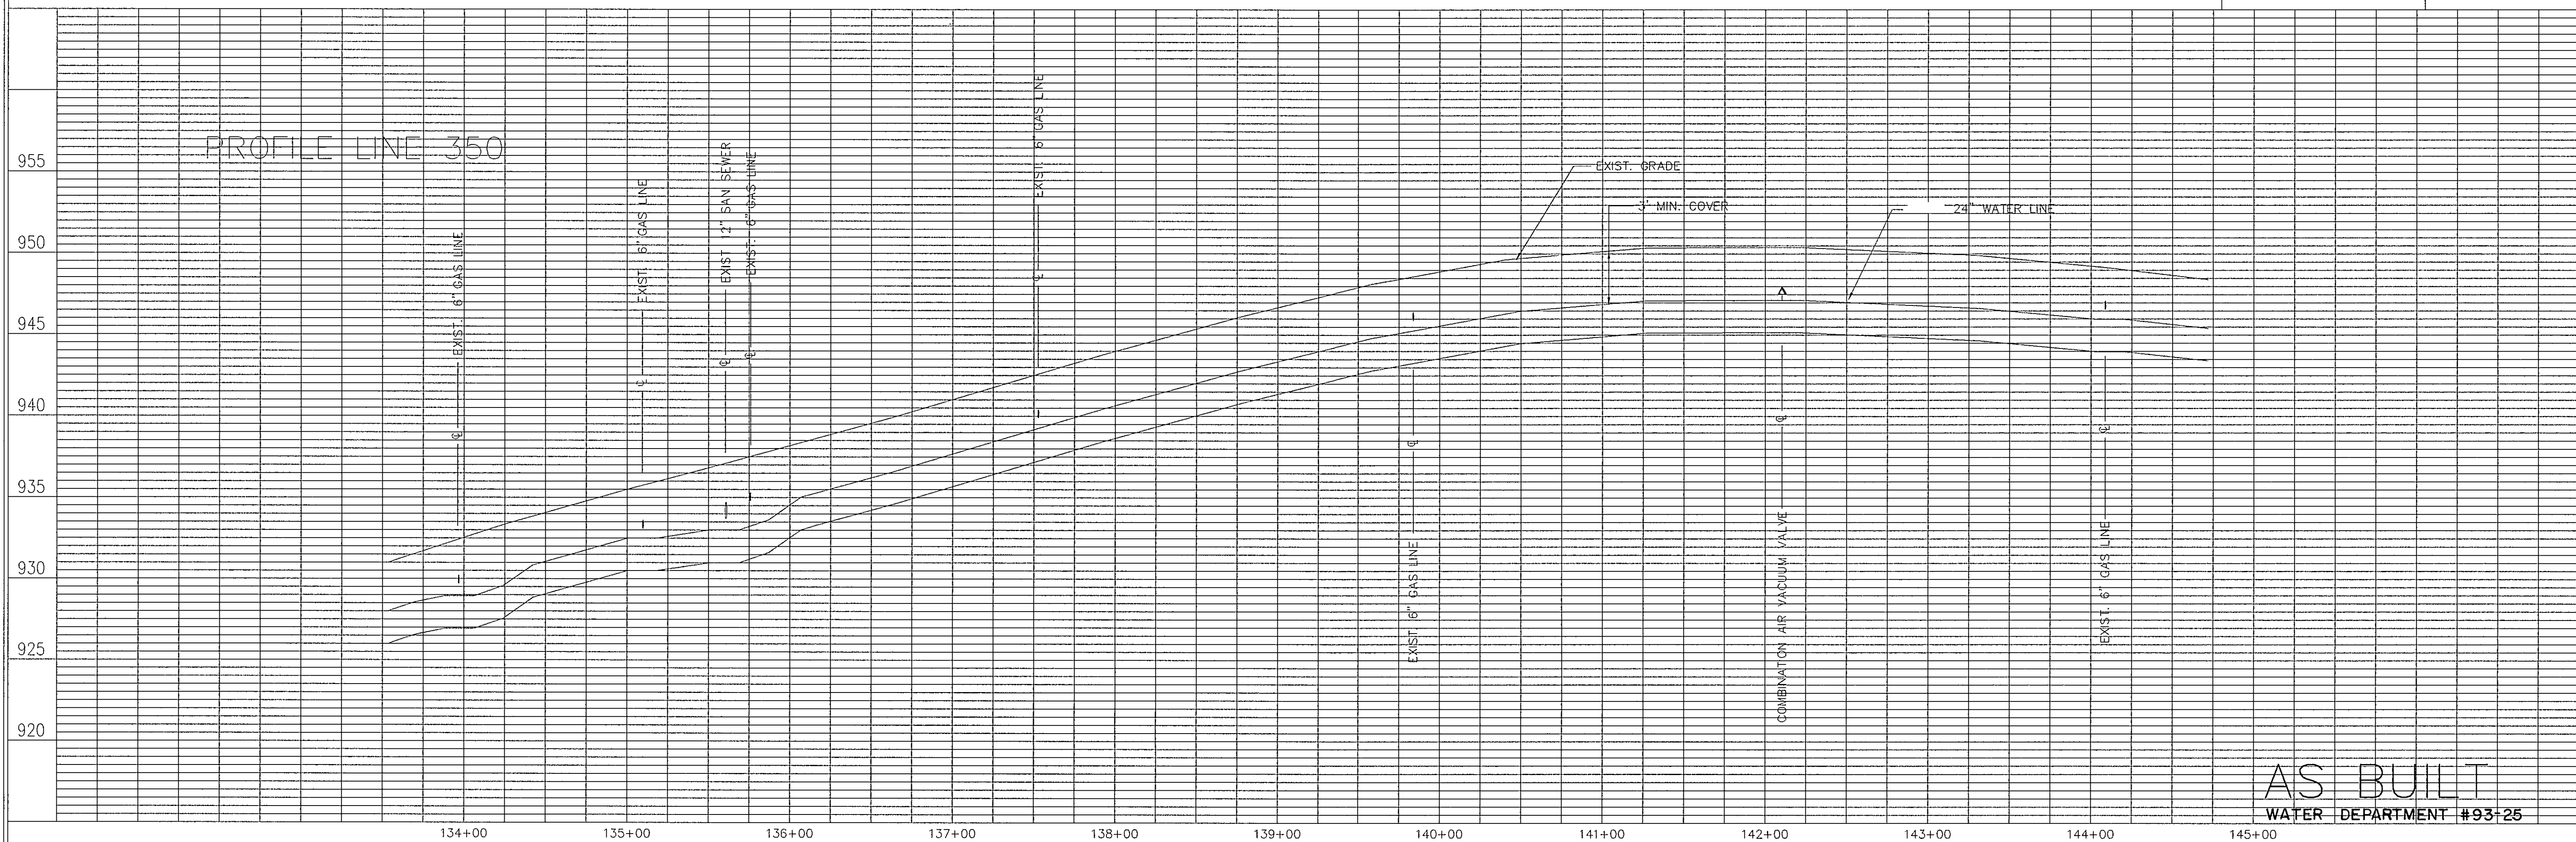

Architects
Engineers
Planners
Surveyors

Dewberry & Davis
5238 Valleypointe Parkway, Suite One-B
Roanoke, Virginia 24019
703 362-7725

Carvins Cove, Phase II
City of Roanoke
Roanoke, Virginia

CONTRACT "C2"
LINE 350
STA 133+54.10 - 144+72.02

Drawn By ACF/REH
Designed By RBS
Checked By SEH
Date MARCH 93
Scale V. 1" = 5'
H. 1" = 50'
Plan Number D15
Zoned NONE
Sheet 12 of 25
File Number C1160