


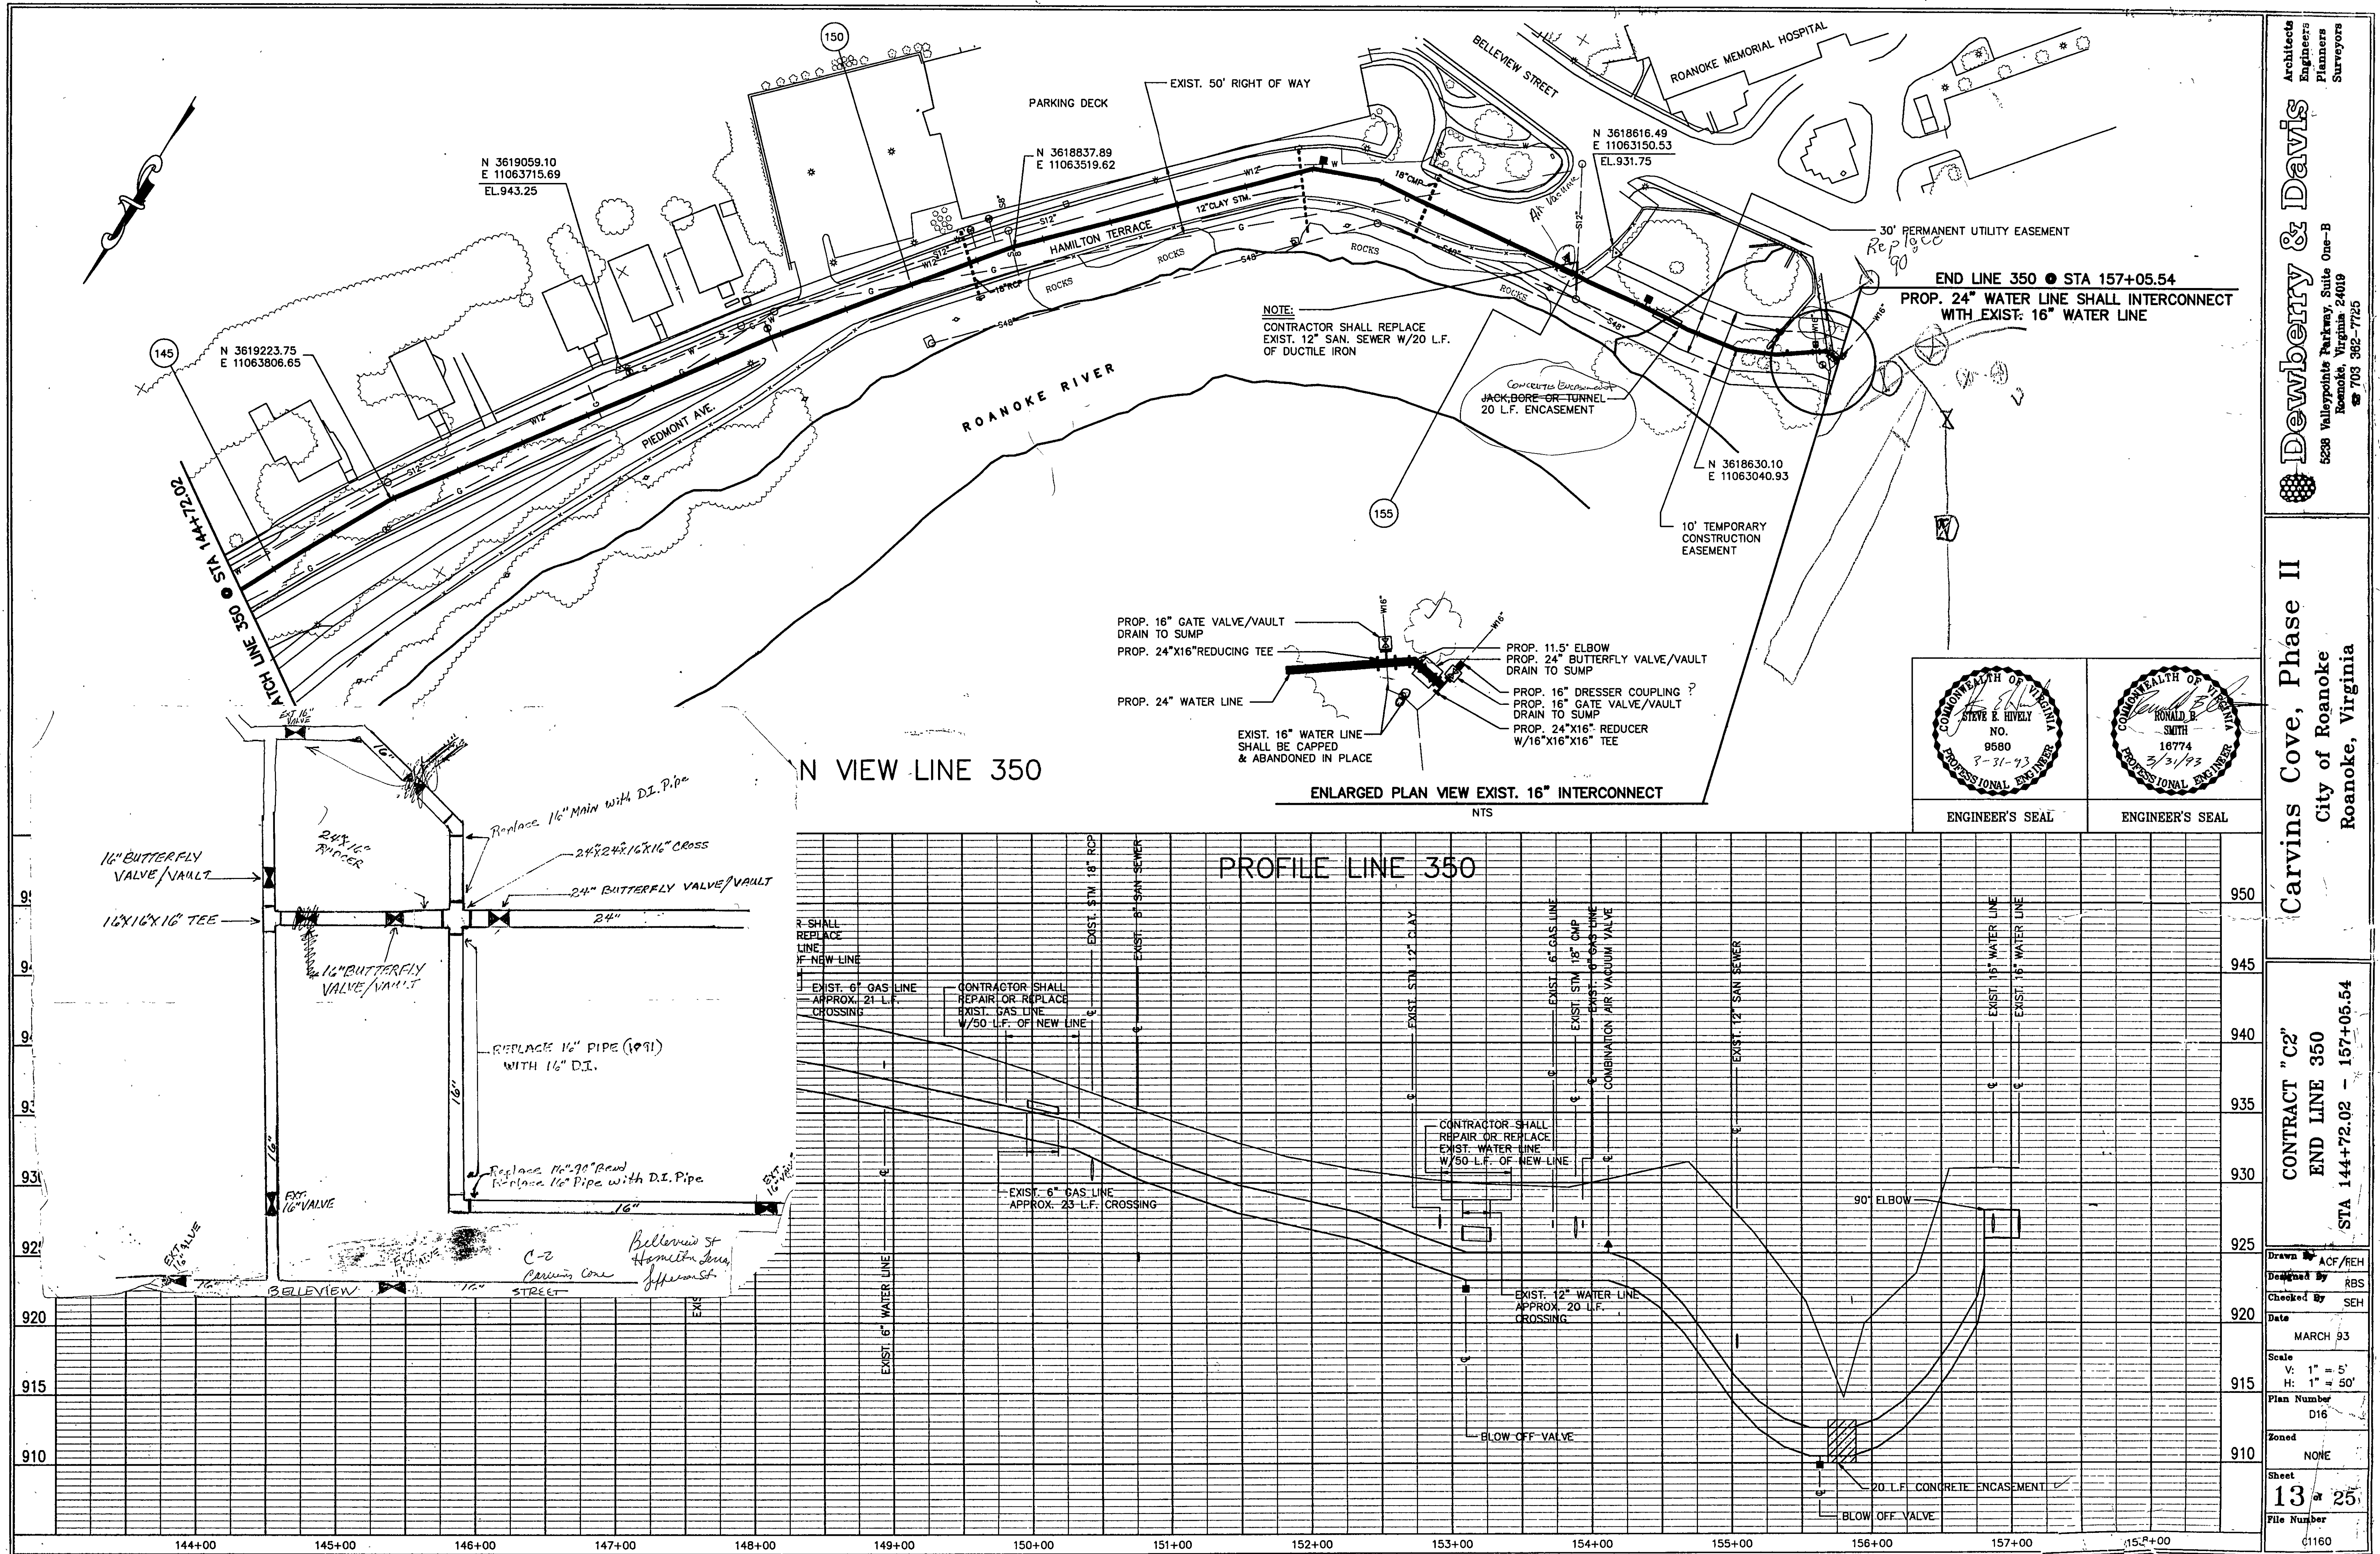

Architects
Engineers
Planners
Surveyors

Dewberry & Davis

5228 Valleypoints Parkway, Suite One-B
Roanoke, Virginia 24019
703 982-7725

Carvins Cove, Phase II

City of Roanoke
Roanoke, Virginia

CONTRACT "C2"

END LINE 350

STA 144+72.02 - 157+05.54

Drawn By: ACF/REH

Designed By: RBS

Checked By: SEH

Date: MARCH 93

Scale: V: 1" = 5'
H: 1" = 50'

Plan Number: D16

Zoned: NONE

Sheet: **13** of 25

File Number: 01160